


ABBREVIATIONS

Table of abbreviations including: A.F.F. ABOVE FINISHED, A.D. ACCESS DOOR, A.P. ACCESS PANEL, ACUST. ACUSTICAL, ADJ. ADJUSTABLE, ALT. ALTERNATE, ALUM. ALUMINUM, APPROX. APPROXIMATE, ANOD. ANODIZED, ARCH. ARCHITECTURAL, ASPH. ASPHALT, ASSY. ASSEMBLY, ATT. ATTENUATION, AT. AT, B.M. BEAM, BET. BETWEEN, BIF. BIFURCATED, B.L.K. BLOCK, B.D. BOARD, BRKT. BRACKET, B.L.G. BUILDING, B.U.R. BUILT UP ROOF, C.A.B. CABINET, CPT. CARPET, C.I.P. CAST IN PLACE, C.I. CAST IRON, C.E.M. CEMENT, CTR. CENTER, C.L. CENTERLINE, CER. CERAMIC, C.T. CERAMIC TILE, C.G. CORNER GUARD, CHAN. CHANNEL, C.O. CLEAN OUT, COL. COLUMN, CONC. CONCRETE, C.M.U. CONC. MASONRY UNIT, CONN. CONNECTION, CONST. CONSTRUCTION, C.J. CONTROL JOINT, CONT. CONTINUOUS, CSK. COUNTERSUNK, CU. CUBIC, D.E.G. DEGREE(S), DEMO. DEMOLISH, DEPT. DEPARTMENT, DET. DETAIL, DIAG. DIAGONAL, DIA. or D. DIAMETER, DIM. DIMENSION, DISP. DISPENSER, DR. DOOR, DBL. DOUBLE, DN. DOWN, D/S. DOWNSPOUT, DWR. DRAWER, DWG. DRAWING, D.F. DRINKING FOUNTAIN, E.A. EACH, E. EAST, ELECT. ELECTRIC, E.P. ELECTRIC PANEL, ELEV. ELEVATION, ENCL. ENCLOSURE, EQ. EQUAL, EQUIP. EQUIPMENT, EXH. EXHAUST, EXIST. EXISTING, EXP. EXPANSION, E.J. EXPANSION JOINT, EXT. EXTERIOR, F.O.C. FACE OF CONCRETE, F.O.F. FACE OF FRAMING, F.C.U. FAN COIL UNIT, FIN. FINISH, F.E. FIRE EXTINGUISHER, F.E.B. FIRE EXTINGUISHER BRACKET, F.E.C. FIRE EXTINGUISHER CABINET, F.H.C. FIRE HOSE CABINET, F.L.C. FLOORING, FL. FLOOR, F.D. FLOOR DRAIN, FL. MTD. FLOOR MOUNTED, FLUOR. FLUORESCENT, FT. FOOT OR FEET, FTD. FOOTING, FND. FOUNDATION, FR. FRAME, FUR. FURRING, FUT. FUTURE, G.G. GALVANIZED GALVANIZED IRON GAUGE, GEN. GENERAL, G.C. GENERAL CONTRACTOR, GL. GLASS, G.B. GRAB BAR, GR. GRADE, G.N.D. GROUND, GYP. GYPSUM, GYP. BD. GYPSUM BOARD, H. HANDICAP, H.W.D. HARDWOOD, HD. HEAD, HT. HEIGHT, H.P. HIGH POINT, H.C. HOLLOW CORE, H.M. HOLLOW METAL, HOR. HORIZONTAL, H.S. HOSE BIB, HR. HOUR, I. INCH, INCL. INCLUDE, INSUL. INSULATE, INT. INTERIOR, ID. INSIDE DIAMETER, J. JOINT, K.O. KNOCK OUT, L. LAMINATE, L.A.V. LAVATORY, L.H. LEFT HAND(ED), LT. LIGHT, LTWT. LIGHTWEIGHT, L.F. LINEAR FEET, L.P.T. LOW POINT, LB. POUND, L.O.W. LIMITS OF WORK, M. MACHINE, M.H. MAN HOLE, MAN. MANUAL, M.F.G.R. MANUFACTURER, MAS. MASONRY, M.O. MASONRY OPENING, M.R. MOISTURE RESISTANT, MAT. MATERIAL, MAX. MAXIMUM, M.E.C.H. MECHANICAL, M.E.P. MECHANICAL/ELECTRICAL/PLUMBING, MTL. METAL, MM. MILLIMETER, MIN. MINIMUM, MISC. MISCELLANEOUS, MOD. MODIFIED, MLDG. MOLDING, MTD. MOUNTED, MNTG. MOUNTING, MULL. MULLION, NAT. NATURAL, NOM. NOMINAL, N. NORTH, N/A. NOT APPLICABLE, N.C. NOT IN CONTRACT, N.T.S. NOT TO SCALE, N.O. NUMBER, O.C. ON CENTER, O.P.C. OPENING, O.P.P. OPPOSITE, O.P.P. H. OPPOSITE HAND, O.V. OVERALL, O.D. OUTSIDE DIAMETER, O.H. OVERHEAD, O.F.C.I. OWNER FURNISHED, CONTRACTOR INSTALLED, O.F.O.I. OWNER FURNISHED AND INSTALLED, P. PAINT, P.M.T. PAINT, P.R. PAIR, P.T.D. PAPER TOWEL DISPENSER, P.T.C. PAPER TOWEL DISPENSER & RECEPTACLE, P.T.D.R. RECEPTACLE, P.B. PARTICLE BOARD, PART. PARTITION, PLUS. PLASTER, P.L.A.M. PLASTIC LAMINATE, PL. PLATE, PLYWD. PLYWOOD, P.F. POINT, P.O.L. POLISHED, P.S.F. LB. PER SQ. FOOT, P.S.I. LB. PER SQ. INCH, P.V.C. POLYVINYL CHLORIDE, PROP. PROPERTY, Q.T.Y. QUANTITY, Q.T. QUARRY TILE, RAD. RADIUS, R. REFER OR REFERENCE, REFL. REFLECTED, REG. REGISTER, REINF. REINFORCED, REQD. REQUIRED, R.A. RETURN AIR, REV. REVISED OR REVISION, R.O.W. RIGHT OF WAY, R.H. RIGHT HAND(ED), R. RISER, R.D. ROOF DRAIN, RM. ROOM, R.O. ROUGH OPENING, S.N.D. SANITARY NAPKIN DISP., S.N.D.R. SANITARY NAPKIN DISPOSAL, S. SOUTH, SCHED. SCHEDULE, SECT. SECTION, SERV. SERVICE, SH. SHEET, S. & R. SHELF & ROD, SIM. SIMILAR, S.D. SOUTH DISPENSER, S.C. SOLID CORE, S. SOUTH, SPEC. SPECIFICATION, SQ. SQUARE, S. STAINLESS STEEL, STD. STANDARD, S. STEEL, STRUCT. STRUCTURAL, S.A. SUPPLY AIR, SUSP. SUSPENDED, TEL. TELEPHONE, T.V. TELEVISION, TEMP. TEMPERATURE, T. TERRAZZO, TERR. TERRAZZO, THK. THICK, THRESH. THRESHOLD, T.T.D. TOILET TISSUE DISPENSER, T.P.D. TOILET PAPER DISPENSER, T.O.B. TOP OF BEAM, T.O.C. TOP OF CURB, T.O.P. TOP OF PAWING, T.O.S.L. TOP OF SLAB, T.O. STL. TOP OF STEEL, T.O.W. TOP OF WALL, T.G.C. TONGUE & GROOVE, T.B. TOWEL BAR, T.H. TOWEL HOOK, T. TREAD, TRTD. TREATED, TYP. TYPICAL, UNFIN. UNFINISHED, UNLESS OTHERWISE NOTED, UR. URINAL, V.B. VAPOR BARRIER, V.B. VENTS, V.T.R. VENT THROUGH ROOF, VERT. VERTICAL, V.C.T. VINYL COMPOSITION TILE, V.W.C. VINYL WALL COVERING, W.T.W. WALL TO WALL, WH. WALL HUNG, W.C. WATER CLOSET, W.R. WATER RESISTANT, W.P. WATER PROOF(ING), WT. WEIGHT, W. WEST, W.C.H. WHEEL CHAIR, WDW. WINDOW, W.G. WIRE GLASS, W. WITH, W.F. WOVEN WIRE FABRIC, WD. WIDTH, W.P. WORK POINT, WI. WROUGHT IRON, Y. YARD, W.T.W. WALL TO WALL, WH. WALL HUNG, W.C. WATER CLOSET, W.R. WATER RESISTANT, W.P. WATER PROOF(ING), WT. WEIGHT, W. WEST, W.C.H. WHEEL CHAIR, WDW. WINDOW, W.G. WIRE GLASS, W. WITH, W.F. WOVEN WIRE FABRIC, WD. WIDTH, W.P. WORK POINT, WI. WROUGHT IRON, Y. YARD, NOTE: NOT ALL OF THESE ARCHITECTURAL ABBREVIATIONS MAY BE USED AND MAY NOT BE THE SAME AS USED BY THE OTHER DISCIPLINES, EMPLOYEES LOUNGE 101, ROOM NAME, 101, ROOM NUMBER, TRUE NORTH, TRUE NORTH INDICATOR, 1, COLUMN GRID NUMBER / LETTER, 1000, KEYNOTE IDENTIFICATION NUMBER, REVISION NOTE, PARTITION TYPE, DEMOLITION KEYNOTE, WINDOW LETTER DESIGNATION, 10, DOOR NUMBER, ELEVATION IDENTIFICATION, NON-FIRE RATED, 1 HR. SEPARATION, ALIGN, SHEET NUMBER OF DETAIL, DETAIL NUMBER, LEVEL, ELEVATION, LEVEL DESCRIPTION, FINISH FLOOR, ELEVATION, ELEVATION CHANGE, CENTERLINE

SYMBOL LEGEND

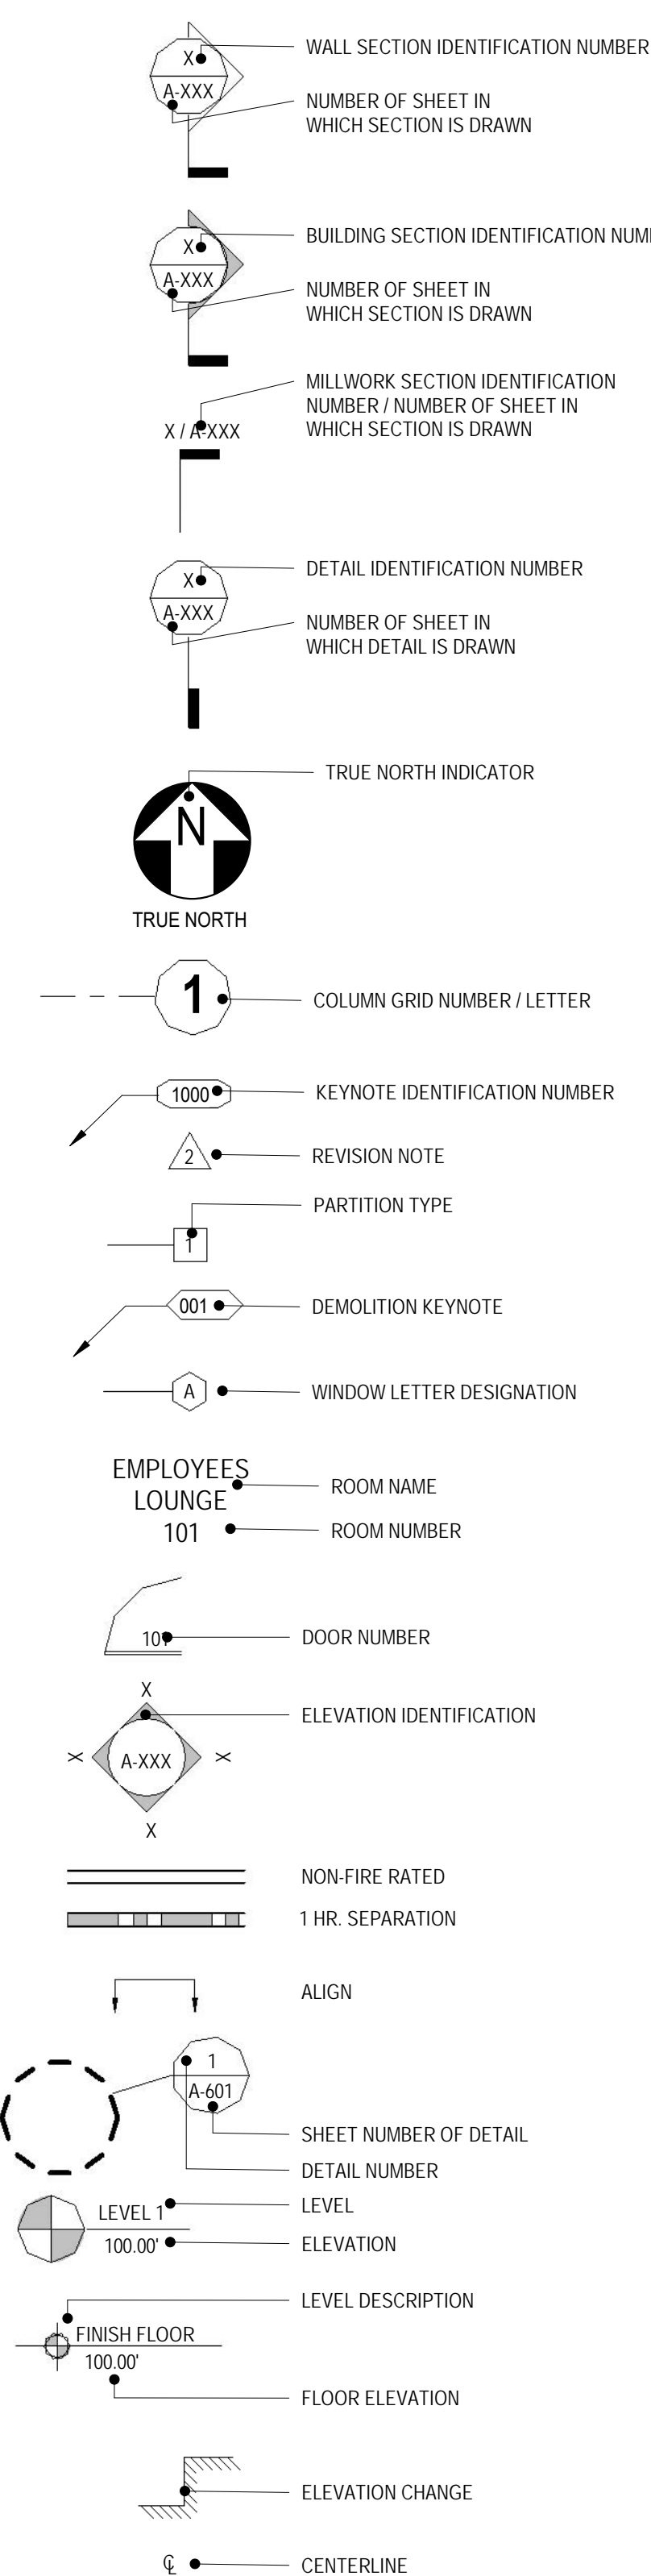

CANDAMIL RESIDENCE



3D View 1

Area Schedule (Gross Livable Building)

Table with columns: Number, Name, Area, Comments, Sheet Number, Sheet Name. Includes items like Existing Main Dwelling (3164 SF), Existing Garage (401 SF), Existing Covered Entry (23 SF), Existing Cover Porch (89 SF), Existing Covered Patio Area (1049 SF), Proposed Garage Addition (153 SF), and Grand total: 6 (4878 SF).

SITE STATISTICS

PROJECT DATA: OWNER: Mayra & Sebastian Candamil, JOB ADDRESS: 9700 Portada Drive, Whittier, CA 90603, APN: 8224-026-015, YEAR BUILT: 1957

SITE DATA: ZONING: "R-E, Residential Estate Zone", LOT AREA: 32,006 Sq.Ft. (0.75 Acres), COASTAL ZONE: NO


BUILDING DATA: OCCUPANCY CLASSIFICATION: R-U, DESCRIPTION OF USE: Single Family Residence, TYPE OF CONSTRUCTION: TYPE V, NUMBER OF STORIES: One, HEIGHT OF BUILDING: APPROXIMATELY 18'-0", FIRE HAZARD SEVERITY ZONE: NONE, FRONT SETBACK: 25' MIN., SIDEYARD: 10' MIN., BACKSIDE: 10' MIN., LOT COVERAGE: Allowable 40% (4,870 / 32,006=15%), FAR: Allowable 40% (4,210 / 32,006=13%)

PROJECT SCOPE: Remove existing roof framing and ceiling joist at existing main dwelling. Add new roof configuration and vaulted ceiling at interior public spaces as indicated in the floor plan. Add new covered patio attached to the rear side of the property. Vaulted ceiling with sloped vaulted plaster ceiling. Remove the existing concrete deck and pool coping in order to accommodate the columns support the proposed Patio. Abandon the pool and fill. Remove existing asphalt paved driveway. Re-compact top soil layers in order to accommodate new concrete driveway.

BUILDING TABULATED AREA: Existing 5 bedroom & 5.5 Bath Single Family Dwelling - 3,215 SF, Existing Carport - 382 SF, Existing Porch - 88 SF



VICINITY MAP 6" = 1'-0"

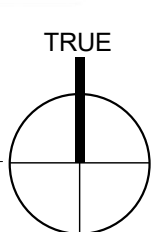

BEST MANAGEMENT PRACTICE

- Eroded sediments and other pollutants must be retained on site and may not be transported from the site via sheet flow, swales, area drains, natural drainage courses or wind.
Stockpiles of earth and other construction related materials must be protected from being transported from the site by the forces of wind or water.
Fuels, oils, solvents and other toxic materials must be stored in accordance with their listing and are not to contaminate the soil and surface waters. All approved storage containers are to be protected from the weather. Spills may not be washed into the drainage system.
Excess or waste concrete may not be washed into the public way or any other drainage system. Provisions must be made to retain concrete wastes on site until they can be disposed of as a solid waste.
Trash and construction related wastes must be deposited into a covered receptacle to prevent contamination of rainwater and dispersal by wind.
Sediments and other material may not be traced from the site by vehicle traffic. The construction entrance roadways must be stabilized so as to inhibit sediments from being deposited into the public way. Accidental depositions must be swept up immediately and may not be washed down by rain or other means.
Any slopes with disturbed soils or demanded of vegetation must be stabilized so as to inhibit erosion by wind and water.


CODE COMPLIANCE

GOVERNING AGENCY: City of Whittier, 13200 Pine Street, Whittier, California 90602. APPLICABLE CODES: ALL WORK AND MATERIAL SHALL BE PERFORMED AND INSTALLED IN COMPLIANCE WITH THE CURRENT EDITIONS OF THE FOLLOWING CODES AS ADOPTED BY THE LOCAL GOVERNING AUTHORITIES. NOTHING IN THESE PLANS IS TO BE CONSTRUED TO PERMIT WORK NOT CONFORMING TO THESE CODES.
- 2016 CALIFORNIA BUILDING STANDARDS CODE
- 2016 CALIFORNIA MECHANICAL CODE
- 2016 CALIFORNIA PLUMBING CODE
- 2016 CALIFORNIA ELECTRICAL CODE
- 2016 CALIFORNIA ENERGY CODE
- 2016 CALIFORNIA RESIDENTIAL CODE
- CITY OF WHITTIER MUNICIPAL CODE AND ADOPTING ORDINANCES
- BEST MANAGEMENT PRACTICES LISTED ON THIS PROJECT.

Table with 3 columns: No., Description, Date. Shows 1st Plan Check (02/13/17) and 2nd Plan Check (04/10/17).

Table with 2 columns: Project Number, Project Number. Includes Date, Drawn by, Checked by, Issue Date, Author, Checker.

Table with 2 columns: Consultant Address, Consultant Address. Includes Phone, Fax, e-mail.

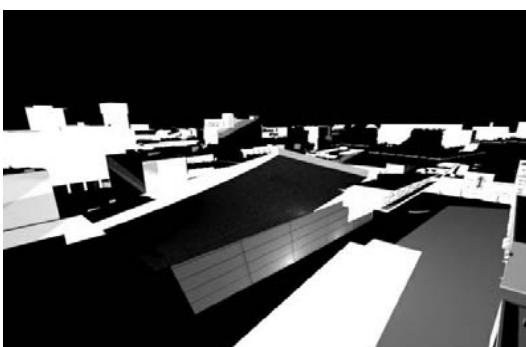

Contact: Jorge Escamilla, 4082 Pomona Street, Ventura, California 93003, Direct: 818.523.7201, Email: info@stitchstudio3d.com

CANDAMIL RESIDENCE

Remodel to Existing Single Family Dwelling

9700 Portada Drive, Whittier, CA

COVER SHEET

.G100

Scale As indicated



00 Keynote Legend

- | Key Value | Keynote Text  |
|-----------|---|
| 1         | Protect in place existing mature trees.   |
| 2         | Protect in place existing lawn area and corresponding irrigation system. Relocate and reconfigure existing sprinkler system as needed.  |
| 3         | Building setbacks, Typical.   |
| 4         | Property lines, typical.  |
| 5         | Protect in place existing curb and gutter at City's right of way.   |
| 6         | Remove and recompact existing asphalt paving, replace with CIP concrete slab, add control joints as per concrete standard.  |
| 7         | Remove and discard existing exterior wall assembly and attached fenestrations as needed, shoring of existing roof shall be installed prior to the removal of existing load bearing walls, shoring and brace walls as needed in order to accommodate the proposed building configuration, refer to waste management guidelines for disposal guidelines for proper waste disposal.  |
| 8         | Existing site perimeter fencing to be protected during the construction phase.  |
| 9         | Area of proposed addition.  |
| 10        | Existing Mature trees, protect during construction phase.   |
| 11        | Existing porch to be removed.   |
| 12        | Infill existing pool using local jurisdiction standards. All fill material shall be compacted to a minimum of 90 percent of maximum density as determined by ASTM D 1557, Modified Proctor, in lifts not exceeding 12 inches (0.3 m) in depth within 40 feet (12.2 m) below finished grade and 93 percent of maximum dry density deeper than 40 feet (12.2 m) below finished grade, unless a lower relative compaction (not less than 90 percent of maximum dry density) is justified by the Geotechnical Engineer and approved by the Building Official. Where ASTM D 1557, Modified Proctor is not applicable, a test acceptable to the Building Official shall be used. Field density shall be determined by a method. |
| 13        | New electrical meter location. Due to the numerous electrical service panel configurations, customers are recommended to contact the local Service Planning Office for details, or contact SCE's EV information hotline at (800) 366-7766.  |
| 14        | A disconnecting means with overcurrent protection is required at the meter location. In some cases, it is a single switch or circuit breaker. In other cases, where permitted by the Company and by inspection authorities, it may be a group of switches or circuit breakers, per National Electrical Code (NEC) 230-71.   |
| 15        | Relocate existing underground electrical main line in order to accommodate the new electrical meter location, installed using Edison Standards, Pull Box Refer to ESR-3, for Pull Box Requirements UG Service Entrance. All installations on the customer's premises are made by the customer. Installations of service conduit and its appurtenant structures for service from an overhead line source, both on and off the customer's premises, are made by the customer, under the conditions specified for Section 6, Underground Service Connections, Electrical Service Requirements sheets ESR-3 SCE.  |
| 16        | Where lot lines, walls, slopes or other physical barriers prohibit 6 inches of fall within 10 feet. International Residential Code-RB125, the final grade shall slope away from the foundation at a minimum slope of 2 percent and the water shall be directed to drains or swales to ensure drainage away from the structure. Swales shall be sloped a minimum of 2 percent when located within 10 feet of the building foundation. Impervious surfaces within 10 feet of the building foundation shall be sloped a minimum of 2 percent away from the building.   |
| 17        | Protect in place exist 2' high retaining wall and concrete deck, repair as needed.  |
| 18        | Existing Fire Hydrant location.   |

- G Gas Meter
- E Electrical Panel
- S Backflow Preventer
- W Water Meter
- P Power Pole
- Dense Landscape - Succulents
- (E) Neighboring Residence
- HB House Bibb, refurbished existing bibbs as needed.

- WASTE MANAGEMENT REQUIREMENTS**
- Owner requires that this project generate the least amount of trash and waste possible.
  - Employ processes that ensure the generation of as little waste as possible due to error, poor planning, breakage, mishandling, contamination, or other factors.
  - Minimize trash/waste disposal in landfills; reuse, salvage, or recycle as much waste as economically feasible.
  - Owner may decide to pay for additional recycling, salvage, and/or reuse based on Landfill Alternatives Proposal specified below.
  - Required Recycling, Salvage, and Reuse: The following may not be disposed of in landfills or by incineration:
    - Aluminum and plastic beverage containers.
    - Corrugated cardboard.
    - Wood pallets.
    - Clean dimensional wood: May be used as blocking or furring.
    - Land clearing debris, including brush, branches, logs, and stumps; see Section 31 1000 -Site Clearing for use options.
    - Concrete: May be crushed and used as riprap, aggregate, sub-base material, or fill.
    - Bricks: May be used on project if whole, or crushed and used as landscape cover, sub-base material, or fill.
    - Concrete masonry units: May be used on project if whole, or crushed and used as sub-base material or fill.
    - Precast concrete panels: May be used for erosion control or landscape features.
    - Asphalt paving: May be recycled into paving for project.
    - Metals, including packaging banding, metal studs, sheet metal, structural steel, piping, reinforcing bars, door frames, and other items made of steel, iron, galvanized steel, stainless steel, aluminum, copper, zinc, lead, brass, and bronze.
    - Glass.
    - Gypsum drywall and plaster.
    - Plastic buckets.
    - Carpet, carpet cushion, carpet tile, and carpet remnants, both new and removed: DuPont (<http://flooring.dupont.com>) and Interface ([www.interfaceinc.com](http://www.interfaceinc.com)) conduct reclamation programs.
    - Asphalt roofing shingles.
    - Paint 18. Plastic sheeting.
    - Rigid foam insulation.
    - Vinyl siding.
    - Windows, doors, and door hardware.
    - Plumbing fixtures.
    - Mechanical and electrical equipment.
    - Fluorescent lamps (light bulbs).
    - Acoustical ceiling tile and panels.


**SITE NOTES:**  
 1. THIS IS A WRITTEN STATEMENT PROPOSING THAT THE IMPROVEMENTS LISTED ON THIS PROJECT "REQUIRED NO GRADING PERMIT"  
 2. CONTOUR LINES ARE A METHOD FOR DEPICTING THREE DIMENSIONS ON TWO-DIMENSIONAL MEDIA WHILE MAINTAINING A UNIFORM SCALE IN ALL DIRECTIONS. THE ILLUSTRATED LINES ARE SHOWN AS A CONCEPTUAL METHOD OF GRAPHICALLY DEPICTING THE EXISTING SITE CONDITIONS. THESE ELEVATIONS ARE NOT GENERATED BY A LICENSED SURVEYOR. THIS PROJECT DOES NOT REQUIRE A GRADING PERMIT. THE CONTRACTOR IS RESPONSIBLE FOR FIELD VERIFYING THE EXISTING SITE CONTOUR CONDITIONS AS WELL AS SUBSURFACE SITE UTILITY CONDITIONS (DIG ALERT SHALL BE NOTIFIED UPON COMMENCING ANY EXCAVATION).



1 Site Plan  
 1/16" = 1'-0"

No.	Description	Date
2	2nd Plan Check	04/10/17

Project number	Project Number	Consultant
Date	Issue Date	Address
Drawn by	Author	Phone
Checked by	Checker	Fax
		e-mail

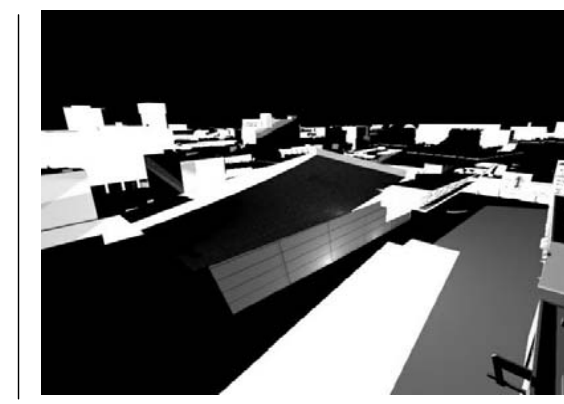

**STITCH STUDIO**  
 Contact: Jorge Escamilla  
 4082 Pomona Street  
 Ventura, California 93003  
 Direct: 818.523.7201  
 Email: info@stitchstudio3d.com


**CANDAMIL RESIDENCE**  
 Remodel to Existing Single Family Dwelling  
 9700 Portada Drive, Whittier, CA

**A101**

SITE PLAN

Scale As indicated

Key Value	Keynote Text
1	Remove and discard existing exterior wall assembly.
2	Remove and discard existing fenestrations in order to accommodate the proposed improvements.
3	Remove and discard existing door and corresponding framing.
4	Remove and relocate roof stack vents as per proposed roof configuration.
5	Protect in place existing interior spaces.
6	Remove and discard existing exterior wall assembly and attached fenestrations as needed, shoring of existing roof shall be installed prior to the removal of existing load bearing walls, shoring and brace walls as needed in order to accommodate the proposed building configuration, refer to waste management guidelines for disposal guidelines for proper waste disposal.
7	Remove and discard existing fireplace and chimney in its entirety, cap and disconnect gaslines in order to accommodate the proposed improvements.
8	Protect in place existing exterior wall assembly.
9	All cutting and patching in the existing building shall be done by the contractor, to provide for exterior load bearing walls and new roof configuration.
10	Infill existing window opening in order to accommodate the proposed improvements.
11	Saw cut existing slab in order to accommodate the proposed footings and slab at proposed garage improvements, coordinate with structural foundation plan.
12	Remove and discard existing casework, base cabinets, counter top and kitchen sink along with upper cabinets, remove damage gyp board, add water-proofing in order to accommodate the proposed kitchen layout.
13	Remove and discard existing planter wall and existing planting, new planter configuration shall be flushed with existing pavement at existing driveway elevation, refer to floor plan for additional information.
14	Protect in place existing flooring and substructure.
15	Contractor shall verify existing conditions at the site and examine adjoining work, identify what will affect the completion of this work, the designer shall be notified in writing should the contractor have questions as to existing condition that will affect the work.
16	Sawcut existing exterior plaster system at base location in order to accommodate the proposed stone veneer wainscot, refer to exterior elevations for additional information.
17	Remove and discard existing plumbing fixture along with all damage utilities, field verify existing sewer lines, replace and repair all damage water supply and sewer lines.
18	Remove and Replace existing damage sub-flooring, replace and repair any damage sub-flooring framing members, contact designer if structural observations are needed.
19	Remove and discard existing washer and dryer, disconnect all utilities, cap gas lines, water lines and sewer lines, coordinate with floor plan in order to accommodate the proposed laundry room location.
20	Remove existing fire place mantel in order to accommodate the proposed floor finish, refer to floor plan for additional information.
21	Remove and discard existing concrete steps and landing in order to accommodate the proposed garage configuration.
22	Protect in place existing footings.
23	Sawcut, remove and discard the existing conc. slab in order to accommodate the proposed laundry room raised foundation.
24	Protect in place existing floor slab and footings.
25	Protect in place existing sub-flooring crawl space attic access and corresponding panel, field verify existing conditions.
26	

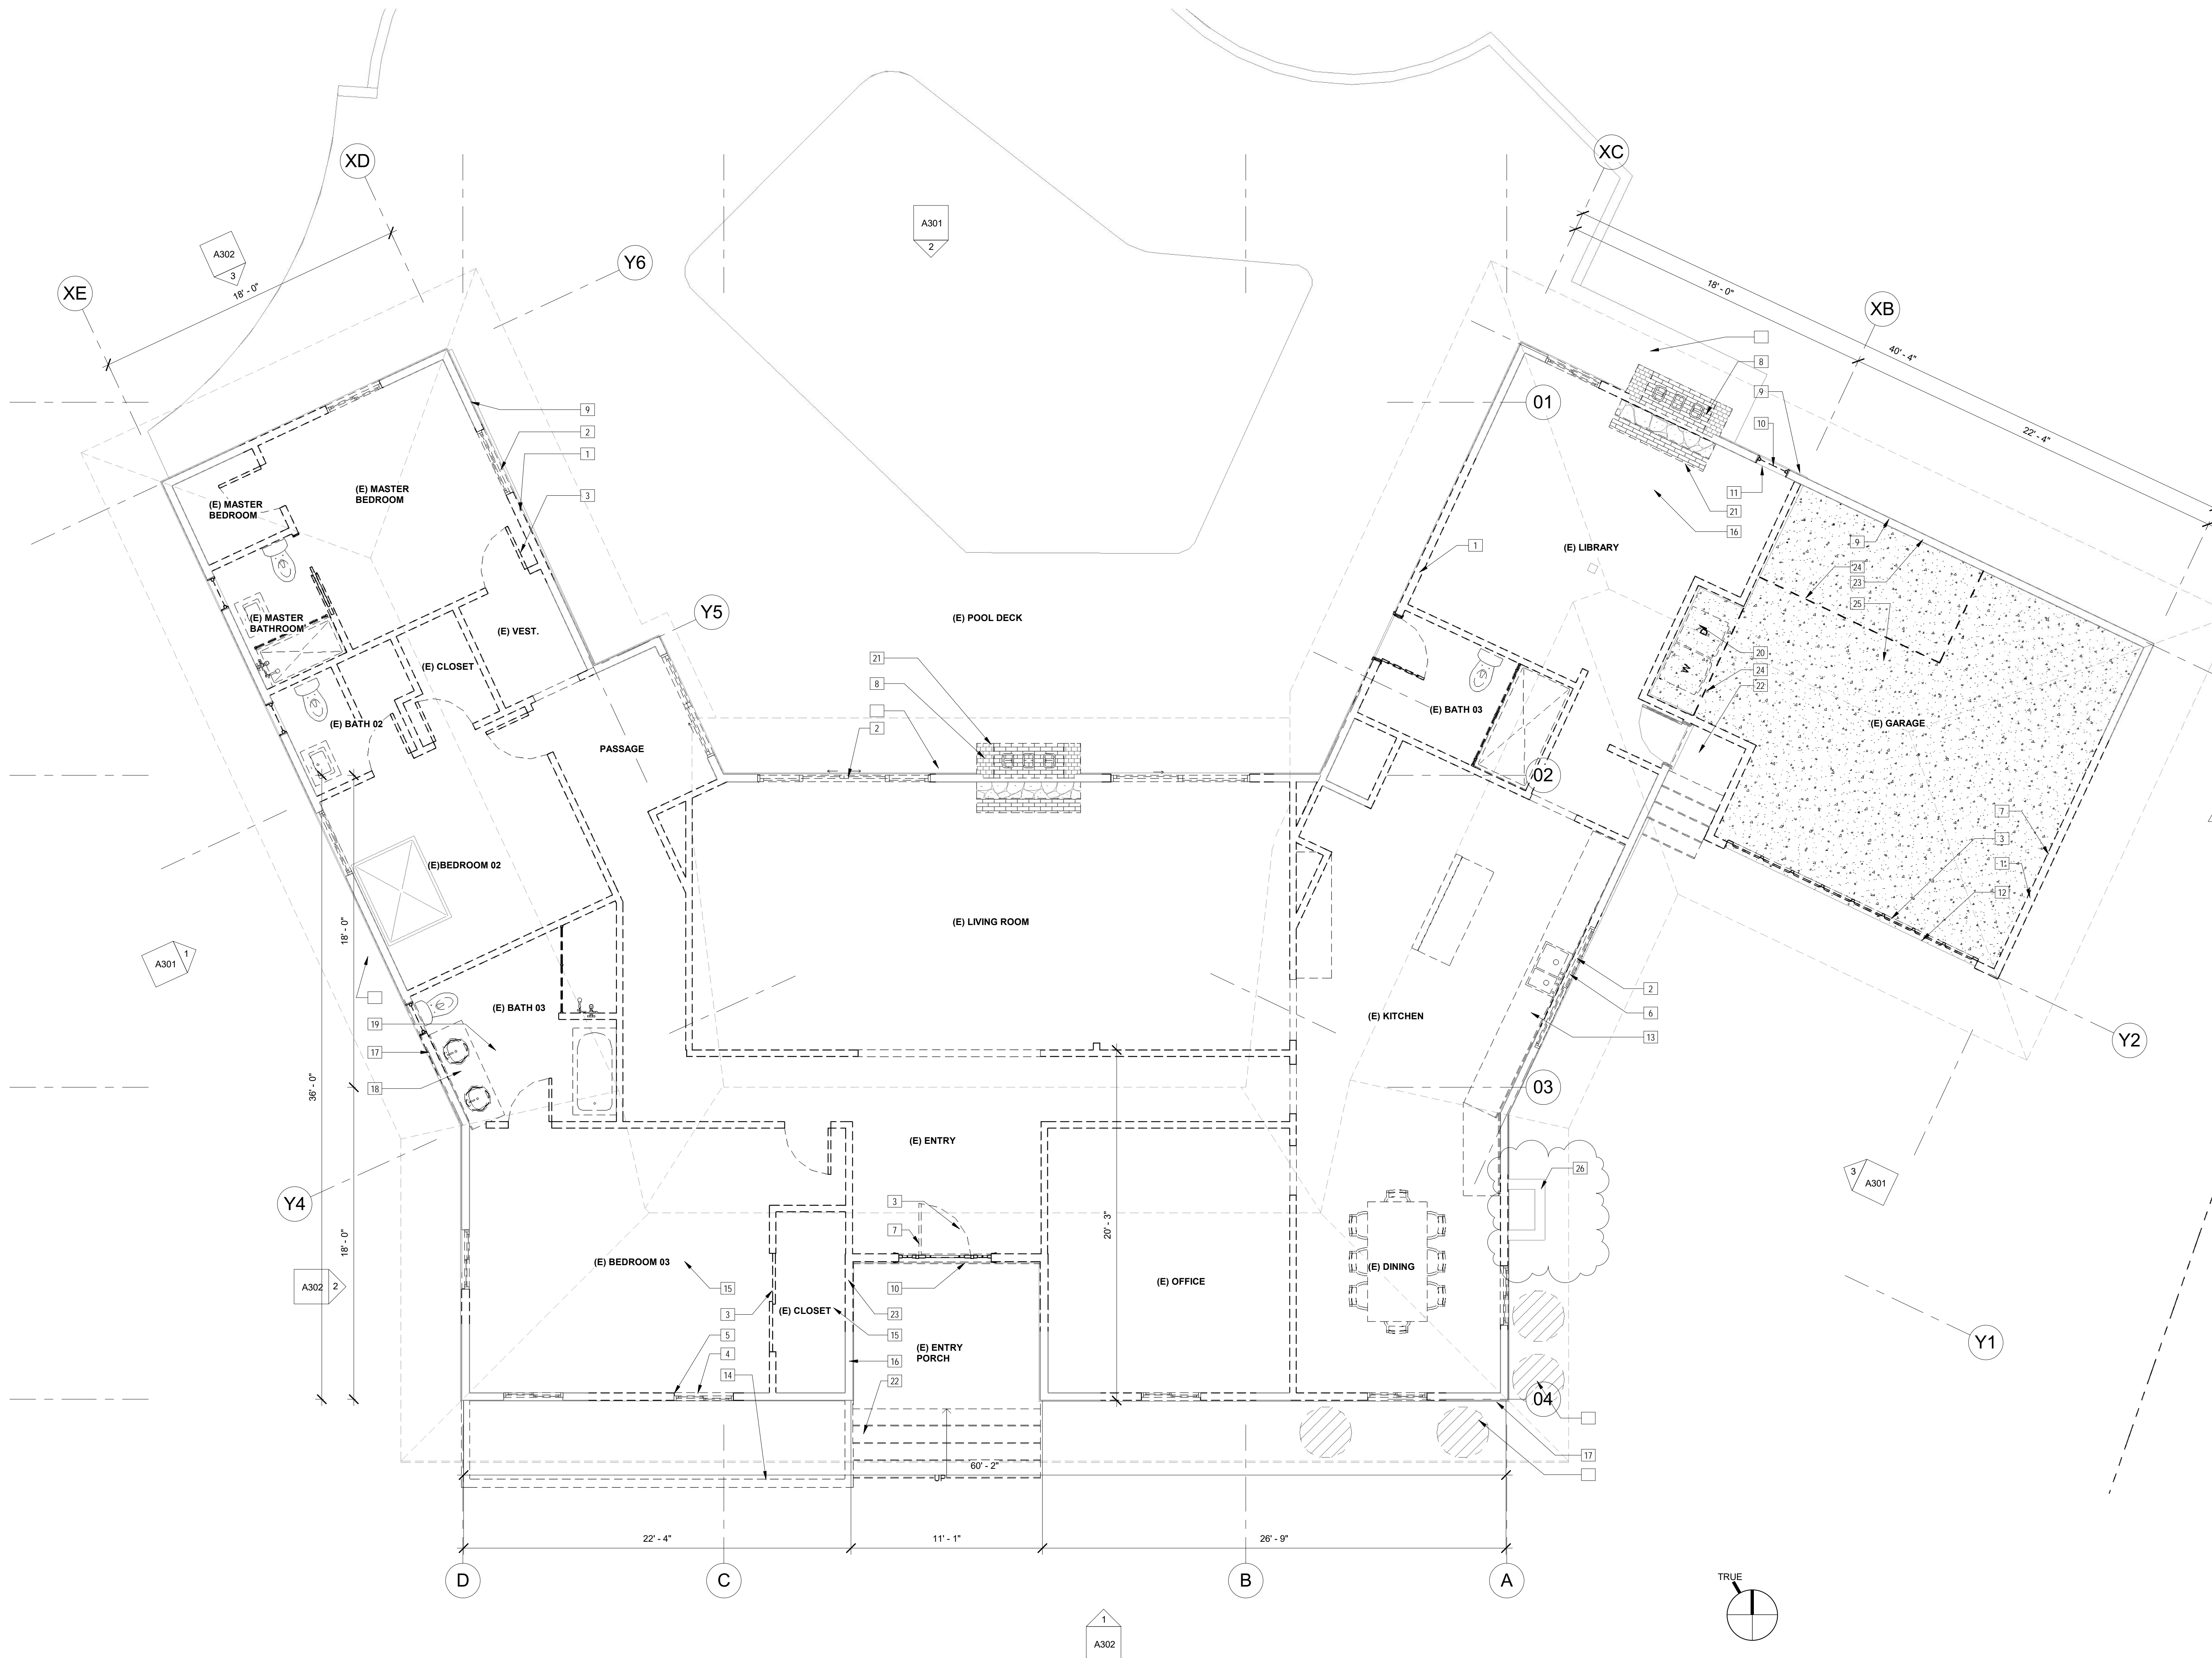

1 00 EXISTING FLOOR PLAN  
1/4" = 1'-0"

**WALL LEGEND**


- REMOVE AND DISCARD EXISTING WOOD FRAMED STUD WALLS.
- EXISTING 2 X 4 WOOD FRAMED STUD WALL (INTERIOR), PROTECT FRAMING IN PLACE.

No.	Description	Date
1	1st Plan Check	02/13/17
2	2nd Plan Check	04/10/17

Project number  
Date  
Drawn by  
Checked by

Project Number  
Issue Date  
Author  
Checker

Consultant  
Address  
Phone  
Fax  
e-mail

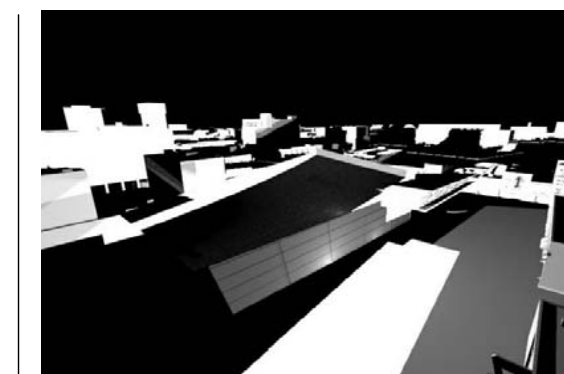


**STITCH STUDIO**  
Contact: Jorge Escamilla  
4082 Pomona Street  
Ventura, California 93003  
Direct: 818.523.7201  
Email: info@stitchstudio3d.com

**CANDAMIL RESIDENCE**  
Remodel to Existing Single Family Dwelling  
9700 Portada Drive, Whittier, CA  
FIRST FLOOR PLAN (Existing)

**A201**

- Key Value Keynote Text
- 1 Exterior wall assembly, 2x wood studs at 16 inches on center, insulation as per calculation requirements, exterior plaster over water proofing membrane, interior gypsum board shall be installed as per manufacture installation standards.
  - 2 Interior wall assembly, interior gypsum board shall be installed as per manufacture installation standards, tape and mud to a smooth finish, primed and painted, color to be owner selected, continuous base board installed as per manufacture installation instructions, 4 inch minimum, color and profile to be owner selected.
  - 3 Exterior window assembly. Refer to schedule and window elevations for window configuration.
  - 4 Tile or stone floor finish, installed as per manufacture installation instructions, color, size and pattern are owner selected.
  - 5 Wood post, seal and paint as specifications.
  - 6 Sealed concrete slab on grade, slope towards garage door, provide 6 inch high curb as indicated on foundation plan.
  - 7 Provide utilities for drying and washing machine along with a drainline for utility sink, 30 inch wide base cabinet along with upper cabinets, provide backing in order to accommodate the cabinets, all case work shall meet the wood working institute standards.
  - 8 Proposed electrical meter and main switch box, installed as per manufacture installation instructions, contact Edison in order to accommodate the power pole connection, owner to select overhead or under ground option.
  - 9 Proposed slab on grade, surface drainage shall be diverted to a storm sewer conveyance or other approved point of collection so as to not create a hazard.
  - 10 Finish floor shall be installed over plywood floor sheathing, installed as per manufacture installation instructions, color and flooring type shall be owner selected, provide trims and base boards as needed.
  - 11 Door as per schedule, wood or vinyl, installed as per manufacture installation instructions, color and style to be owner selected.
  - 12 Exterior lighting, Mount as per recommended exterior elevation heights.
  - 13 All closets shall have shelving and poles installed as per wood working standards, door shall be installed as per manufacture installation instructions, use medium grade doors and hardware shall have a minimum 5 year limited warranty.
  - 14 American Standard Princeton Reinforced Porcelain Enamel/Metal Oval In Rectangle Skirted Bath with Right Hand Drain (14-in x 30-in x 60-in), installed as per manufacture installation instructions, add full height tiling at surrounding tub walls using water resistant gypsum board, add aluminum door and tracks, water fixtures shall be as per green code standards.
  - 15 Toilets and plumbing fixtures shall be installed as per manufacture installation instructions, refer to flow rate fixtures tables for additional information.
  - 16 Integral Single Sink Bathroom Vanity with Cultured Marble Top (Actual: 30-in x 18.5-in), color and style to be owner selected, faucet shall meet Green code standards.
  - 17 Base cabinets, installed as per manufacture standards and Wood Working Institute Standards.
  - 18 4 burner gas range, intalled as per manufacture installation instructions, coordinate proposed gas line in order to accommodate the propose equipment location, provide GFI power outlet, owner to provide range.
  - 19 Sliding door shall be installed as per manufacture installation instructions, provide flashing, sealer and galvanized pan as needed.
  - 20 Provide Type X gypsum wallboard, 5/8" in thickness, 1 hour assembly gypsum board at garage side, full height, penetrations shall be seal and caulk as per UL 1 hour penetration standards.
  - 21 Provide a new 1 hour rated door and door frame assembly, hardware and self closing closer.
  - 22 Use tempered glazing at Glazing in fixed and sliding panels of sliding door assemblies and panels in sliding and bifold closet door assemblies, in doors and enclosures for hot tubs, whirlpools, saunas, steam rooms, bathtubs and showers, also in any portion of a building wall enclosing these compartments where the bottom exposed edge of the glazing is less than 60 inches above a standing surface, individual fixed or operable panel adjacent to a door where the nearest exposed edge of the glazing is within a 24-inch arc of either vertical edge of the door in a closed position and where the bottom exposed edge of the glazing is less than 60 inches above the walking surface.
  - 23 Over the Range Microwave/Range Hood Combo with Exhaust Fan Maximum Capacity (CFM) 300, provide cabinet over microwave, add exhaust ducting, roof penetration and flashing as needed.
  - 24 Dishwasher, provide water supply line and drain lines as per manufacture installation instructions, add power using GFCI outlet at required mounting heights, add holes and access to adjacent cabinets using wood working standards.
  - 25 Refrigerator, provide power and filter water supply line as per manufacture's installation instructions.
  - 26 Slab on grade, provide 15mil vapor barrier over 2 inches of sand, refer to foundation plan for additional information.
  - 27 Add sub flooring sheathing over floor joist, ledger and blocking as per structural drawings.
  - 28 Persons having ownership or custody of buildings are responsible for posting address numbers, the design, style, and shape of address numbers must render them easily readable from the street. Numbers must contrast with background. In cases where conditions (shadows, overgrown vegetation, building location, etc.) adversely affect the legibility of numbers, the Department has the authority to prescribe larger numbers. Addresses may be required to be posted adjacent to driveways, alleys, walkways, or other access ways.

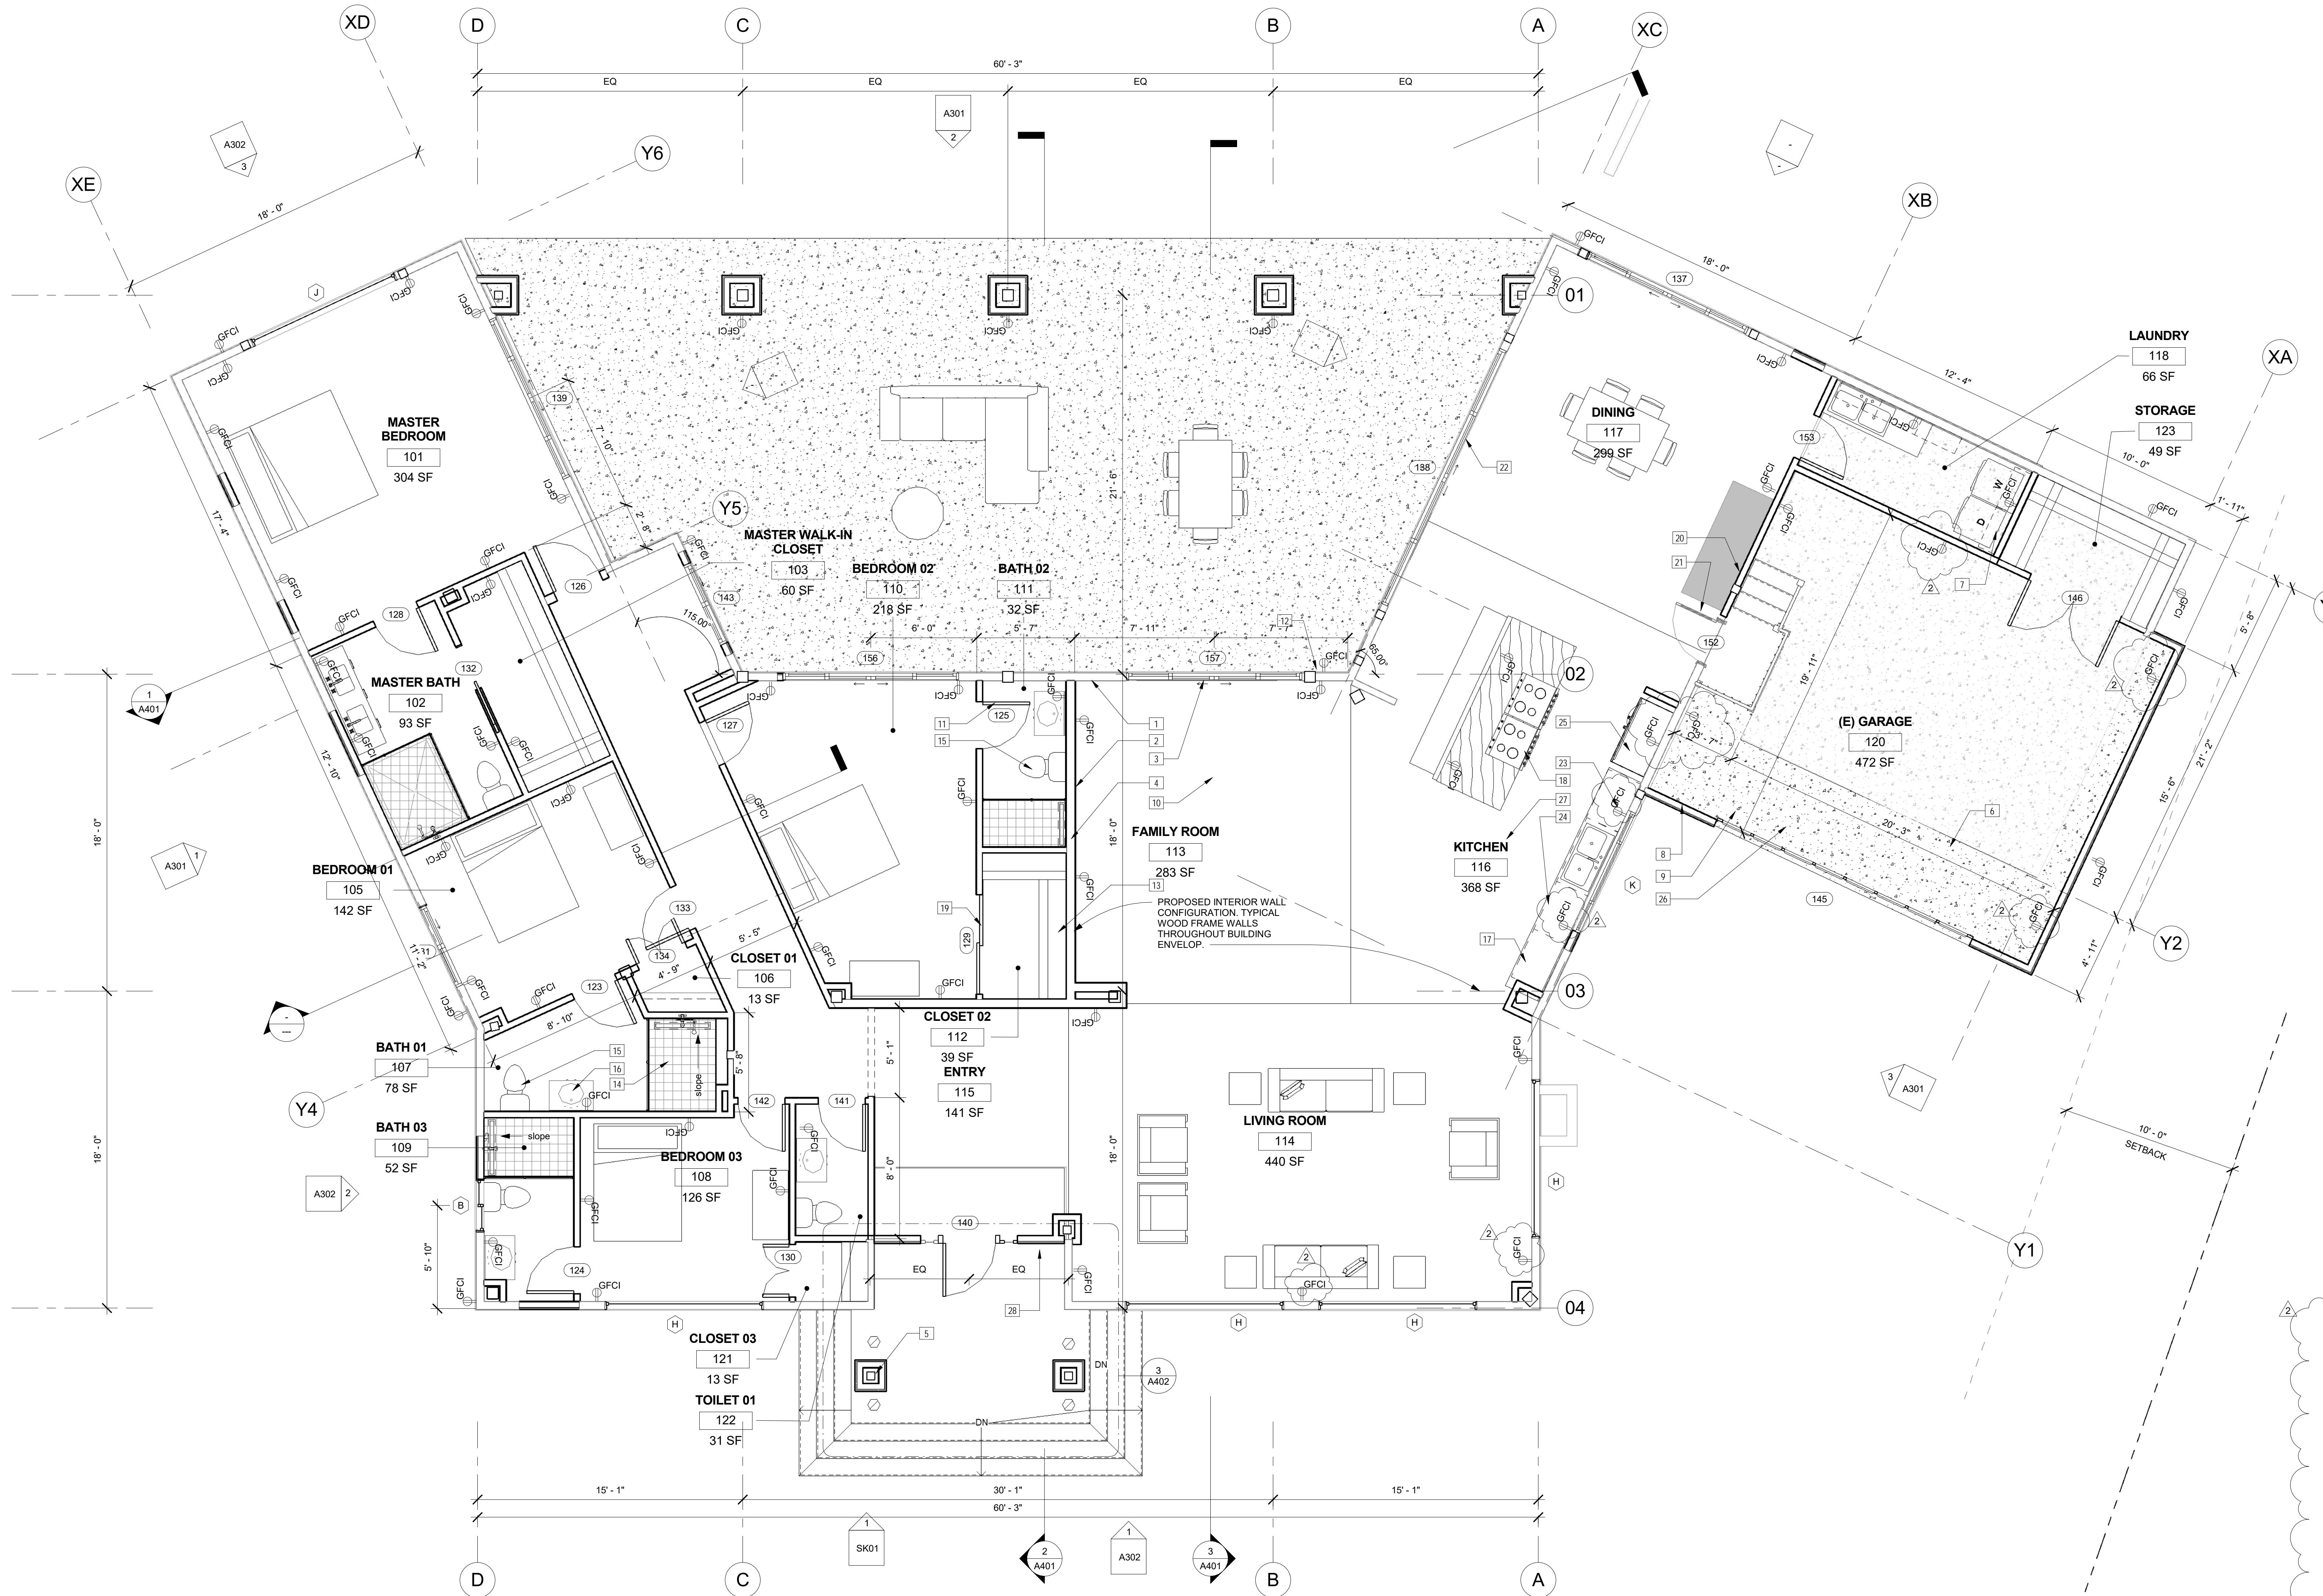

**WALL LEGEND**

- REMOVE AND DISCARD EXISTING WOOD FRAMED STUD WALLS.
- EXISTING 2 X 4 WOOD FRAMED STUD WALL (INTERIOR)
- PROPOSED 2 X 4 WOOD FRAMED STUD WALL (INTERIOR)
- 1 HOUR RATED WALL ASSEMBLY.
- 2 X 6 WOOD STUD FRAMED WALL (INTERIOR)
- 2 X 4 WOOD STUD FRAMED WALL (EXTERIOR)
- 2 X 4 WOOD STUD WALL (EXTERIOR - 2 SIDED FINISH)
- MANSORY WALL (SEE STRUCTURAL)
- CIP CONCRETE WALL (Refer to Structural for additional information)

Note:  
 Interior finish requirements based on group. Interior wall and ceiling finish shall have a flame spread index not greater than that specified in Table 803.9 for the group and location designated. Interior wall and ceiling finish materials tested in accordance with NFPA 286 and meeting the acceptance criteria of Section 803.1.2.1, shall be permitted to be used where a Class A classification in accordance with ASTM E 84 or UL 723 is required.  
 TABLE 803.9-INTERIOR WALL AND CEILING FINISH REQUIREMENTS BY OCCUPANCY (SPRINKLERED IF NEEDED)


1 PROPOSED FLOOR PLAN  
 1/4" = 1'-0"

No.	Description	Date
1	1st Plan Check	02/13/17
2	2nd Plan Check	04/10/17

Project number  
 Date  
 Drawn by  
 Checked by

Project Number  
 Issue Date  
 Author  
 Checker

Consultant  
 Address  
 Phone  
 Fax  
 e-mail

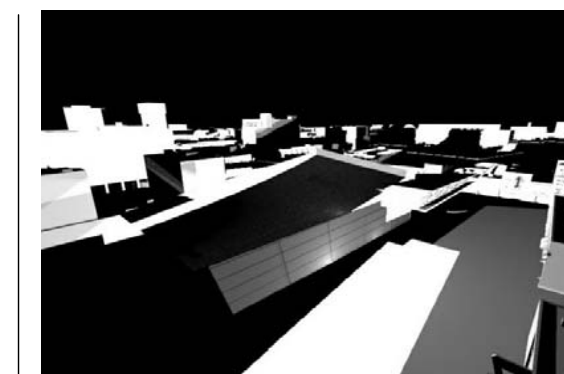


**STITCH STUDIO**  
 Contact: Jorge Escamilla  
 4082 Pomona Street  
 Ventura, California 93003  
 Direct: 818.523.7201  
 Email: info@stitchstudio3d.com

**CANDAMIL RESIDENCE**  
 Remodel to Existing Single Family Dwelling  
 9700 Portada Drive, Whittier, CA  
 PROPOSED FLOOR PLAN

**A202**  
 Scale 1/4" = 1'-0"

00 Keynote Legend

Key Value	Keynote Text
1	Remove and discard existing exterior wall assembly and attached fenestrations as needed, shoring of existing roof shall be installed prior to the removal of existing load bearing walls, shoring and brace walls as needed in order to accommodate the proposed building configuration, refer to waste management guidelines for disposal guidelines for proper waste disposal.
2	Protect in place existing exterior wall assembly in order to accommodate the proposed addition.
3	Remove and discard existing eave and overhang in order to accommodate the proposed addition.
4	Remove and discard existing lighting fixtures and corresponding conduit and wiring, refer to new ceiling plan.
5	Remove and discard existing fenestrations in order to accommodate the proposed improvements.
6	Remove existing fire place mantel in order to accommodate the proposed floor finish, refer to floor plan for additional information.
7	Remove and discard existing ceiling and corresponding ceiling joist in order to accommodate the proposed ceiling configuration and room layouts.
8	Remove and discard existing plaster soffits and corresponding 2x framing.
9	All cutting and patching in the existing building shall be done by the contractor, to provide for exterior load bearing walls and new roof configuration.
10	Contractor shall verify existing conditions at the site and examine adjoining work, identify what will affect the completion of this work, the designer shall be notified in writing should the contractor have questions as to existing condition that will affect the work.
11	Protect in place existing electrical overhead line, provide temporary pole if meter is to be replaced, contractor shall be responsible for all local utility company requirements.
12	
13	Remove and discard existing interior partition, shoring and temporary bracing shall be place at all load bearing walls during the construction phase.
14	Remove and relocate existing electrical pole in order to accommodate the proposed door opening.

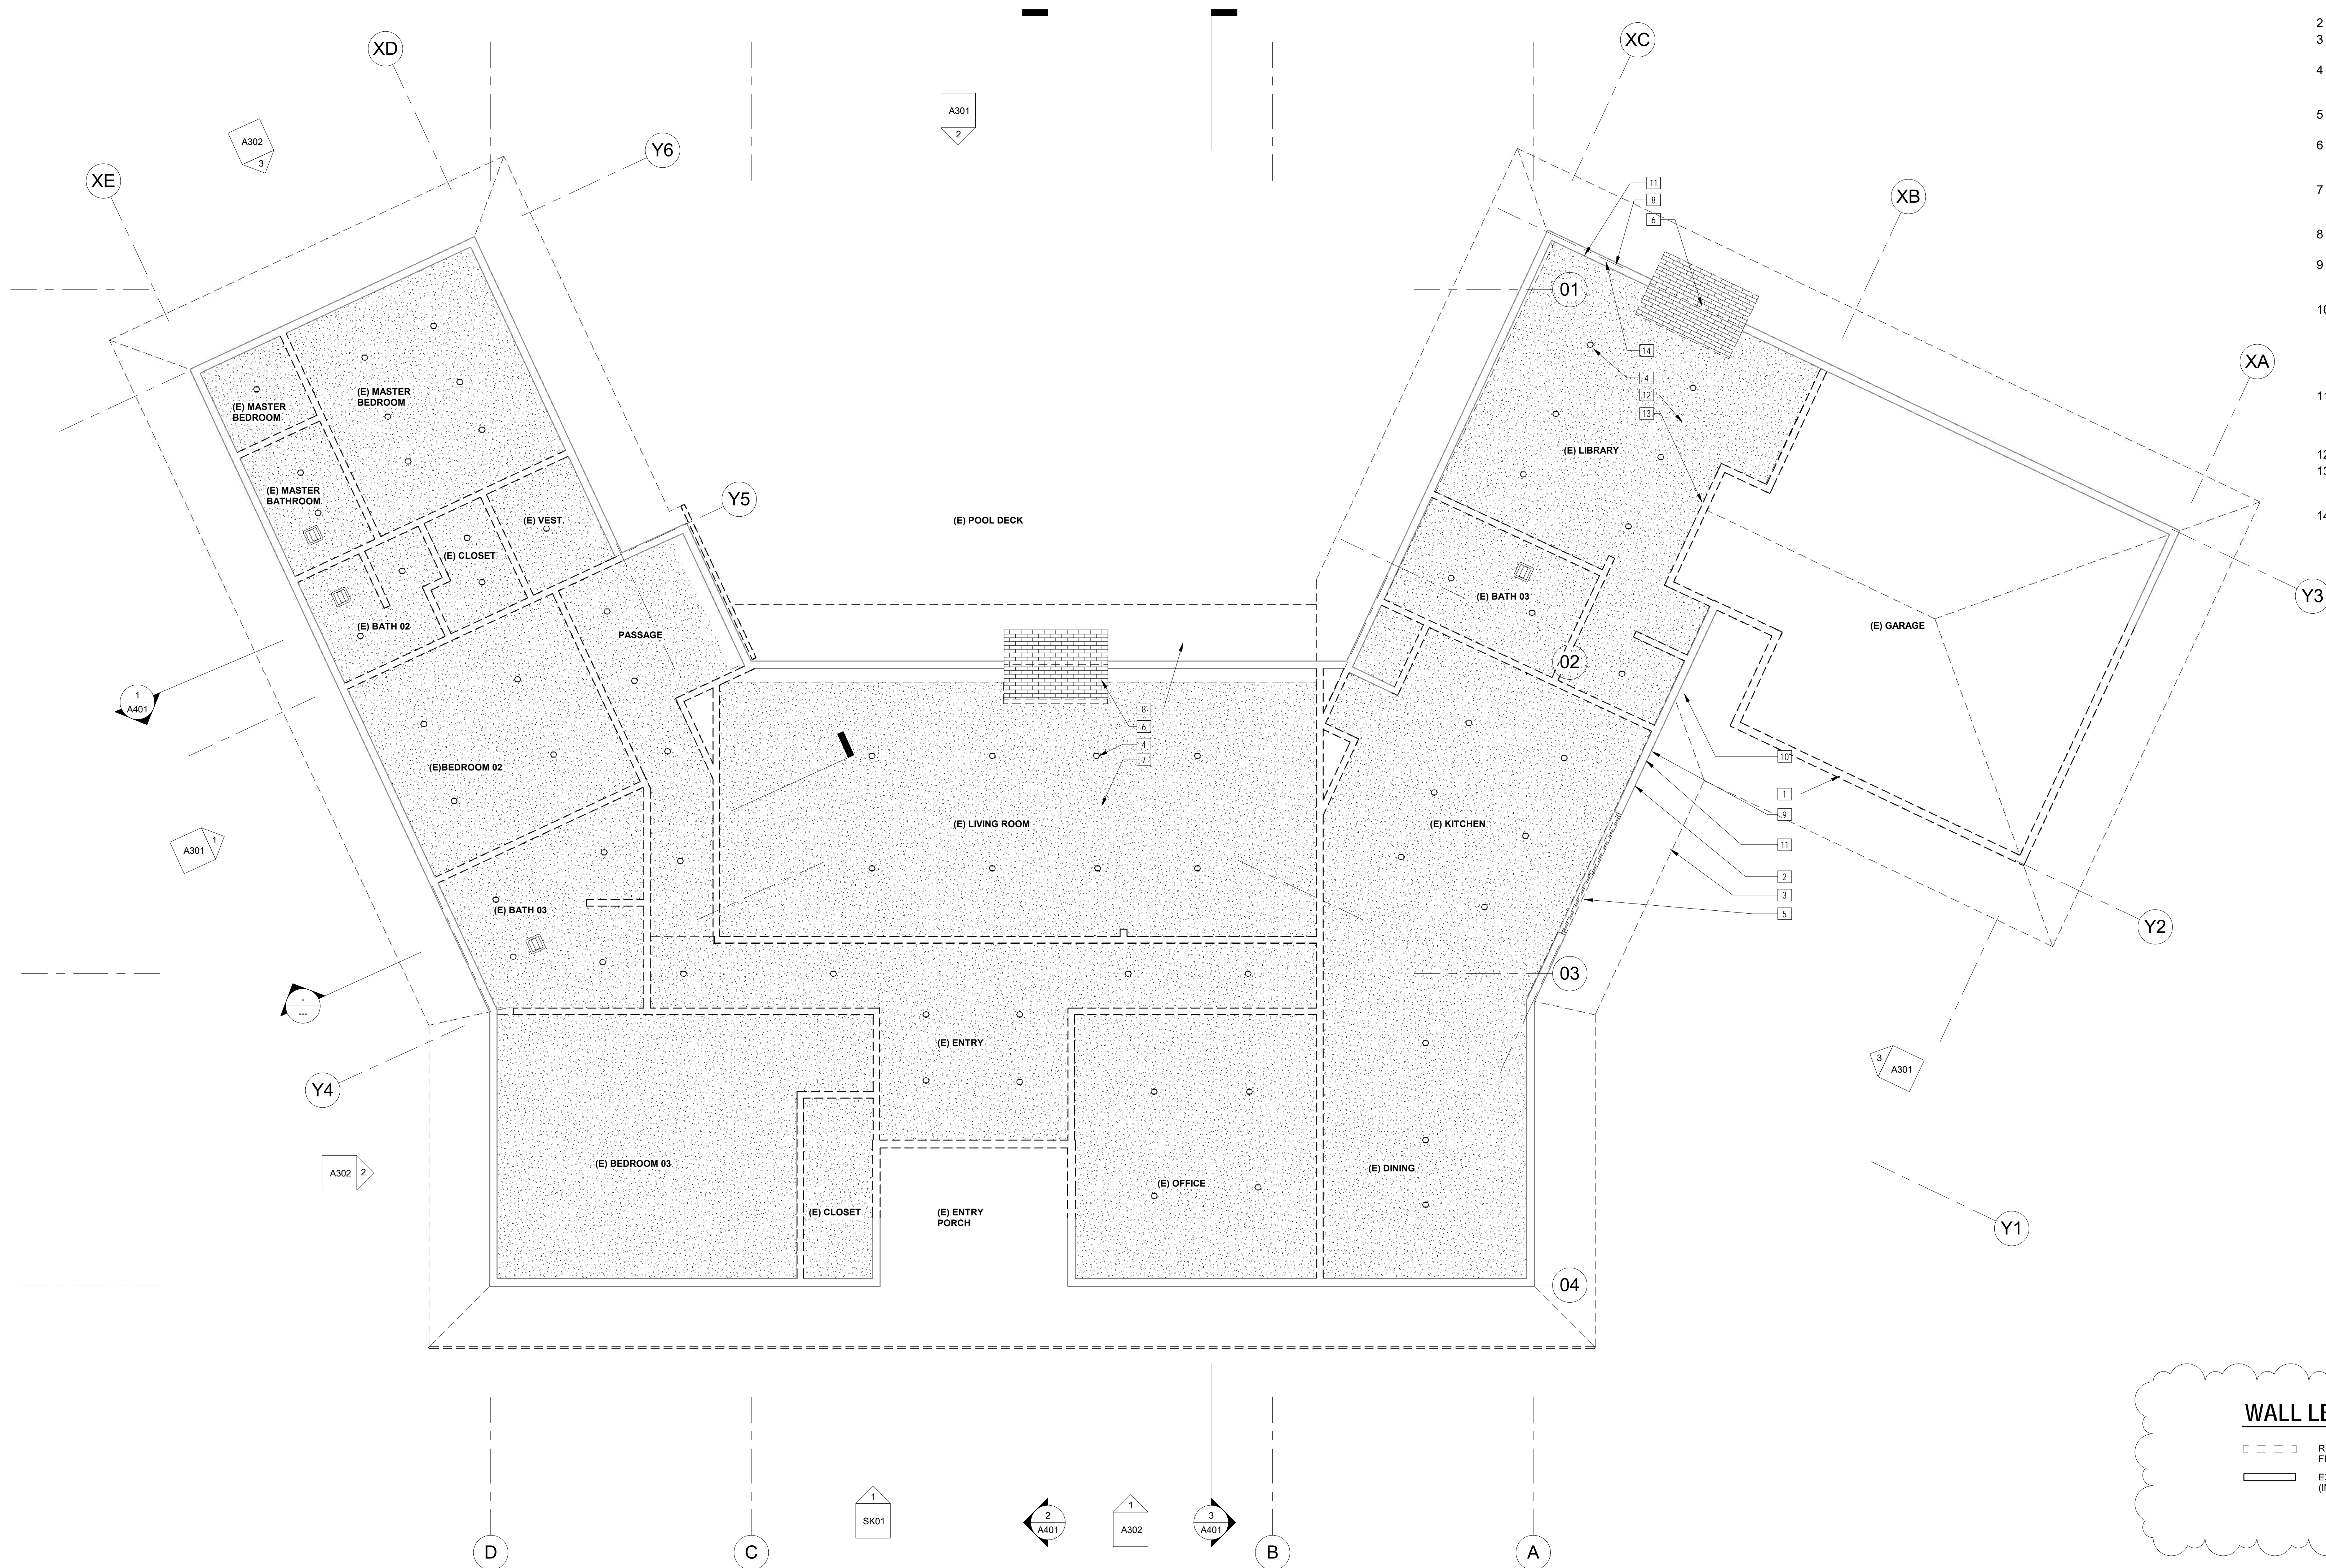

**WALL LEGEND**

- REMOVE AND DISCARD EXISTING WOOD FRAMED STUD WALLS.
- EXISTING 2 X 4 WOOD FRAMED STUD WALL (INTERIOR), PROTECT FRAMING IN PLACE.


00 EXISTING REFLECTED CEILING PLAN  
1/4" = 1'-0"

No.	Description	Date
2	2nd Plan Check	04/10/17

Project number  
Date  
Drawn by  
Checked by

Project Number  
Issue Date  
Author  
Checker

Consultant  
Address  
Phone  
Fax  
e-mail

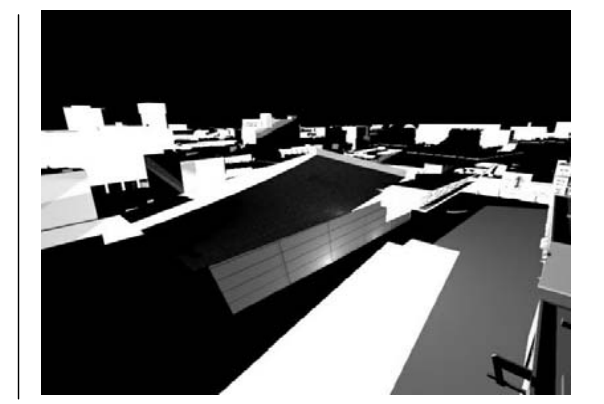

**STITCH STUDIO**  
Contact: Jorge Escamilla  
4082 Pomona Street  
Ventura, California 93003  
Direct: 818.523.7201  
Email: info@stitchstudio3d.com

**CANDAMIL RESIDENCE**  
Remodel to Existing Single Family Dwelling  
9700 Portada Drive, Whittier, CA  
EXISTING REFLECTED CEILING PLAN

**A203**

Scale 1/4" = 1'-0"

00 Keynote Legend	
Key Value	Keynote Text

- 1 Exposed wood decking and rafter tails, prime and paint, color to be owner selected.
- 2 Protect in place existing exterior wall assembly.
- 3 Exterior window assembly. Refer to schedule and window elevations for window configuration.
- 4 22 GA. sheet metal square continuous gutters, color to be owner selected.
- 5 Gypsum board over 2x ceiling joist, tape and mud, finish to be smooth, primed and paint, owner to select color.
- 6 Skylight, installed as per manufacture intallation instructions, use tempered glazing as per residential code glazing standards, provide skylight framing as per Velux details on sheet A203, painted gypsum board, coordinate with structural framing plans.
- 7 Ceiling mounted fan, installed as per manufacture installation instructions, mount to ceiling joist using manufacture approved fasteners.
- 8 Lighting control switches, use dimmable switches at all recessed lighting fixtures.
- 9 Ceiling mounted mechanical return diffuser.
- 10 Proposed interior wall assembly below.
- 11 Rated wall assembly.
- 12 Plumbing wall chase, provide blocking as needed, coordinate with floor plan for fixture location.
- 13 Exterior wall assembly below.
- 14 Recessed lighting fixtures, 4 inch Halo Remodel Airtight IC LED Recessed Light Housing or of equal grade, installed as per manufacture installation instruction.
- 15 Pendant lighting fixtures, add blocking as needed, use manufacture approved mounting fasteners, color and style to be owner selected.
- 16 Fenestrations below as per schedule, refer to floor plan for additional information.
- 17 Wall mounted Sconces as per reflected ceiling plan.
- 18 Smoke detector.
- 19 Roll up garage door shall be mounted to exposed ceiling joist, add tracks and mounting brackets as per manufacture installation instructions, owner to select motor type and remote control options.
- 20 Continuous half round gutter, primed and painted using high gloss exterior paint, provide support as per manufacture installation instructions.
- 21 Downspout to match gutter style and color, installaed as per manufacture installation instruction, fastners shall be installed into plaster walls, protect exterior plaster as suggested by manufacture.
- 22 Wood Columns as per structural drawings.
- 23 Exposed roof members. Paint, stain and seal as per specifications.
- 24 22" x 30", Attic access, installed as per manufacture installation instructions.
- 25 New electrical meter location, Due to the numerous electrical service panel configurations, customers are recommended to contact the local Service Planning Office for details, or contact SCE's EV information hotline at (800) 366-7766.

### REFLECTED CEILING SYMBOLS


- SMOKE DETECTOR HARDWIRED (CRC R314.23, R314 & R315).
- CARBON MONOXIDE ALARM - HARDWIRED (CRC R314.23, R314 & R315).
- EXHAUST FAN (CRC R303.3.1 & CGBC 4.506.1)
- SINGLE POLE SWITCH
- DOUBLE POLE SWITCH
- DUPLEX RECEPTACLE
- GFCI
- GROUND FAULT RECEPTACLE
- TEL/DATA OUTLET
- THERMOSTAT
- RECESSED LIGHTING FIXTURE
- RECESSED LIGHTING FIXTURE (SQUARE)
- WALL MOUNTED LIGHTING FIXTURE
- SURFACE MOUNTED LIGHTING FIXTURE (SQUARE)
- PENDANT LIGHTING FIXTURE (SQUARE)
- CEILING MOUNTED FAN
- RECESSED FLOURESCENT LIGHTING FIXTURE
- SURFACE MOUNTED FLOURESCENT LIGHTING FIXTURE
- AIR SUPPLY REGISTER
- AIR RETURN REGISTER

### WALL LEGEND

- REMOVE AND DISCARD EXISTING WOOD FRAMED STUD WALLS.
- EXISTING 2 X 4 WOOD-FRAMED STUD WALL (INTERIOR)
- PROPOSED 2 X 4 WOOD-FRAMED STUD WALL (INTERIOR)
- 1 HOUR RATED WALL ASSEMBLY.
- 2 X 6 WOOD STUD FRAMED WALL (INTERIOR)
- 2 X 4 WOOD STUD FRAMED WALL (EXTERIOR)
- 2 X 4 WOOD STUD WALL (EXTERIOR - 2 SIDED FINISH)
- MANSORY WALL (SEE STRUCTURAL)
- CIP CONCRETE WALL (Refer to Structural for additional information)

Note:  
Interior finish requirements based on group. Interior wall and ceiling finish shall have a flame spread index not greater than that specified in Table 803.9 for the group and location designated. Interior wall and ceiling finish materials tested in accordance with NFPA 286 and meeting the acceptance criteria of Section 803.1.2.1, shall be permitted to be used where a Class A classification in accordance with ASTM E 84 or UL 723 is required.

TABLE 803.9-INTERIOR WALL AND CEILING FINISH REQUIREMENTS BY OCCUPANCY (SPRINKLERED IF NEEDED)

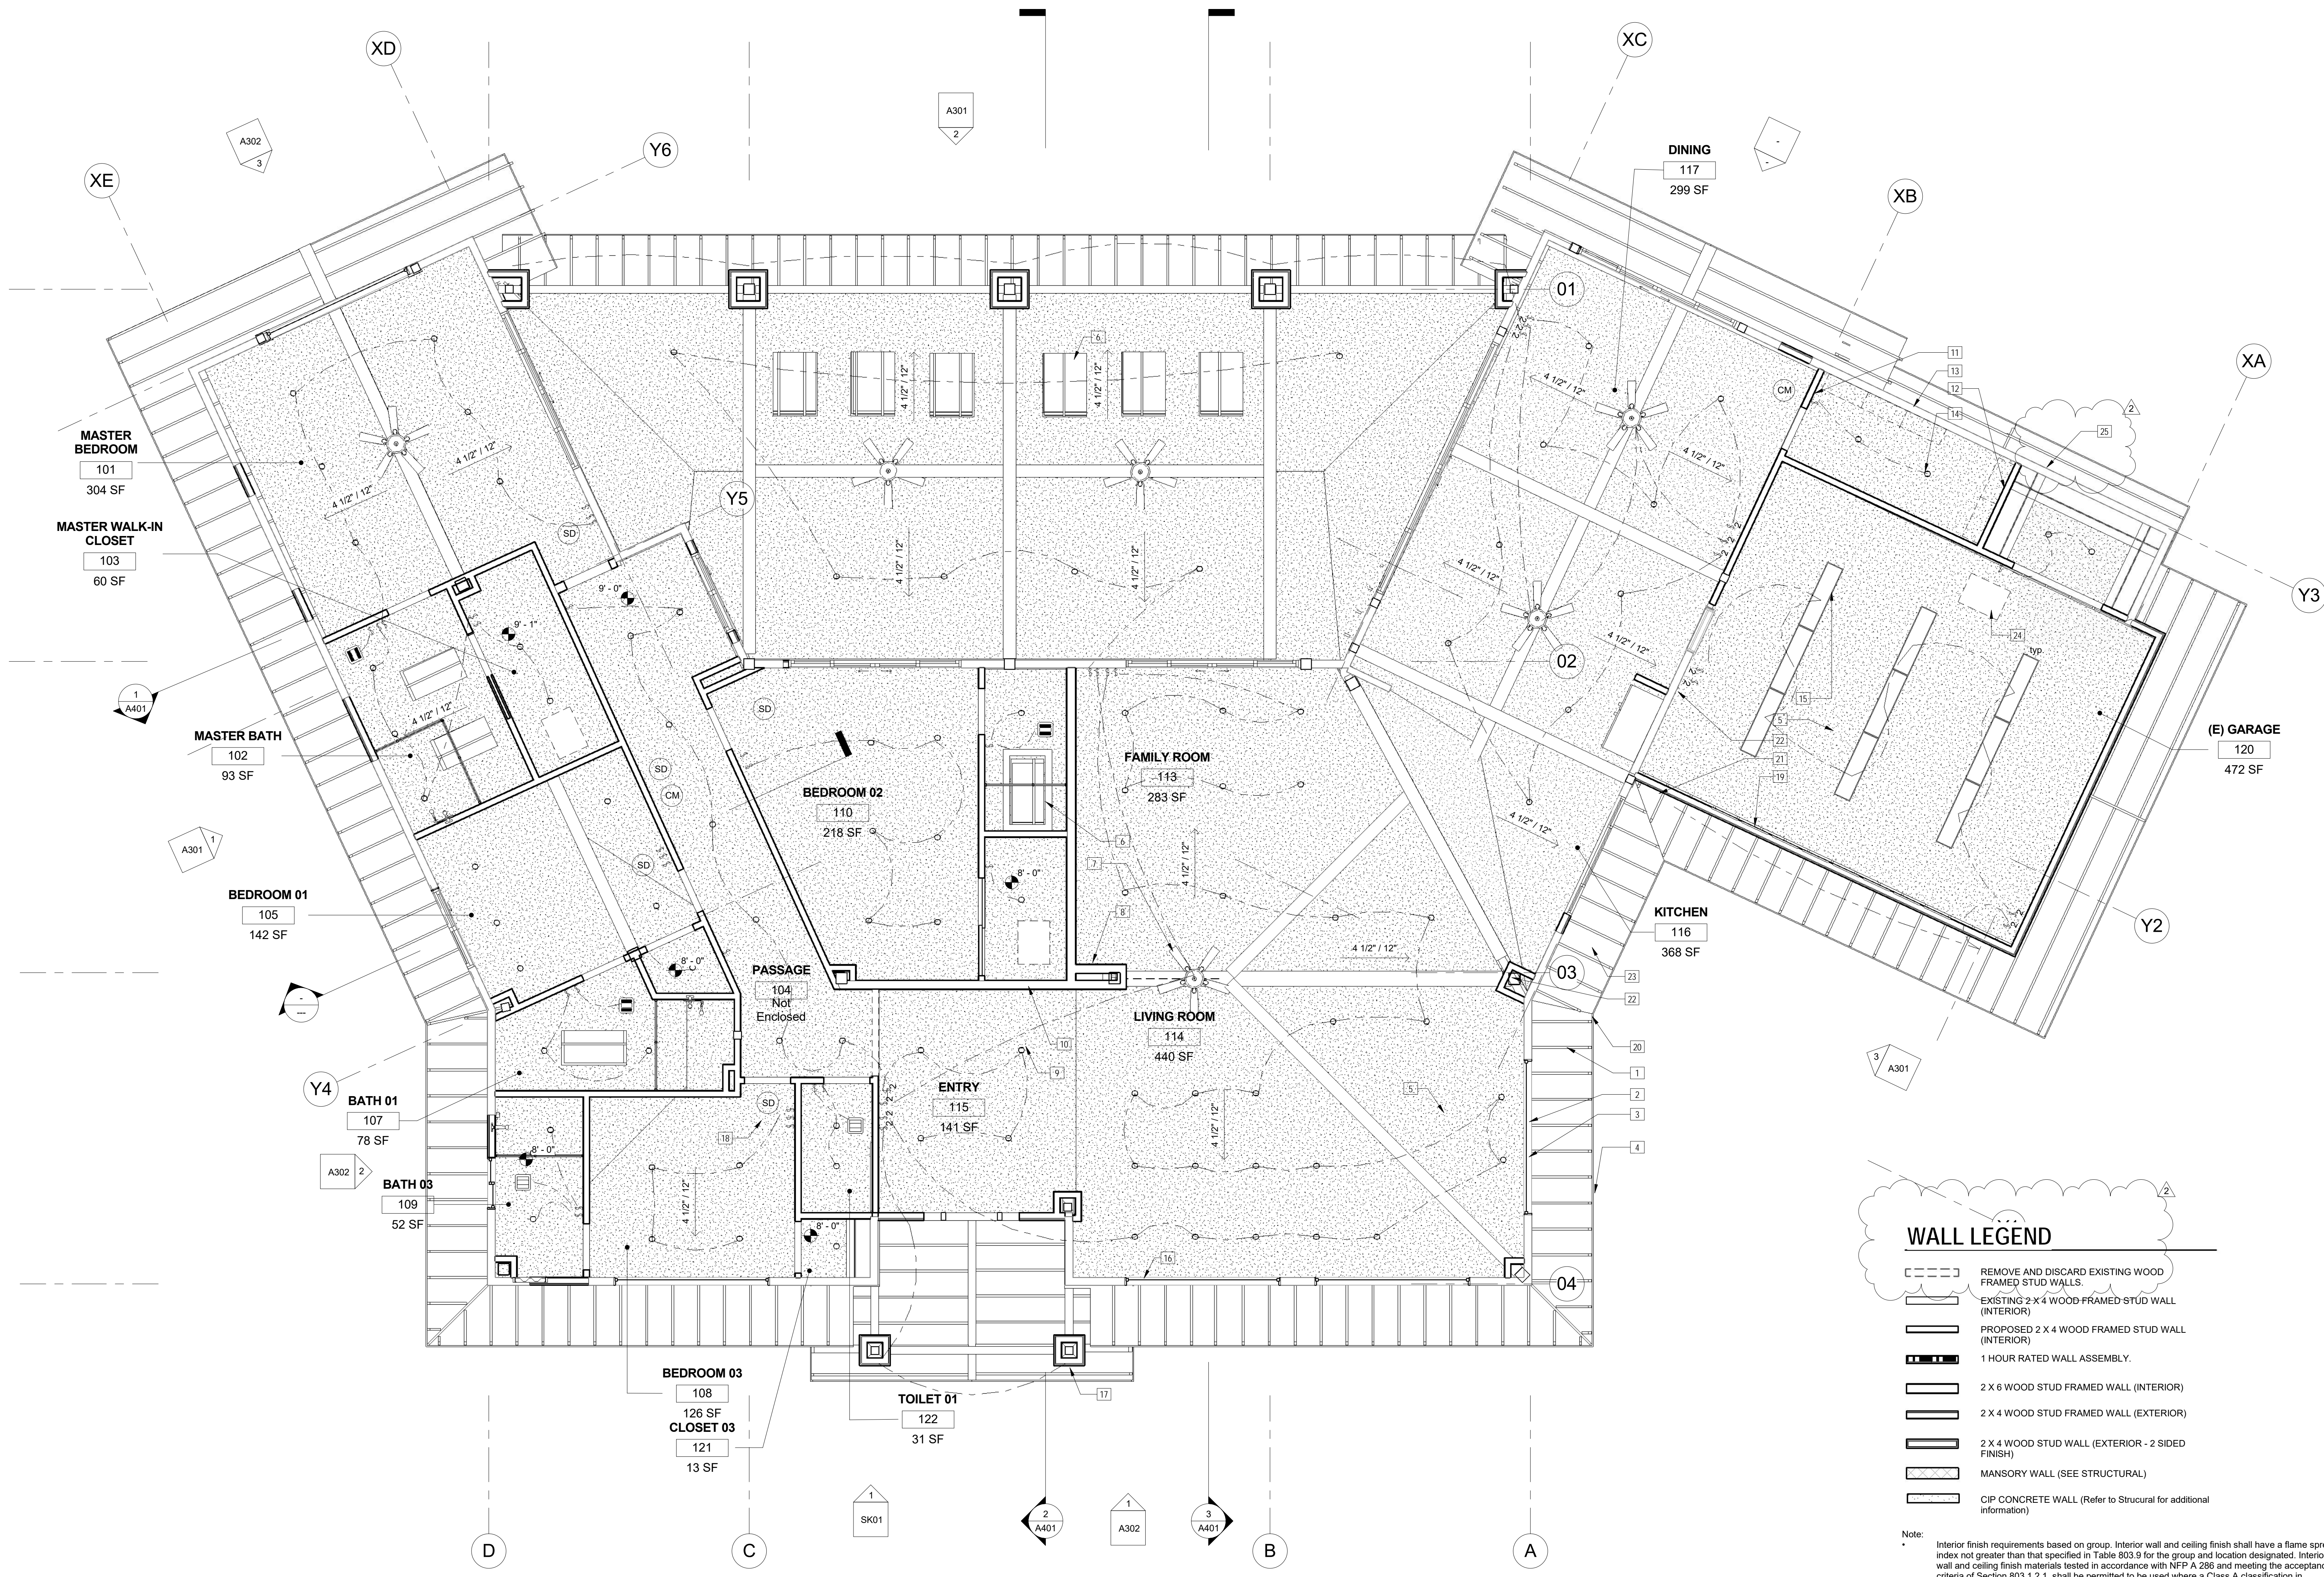

1 PROPOSED REFLECTED CEILING PLAN  
1/4" = 1'-0"


No.	Description	Date
1	1st Plan Check	02/13/17
2	2nd Plan Check	04/10/17

Project number  
Date  
Drawn by  
Checked by

Project Number  
Issue Date  
Author  
Checker

Consultant  
Address  
Phone  
Fax  
e-mail

Contact: Jorge Escamilla  
4082 Pomona Street  
Ventura, California 93003  
Direct: 818.523.7201  
Email: info@stitchstudio3d.com

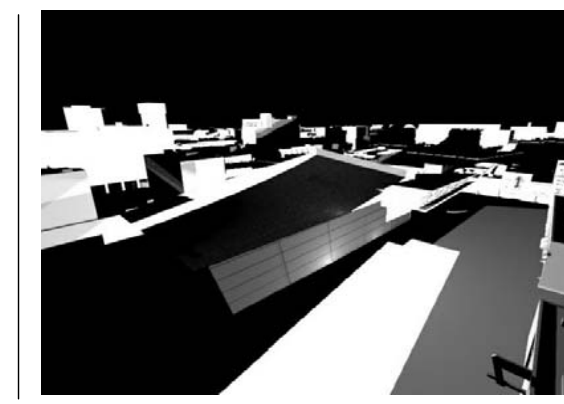


**STITCH STUDIO**

**CANDAMIL RESIDENCE**  
Remodel to Existing Single Family Dwelling  
9700 Portada Drive, Whittier, CA  
PROPOSED REFLECTED CEILING PLAN

**A204**

00 Keynote Legend

Key Value	Keynote Text
1	Remove and discard existing exterior wall assembly and attached fenestrations as needed, shoring of existing roof shall be installed prior to the removal of existing load bearing walls, shoring and brace walls as needed in order to accommodate the proposed building configuration, refer to waste management guidelines for disposal guidelines for proper waste disposal.
2	Remove and discard existing fenestrations in order to accommodate the proposed improvements.
3	Remove and discard existing electrical conduit and corresponding wiring, reroute in order to accommodate the proposed ceiling.
4	Remove and relocate existing electrical pole in order to accommodate the proposed door opening.
5	Remove and discard existing interior partition, shoring and temporary bracing shall be place at all load bearing walls during the construction phase.
6	Remove and discard existing eave and overhang in order to accommodate the proposed addition.
7	Remove and discard existing ceiling and corresponding ceiling joist in order to accommodate the proposed ceiling configuration and room layouts.
8	Remove and discard existing concrete slate roofing system, plywood sheathing, roof rafters in order to accommodate the proposed light weight concrete slate roofing system, refer to roof plan for additional information.
9	Remove existing fire place mantel in order to accommodate the proposed floor finish, refer to floor plan for additional information.
10	Remove and relocate roof stack vents as per proposed roof configuration.
11	Remove and discard existing fireplace and chimney in its entirety, cap and disconnect gaslines in order to accommodate the proposed improvements.
12	Remove and discard existing light weight tile system.
13	Protect in place existing exterior wall assembly.
14	Remove and discard existing plaster soffits and corresponding 2x framing.
15	Remove and discard existing roofing system, sheathing and roof rafters, add shoring and bracing at all exterior load bearing walls during the construction phase.

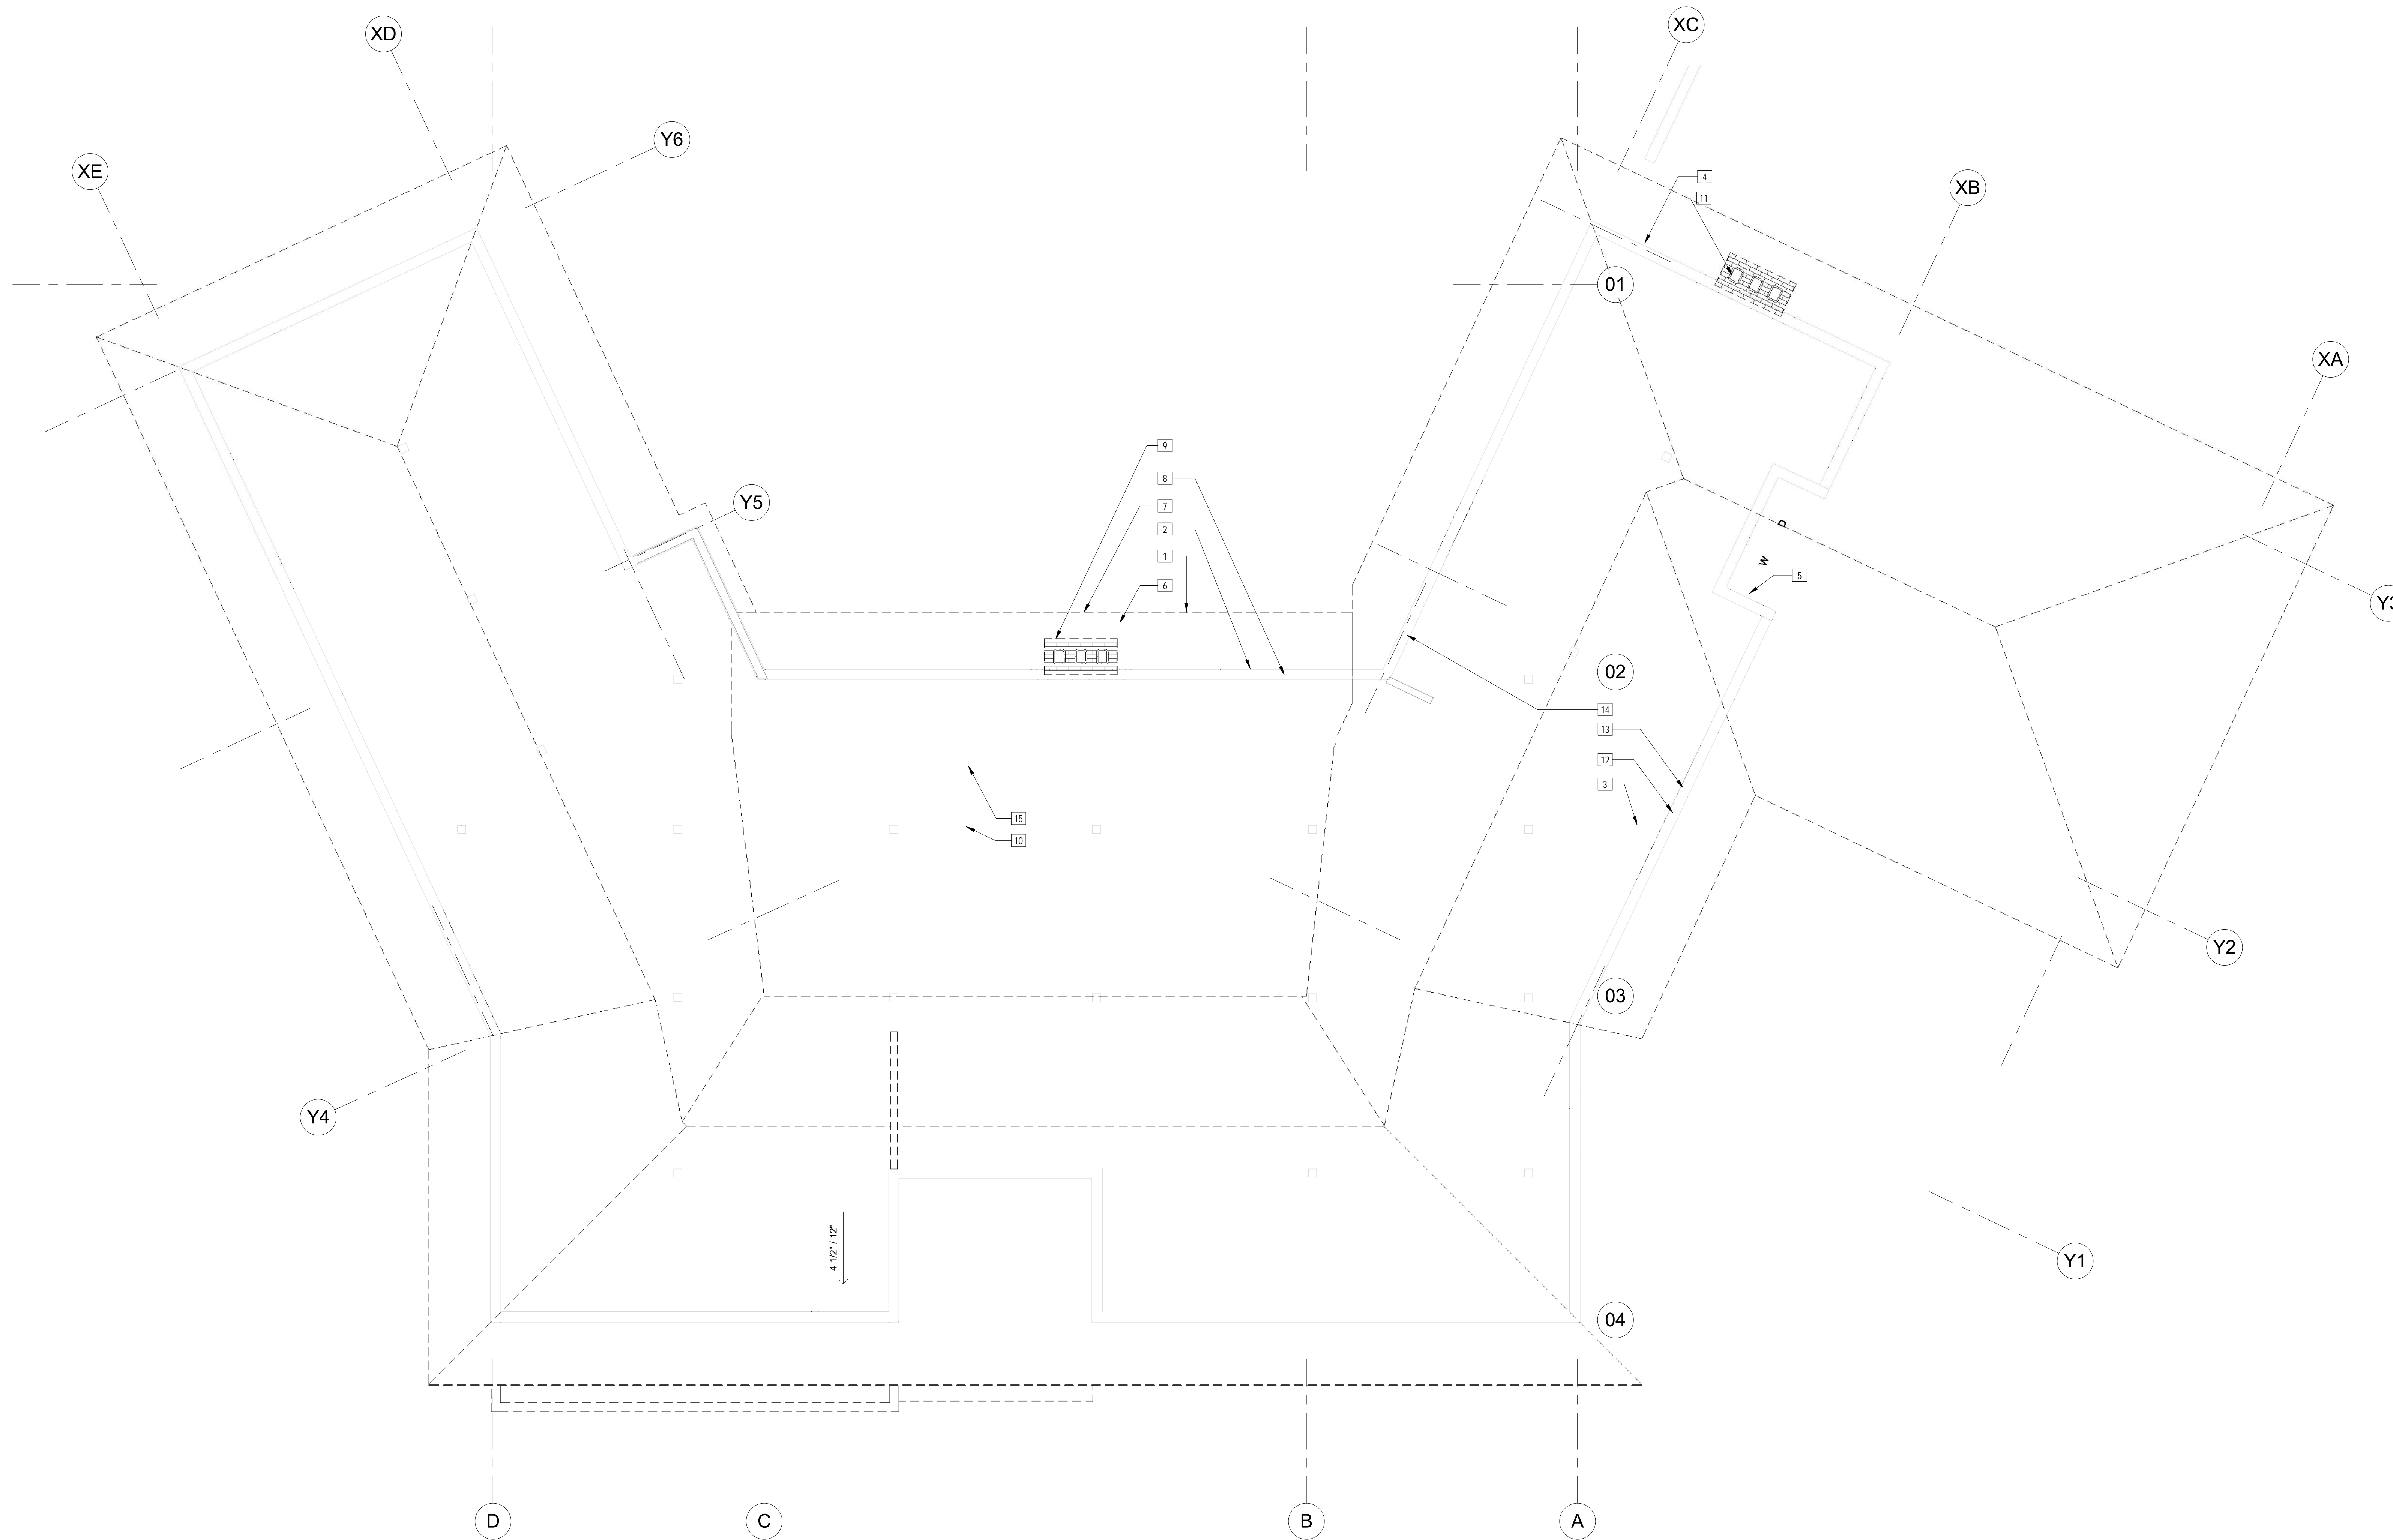


1 00 EXISTING ROOF PLAN  
1/4" = 1'-0"

No.	Description	Date

Project number  
Date  
Drawn by  
Checked by

Project Number  
Issue Date  
Author  
Checker

Consultant  
Address  
Phone  
Fax  
e-mail

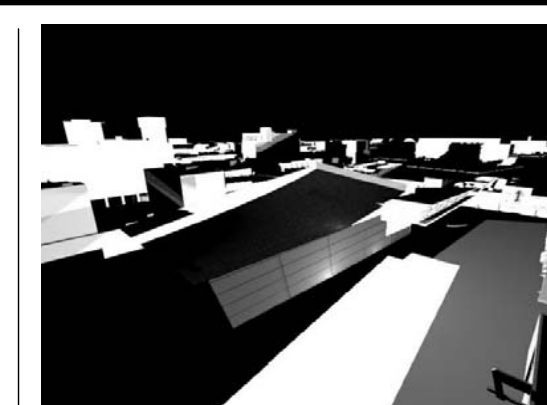

**STITCH  
STUDIO**  
Contact: Jorge Escamilla  
4082 Pomona Street  
Ventura, California 93003  
Direct: 818.523.7201  
Email: info@stitchstudio3d.com

**CANDAMIL RESIDENCE**

Remodel to Existing Single Family Dwelling

9700 Portada Drive, Whittier, CA

ROOF PLAN (Existing)


**A205**

Scale 1/4" = 1'-0"



00 Keynote Legend

Key Value	Keynote Text
1	O'hagin Low profile attic roof mounted vents, Tapered Low-Profile, color to match roof color, installed as per manufacture installation instructions.
2	Roof rafters as per structural framing plan.
3	22 GA. sheet metal square continuous gutters, color to be owner selected.
4	Overhang shall be assemble using 1 hour construction.
5	Ridge ventilation, installed as per manufacture installation instructions.
6	Proposed Skylights VELUX Venting Tempered Skylight (VCM) or of equal grade, -Typ. install as per manufactures installation instructions (see detail #9 on sheet A601).
7	Flashing as required.
8	Downspout, color and style to match existing.
9	1x wood fascia, profile to match existing main dwelling, color to be owner selected.
10	Line of building beyond.
11	Clay roof tiles, Similar grade to Ponderosa color tile by Eagle Roofing Products Co.; Concrete Roof Tiles and Accessories, ASTM C 1492, Standard Specification for Concrete Roof Tile, Roofing tile materials and installation shall conform to the requirements of IAPMO ER 1900 and LA RR 25021, and the 2015 Concrete and Clay Roof Tile Installation Manual, installed as per manufacture installation instructions.

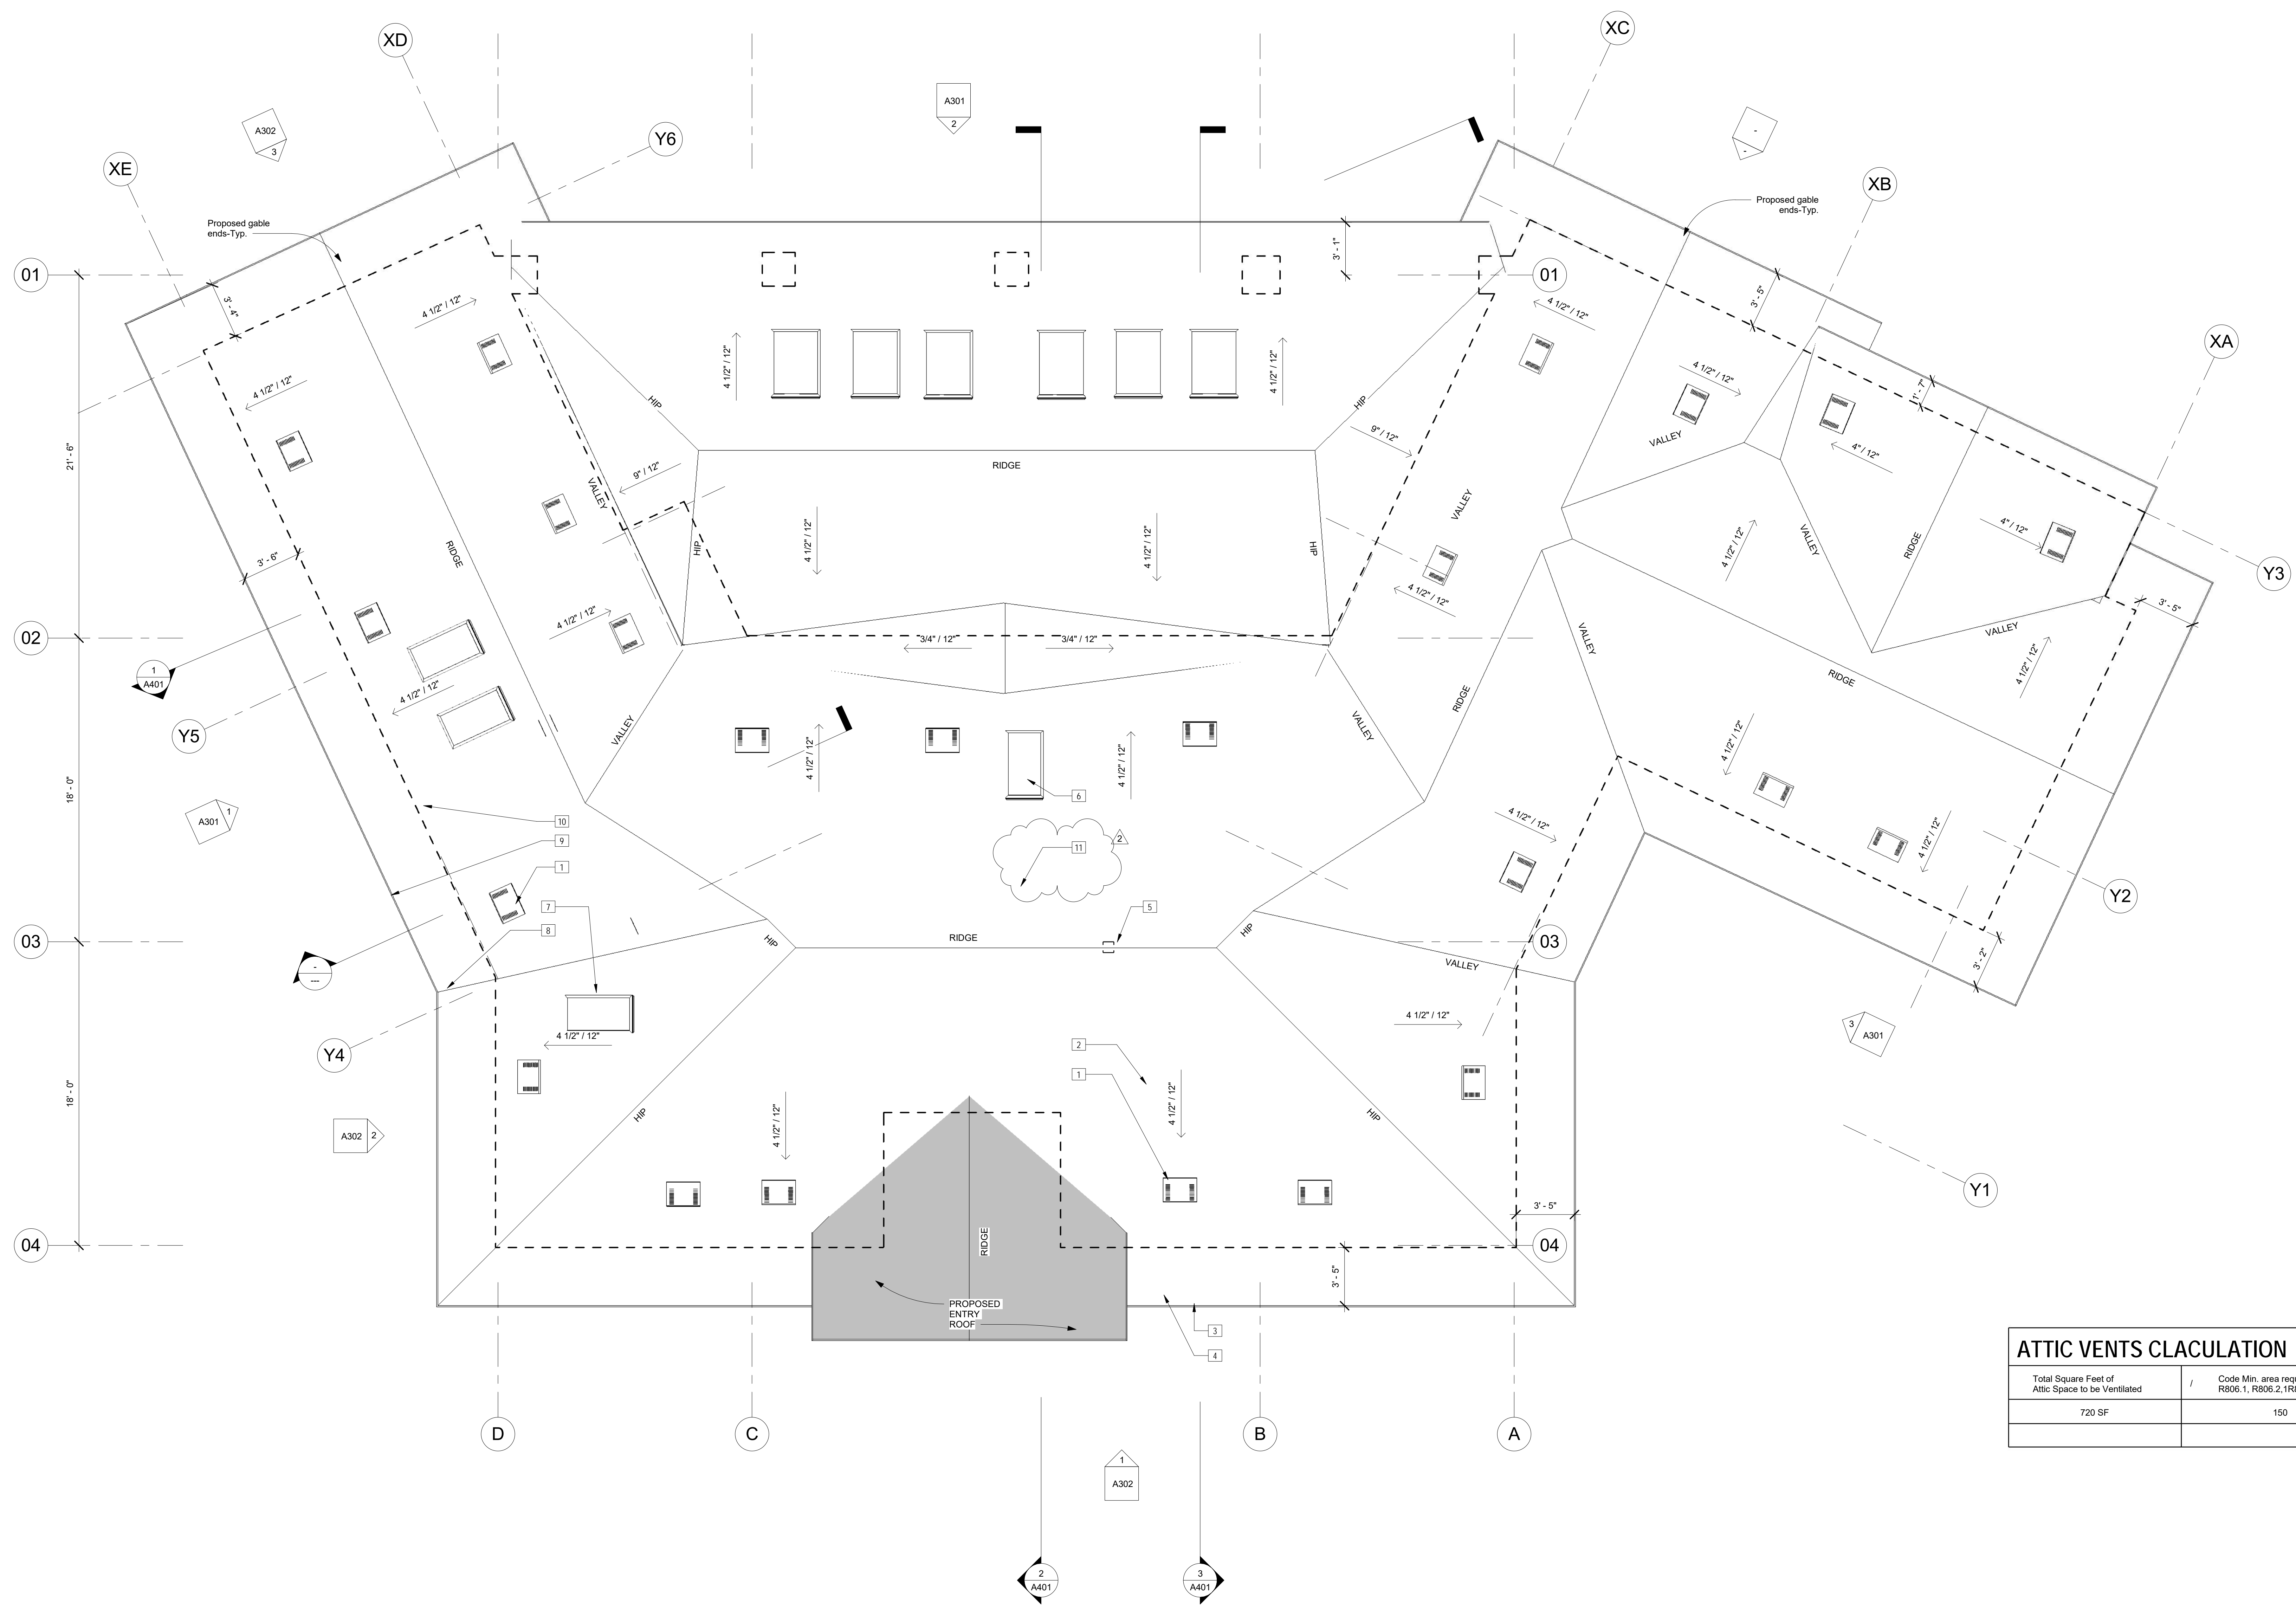

Total Square Feet of Attic Space to be Ventilated	Code Min. area requirements - R806.1, R806.2, 1R806.3	Total Square Feet of Code-Required Ventilation	Provided area (O'Hagan Low-profile vents- or equal).
720 SF	150	= 4.8 SF = 691.2'	12 vents @ 72sq. in. each = 864 sq. in.


PROPOSED ROOF PLAN  
1/4" = 1'-0"

No.	Description	Date
2	2nd Plan Check	04/10/17

Project number  
Date  
Drawn by  
Checked by

Project Number  
Issue Date  
Author  
Checker

Consultant  
Address  
Address  
Phone  
Fax  
e-mail

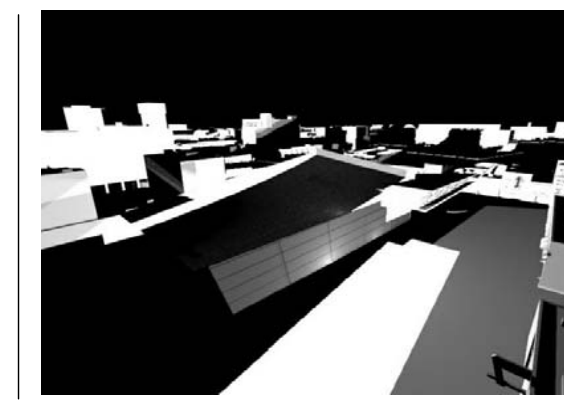


**STITCH STUDIO**  
Contact: Jorge Escamilla  
4082 Pomona Street  
Ventura, California 93003  
Direct: 818.523.7201  
Email: info@stitchstudio3d.com

**CANDAMIL RESIDENCE**  
Remodel to Existing Single Family Dwelling  
9700 Portada Drive, Whittier, CA


PROPOSED ROOF PLAN

**A206**


Scale As indicated

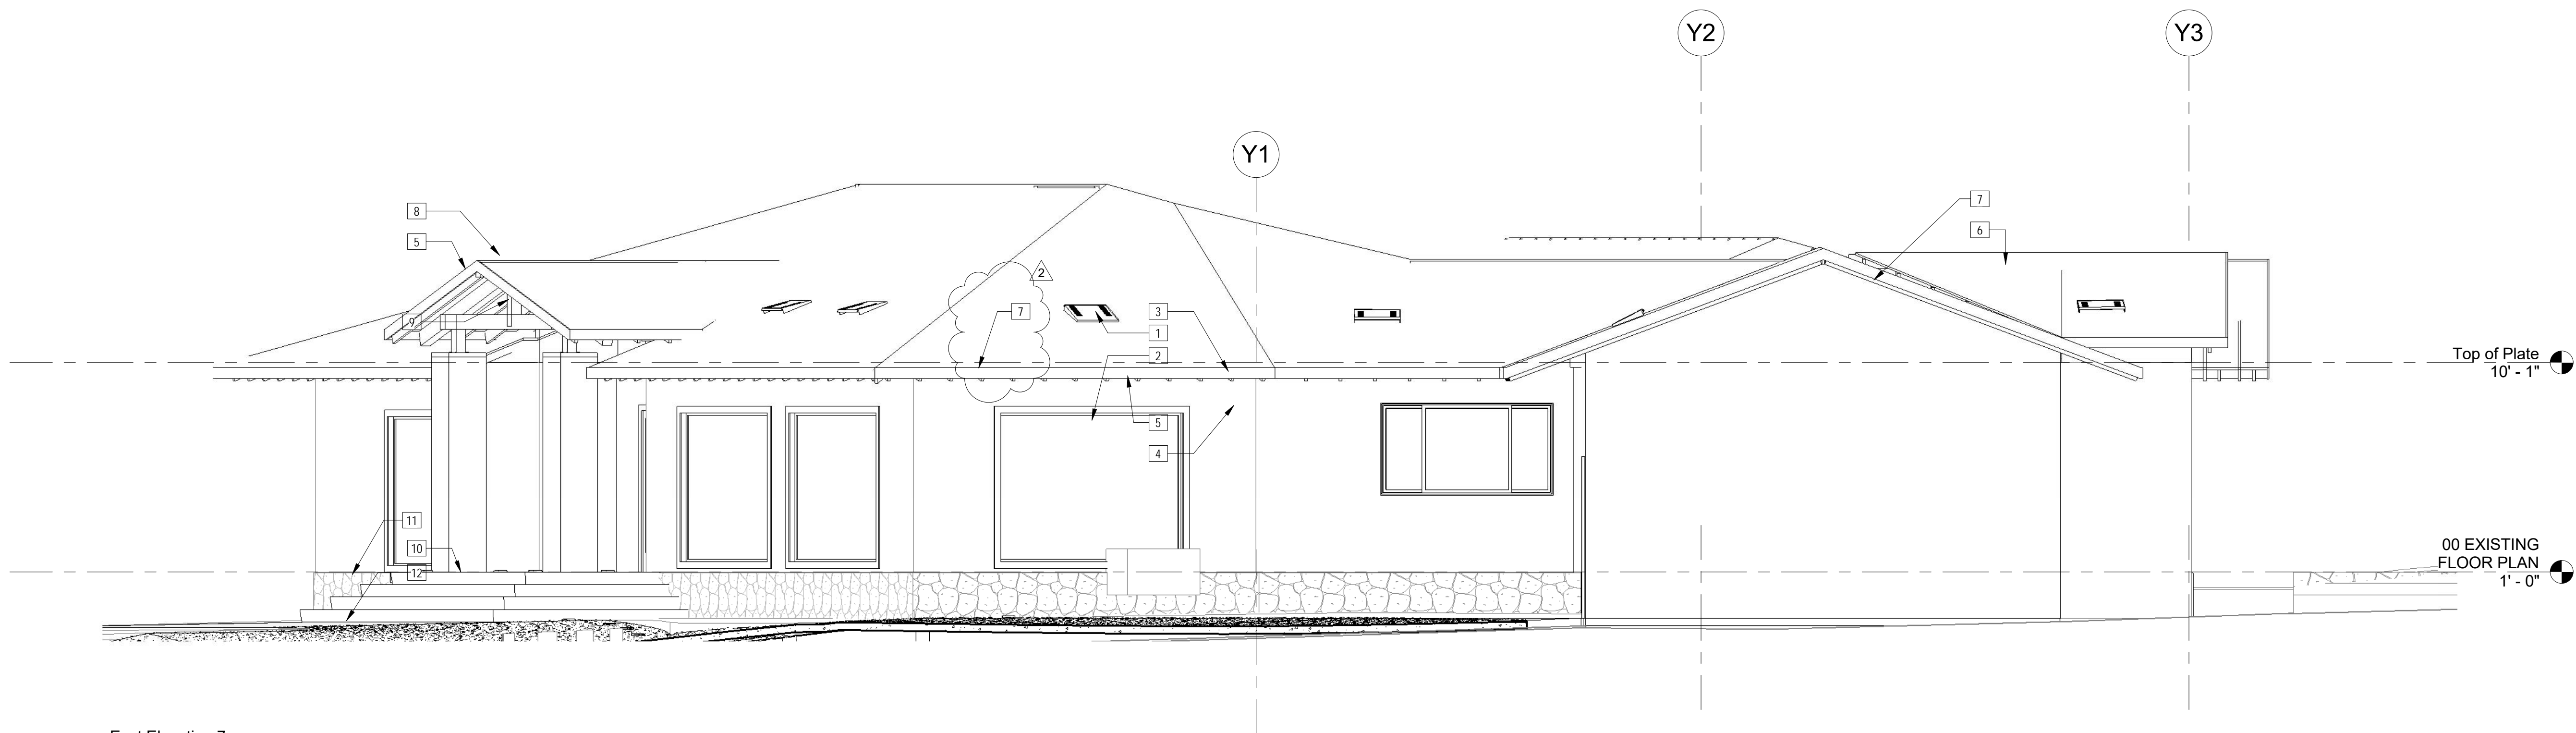

3 East Elevation 7 - a  
1/4" = 1'-0"

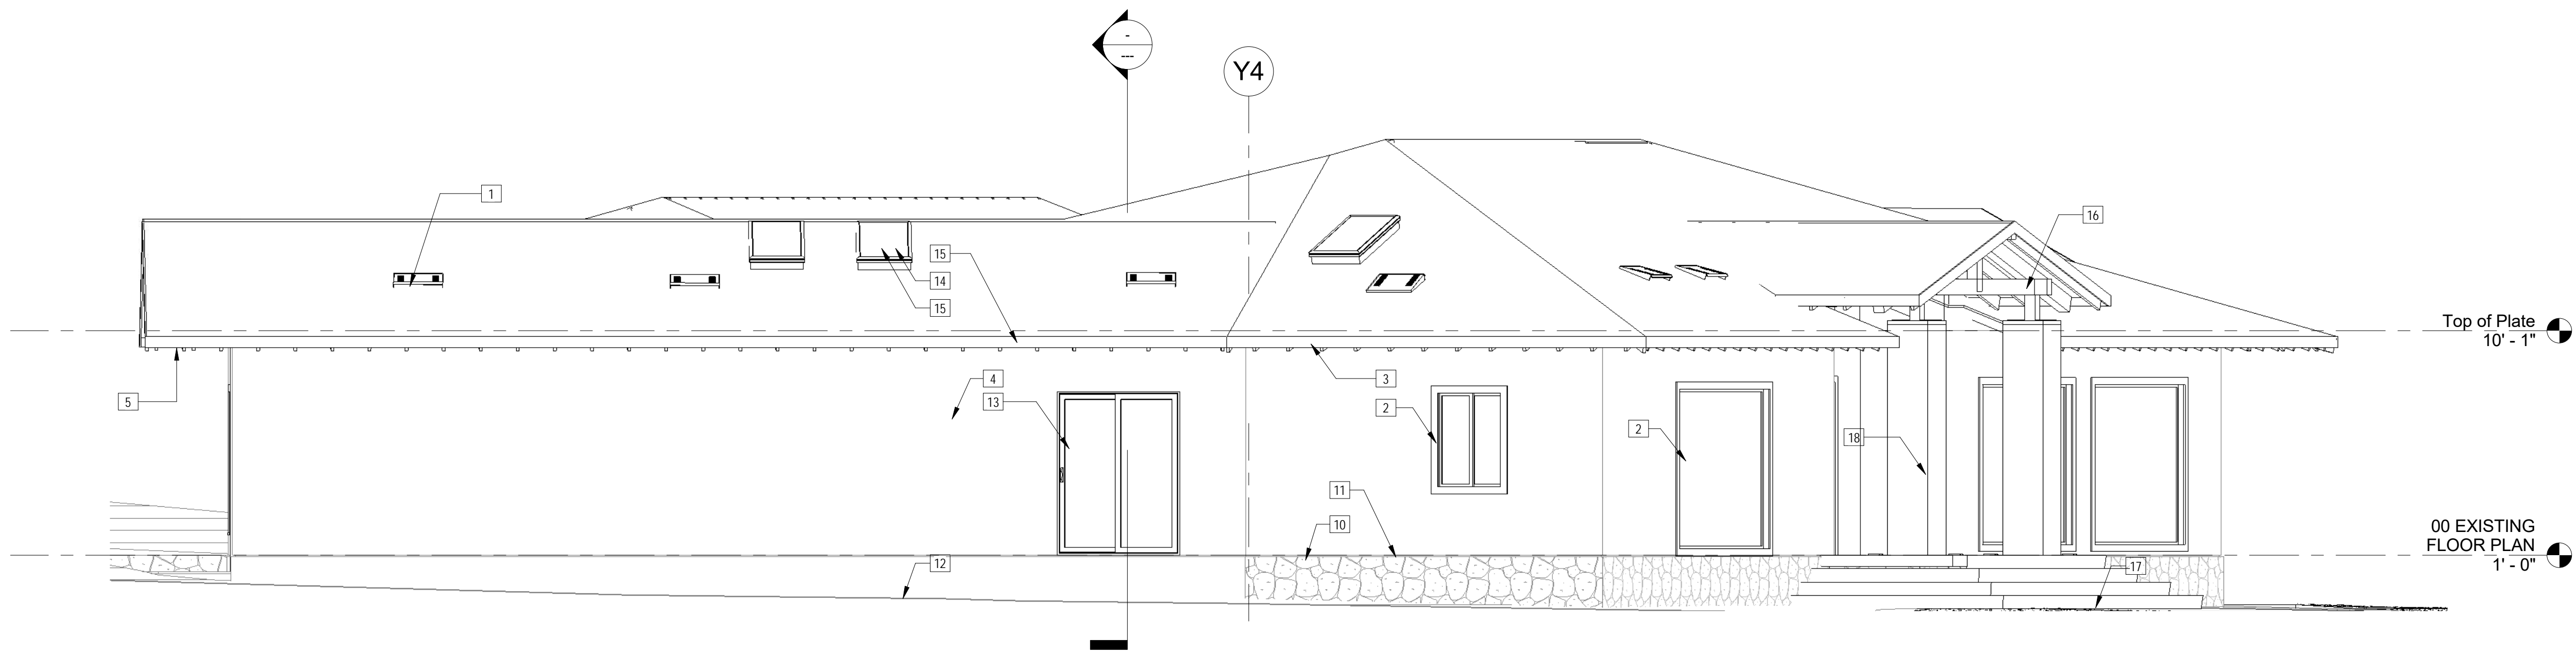

1 West Elevation 1 - a  
1/4" = 1'-0"

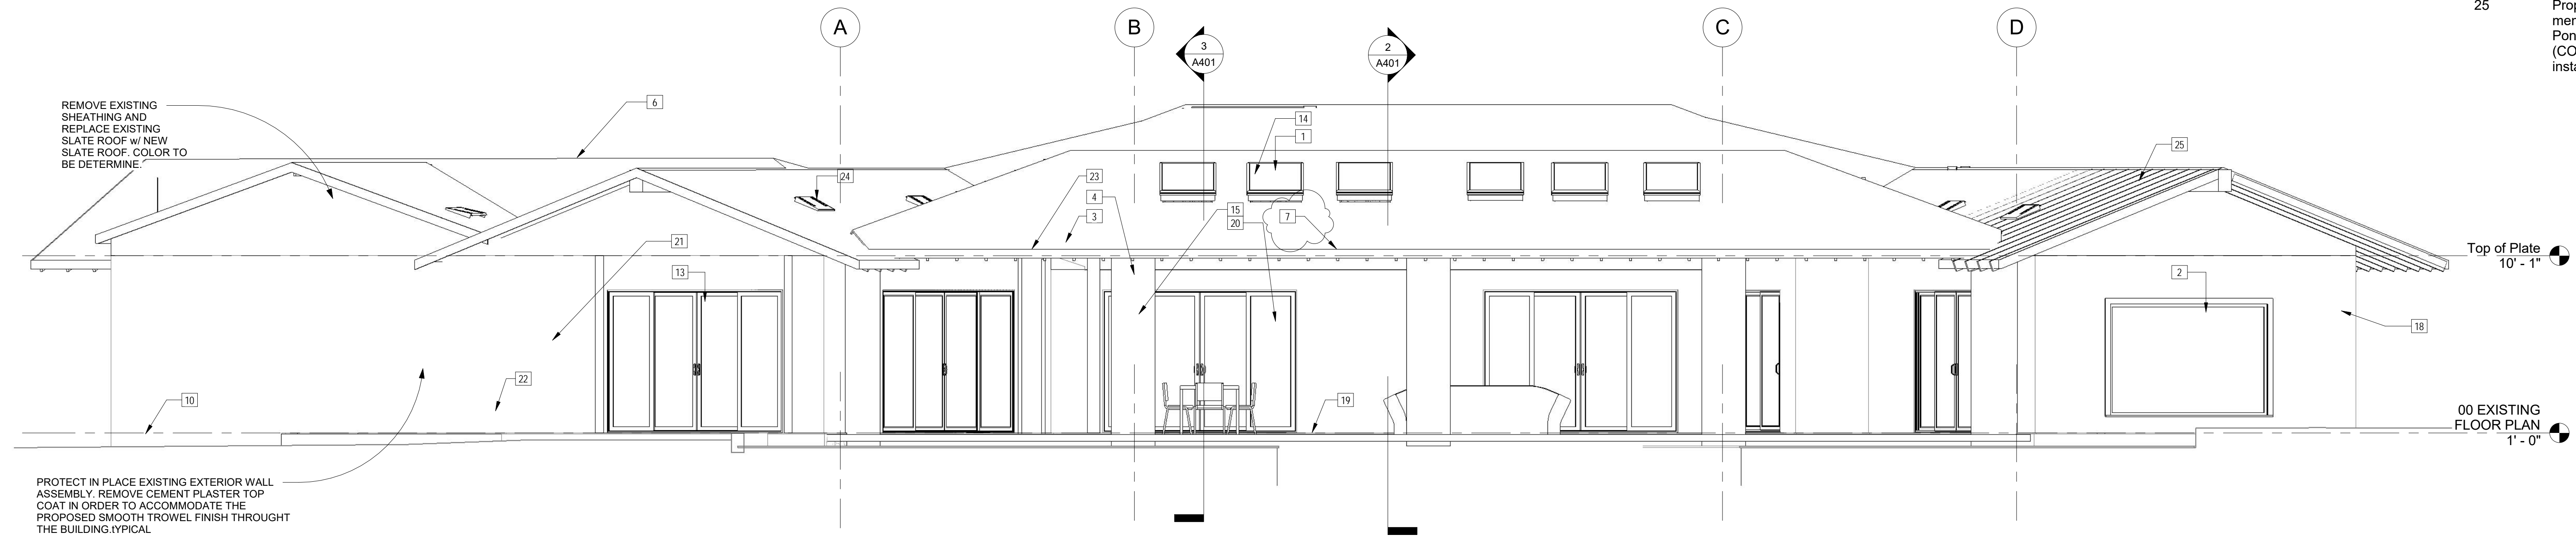

2 North Elevation 3 - a  
1/4" = 1'-0"


- 00 Keynote Legend
- | Key Value | Keynote Text   |
|-----------|--|
| 1         | O'haggin Low profile attic roof mounted vents, Tapered Low-Profile, color to match roof color, installed as per manufacture installation instructions..  |
| 2         | Window assembly as per window schedule, Vinyl sliding, white, U-factor .   |
| 3         | Painted steel gutter and downspout, color to match existing.   |
| 4         | Exterior cement plaster system, smooth texture finish, color to match LaHabra Stucco Finish, Base200, X-23 Aspen, Parex USA, over DuPont, Tyvek® Stucco Wrap, WRB or of equal grade, sheathing as per structural drawings.   |
| 5         | Overhangs to match existing, prepare, prime and paint all exposed wood members, colors shall be similar to EVERSHIELD® is a complete line of ultra premium exterior, ultra-low VOC, 100 percent acrylic paint by DUNN-EDWARDS, or of equal grade.  |
| 6         | Building beyond.   |
| 7         | 2x Trims and 2 x 8 rough sawn, painted facia primed and paint all exposed wood members, colors shall be similar to EVERSHIELD is a complete line of ultra premium exterior, ultra-low VOC, 100 percent acrylic paint by DUNN-EDWARDS, or of equal grade.   |
| 8         | Clay roof tiles, Similar grade to Ponderosa color tile by Eagle Roofing Products Co.; Concrete Roof Tiles and Accessories, ASTM C 1492, Standard Specification for Concrete Roof Tile, Roofing tile materials and installation shall conform to the requirements of IAPMO ER 1900 and LA RR 25021, and the 2015 Concrete and Clay Roof Tile Installation Manual, installed as per manufacture installation instructions. |
| 9         | Exposed roof members: Paint, stain and seal as per specifications.   |
| 10        | Provide raised floor ventilation Foundation Vents, 9" high x 18" long, vinyl or sheet metal, net free area 57 inches, installed as per manufacture installation instructions.  |
| 11        | Sawcut existing exterior plaster system at base location in order to accommodate the proposed stone veneer wainscote, refer to exterior elevations for additional information.   |
| 12        | Protect in place existing grade, Back-fill shall be slope to drain away from the building for a minimum of 6 inches of fall for the first 10 feet horizontal to an approved drainage course, Typical, refer to CRC-R401_3.   |
| 13        | Door as per schedule.  |
| 14        | 22" wide x 46" long skylight similar to Velux FSM, aluminum exterior finish or of equal grade, Intall as per manufacture installation instructions.  |
| 15        | Downspout to match gutter style and color, installed as per manufacture installation instruction, fastners shall be installed into plaster walls, protect exterior plaster as suggested by manufacture.  |
| 16        | Exposed wood timber shall be similar to EXPOSED TIMBER, STAINED General Finishes- Exterior 450 Wood Stains premium quality, exterior pigmented stains designed for outdoor_COLOR (Olde Cherry).  |
| 17        | Remove and discard existing landscaping, lawn, sprinklers and relevant site work accordingly.  |
| 18        | Smooth trowel finish plaster, color shall be similar to LaHabra X23 Aspen Base 200, or similar to SHERWIN-WILLIAMS ALBASTER SW7008, Trims and exposed wood shall be similar to WOOD TRIMS AND FACIA BOARDS: COLOR: SHERWIN-WILLIAMS WHITE DUCK SW7010.   |
| 19        | Concrete floor slab, slope to drain.   |
| 20        | Sliding glass door, intalled as per manufacture installation instructions, provide flashing and sheet metal pan as per manufacture intallation instructions, seal perimeter as needed.   |
| 21        | Wall mounted Sconces as per reflected ceiling plan.  |
| 22        | Condensor unit as per plan.  |
| 23        | Continuous half round gutter, primed and painted using high gloss exterior paint, provide support as per manufacture installation instructions.  |
| 24        | O'haggin Low profile attic roof mounted vents, Tapered Low-Profile, color to match roof color, installed as per manufacture installation instructions.   |
| 25        | Proposed concrete clay tile roofing system over water proofing membrane, Flat roof tiles, Similar grade to Eagle, Color similar to Ponderosa Description, Rosy Brown, Dark Brown Streaks (COLOR 5557 Live Oak), installed as per manufacture installation instructions.  |

No.	Description	Date
2	2nd Plan Check	04/10/17

Project number  
Date  
Drawn by  
Checked by

Project Number  
Issue Date  
Author  
Checker

Consultant  
Address  
Phone  
Fax  
e-mail

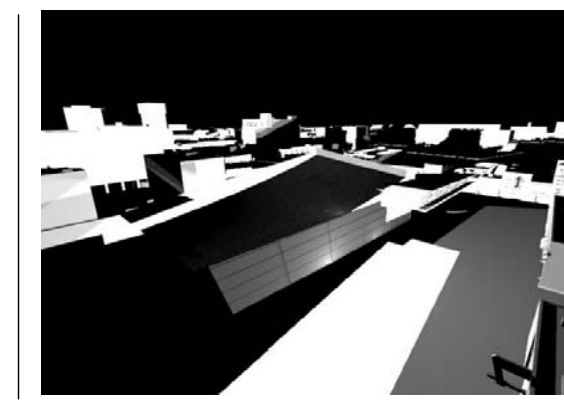


**STITCH  
STUDIO**

Contact: Jorge Escamilla  
4082 Pomona Street  
Ventura, California 93003  
Direct: 818.523.7201  
Email: info@stitchstudio3d.com


**CANDAMIL RESIDENCE**  
Remodel to Existing Single Family Dwelling  
9700 Portada Drive, Whittier, CA  
EXTERIOR ELEVATIONS

**A301**

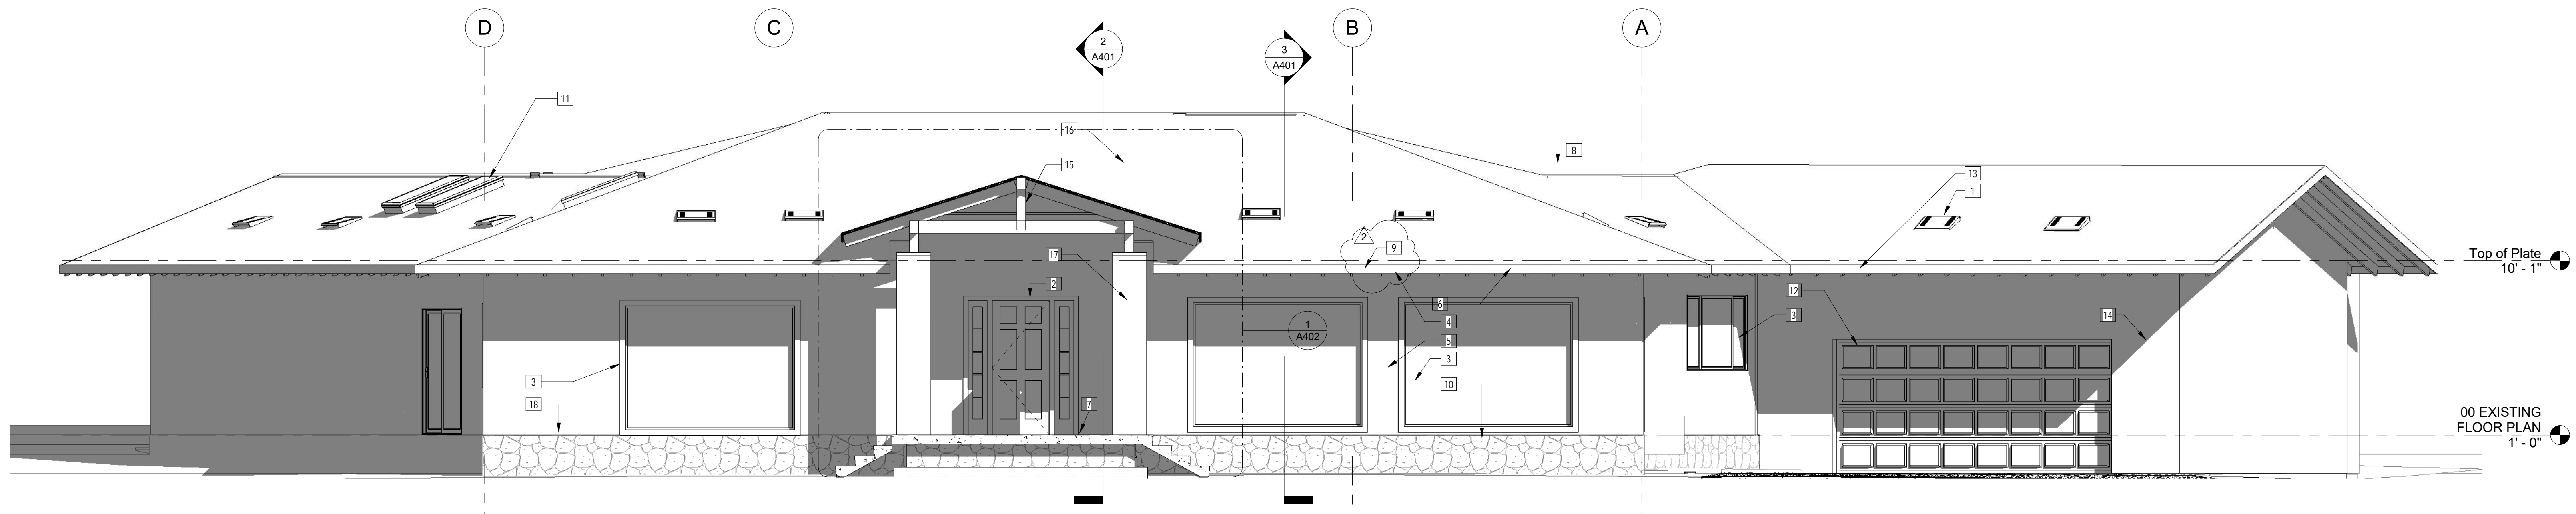


1 South Elevation 9 - a  
1/4" = 1'-0"

- 00 Keynote Legend
- | Key Value | Keynote Text  |
|-----------|---|
| 1         | O'hagin Low profile attic roof mounted vents, Tapered Low-Profile, color to match roof color, installed as per manufacture installation instructions..  |
| 2         | Door as per schedule.   |
| 3         | Window assembly as per window schedule, Vinyl sliding, white, U-factor .  |
| 4         | Painted steel gutter and downspout, color to match existing.  |
| 5         | Exterior cement plaster system, smooth texture finish, color to match LaHabra Stucco Finish, Base200, X-23 Aspen, Parex USA, over DuPont, Tyvek® Stucco Wrap, WRB or of equal grade, sheathing as per structural drawings.  |
| 6         | Overhangs to match existing, prepare, prime and paint all exposed wood members, colors shall be similar to EVERSHIELD® is a complete line of ultra premium exterior, ultra-low VOC, 100% acrylic paint by DUNN-EDWARDS, or of equal grade.                              |
| 7         | Concrete floor slab, slope to drain Building beyond.  |
| 8         | 2x Trims and 2 x 8 rough sawn, painted fascia primed and paint all exposed wood members, colors shall be similar to EVERSHIELD is a complete line of ultra premium exterior, ultra-low VOC, 100 percent acrylic paint by DUNN-EDWARDS, or of equal grade.               |
| 9         | Provide raised floor ventilation Foundation-Vents, 9" high x 18" long, vinyl or sheet metal, net free area 57 inches, installed as per manufacture installationinstructions.  |
| 10        | 22" wide x 46" long skylight similar to Velux FSM, aluminum exterior finish or of equal grade, Install as per manufacture installation instructions.  |
| 11        | Roll up garage door shall be mounted to ceiling joist, add tracks and mounting brackets as per manufacture installation instructions, owner to select motor type and remote control options.  |
| 12        | Continuous half round gutter, primed and painted using high gloss exterior paint, provide support as per manufacture installation instructions.   |
| 13        | Wall mounted Sconces as per reflected ceiling plan.   |
| 14        | Exposed wood timber shall be similar to EXPOSED TIMBER, STAINED General Finishes- Exterior 450 Wood Stains premium quality, exterior pigmented, stains designed for outdoor COLOR (Olde Cherry).  |
| 15        | Proposed concrete clay tile roofing system over water proofing membrane, Flat roof tiles, Similar grade to Eagle, Color similar to Ponderosa Description, Rosy Brown, Dark Brown Streaks (COLOR 5557 Live Oak), installed as per manufacture installation instructions. |
| 16        | Smooth trowel finish plaster, color shall be similar to LaHabra X23 Aspen Base 200, or similar to SHERWIN-WILLIAMS ALBASTER SW7008, Trims and exposed wood shall be similar to WOOD TRIMS AND FACIA BOARDS' COLOR: SHERWIN-WILLIAMS WHITE DUCK SW7010.                  |
| 17        | Sawcut existing exterior plaster system at base location in order to accommodate the proposed stone veneer wainscot, refer to exterior elevations for additional information.   |
| 18        | Downspout to match gutter style and color, installed as per manufacture installation instruction, fastners shall be installed into plaster walls, protect exterior plaster as suggested by manufacture.   |
| 19        | Proposed slab on grade, surface drainage shall be diverted to a storm sewer conveyance or other approved point of collection so as to not create a hazard.  |
| 20        | Proposed concrete paving, concrete finish and texture to match existing adjacent concrete paving.   |
| 21        | Sliding glass door, intalled as per manufacture installation instructions, provide flashing and sheet metal pan as per manufacture intallation instructions, seal perimeter as needed.  |
| 22        |   |

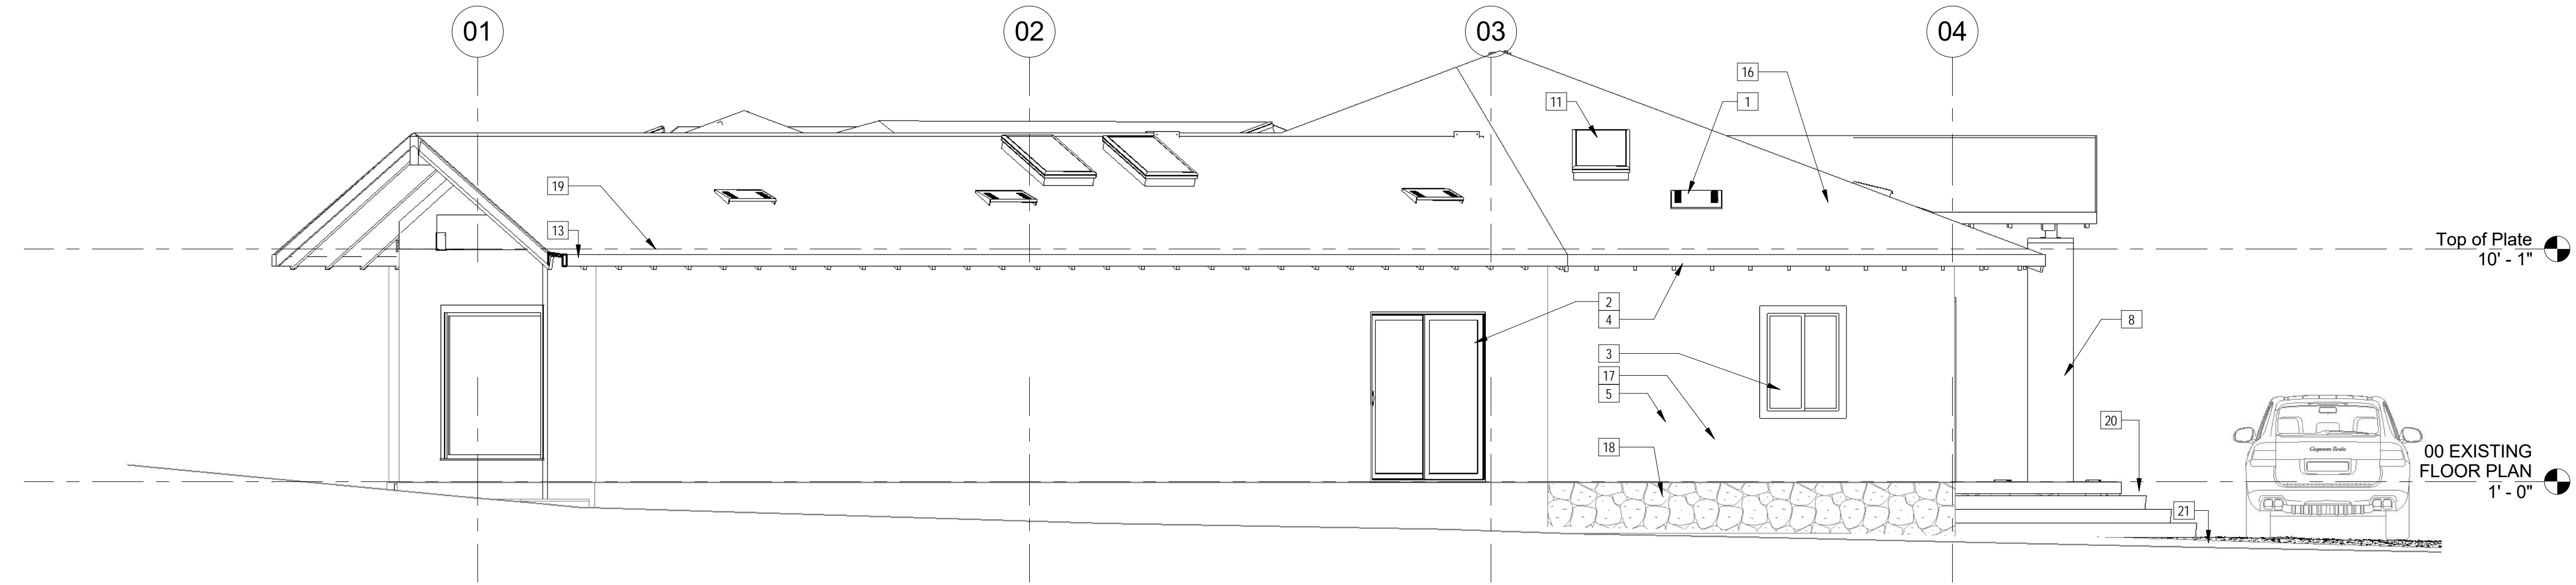

2 Elevation 10 - a  
1/4" = 1'-0"

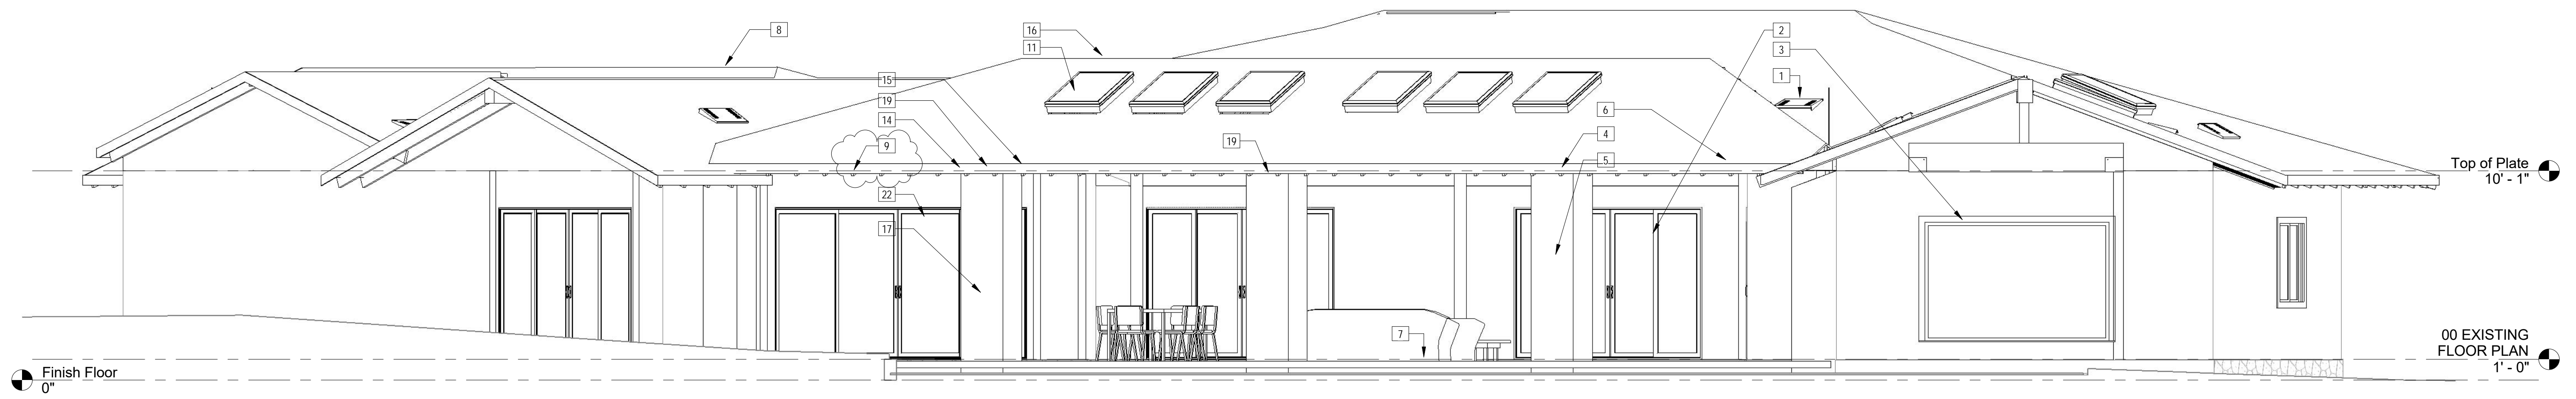

3 North West Elevation 2 - a  
1/4" = 1'-0"


- EXTERIOR ELEVATIONS NOTES:
- APPLICATION OF LATH, PAPER AND FLASHING OR WEEP SCREEDS SHALL COMPLY WITH ASTM C1063.
  - PROVIDE A MINIMUM OF 2x 26 GALVANIZED SHEET GAGE CORROSION-RESISTANT WEEP WITH A MINIMUM VERTICAL ATTACHMENT FLANGE OF 3-1/2" SHALL BE PROVIDED AT OR BELOW THE FOUNDATION PLATE LINE ON EXTERIOR STUD WALLS.
  - THE WATER-RESISTIVE BARRIER TO THE EXTERIOR OF THE BUILDING AND THE EXTERIOR LATH SHALL COVER AND TERMINATE ON THE ATTACHMENT FLANGE OF THE WEEP SCREED.

No.	Description	Date
2	2nd Plan Check	04/10/17

Project number  
Date  
Drawn by  
Checked by

Project Number  
Issue Date  
Author  
Checker

Consultant  
Address  
Phone  
Fax  
e-mail

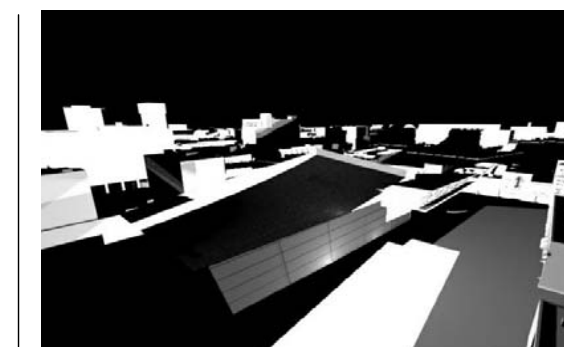


**STITCH  
STUDIO**  
Contact: Jorge Escamilla  
4082 Pomona Street  
Ventura, California 93003  
Direct: 818.523.7201  
Email: info@stitchstudio3d.com


**CANDAMIL RESIDENCE**  
Remodel to Existing Single Family Dwelling  
9700 Portada Drive, Whittier, CA

**A302**  
Scale As indicated


- | Key Value | Keynote Text  |
|-----------|---|
| 1         | Infill existing pool using local jurisdiction standards. All fill material shall be compacted to a minimum of 90 percent of maximum density as determined by ASTM D 1557, Modified Proctor, in lifts not exceeding 12 inches (0.3 m) in depth within 40 feet (12.2 m) below finished grade and 93 percent of maximum dry density deeper than 40 feet (12.2 m) below finished grade, unless a lower relative compaction (not less than 90 percent of maximum dry density) is justified by the Geotechnical Engineer and approved by the Building Official. Where ASTM D 1557, Modified Proctor is not applicable, a test acceptable to the Building Official shall be used. Field density shall be determined by a method. |
| 2         | Beams as per structural plan.   |
| 3         | Proposed concrete clay tile roofing system over water proofing membrane. Flat roof tiles. Similar grade to Eagle, Color similar to Ponderosa Description, Rosy Brown, Dark Brown Streaks (COLOR 5557 Live Oak), installed as per manufacture installation instructions.   |
| 4         | Smooth trowel finish plaster, color shall be similar to LaHabra X23 Aspen Base 200, or similar to SHERWIN-WILLIAMS ALBASTER SW7008, Trims and exposed wood shall be similar to WOOD TRIMS AND FACIA BOARDS: COLOR: SHERWIN-WILLIAMS WHITE DUCK SW7010.  |
| 5         | Cont. Gutter and downspout. See specifications.   |
| 6         | Gypsum board, finish to match existing main dwelling finish, color to be owner selected.  |
| 7         | Wood Column, Refer to structural drawings.  |
| 8         | Exterior window assembly system. Refer to schedule.   |
| 9         | Gypsum board ceiling, refer to ceiling joist span table on roof framing sheet, ceiling texture shall match existing main dwelling texture, color is to be owner selected.   |
| 10        | Footings as per structural drawings.  |
| 11        | Slab on grade, over compacted earth, add 2" sand and vapor barrier as recommended by concrete standards.  |
| 12        | Compacted earth.  |
| 13        | Remove and discard exiting overhang in its entirety in order to accommodate the new roof configuration, refer to framing plan and roof plan.  |
| 14        | Roof sheathing as per schedule.   |
| 15        | Roof rafters as per structural drawings, R-30 insulation, add 2 inch diameter holes at each roof rafter bay, protect openings using a 1/4 inch galvanized steel mesh stapled to the inside of the top of wall plate blocking.   |
| 16        | Waterproofing membrane, install as per manufactures installation instructions.  |
| 17        | Elevation Beyond.   |
| 18        | Sawcut existing exterior plaster system at base location in order to accommodate the proposed stone veneer wainscot, refer to exterior elevations for additional information.   |
| 19        | Protect in place existing footings.   |
| 20        | Protect in place existing flooring and substructure.  |
| 21        | Contractor shall verify existing conditions at the site and examine adjoining work, identify what will affect the completion of this work, the designer shall be notified in writing should the contractor have questions as to existing condition that will affect the work.   |
| 22        | All cutting and patching in the existing building shall be done by the contractor, to provide for exterior load bearing walls and new roof configuration.   |
| 23        | Exterior plaster wall system over wood framing, all water proofing membranes shall be installed as per manufacture installation instructions, R-19 batten insulation.   |
| 24        | Interior load bearing partition. Refer to structural drawings.  |
| 25        | Protect in place existing interior wall assemblies.   |
| 26        | Proposed beam as per structural framing plan.   |
| 27        | Slab on grade, remove and recompact existing soil as recommended in soils report.   |
| 28        | 22" wide x 46" long skylight similar to Velux FSM, aluminum exterior finish or of equal grade, install as per manufacture installation instructions.  |
| 29        | O'haggin Low profile attic roof mounted vents, Tapered Low-Profile, color to match roof color, installed as per manufacture installation instructions.  |
| 30        | Painted steel gutter and downspout, color to match existing.  |
| 31        | Sliding glass door, intalled as per manufacture installation instructions, provide flashing and sheet metal pan as per manufacture intallation instructions, seal perimeter as needed.  |
| 32        | Wall mounted Sconces as per reflected ceiling plan.   |
| 33        | Protect in place existing exterior wall assembly.   |
| 34        | Existing Landscaping, protect during the construction of the proposed addition.   |

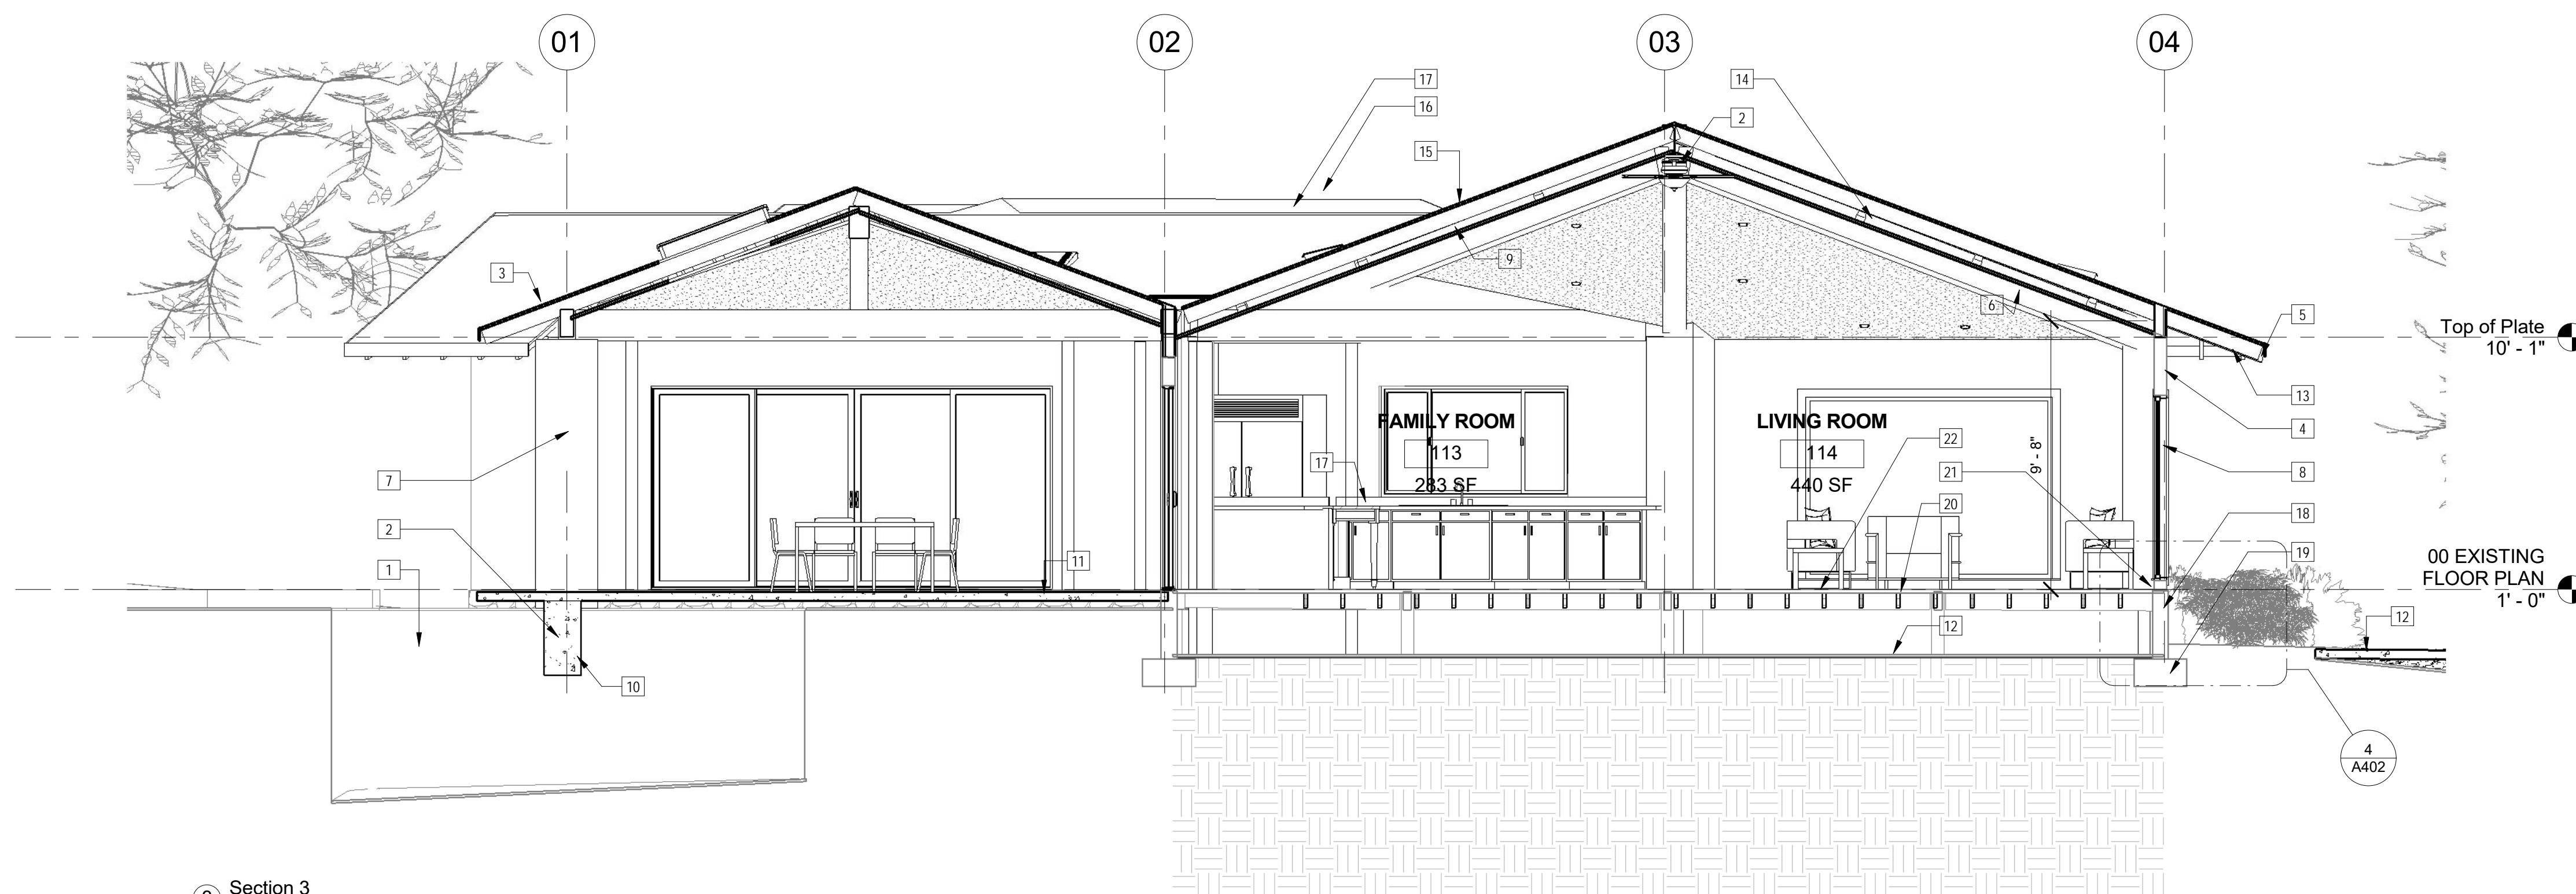

3 Section 3  
1/4" = 1'-0"

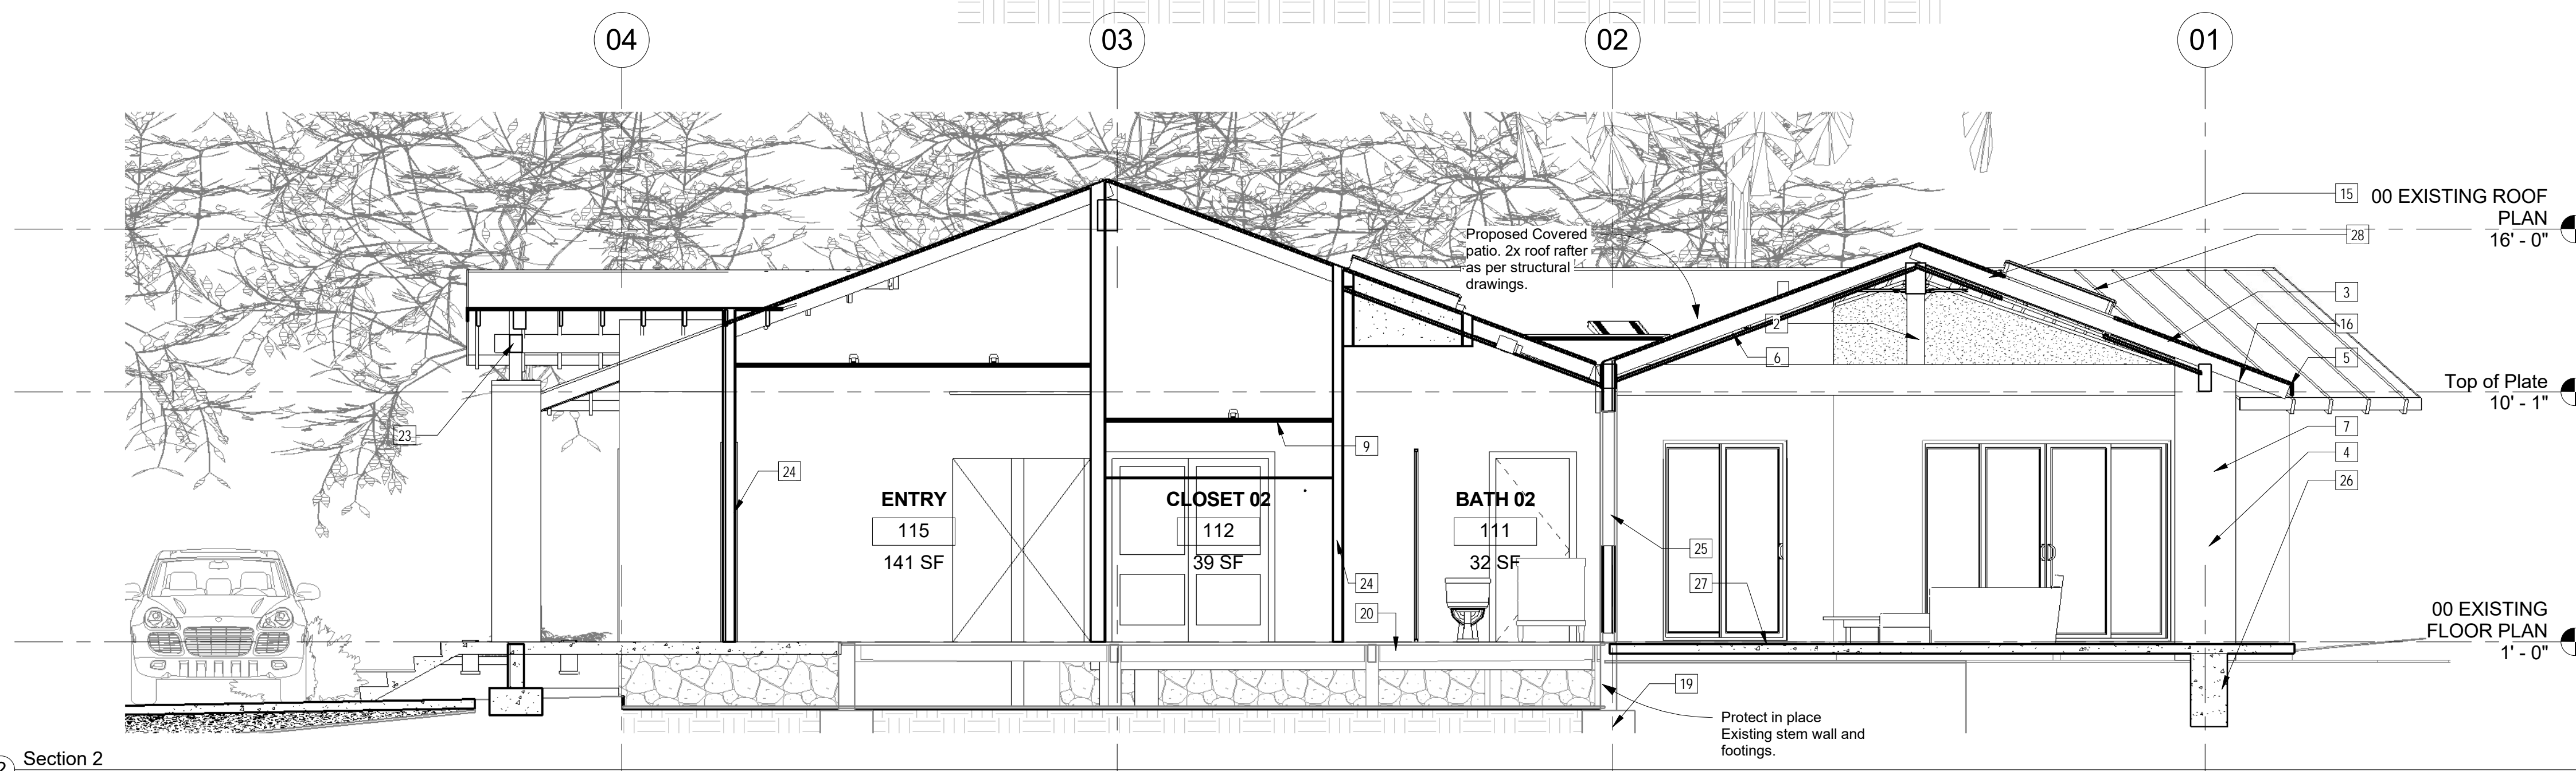

2 Section 2  
1/4" = 1'-0"

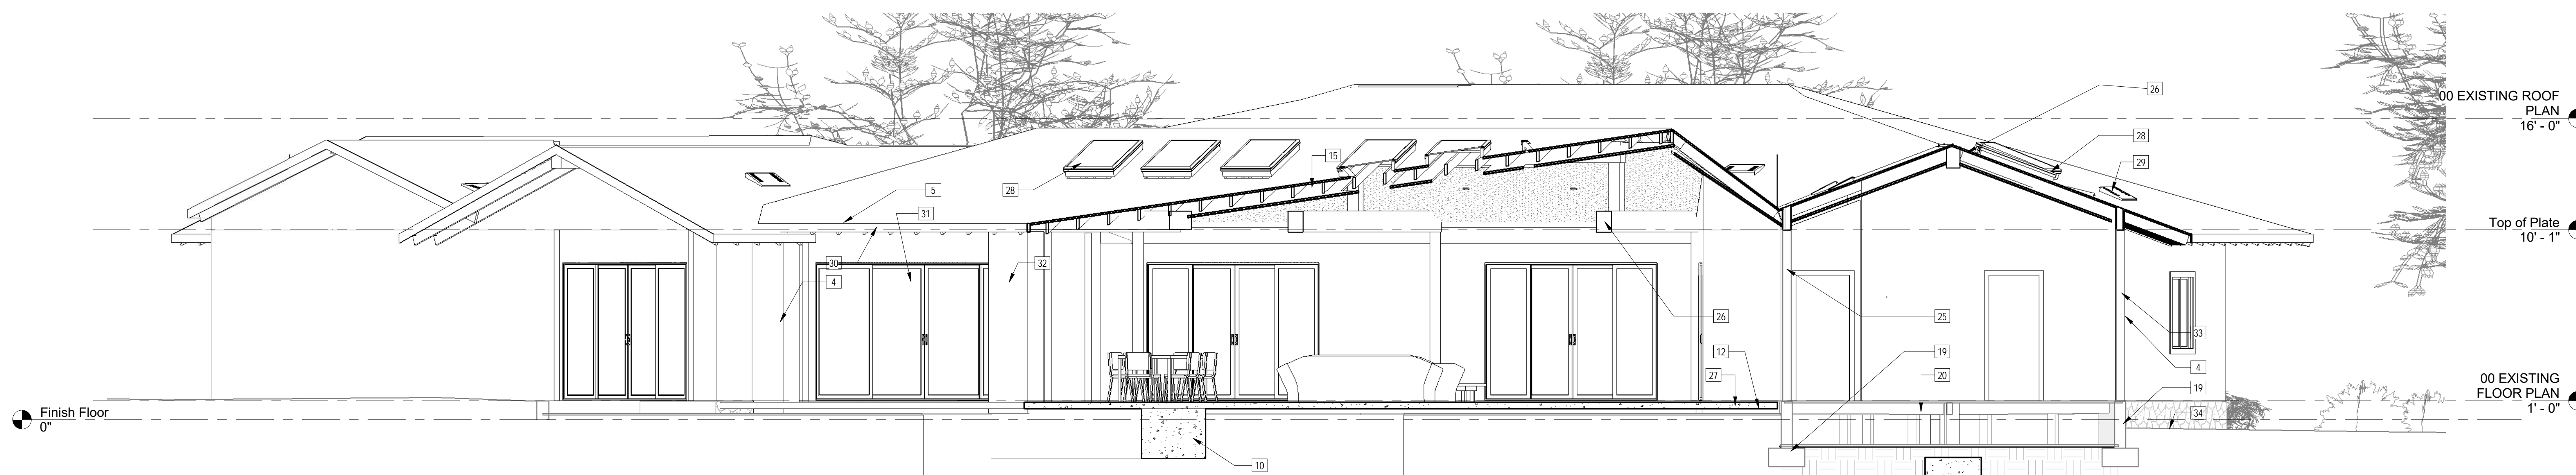


1 Section 1  
1/4" = 1'-0"

No.	Description	Date

Project number  
Date  
Drawn by  
Checked by

Project Number  
Issue Date  
Author  
Checker

Consultant  
Address  
Phone  
Fax  
e-mail

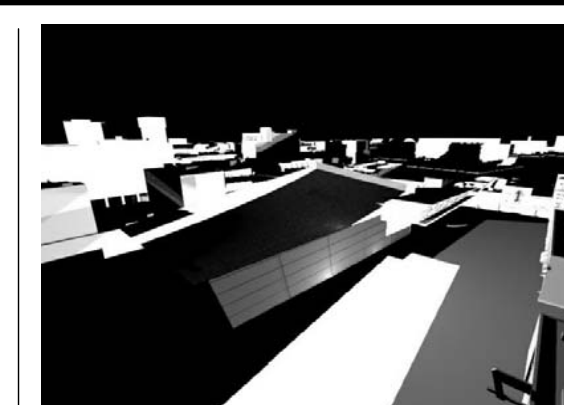

**STITCH  
STUDIO**


Contact: Jorge Escamilla  
4082 Pomona Street  
Ventura, California 93003  
Direct: 818.523.7201  
Email: info@stitchstudio3d.com

**CANDAMIL RESIDENCE**  
Remodel to Existing Single Family Dwelling  
9700 Portada Drive, Whittier, CA


BUILDING SECTIONS

**A401**


Scale 1/4" = 1'-0"

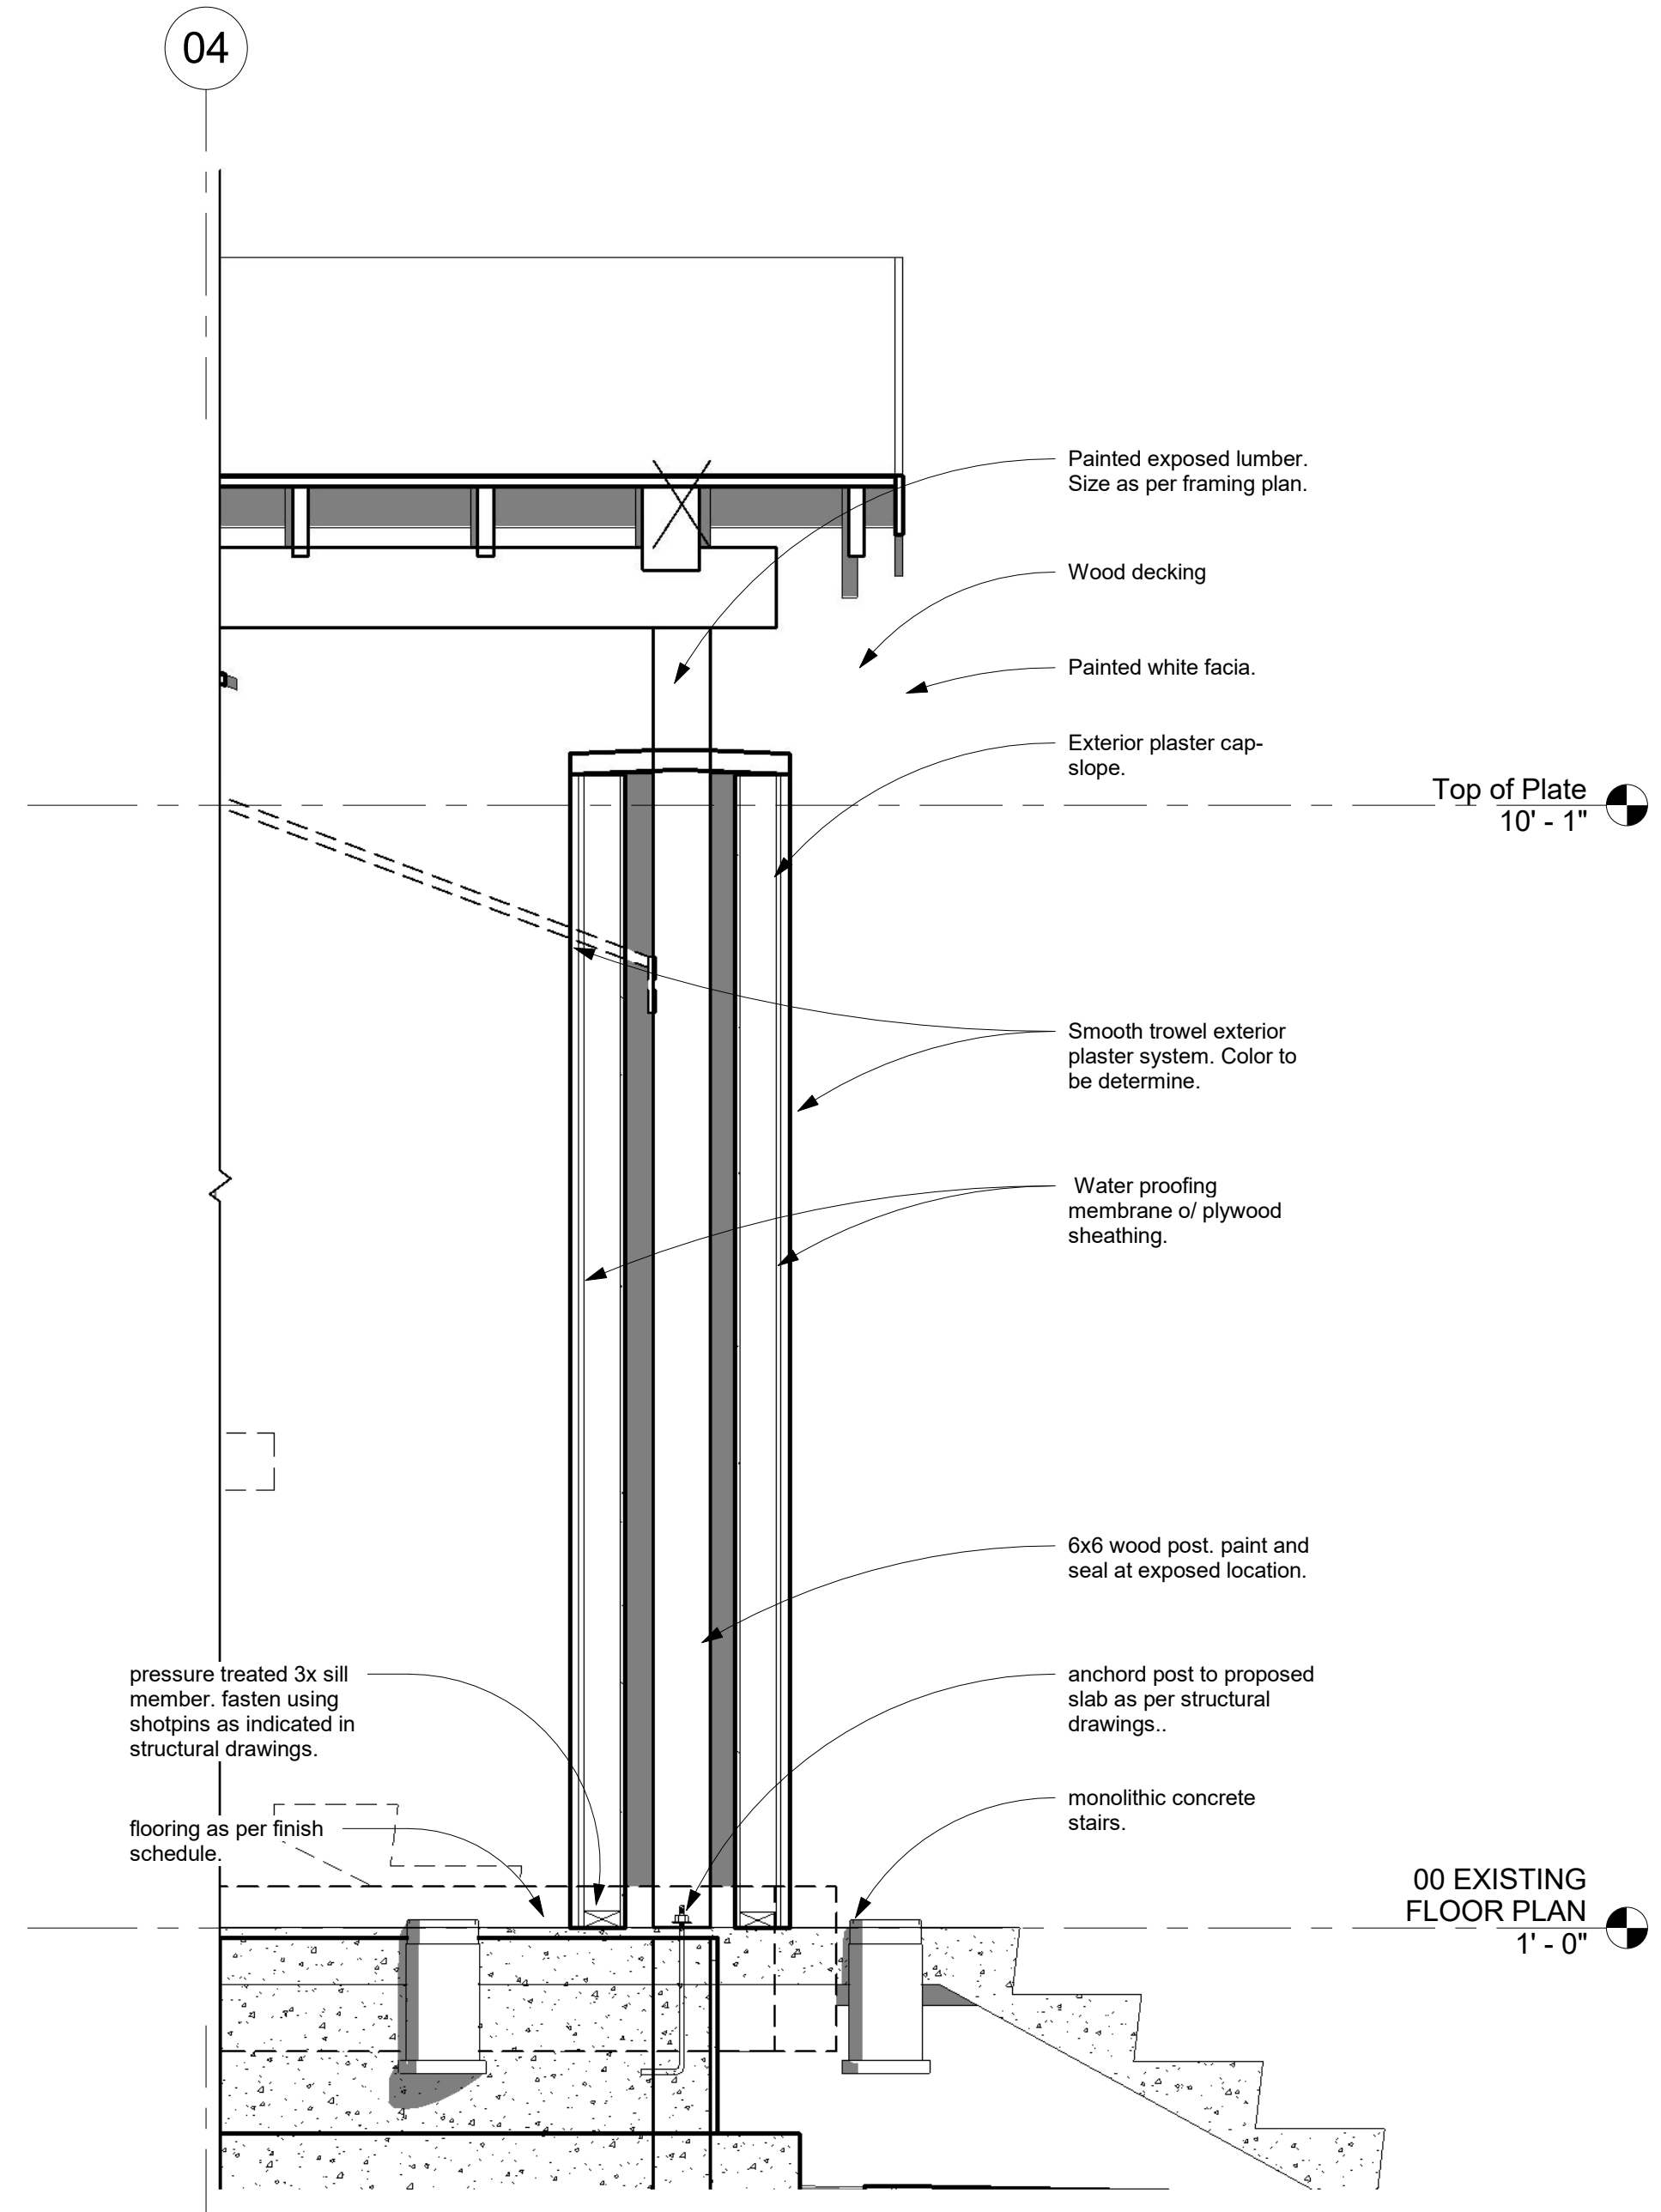


2 Enlarged Entry Section  
3/4" = 1'-0"

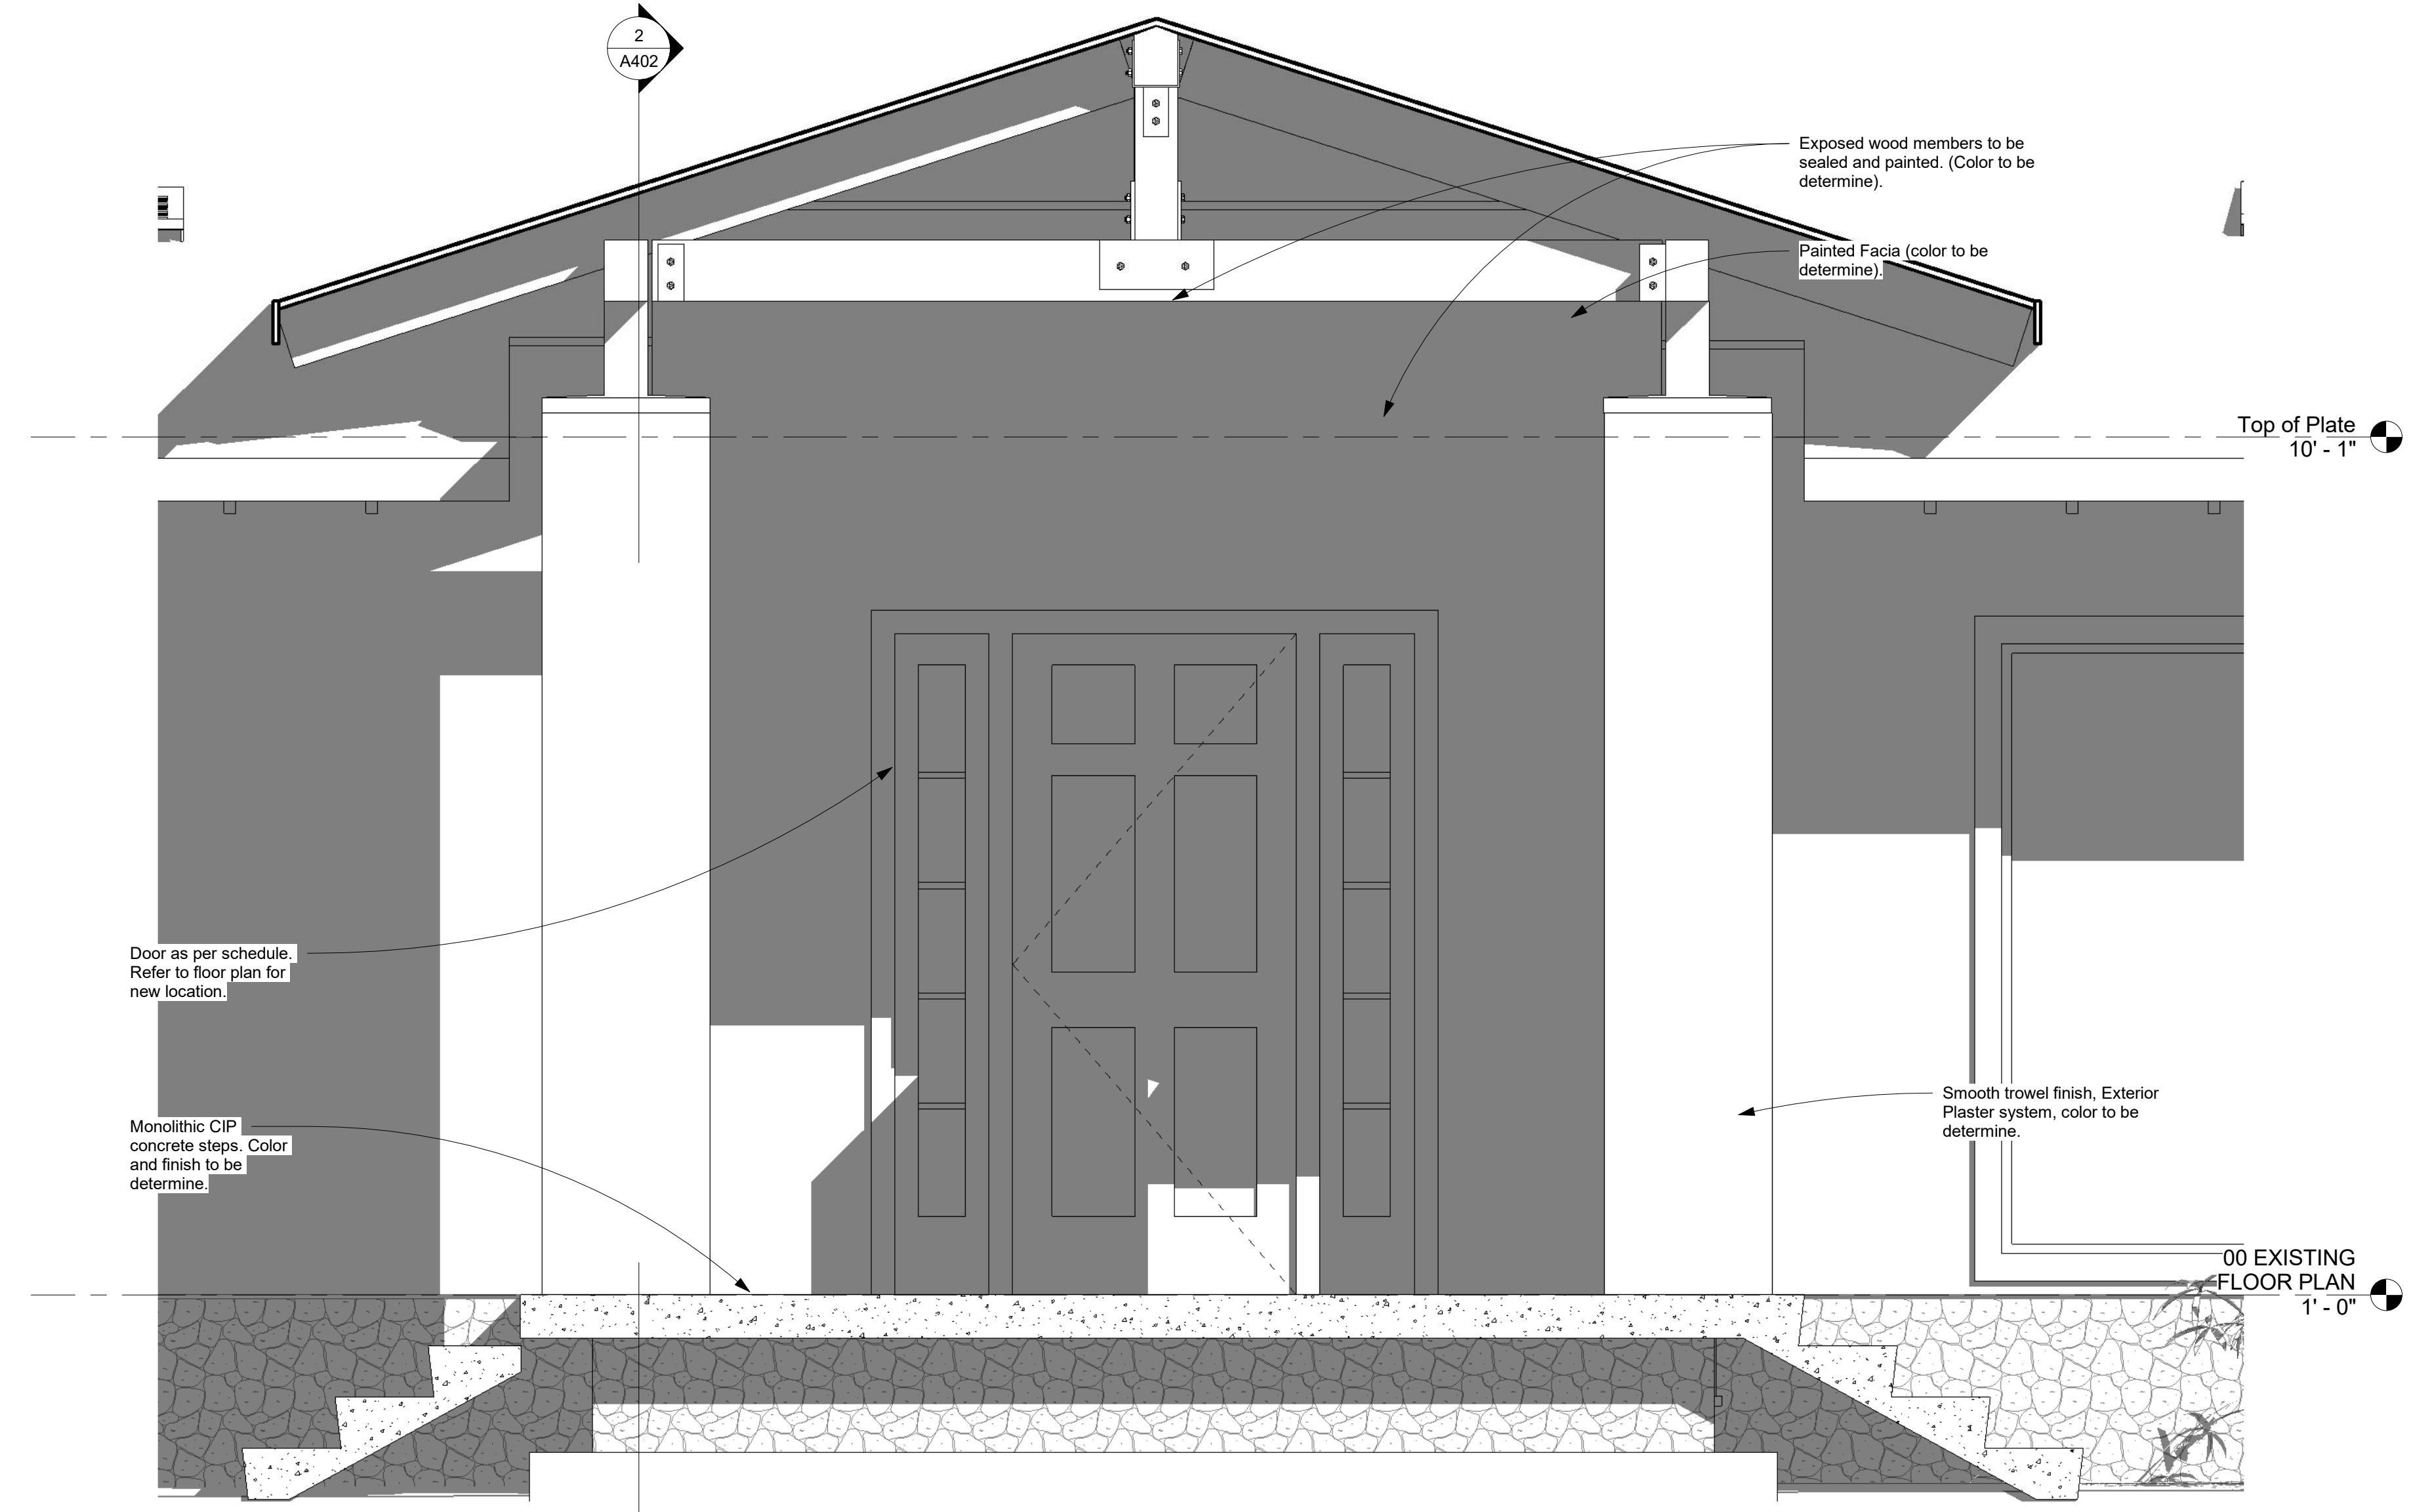

1 Enlarged Entry Partial Elevation  
3/4" = 1'-0"

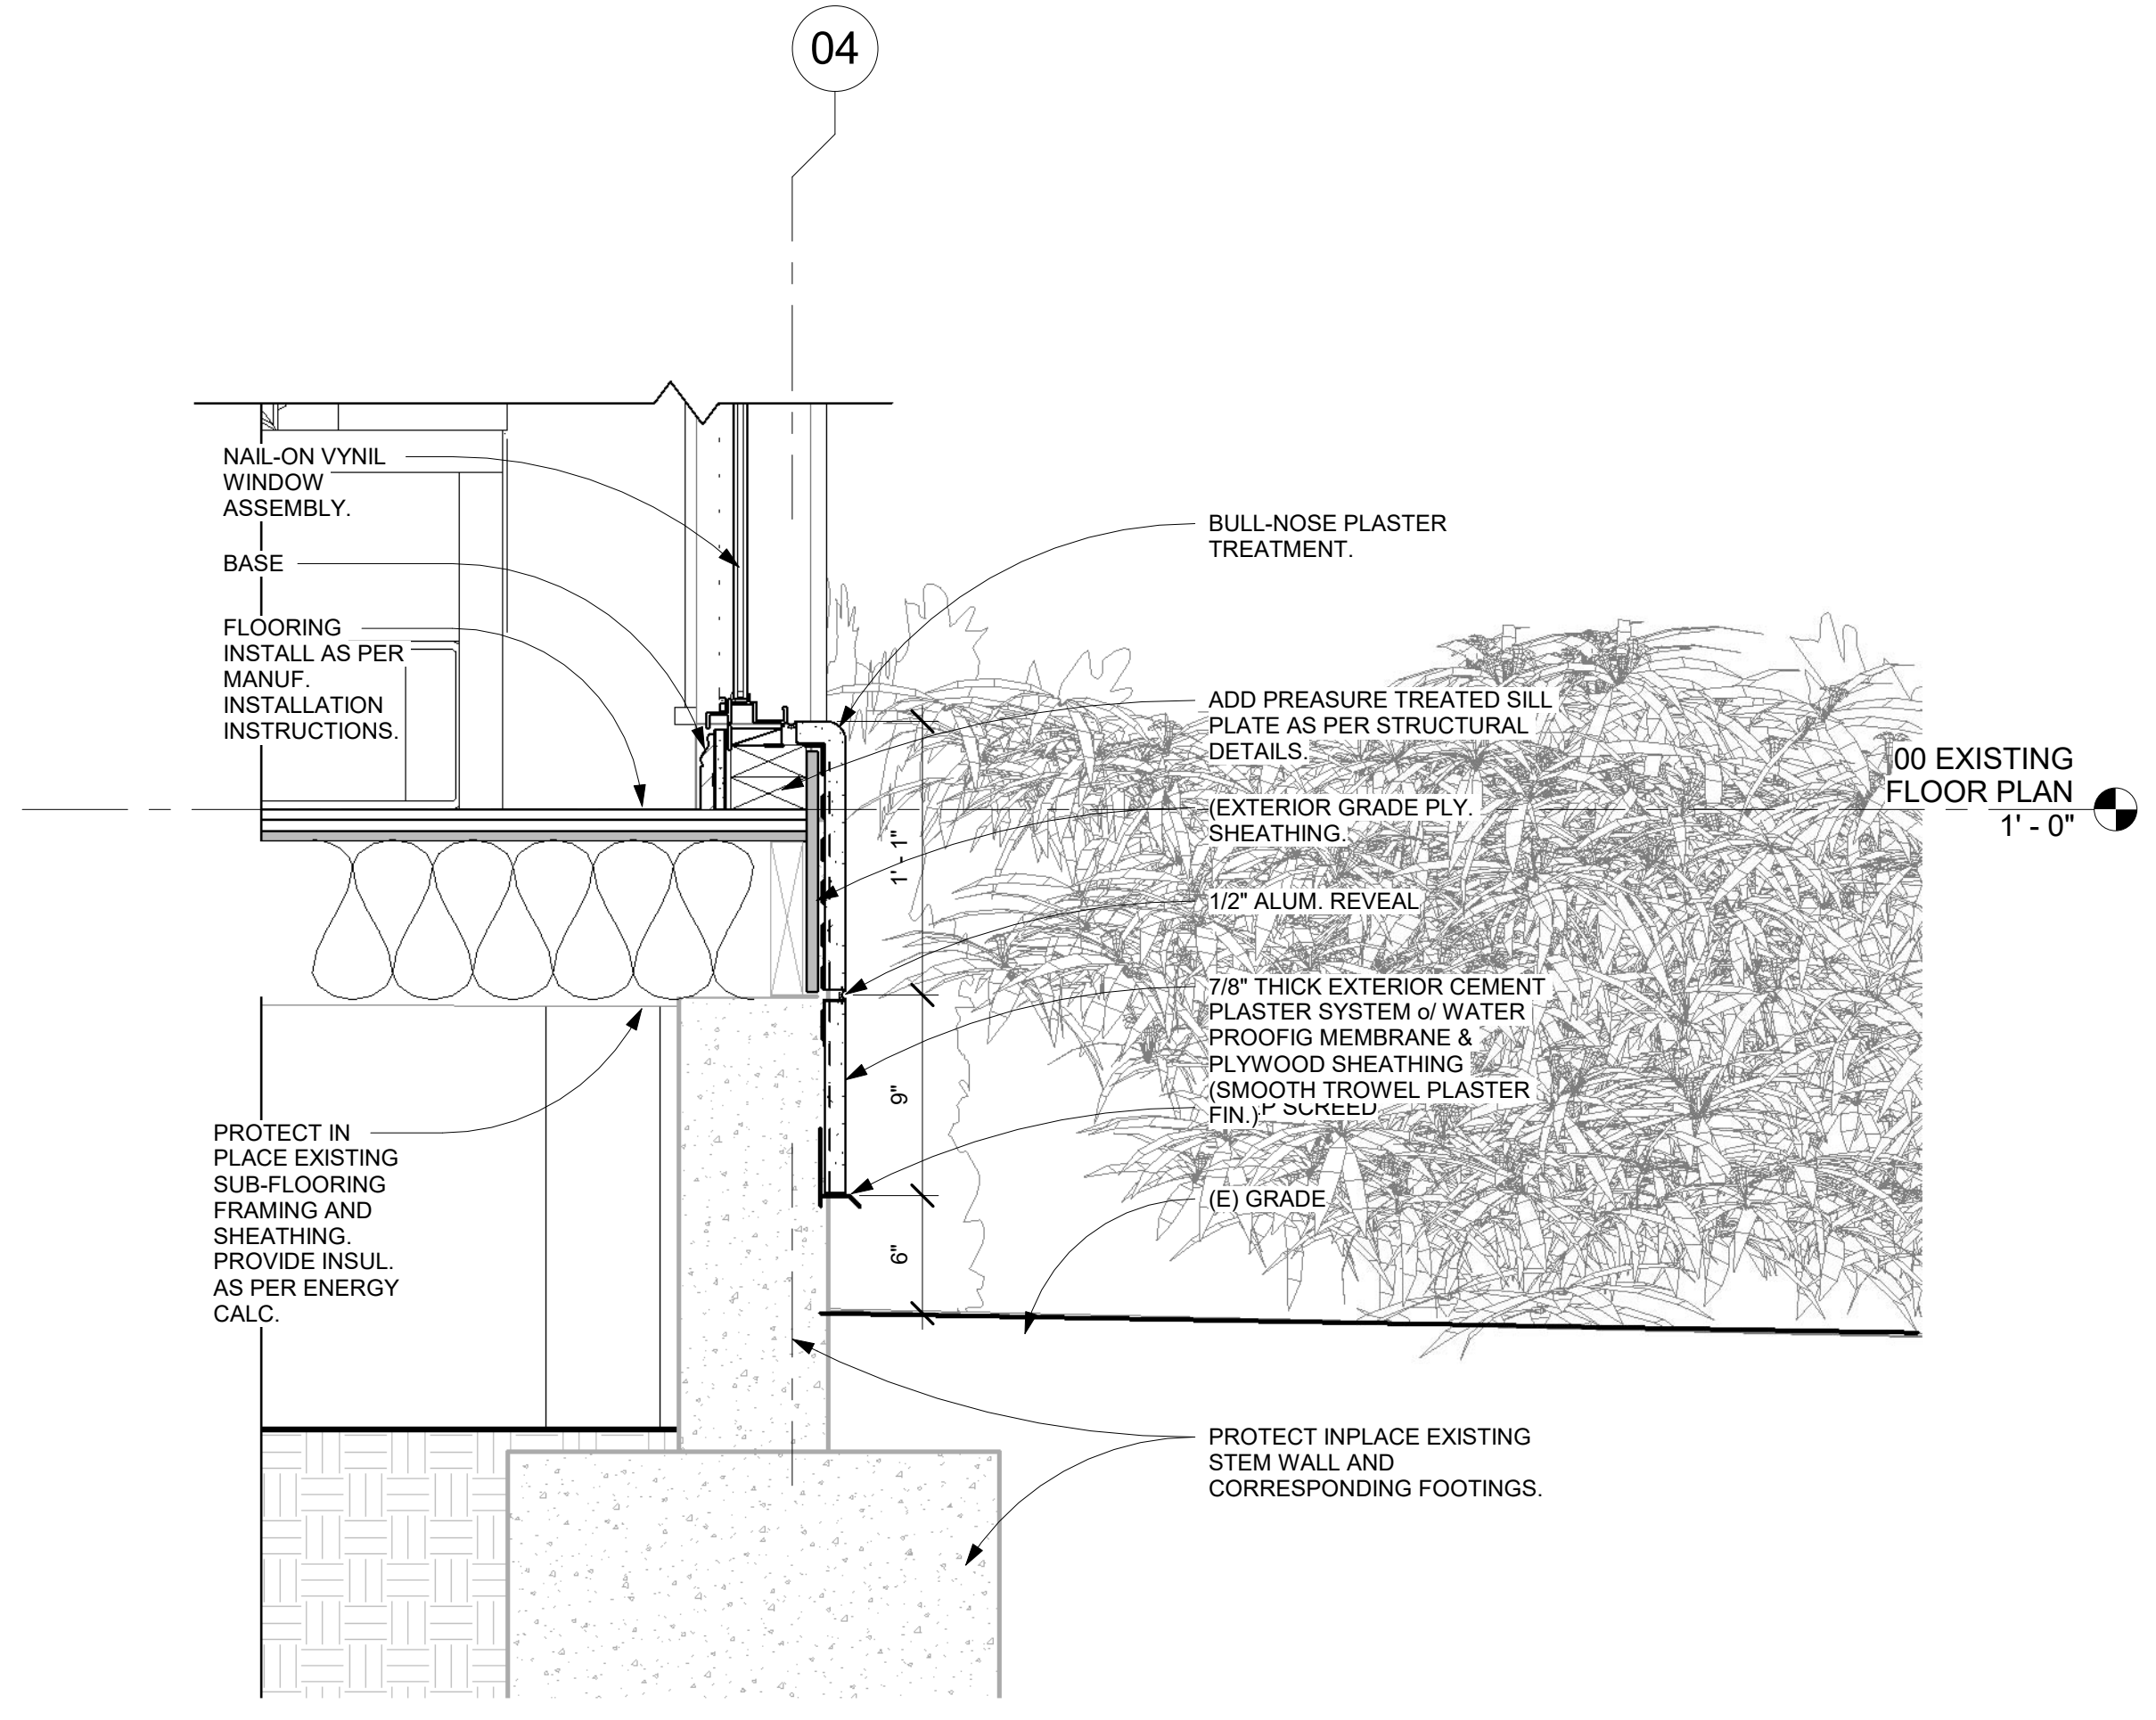

4 Wall Base Detail @ Exterior Wall  
1 1/2" = 1'-0"

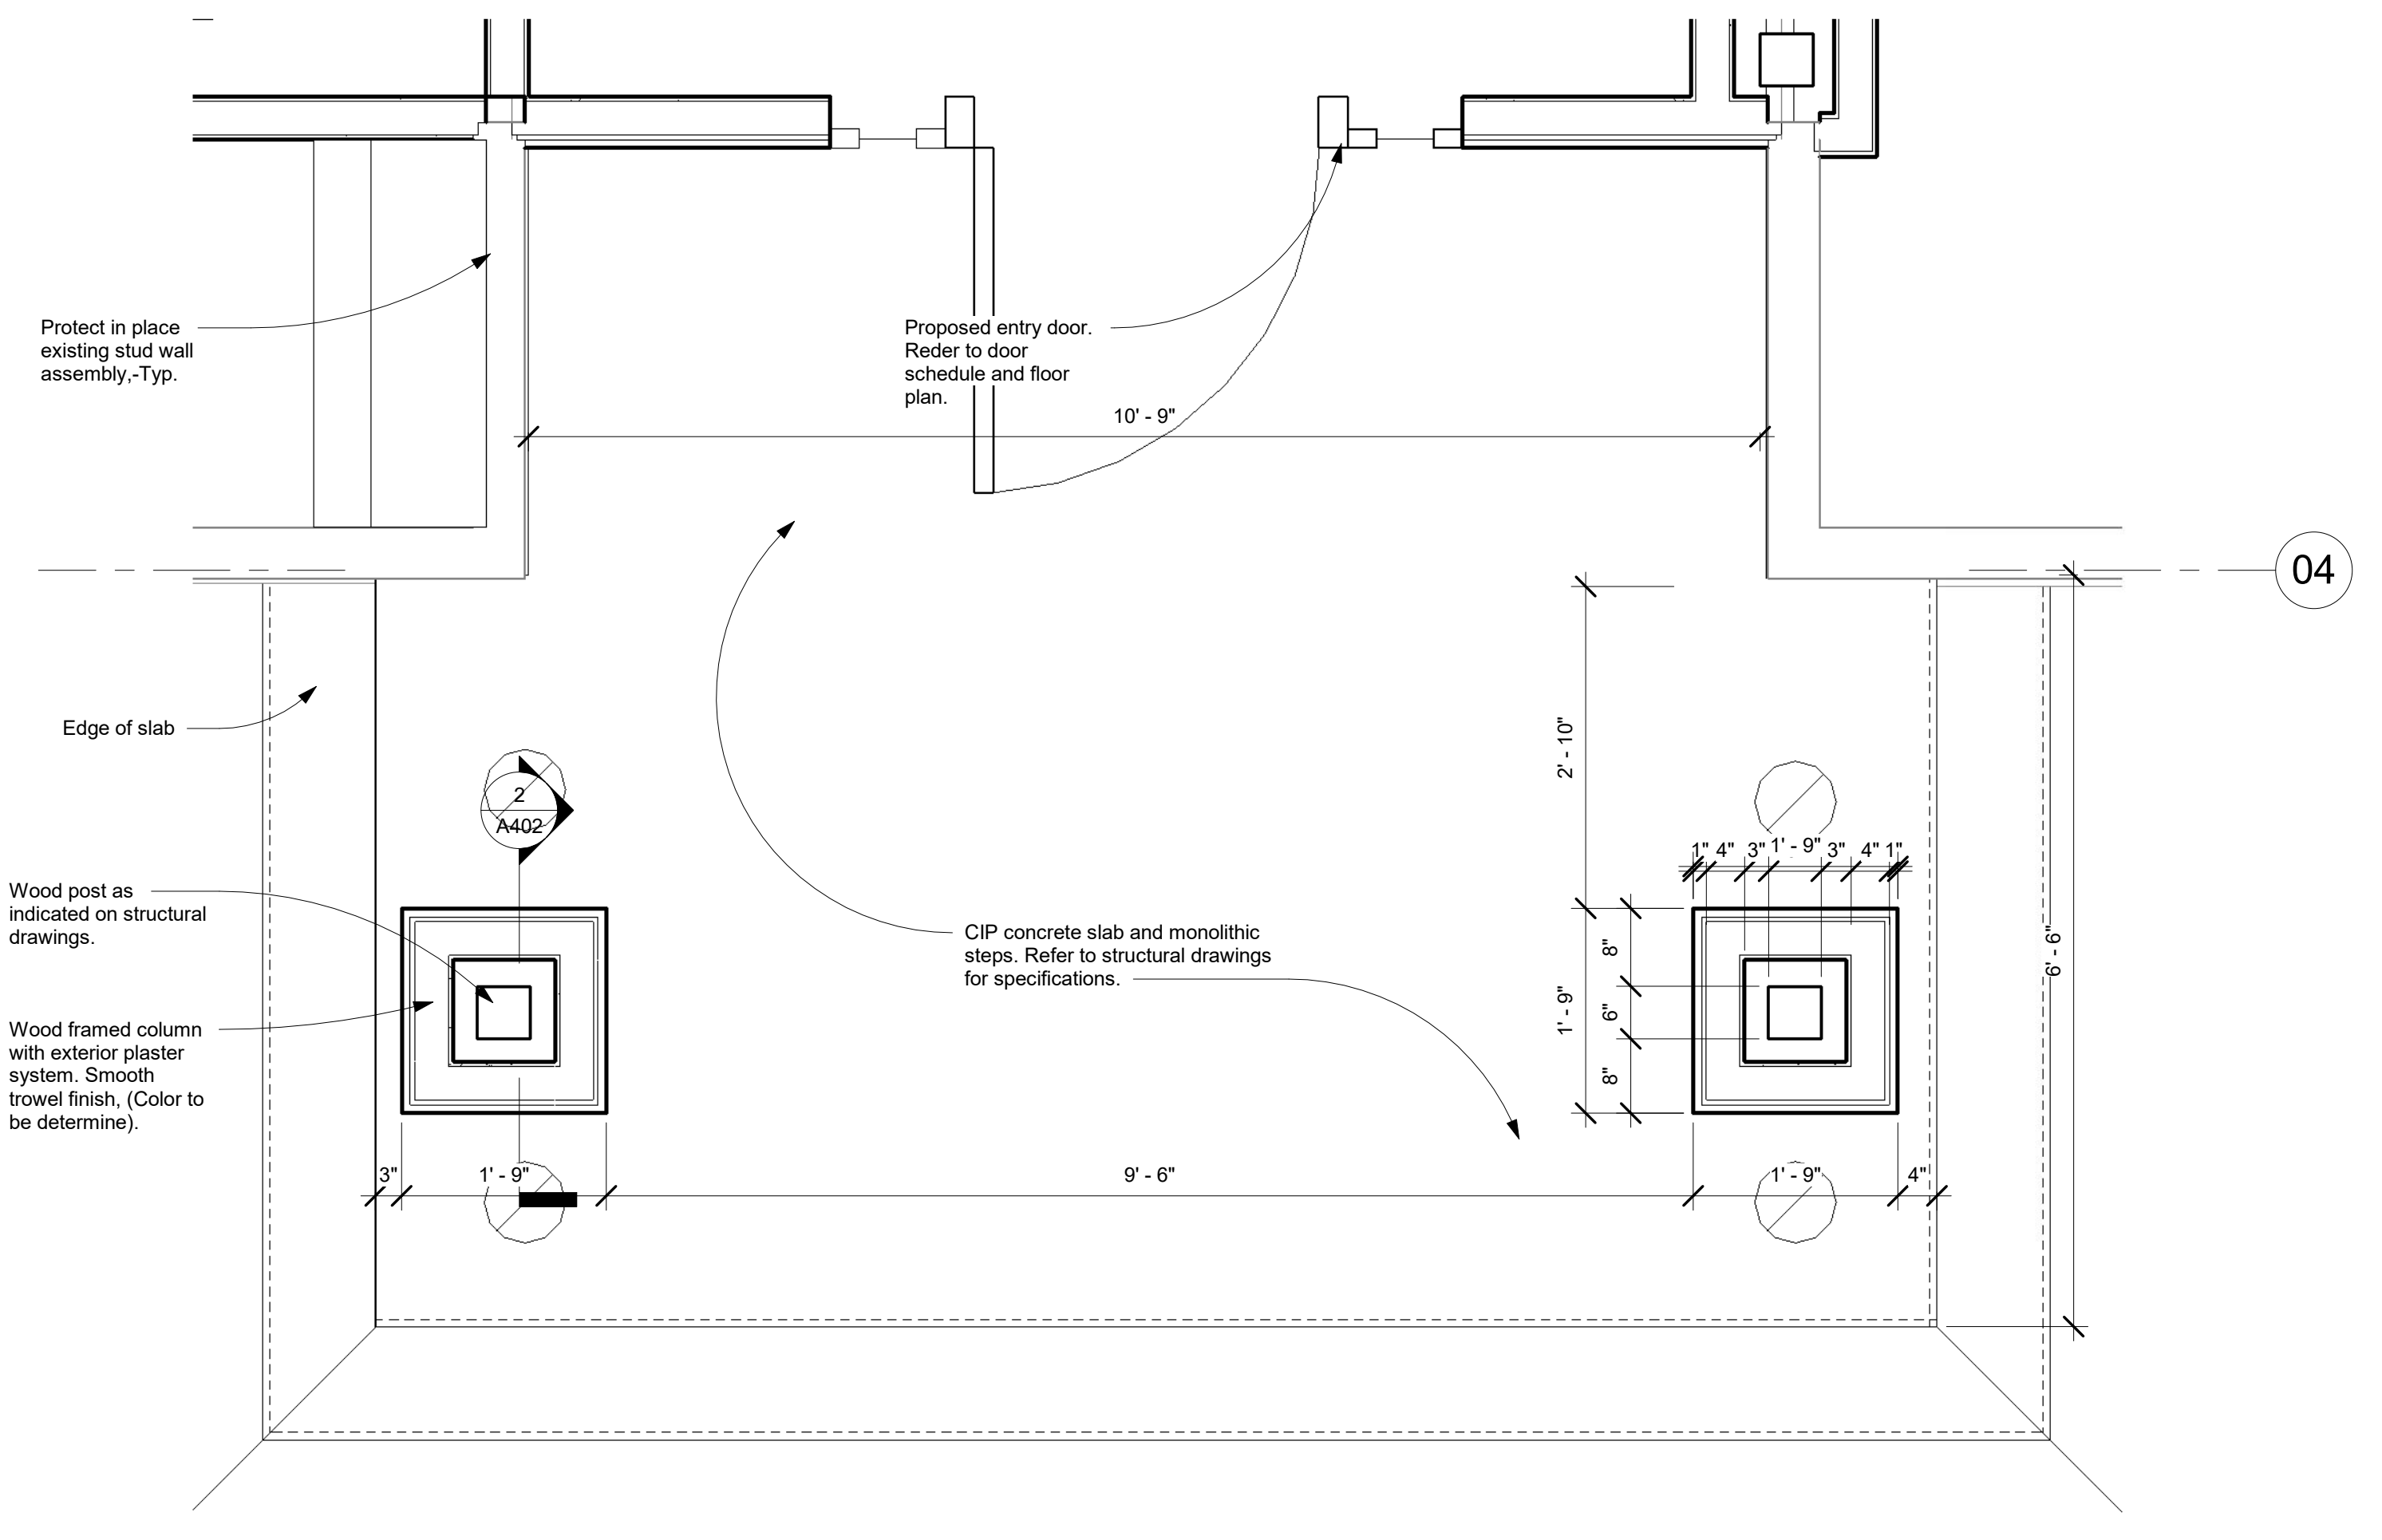


3 Enlarged Column Details  
3/4" = 1'-0"

No.	Description	Date

Project number  
Date  
Drawn by  
Checked by

Project Number  
Issue Date  
Author  
Checker

Consultant  
Address  
Phone  
Fax  
e-mail

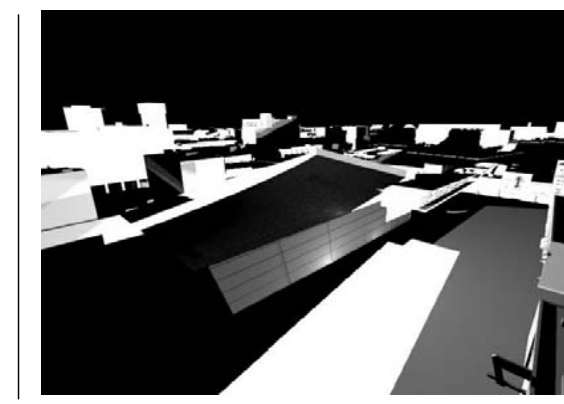

**STITCH  
STUDIO**  
Contact: Jorge Escamilla  
4082 Pomona Street  
Ventura, California 93003  
Direct: 818.523.7201  
Email: info@stitchstudio3d.com

**CANDAMIL RESIDENCE**  
Remodel to Existing Single Family Dwelling  
9700 Portada Drive, Whittier, CA

**A402**

TYPICAL EXTERIOR DETAILS

Scale As indicated

- Division 1  
**A. GENERAL CONDITIONS:**  
 1. AIA Document A201, "General Conditions of the Contract for Construction" shall govern work performed under this Contract.  
 2. The contractor shall be responsible for providing all materials and workmanship in accordance with all applicable State and City building codes and requirements.  
 3. As approved by building owner, the contractor and all subcontractors shall purchase and maintain certificates of insurance with respect to workmen's compensation, public liability and property damage for the limits as required by law. The contractor shall be responsible for initiating, maintaining, and supervising all safety precautions in connection with the work.  
 4. The contractor is required to secure and pay for all building permits, plan check or any other fees required to complete this project and all fees shall be included in the contractor's pricing proposal. All pricing submittals shall be completely itemized for each sub-trade.  
 5. The contractor and all sub-contractors shall thoroughly examine the premises and shall base their bids on the existing conditions. The contractor shall notify owner's representative immediately of any discrepancies between field conditions and construction documents prior to construction, or the contractor shall be held responsible.  
 6. Upon submittal of the final construction costs, the general contractor shall also submit a specific construction schedule indicating the required construction time for all subcontractors' and general contractors' work. This schedule shall confirm approximate on-site delivery dates for all construction materials by the construction documents and shall immediately notify owner's representative, in writing, of all construction delays that may arise due to the availability of the specified products which will affect scheduled occupancy.  
 7. Substitutions, revisions, or changes must have prior written approval by the owner's representative. There shall be no substitution of materials where a manufacturer is specified. Where the term "or approved equal" is used, the owner's representative shall determine equality based upon complete information submitted by the contractor.  
 8. No work defective in construction or quality or deficient in any requirements of the drawings will be acceptable. The owner's or owner's representative failure to discover or point out defects or deficiencies during construction shall bear no consequence to the owner or owner's representative. Defective work revealed during the construction period or during the guarantee period shall be replaced by work conforming with the intent of the contract. No payment, either partial or final shall be construed as an acceptance of defective work or improper materials.  
 9. The general contractor shall not proceed with any additional compensation beyond the contract amount without written authorization from the owner or the owner's representative. Failure to obtain authorization shall invalidate any claim for extra compensation.  
 10. The general contractor shall be responsible for the distribution of drawings to all trades under his jurisdiction.  
 11. The contractor shall provide strict control of job cleaning and prevent dust and debris from emanating from construction areas. Keep corridors and adjacent occupied areas clean and clear. Do not disrupt operations of adjacent occupied areas.  
 12. "Typical" means identical for all similar conditions unless otherwise noted.  
 13. Contractor is responsible for coordinating all design & engineering work to assure that all lighting, mechanical, electrical, plumbing & sprinkler work has the proper clearances for installation and maintenance. Resolve all conflicts before proceeding.

- B. SUBMITTALS**  
 1. Contractor shall submit samples and shop drawings to the owner's representative for review prior to fabrication. The owner's representative will review and approve submittals in an orderly sequence to prevent delay. Inform owner's representative in writing at the time of submission of any proposed deviation in submittals from the requirements of the Contract Documents. By approving and submitting shop drawings and samples, the Contractor represents that he has determined and verified field measurements, field construction criteria, materials, catalogue numbers and similar data, and that each submittal has been checked and coordinated with the requirements of the Contract.  
 2. Samples  
 a. Provide three samples of each item as required. Contractor shall ship samples prepaid.  
 b. Rejected samples shall be resubmitted as soon as possible and shall be identified as "Resubmitted Samples".  
 c. Provide samples of actual piece of the appropriate material for the following:  
 1. Points (8" x 10")  
 2. Vinyl Composite Tile (1' x 1')  
 3. Plastic laminates (8" x 10")  
 4. Wood Finishes (8" x 10")  
 5. Rubber Base (3")  
 6. Carpet (1' x 1')  
 3. Shop Drawings - Submit shop drawings, equipment/product cut sheets, and samples to owner's representative for approval.  
 a. Submit one reproducible and two prints of each shop drawing. Drawings shall include title block, reference to architectural drawing and required information.  
 b. Corrections and notations will be made on the reproducible. When required, revision shall be incorporated and resubmitted.  
 c. The owner's representative review of shop drawings shall be for design concept only. The Contractor is responsible for the accuracy of shop drawings, proper fittings, coordination of work, construction techniques, materials and work required by the Contract Documents.  
 d. The owner's representative review of shop drawings shall not be construed as approving departures from contract requirements.  
 e. Provide shop drawings for the following:  
 1. Finish carpentry/millwork.  
 2. HVAC system.  
 3. Electrical system.  
 4. Life Safety system.  
 5. Sprinkler system.  
 6. Carpet seaming diagrams.  
 4. Contractor shall submit a detailed hardware schedule for the owner's representative approval prior to submitting order. Finish hardware samples shall be submitted at the request of owner.

- Division 2 - Site Access  
**A. SITE WORK:**  
 1. Receive approval from Building Owner regarding access to space, debris removal routes, and other necessary construction functions prior to commencing construction.  
 2. Coring and other work which might affect other tenants shall be scheduled through the office of the Building Owner.  
 3. Submit shop drawings, equipment/product cut sheets, and samples to owner's representative for approval.

- Division 3 - Concrete  
**A. CUTTING & PATCHING**  
 1. All concrete cutting and patching to conform to the provisions of ACI Standard 318 for concrete construction.  
 2. Submit shop drawings, equipment/product cut sheets, and or samples to owner's representative for approval.

- DIVISION 4: MASONRY**  
 This Section not used.

- DIVISION 5: MISCELLANEOUS METALS**  
 This Section not used.

- DIVISION 6: WOOD AND PLASTIC**  
**A. ROUGH CARPENTRY**  
 1. Wood for rough carpentry shall be graded by an agency certified by the National Forest Products Association (NFPA) and shall be of the type recommended for the application involved.  
 a. Fire treat all wood for rough carpentry.

- B. FINISH CARPENTRY**  
 1. Finish carpentry and millwork shall conform to the following standard: Woodwork Institute of California: Custom Grade.  
 2. Wood Casework:  
 a. Plastic laminate shall be NEMA LD-3 general purpose type. Thickness as follows:  
 a) Counter tops: 0.05"  
 b) Vertical surfaces: 0.038"  
 c) Back-up sheets: 0.020"  
 See Finish Schedule.  
 b. Paint finish millwork shall be paint grade solid wood or edge banded plywood or particle board. Millwork Details.  
 c. Doors, shelves, drawer fronts 3/4" plywood with 1/4" hardwood cabinet sides, base: edgeboard exposed edges. See Details.  
 d. Cabinet back: 1/4" plywood  
 e. Countertop (at Coffee Area): 3/4" particle board with plastic laminate on all exposed surfaces.  
 f. Materials for transparent finish: Cabinets to receive transparent finish ore to be fabricated from grade American maple or cherry wood with matching edge band, U.O.N. Transparent finish scheduled on plans.  
 g. Materials for opaque finish: Cabinets to receive paint ore to be fabricated from point grade materials. See Finish Schedule.

- 3. Casework Hardware**  
 a. Concealed Hinges: Match existing.  
 b. Pulls: Match existing.  
 c. Standards: KV #255 w/KV #256 rests, finish: zinc.  
 d. Grommets: 1-3/4". Manufacturer: Doug Mockett & Co. Finish: brushed chrome.  
 e. Take field measurements as required. Discrepancies between drawings and field dimensions shall be reported to the architect.  
 f. Millwork shall be installed under supervision of factory trained mechanics.  
 g. After installation, check and adjust woodwork and cabinetwork hardware.  
 4. Submit shop drawings, equipment/product cut sheets, and or samples to owner/owner's representative for approval.

- DIVISION 7: THERMAL AND MOISTURE PROTECTION**  
**A. ACOUSTICAL INSULATION**  
 1. Low density acoustic batt insulation to be 3/4 lb./cu.ft., 3-1/2" unfaced fiberglass acoustical insulation Owens Corning noise barrier, SG thermatiber or approved equal. Minimum thickness: 3-1/2", (or approved equal).  
 2. Submit shop drawings, equipment/product cut sheets, and or samples to Owner for approval.

- DIVISION 8: DOORS AND WINDOWS**  
**A. DOORS AND FRAMES**  
 See Door Schedule and Construction Details.  
 1. Aluminum Frames: factory finish aluminum, see door schedule for additional finish information, 20 min. rated where required or shown on plans. See drawings for layout of doors. Submit frame color sample to architect for approval.  
 2. Hollow Metal Frames: One piece knock down, primed to receive finish. Color: See Finish Schedule for additional finish information. Fire rated where required or shown on plans.  
 3. Tenant Doors: Solid core wood door, premium wood veneer with matching rails. See door schedule for additional finish information. Fire rated where required by code or indicated on the plan.  
 4. Doors and frames shall be straight, square and undamaged.  
 5. Installation is to be in accordance with the manufacturer's latest printed instructions. Gaps between frame sections greater than 1/64" to be redone.  
 6. Submit shop drawings, equipment/product cut sheets, and or samples to owner for approval.

- B. GLAZING**  
 1. Glass and glazing shall be installed per published specifications standards, test or recommended methods of industry or governmental organizations which apply to work in this project.  
 a. Flat gloss: Standard Specification C 1036-85 of the ASTM.  
 b. Safety Glazing Standard for Architectural Glazing Materials (16 CFR 1201) issued by the Consumer Product Safety Commission.  
 c. ANSI Z97-1-1975 of the American National Standards Institute, Inc.  
 2. Where glass and glazing is designated on the construction plan, details and elevations, the materials shall be as follows:  
 Glass: Factory cut fully tempered plate glass or laminated glass (as required).  
 Glazing Tape: Performed, pre-shimmed polyisobutylene-butyl tremco 440 or approved equal.  
 Setting Blocks: Shore A Neoprene, 4" min. length.  
 Spacers: Shore A Neoprene.  
 Vinyl Glazing Strips: match existing.  
 Submit sample. Silicone: General Electric Silicone Sealant, color to match existing.  
 3. Submit shop drawings, equipment/product cut sheets, and or samples to owner for approval.

- DIVISION 9: FINISHES**  
**A. METAL FRAMING SYSTEMS:** To be installed per code and construction details.  
**B. GYPSUM WALLBOARD SYSTEMS:** To be installed per code and construction details. Use U.S. Gypsum, Gold Bond or Georgia Pacific. Fire rated assemblies shall be listed and labeled by U.L.

- C. FLOORING:**  
 1. Carpet: Install per manufacturer's recommendations over pad. See Finish Notes and Schedule.  
 2. Pad: Install per manufacturer's recommendations. See Finish Notes and Schedule.  
 3. Vinyl Flooring: Install per manufacturer's recommendations. See Finish Schedule and Schedule.  
 4. Base: Install per manufacturer's recommendations. See Finish Schedule and Schedule.  
 5. Submit shop drawings, equipment/product cut sheets, and or samples to architect for approval.

- D. PAINT:**  
 1. Minimum two-coat application spread as recommended by the paint manufacturer to obtain true, even color. For deepstone colors provide additional coats as needed.  
 a. Primer: As recommended by manufacturer for the substrate and finish required.  
 b. Paint: As indicated. Two coats eggshell finish at all wall surfaces. Semi-gloss work at all millwork, typical. See Finish Schedule for color and manufacturer.  
 2. Submit shop drawings, equipment/product cut sheets, and or samples to owner for approval.

- F. ACOUSTICAL CEILING:**  
 1. Grid: Match existing. Color: Match existing ..  
 2. Tile: Match existing  
 3. Installation: Install per code and manufacturer's recommendations. See Construction Details.  
 4. Finished ceiling to be level within the tolerances of 1/8" in 12'-0".  
 5. Submit shop drawings, equipment/product cut sheets, and or samples to architect for approval.

- DIVISION 10: SPECIALTIES**  
 This section not used.

- DIVISION 11: EQUIPMENT**  
**A. EQUIPMENT SPECIFICATIONS AND OPERATING INSTRUCTIONS BINDER:**  
 1. Contractor to provide equipment specifications and operating instructions binder for all equipment installed. Contractor to provide binder to tenant and building owner prior to final punchlist and application for final payment.

- DIVISION 12: FURNISHINGS**  
**A. BLINDS:** to match existing window treatments on tenant's existing space on floor above.

- DIVISION 13: SPECIAL CONSTRUCTION**  
 This Section not used.

- DIVISION 14: CONVEYING SYSTEMS**  
 This Section not used.

- DIVISION 15: PLUMBING/FIRE PROTECTION**  
**A. PLUMBING:** Engineering to be "Design/Build."  
 1. Installation: Install plumbing in accordance with applicable codes, standards and ordinances.  
 2. Provide cold and hot water lines. Verify location and type.  
 3. Submit shop drawings, equipment/product cut sheets, and or samples to architect for approval

- B. FIRE PROTECTION:** Engineering to be "Design/Build."  
 1. Design Sprinkler System to meet state and local codes.  
 2. Complete Sprinkler system design to be approved by Architect prior to purchase or fabrication of equipment.  
 3. Submit shop drawings, equipment/product cut sheets, and or samples to architect for approval

- C. AIR DISTRIBUTION:** Engineering to be "Design/Build."  
 1. Design air distribution to meet state and local codes.  
 2. HVAC system to conform to Title 24 regulations.  
 3. Complete HVAC system design (including ducts, vents, thermostats, etc.) to be approved by Architect prior to purchase or fabrication of equipment.  
 4. Mechanical contractor to provide Title 24 documentation.  
 5. Submit shop drawings, equipment/product cut sheets, and or samples to architect for approval

- DIVISION 16: ELECTRICAL:**  
**ELECTRICAL A. ELECTRICAL:**  
 Engineering to be "Design/Build."  
 1. Electrical design to meet state and local codes.  
 2. Electrical design to conform to Title 24 regulations.  
 3. Complete electrical system design to be approved by owner.  
 4. Submit shop drawings, equipment/product cut sheets, and or samples to architect for approval.


- B. LIFE SAFETY:**  
 Engineering to be "Design/Build."  
 1. Life safety design to meet state and local codes.  
 2. Complete life safety design to be approved by architect prior to purchase or fabrication of equipment.  
 3. Submit shop drawings, equipment/product cut sheets, and or samples to Owner for approval.



No.	Description	Date

Project number	Project Number
Date	Issue Date
Drawn by	Author
Checked by	Checker

Consultant
Address
Address
Phone
Fax
e-mail

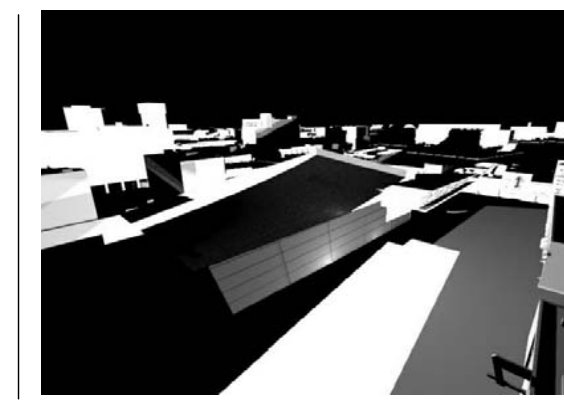

**STITCH STUDIO**  
 Contact: Jorge Escamilla  
 4082 Pomona Street  
 Ventura, California 93003  
 Direct: 818.523.7201  
 Email: info@stitchstudio3d.com

**CANDAMIL RESIDENCE**  
 Remodel to Existing Single Family Dwelling  
 9700 Portada Drive, Whittier, CA


**A500**

3D VIEWS

Scale 12" = 1'-0"



5 3D View 5

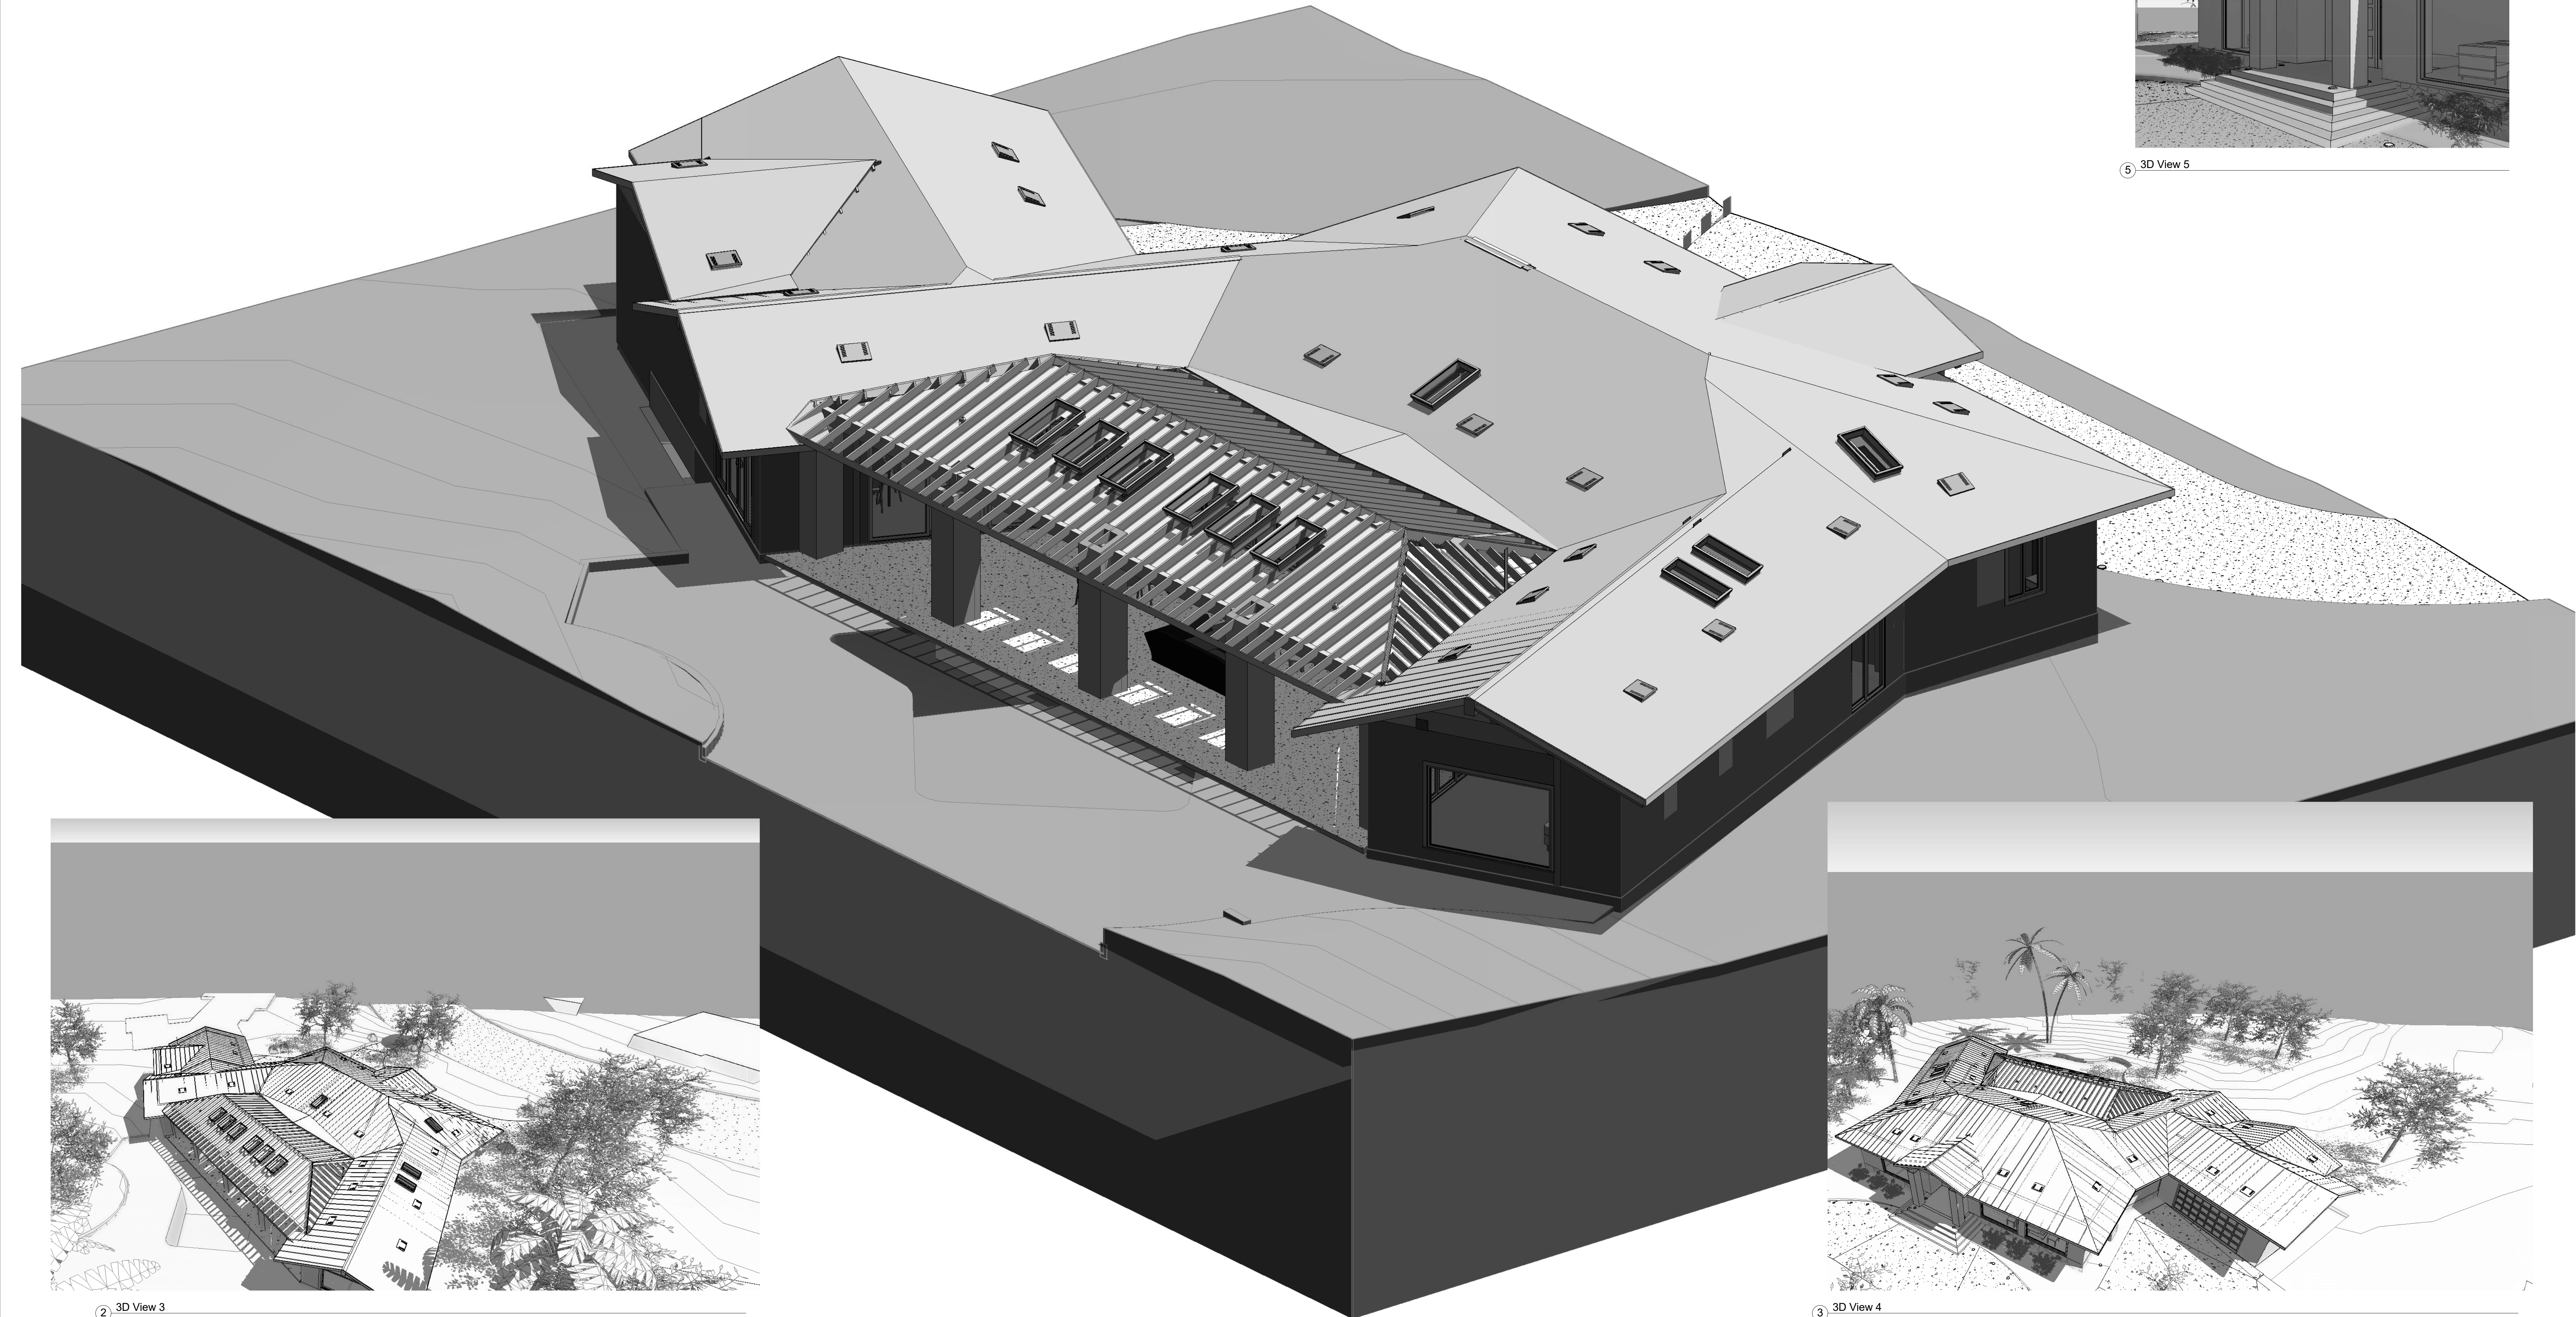

2 3D View 3




3 3D View 4

No.	Description	Date

Project number  
Date  
Drawn by  
Checked by  
Axonometric View 02

Project Number  
Issue Date  
Author  
Checker


Consultant  
Address  
Phone  
Fax  
e-mail

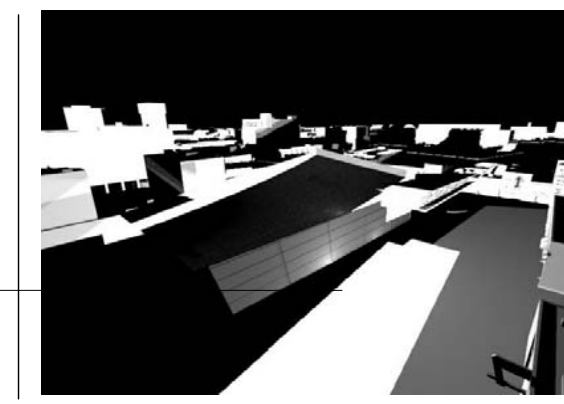


**STITCH  
STUDIO**  
Contact: Jorge Escamilla  
4082 Pomona Street  
Ventura, California 93003  
Direct: 818.523.7201  
Email: info@stitchstudio3d.com

**CANDAMIL RESIDENCE**  
Remodel to Existing Single Family Dwelling  
9700 Portada Drive, Whittier, CA  
3D VIEW (ROOF FRAMING)

**A501**  
Scale

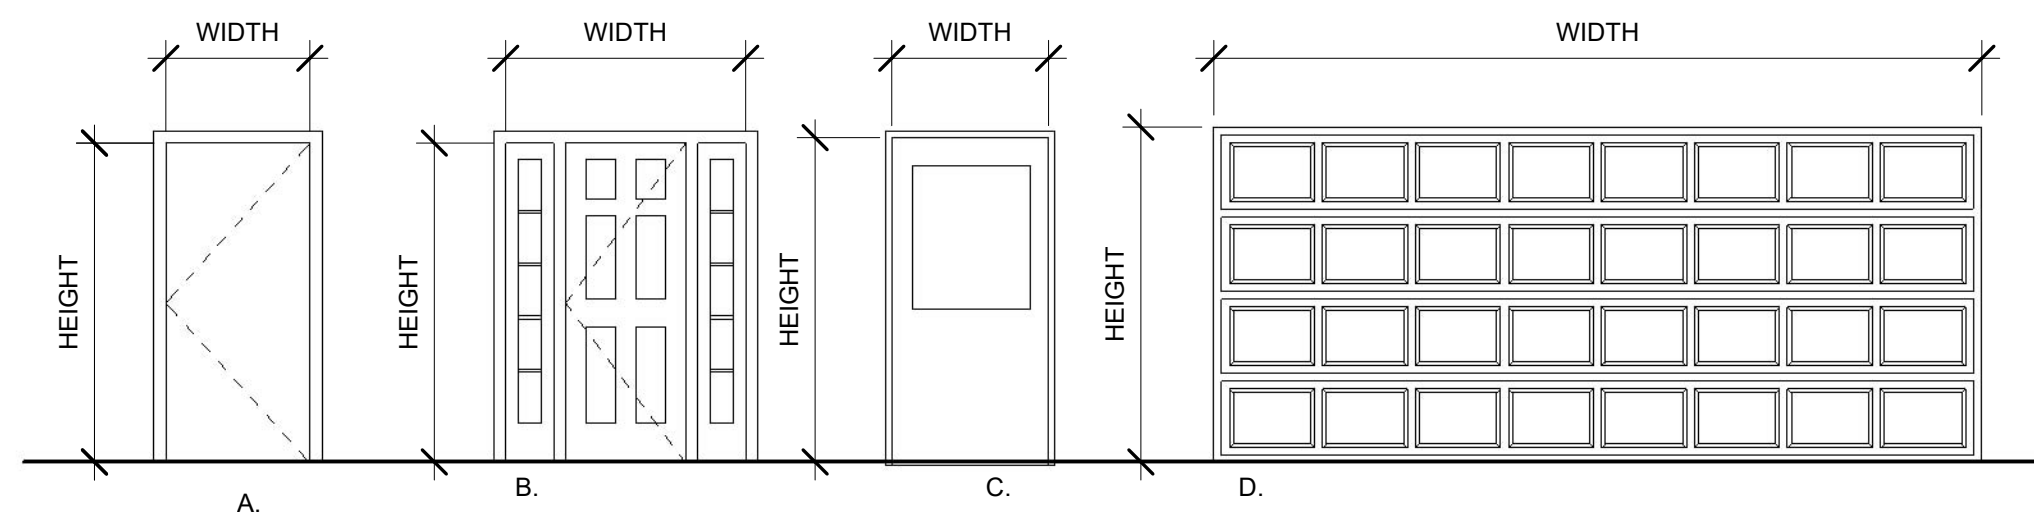


DOOR ELEVATIONS

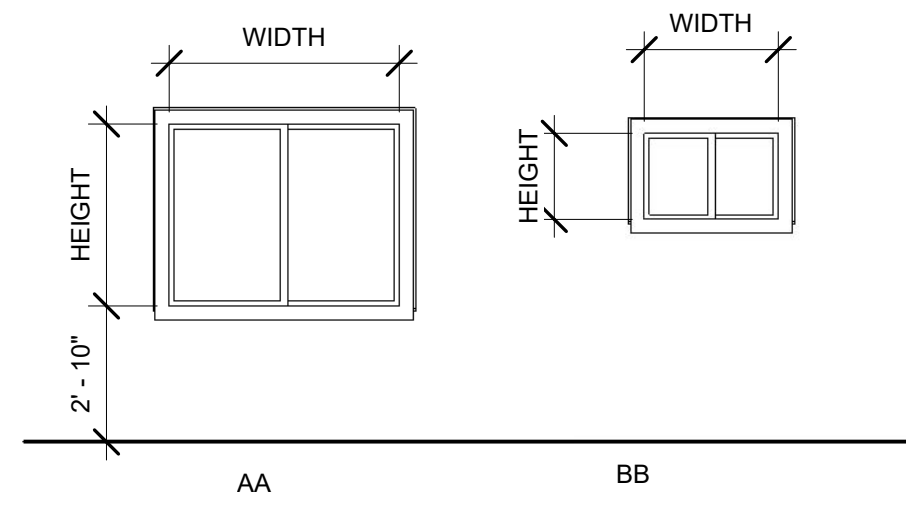

WINDOW ELEVATIONS

DOOR & WINDOW ELEVATIONS  
1/4" = 1'-0"

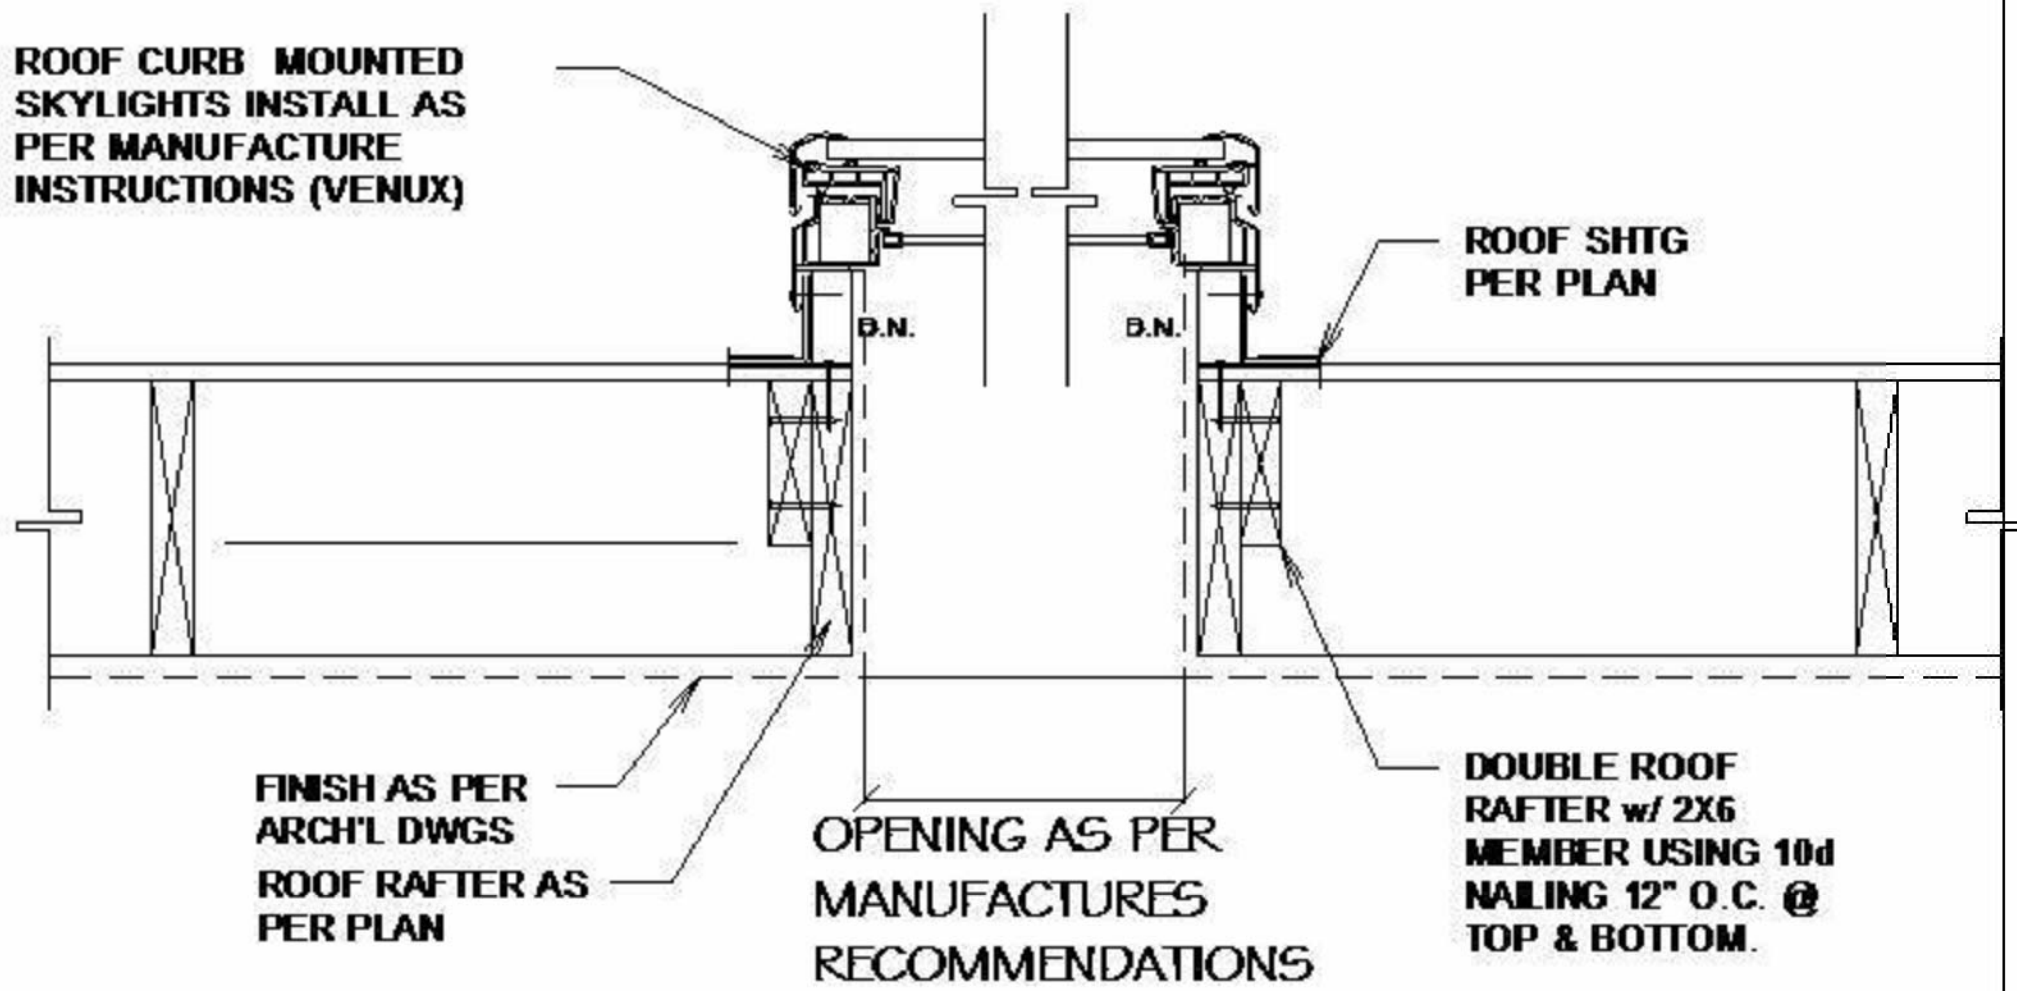

**ROOF MOUNTED SKYLIGHTS**

SCALE: 3/4"=1'-0" 9

Window Schedule															
Type Mark	Count	Rough Opening		Type	Manufacturer	Model	Material	Finish	Detail			Glazing		Head Height	Comments
		Width	Height						Head	Jamb	Sill	Thickness	Type		
A	4	2' - 0"	4' - 0"	Double Hung with Trim											
B	1	3' - 0"	4' - 0"	Slider with Trim										6' - 8"	
C	8	3' - 5"	3' - 5"	Window-Sliding-Milgard-Montecito_Series-Half_Vent	© 2011 Milgard Manufacturing, Inc.	Montecito® Series								6' - 5"	
D	2	4' - 0"	4' - 0"	Window-Sliding-Milgard-Montecito_Series-Half_Vent	© 2011 Milgard Manufacturing, Inc.	Montecito® Series								7' - 0"	
E	1	7' - 8"	3' - 5"	Window-Sliding-Milgard-Montecito_Series-Half_Vent	© 2011 Milgard Manufacturing, Inc.	Montecito® Series								7' - 7"	
F	7	2' - 2"	4' - 2"	Window-skylight-VELUX_FCM-curb_mounted-fixed	VELUX	FCM									
G	6	2' - 10"	4' - 2"	Window-skylight-VELUX_FCM-curb_mounted-fixed	VELUX	FCM									
H	4	9' - 0"	6' - 8"	Fixed with Trim											
J	1	9' - 0"	5' - 10"	Fixed with Trim										6' - 8"	
K	1	7' - 6"	4' - 0"	Window-Sliding-Milgard-Montecito_Series-Double_Vent(1)	© 2013 Milgard Manufacturing, Inc.	Montecito® Series								7' - 4"	

Door Schedule																
Door Number	Door Type	Door Size	Phase Created	Manufacturer	Model	Frame Type	Fire Rating	Head	Details			Description	Finish			Comments
									Jamb	Sill			Door	Frame		
102	77	78" x 80"	Existing	© 2012 Milgard Manufacturing, Inc.	Tuscany® Series							Vinyl Doors				
103	36	32" x 80"	Existing													
104	36	32" x 80"	Existing													
105	36	32" x 80"	Existing													
106	38	30" x 80"	Existing													
107	38	30" x 80"	Existing													
108	97	30" x 80"	Existing													
109	81	32" x 80"	Existing									32" x 80"				
110	61	34" x 80"	Existing													
111	65	126" x 80"	Existing													
112	98	Front_Entry_14636	Existing													
113	36	32" x 80"	Existing													
114	38	30" x 80"	Existing													
115	49	68" x 80"	Existing													
116	61	34" x 80"	Existing													
117	61	34" x 80"	Existing													
118	100	42" x 80"	Existing													
119	61	34" x 80"	Existing													
122	67	16" x 7"	Existing													
152	79	30" x 80"	Existing									30" x 80"				
154	94	96" x 80"	Existing	© 2012 Milgard Manufacturing, Inc.	Tuscany® Series							Vinyl Doors				
155	103	120" x 88"	Existing	© 2012 Milgard Manufacturing, Inc.	Tuscany® Series							Vinyl Doors				
Existing: 22																
123	36	32" x 80"	New Construction													
124	36	32" x 80"	New Construction													
125	36	32" x 80"	New Construction													
126	40	34" x 80"	New Construction													
127	36	32" x 80"	New Construction													
128	36	32" x 80"	New Construction													
129	49	68" x 80"	New Construction													
130	87	36" x 80"	New Construction													
131	76	60" x 80"	New Construction	© 2012 Milgard Manufacturing, Inc.	Tuscany® Series							Vinyl Doors				
132	95	32" x 80"	New Construction													
133	36	32" x 80"	New Construction													
134	87	36" x 80"	New Construction													
137	103	120" x 88"	New Construction	© 2012 Milgard Manufacturing, Inc.	Tuscany® Series							Vinyl Doors				
138	102	192" x 88"	New Construction	© 2012 Milgard Manufacturing, Inc.	Tuscany® Series							Vinyl Doors				
139	103	120" x 88"	New Construction	© 2012 Milgard Manufacturing, Inc.	Tuscany® Series							Vinyl Doors				
140	41	36" x 84"	New Construction													
141	36	32" x 80"	New Construction													
142	36	32" x 80"	New Construction													
143	113	60" x 88"	New Construction	© 2012 Milgard Manufacturing, Inc.	Tuscany® Series							Vinyl Doors				
145	67	16" x 7"	New Construction													
146	116	68" x 80"	New Construction													
147	69	60" x 80"	New Construction													
153	36	32" x 80"	New Construction													
156	103	120" x 88"	New Construction	© 2012 Milgard Manufacturing, Inc.	Tuscany® Series							Vinyl Doors				
157	103	120" x 88"	New Construction	© 2012 Milgard Manufacturing, Inc.	Tuscany® Series							Vinyl Doors				


New Construction: 25

No.	Description	Date
2	2nd Plan Check	04/10/17

Project number  
Date  
Drawn by  
Checked by

Project Number  
Issue Date  
Author  
Checker

Consultant  
Address  
Address  
Phone  
Fax  
e-mail

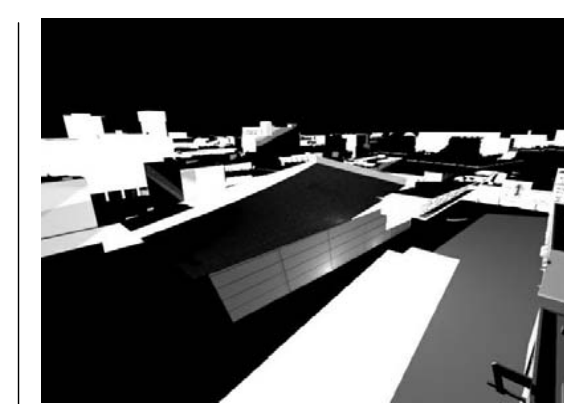

**STITCH STUDIO**  
Contact: Jorge Escamilla  
4082 Pomona Street  
Ventura, California 93003  
Direct: 818.523.7201  
Email: info@stitchstudio3d.com

**CANDAMIL RESIDENCE**

Remodel to Existing Single Family Dwelling

9700 Portada Drive, Whittier, CA


SCHEDULES

**A601**

Scale As indicated






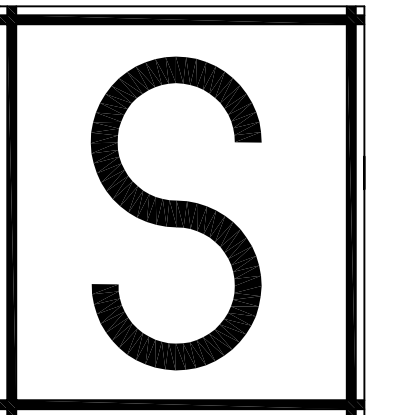

**SAYAH**  
ENGINEERING INC  
Structural - Civil - Design

TEL 818 . 788 . 7887  
16233 Ventura Blvd., Suite 1130  
Sherman Oaks, Ca. 91403-2201  
FAX 818 . 788 . 7827

When dimensions on these drawings shall have precedence over scaled dimensions, contractor shall verify and be responsible for all dimensions and conditions on the job and his office must be notified of any variations from the dimensions and conditions shown by these drawings.  
These drawings, specifications and notes, details and arrangements represented thereby are and shall remain the property of SAYAH ENGINEERING INC and no part thereof shall be copied, disclosed to others or used in connection with any work or project other than the specific project for which they have been prepared and developed without the written consent of SAYAH ENGINEERING INC. Visual contact with these drawings or specifications shall constitute conclusive evidence of acceptance of these provisions.

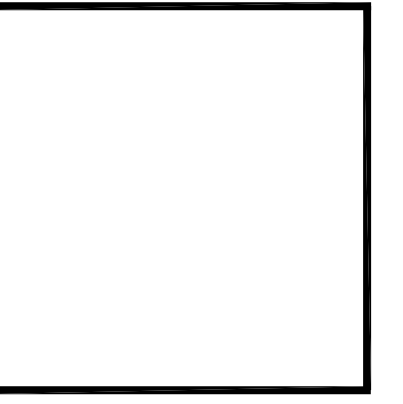


**Candamil Residence**  
1-story addition & remodel  
Candamil Residence  
9700 Portada Drive  
Whittier, Ca 90603

Sheet Contents:

Foundation Plan

Scale: AS SHOWN

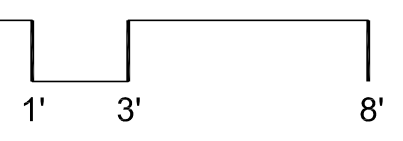

Revisions:

Date: 2017.04.05


Project No.: S16225

File Name: S16225\_S

Sheet No.:

**S-2.0**

Total Sheets:

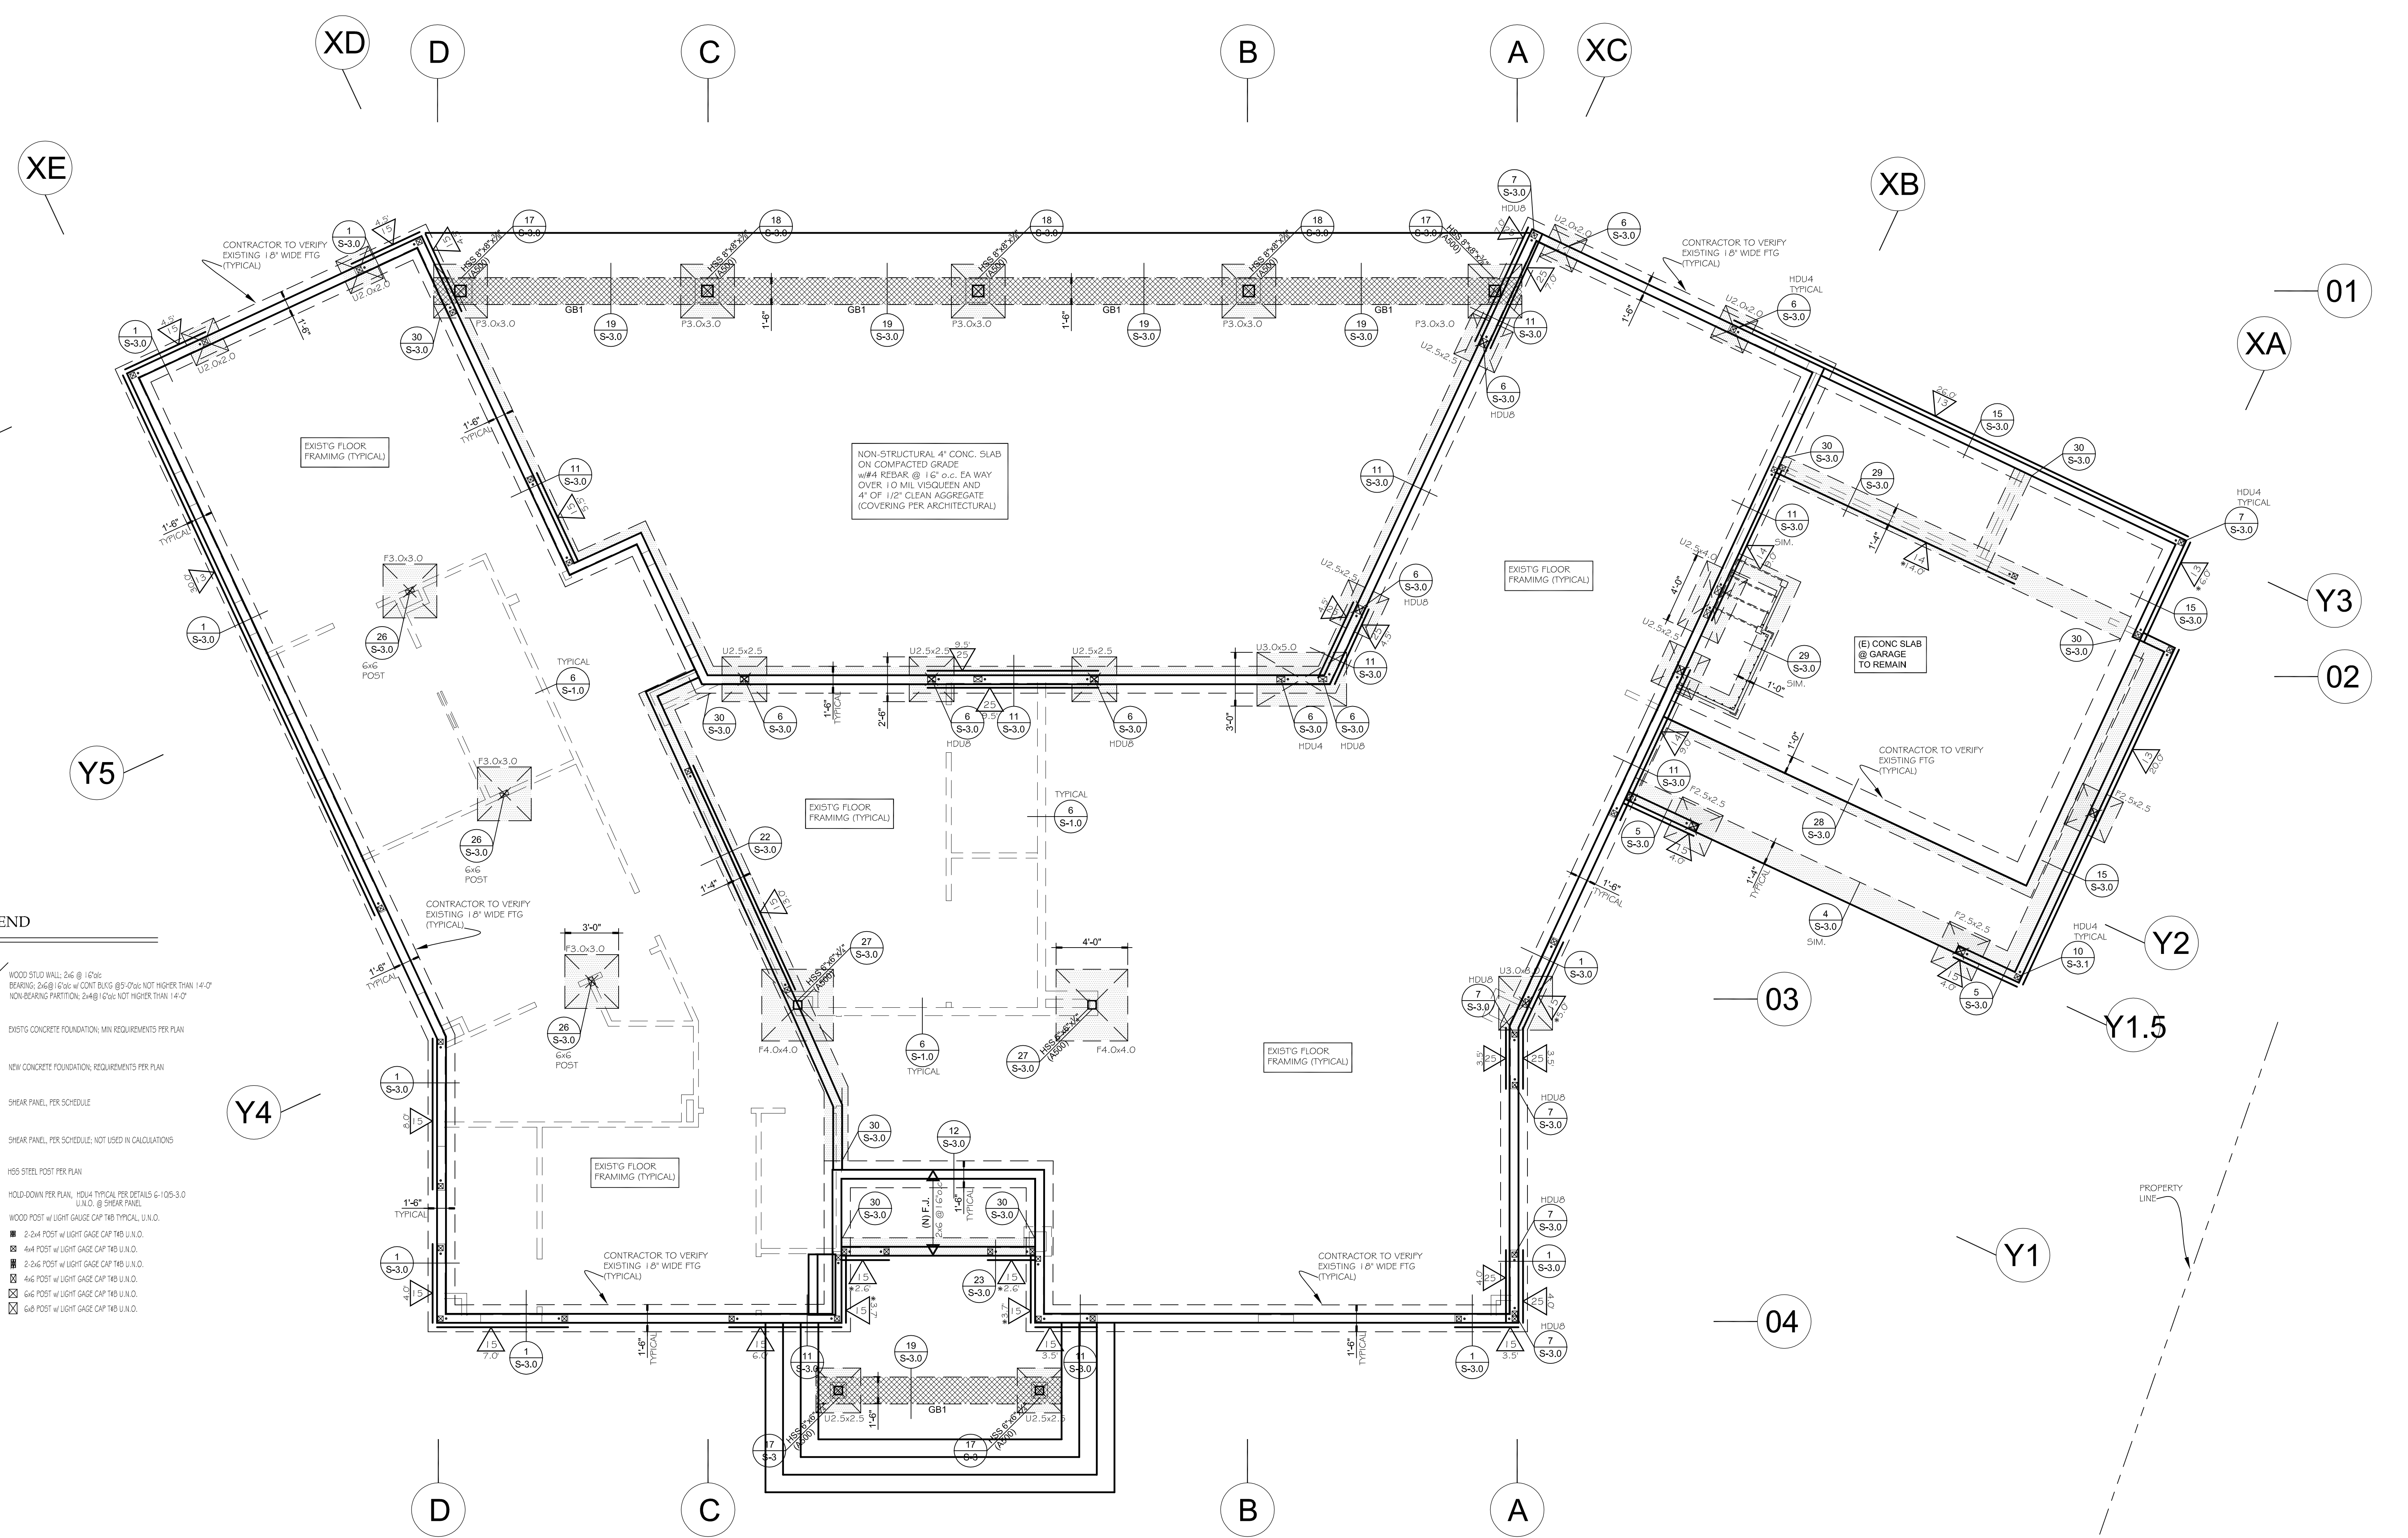

**LEGEND**

	WOOD STUD WALL, 2x6 @ 16" O.C. BEARING, 2x4 @ 16" O.C. CAP. MIN. REQUIREMENTS PER PLAN.
	EXISTING CONCRETE FOUNDATION, MIN. REQUIREMENTS PER PLAN.
	NEW CONCRETE FOUNDATION, REQUIREMENTS PER PLAN.
	SHEAR PANEL, PER SCHEDULE.
	SHEAR PANEL, PER SCHEDULE, NOT USED IN CALCULATIONS.
	165 STEEL POST PER PLAN.
	HOLD-DOWN PER PLAN, HDU4 TYPICAL PER DETAILS 6-105-3.0 U.N.O. @ SHEAR PANEL.
	WOOD POST w/ LIGHT GAUGE CAP PER PLAN, U.N.O.
	2x4 POST w/ LIGHT GAUGE CAP PER PLAN, U.N.O.
	4x4 POST w/ LIGHT GAUGE CAP PER PLAN, U.N.O.
	6x6 POST w/ LIGHT GAUGE CAP PER PLAN, U.N.O.
	6x6 POST w/ LIGHT GAUGE CAP PER PLAN, U.N.O.

**FOUNDATION PLAN**

NOTES: SCALE: 1/4" = 1'-0"


- IF ADVERSE SOIL CONDITIONS ARE ENCOUNTERED, A SOILS INVESTIGATION REPORT MAY BE REQUIRED.
- WOOD IN CONTACT WITH CONCRETE OR MASONRY MUST BE PRESSURE TREATED.
- INDICATES HOLD DOWN @ END OF SHEAR PANEL; TO BE HDU4 TYPICAL, U.N.O.
- SEPARATION BETWEEN WOOD AND EARTH MUST BE AT LEAST 8". THE SEPARATION MAY BE 6" IF ADJACENT TO A PAVED SURFACE DRAINING AWAY FROM THE BUILDING.
- CONTRACTOR TO VERIFY EXISTING CONDITIONS AND NOTIFY ENGINEER IN WRITING FOR AUTHORIZATION ON ANY CHANGE IN PLANS OR DETAILS.
- CONCRETE STRENGTH OF FOUNDATIONS SHALL BE 2500 psi MIN (CRC, R402.2 Table R402.2).
- MINIMUM FOOTING REINFORCEMENT SHALL BE ONE #4 BAR TOP AND BOTTOM (CRC R403.1.3).
- MINIMUM ANCHOR BOLT SIZE AND SPACING SHALL BE 5/8" DIA A.B. @ 72" O.C. WITH 7" EMBEDMENT AND 3"x3"x1/4" PLATE WASHERS. ANCHOR BOLTS SHALL BE LOCATED A MINIMUM OF 12" and 4 1/2" MINIMUM FROM THE END OF THE PLATE (CRC R403.1.6, R602.11.1).

**GRADE BEAM SCHEDULE (3000 PSI CONCRETE @28 DAY)**

MARK	SIZE (WxH)	REBAR	TIES	NOTE
GB1	16" x 24"	2-#6 T&B	#4@12" O.C.	

**TABLE 1.0: FOOTING SCHEDULE (2500 PSI CONCRETE @28DAY)**


MARK	SIZE (WxLxH)	REBAR	DEPTH IN SOIL	NOTE
CONT FTG	W = PER LPAN L = PER PLAN H = 24"	#4@12" O.C. T&B MIN 2#4 T&B	24" MIN	FTG WIDTH PER PLAN AS NOTED, 12" MIN ALL ELSE
PAD-FTG "F<Wx<L>"	W = PER PLAN L = PER PLAN H = 24"	#4@8" O.C. T&B EA. WAY	24" MIN	SEE DETAIL 26/S-3.0 & 27/S-3.0
PAD-FTG "F<Wx<L>"	W = PER PLAN L = PER PLAN H = 16"	#4@8" O.C. T&B EA. WAY	24" MIN	SEE DETAIL 17/S-3.0 & 18/S-3.0
UNDER-FTG "U<Wx<L>"	W = PER PLAN L = PER PLAN H = 12" MIN.	#4@8" O.C. EA. WAY	24" MIN	SEE DETAIL 6/S-3.0 & 16/S-3.0

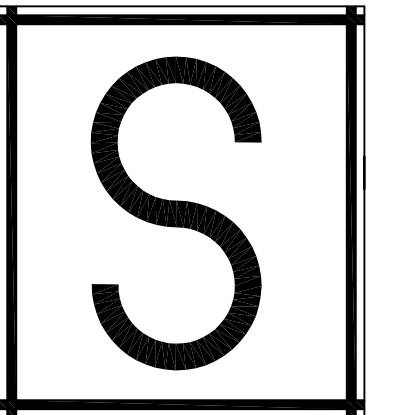

**SAYAH**  
ENGINEERING INC  
Structural - Civil - Design

TEL 818 . 788 . 7887  
15233 Ventura Blvd., Suite 1130  
Sherman Oaks, Ca. 91403-2201  
FAX 818 . 788 . 7827

When dimensions on these drawings shall have precedence over scaled dimensions, contractor shall verify and be responsible for all dimensions and conditions on the job and his office must be notified of any variations from the dimensions and conditions shown by these drawings.  
These drawings, specifications and notes, design and arrangements represented thereby are and shall remain the property of SAYAH ENGINEERING INC and no part thereof shall be copied, disclosed to others or used in connection with any work or project other than the specific project for which they have been prepared and designed without the written consent of SAYAH ENGINEERING INC. Visual contact with these drawings or specifications shall constitute conclusive evidence of acceptance of these provisions.

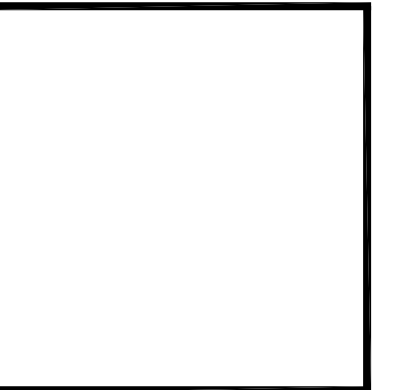


**Candamil Residence**  
1-story addition & remodel

Candamil Residence  
9700 Portada Drive  
Whittier, Ca 90603

Sheet Contents:

Roof Framing Plan

Scale: AS SHOWN

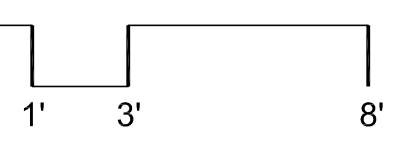

Revisions:

Date: 2017.04.05


Project No.: S16225

File Name: S16225\_S

Sheet No.:

**S-2.1**

Total Sheets:

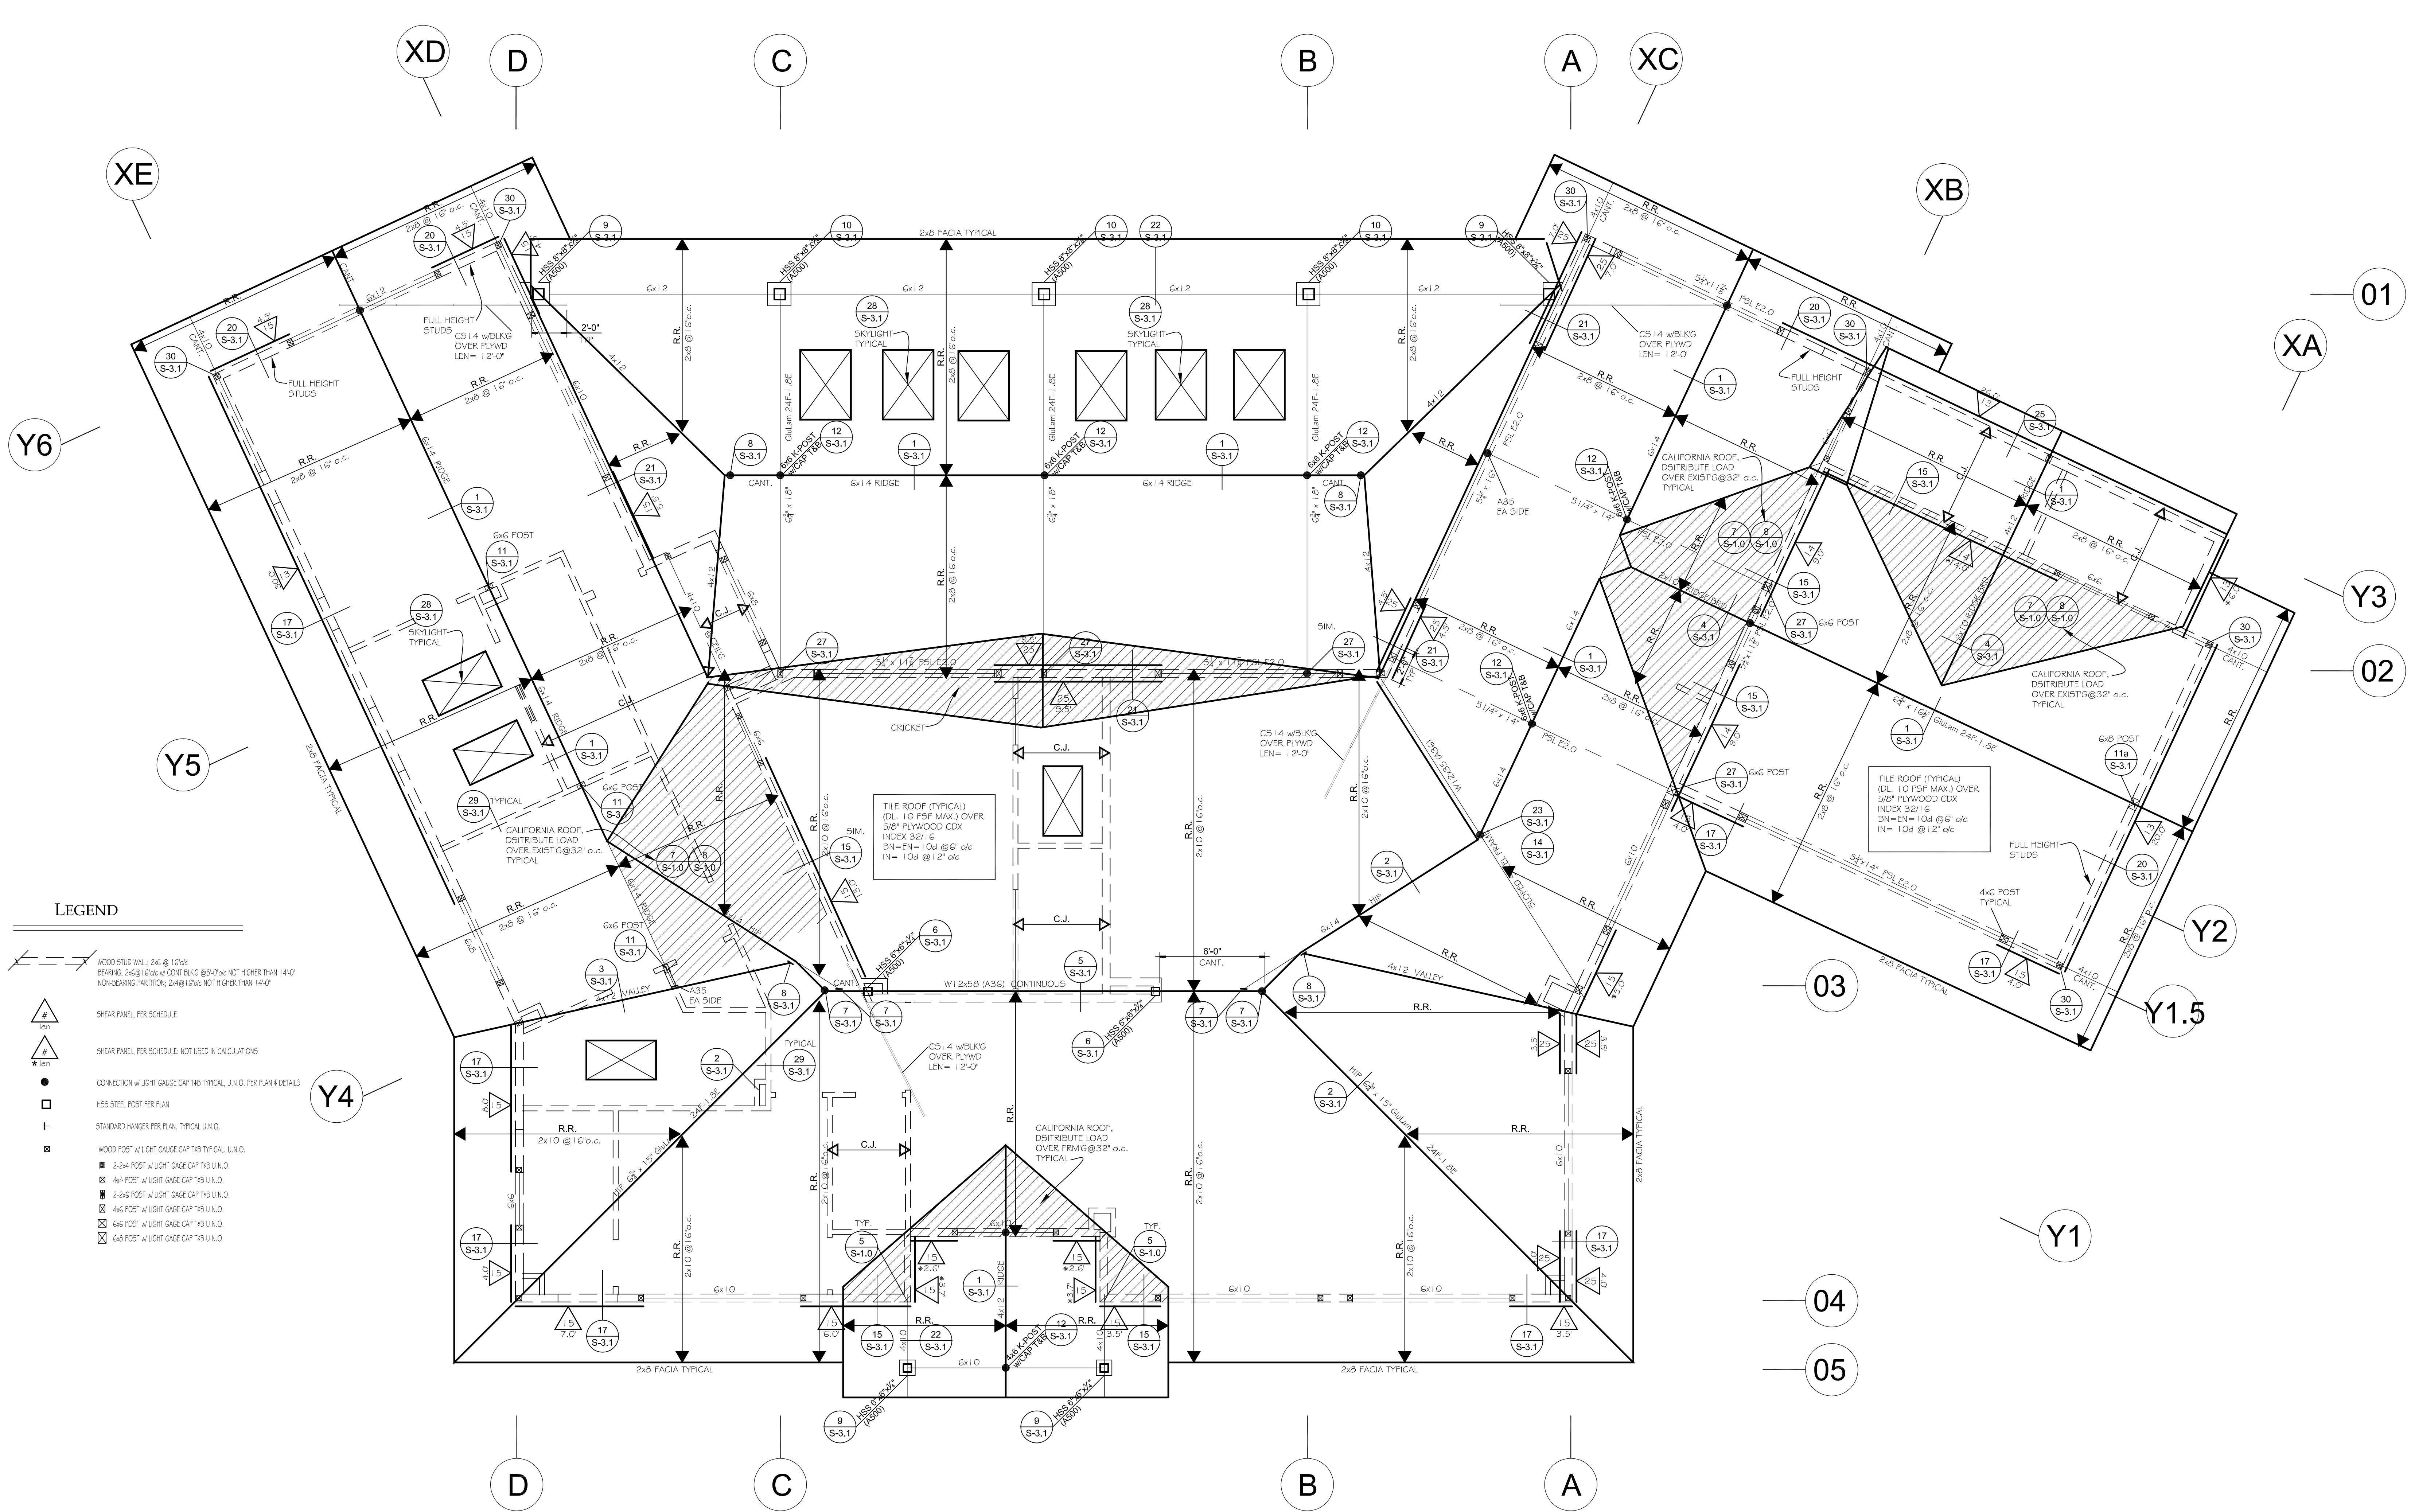

**LEGEND**


- WOOD STUD WALL 2x6 @ 16" o.c. BEARING 2x6 @ 16" o.c. w/ CONT. BRG. @ 8'-0" o.c. NOT HIGHER THAN 14'-0" NON-BEARING PARTITION 2x4 @ 12" o.c. NOT HIGHER THAN 14'-0"
- SHEAR PANEL PER SCHEDULE
- SHEAR PANEL PER SCHEDULE; NOT USED IN CALCULATIONS
- CONNECTION w/ LIGHT GAUGE CAP TIE TYPICAL, U.N.O. PER PLAN & DETAILS
- HSS STEEL POST PER PLAN
- STANDARD HANGER PER PLAN, TYPICAL U.N.O.
- WOOD POST w/ LIGHT GAUGE CAP TIE TYPICAL, U.N.O.
- 2x4 POST w/ LIGHT GAUGE CAP TIE U.N.O.
- 4x4 POST w/ LIGHT GAUGE CAP TIE U.N.O.
- 2x6 POST w/ LIGHT GAUGE CAP TIE U.N.O.
- 4x6 POST w/ LIGHT GAUGE CAP TIE U.N.O.
- 6x6 POST w/ LIGHT GAUGE CAP TIE U.N.O.

**ROOF FRAMING PLAN**

NOTES: SCALE: 1/4" = 1'-0"

1. ALL ROOFING MATERIAL UNDER CALIFORNIA OR CRICKET ROOF SECTIONS, ARE TO BE REMOVED PRIORI TO INSTALLATION OF NEW ROOF FRAMING.
2. ROOF RAFTER(R.R.) TO BE 2x8 @ 16" o.c, U.N.O.; CEILING JOIST (C.J.) TO BE 2x8@16"o.c U.N.O.
3. STUDS TO BE 2x6@ 16 o/c w/ 2x BLOCKING @ 5'-0" o.c. MAX NOT HIGHER THAN 14'-0" U.N.O.
4. INDICATES 4x4 or 2-2x6 POST MINIMUM, U.N.O.
5. CONTRACTOR TO VERIFY EXISTING CONDITIONS AND NOTIFY ENGINEER IN WRITING FOR AUTHORIZATION ON ANY CHANGE IN PLANS OR DETAILS.
6. INDICATES NEW CALIFORNIA ROOF OVER EXISTING OR NEW.
7. ORIENTED STRAND BOARD (OSB) CAN BE SUBSTITUTED FOR PLYWOOD PER STRUCTURAL GENERAL NOTES 10/S-1

When dimensions on these drawings do not have precedence over verbal directions, contractors shall verify and be responsible for all dimensions and conditions on the job and this office must be notified of any variations from the drawings and conditions shown by these drawings.  
 These drawings, specifications and notes, designs and arrangements represented hereby are and shall remain the property of SAYAH ENGINEERING INC and no part thereof shall be copied, disclosed or otherwise used in connection with any work or project other than the specific project for which they have been prepared and designed without the written consent of SAYAH ENGINEERING INC. Visual contact with these drawings or specifications shall constitute conclusive evidence of acceptance of these conditions.

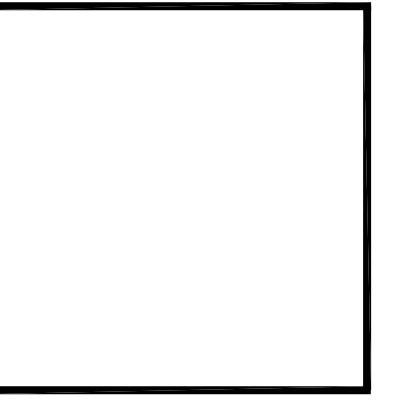
































Sheet Contents:  
 Details

Scale: AS SHOWN




Revisions:

Date: 2017.04.05  
 Project No.: S16225  
 File Name: S16225\_S  
 Sheet No.:

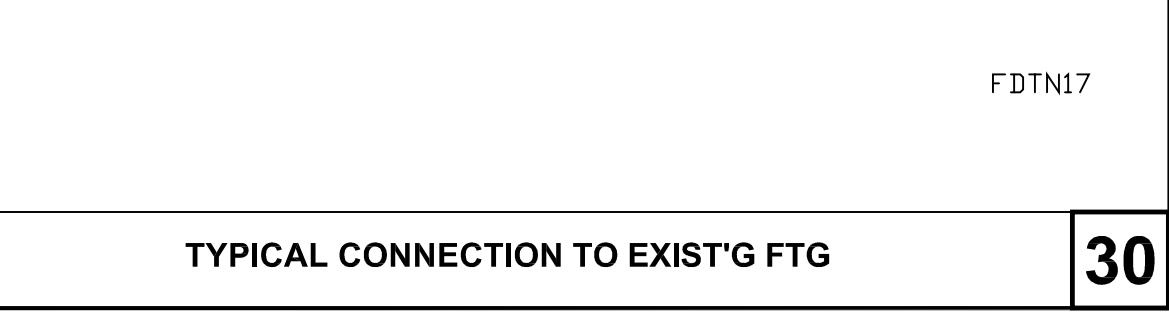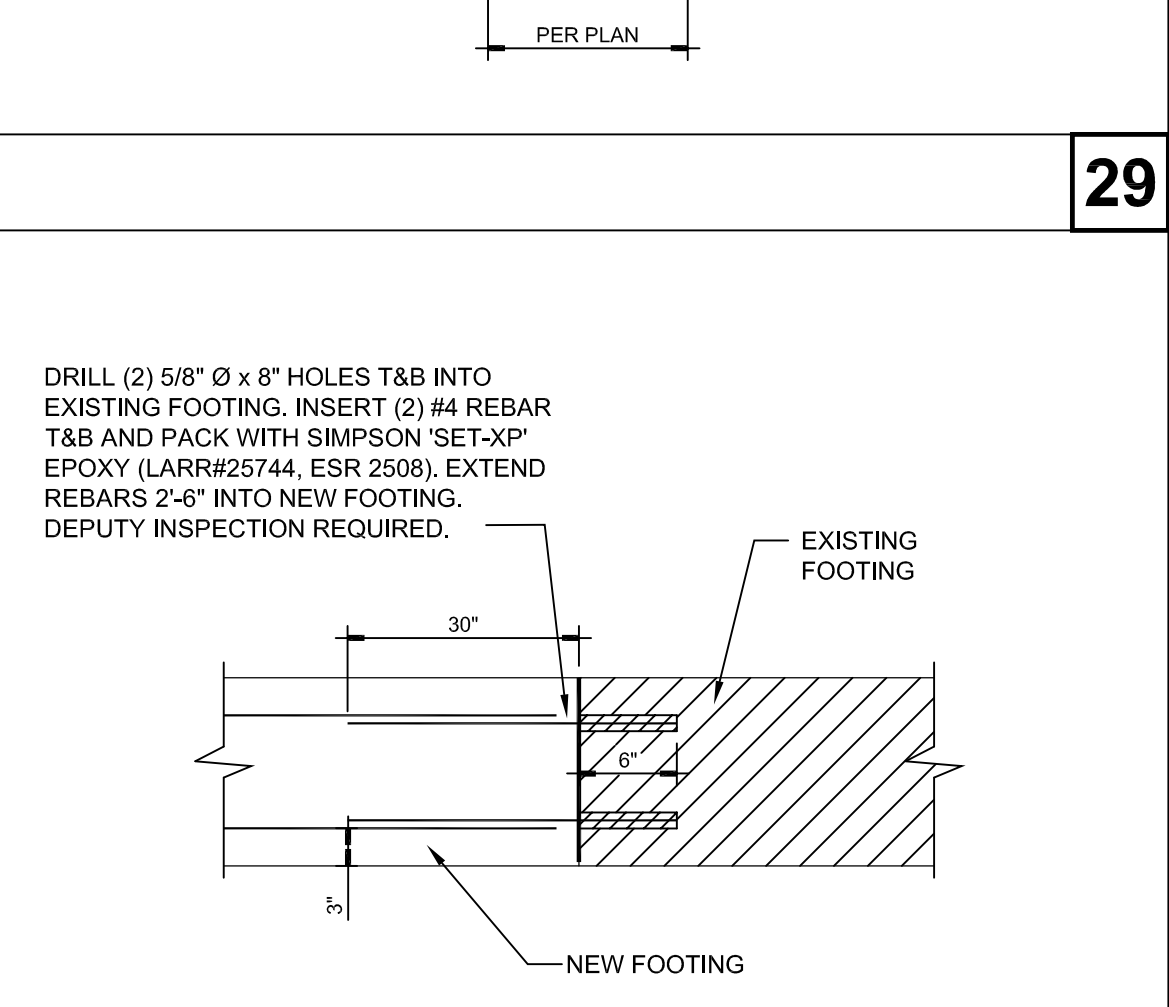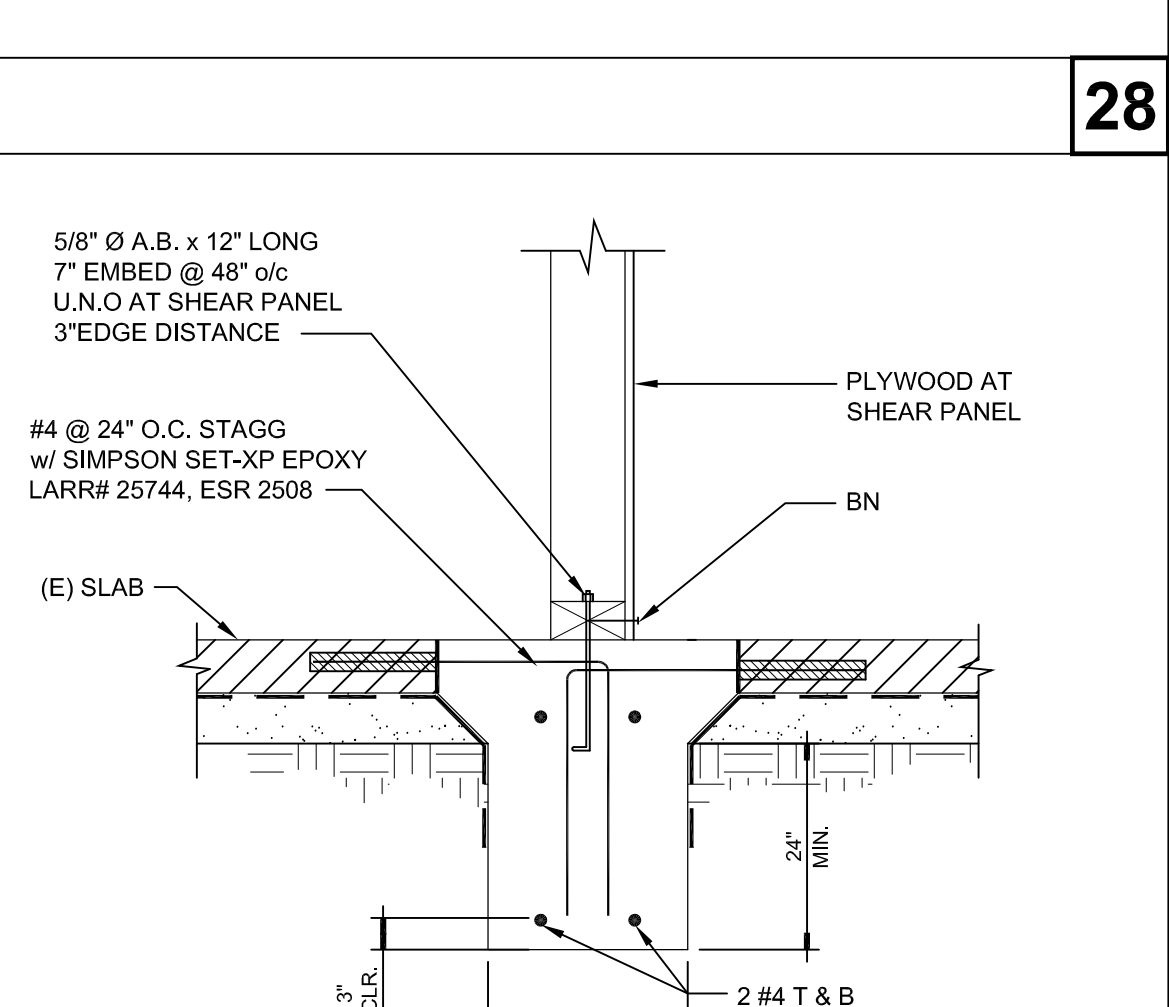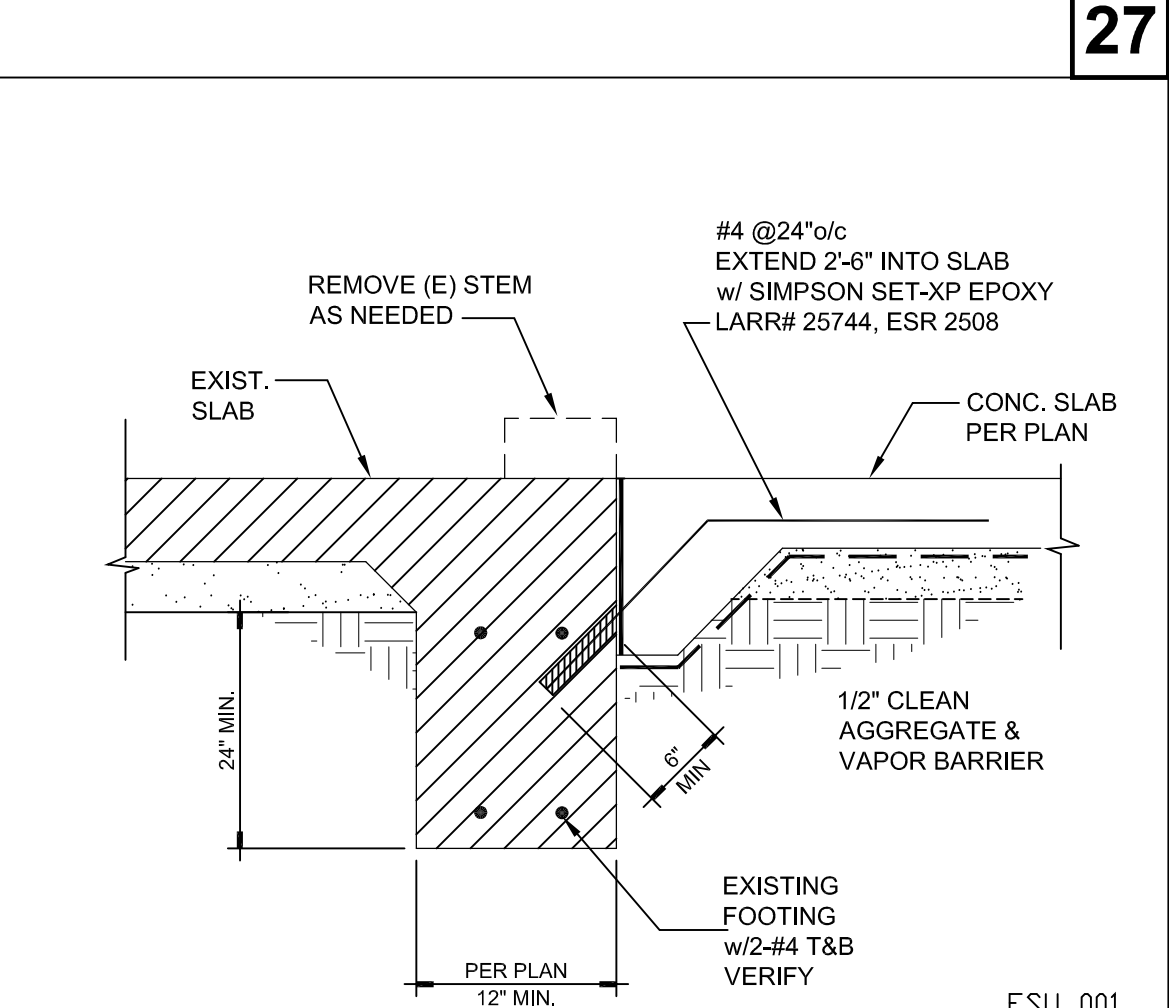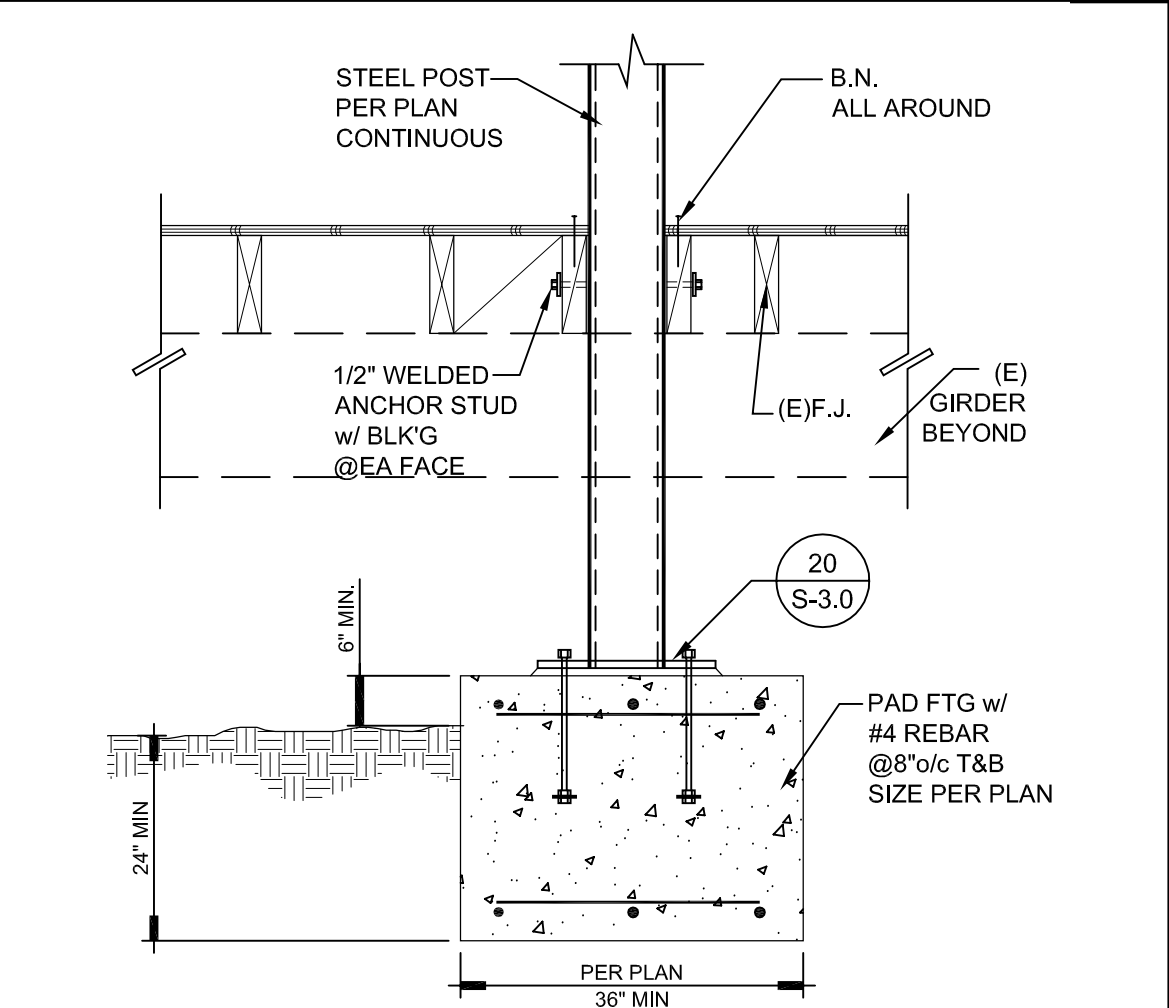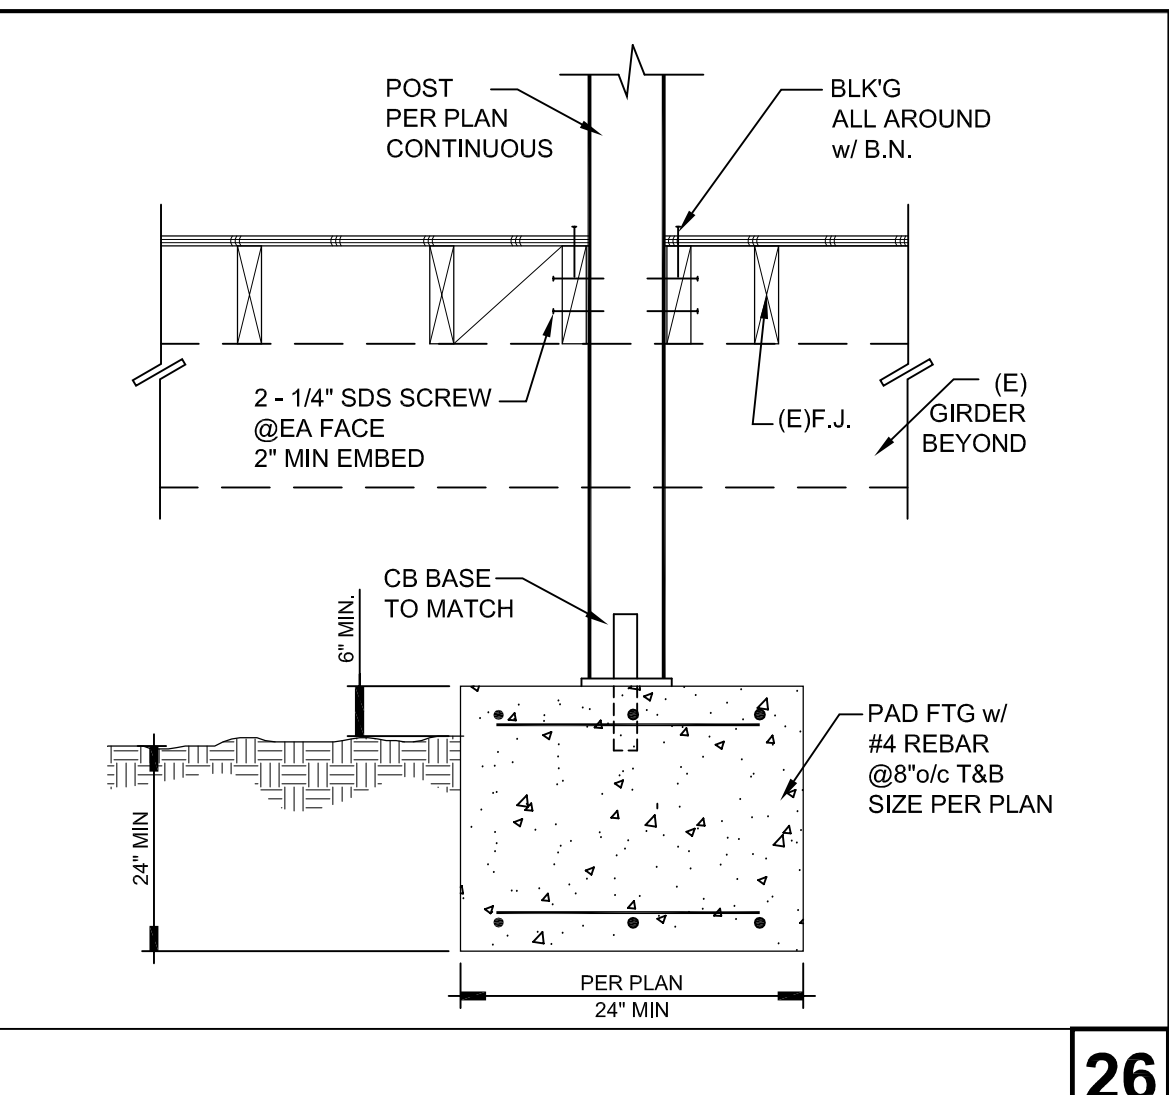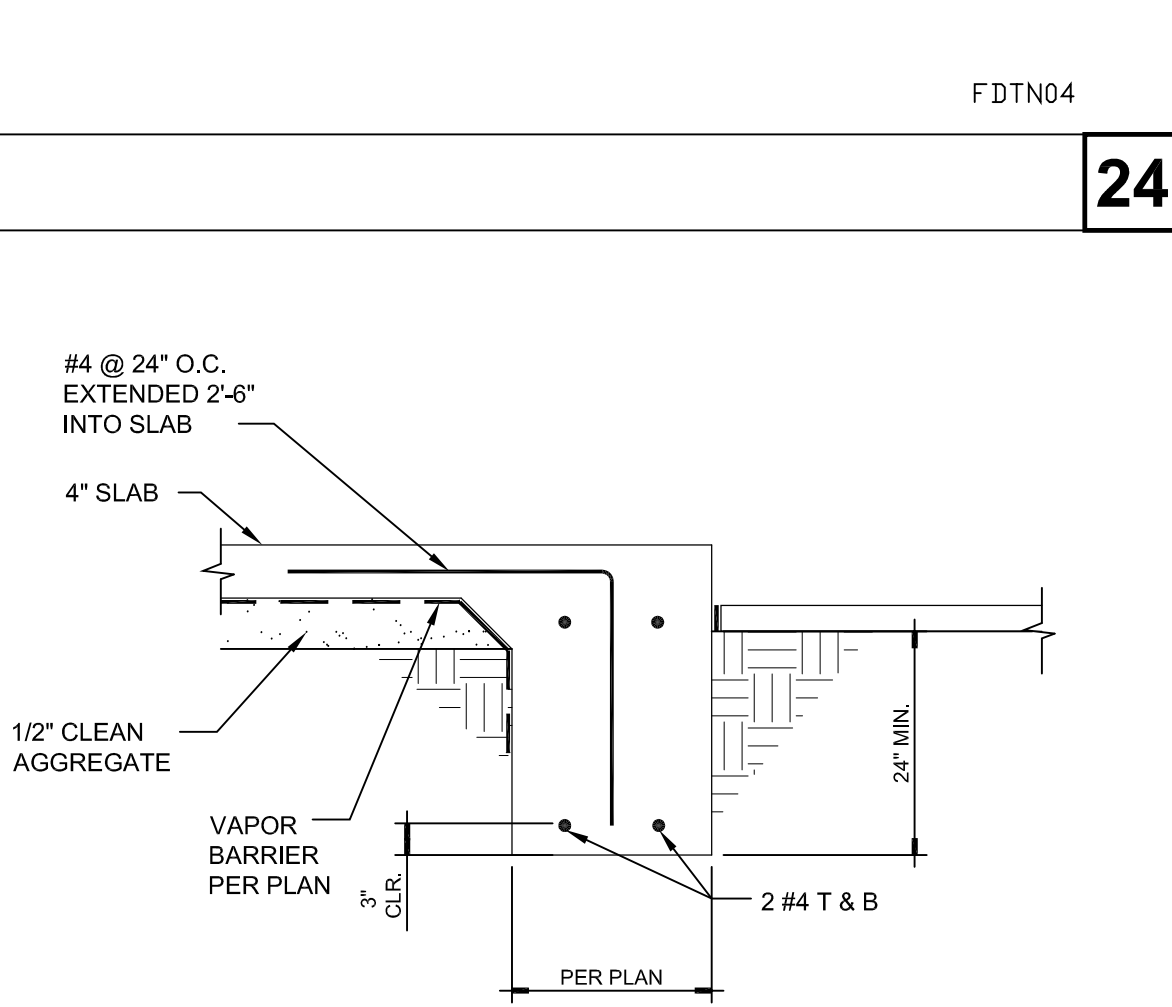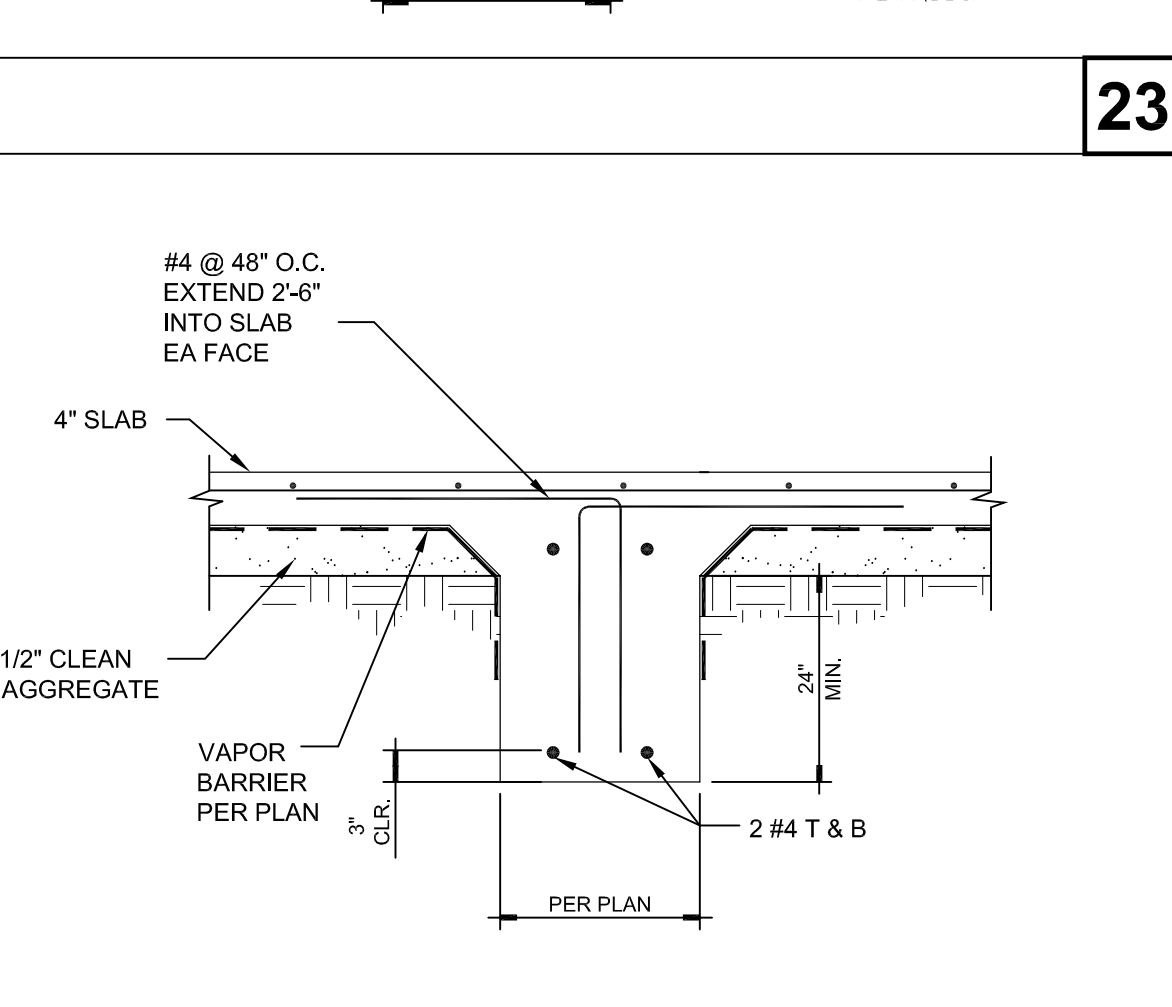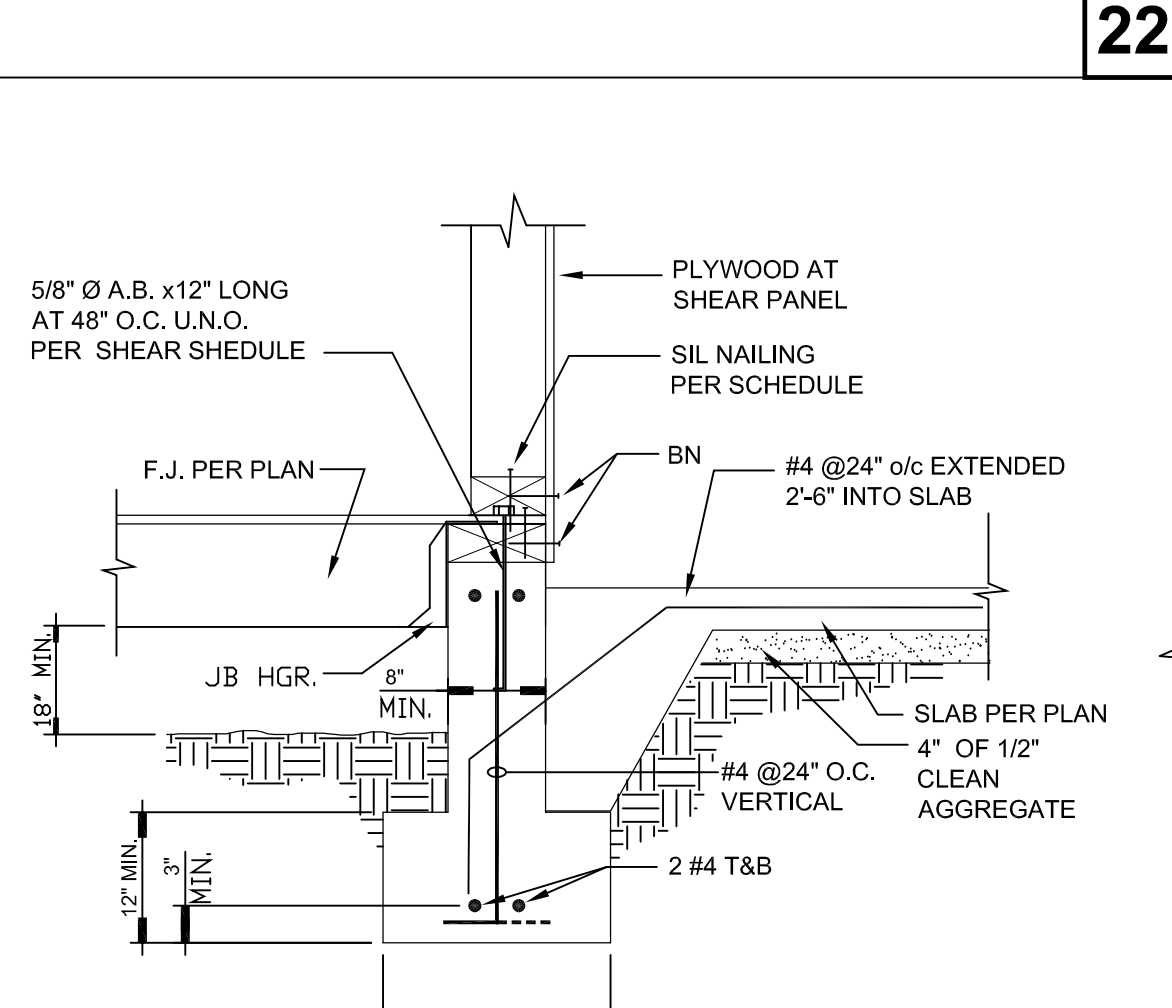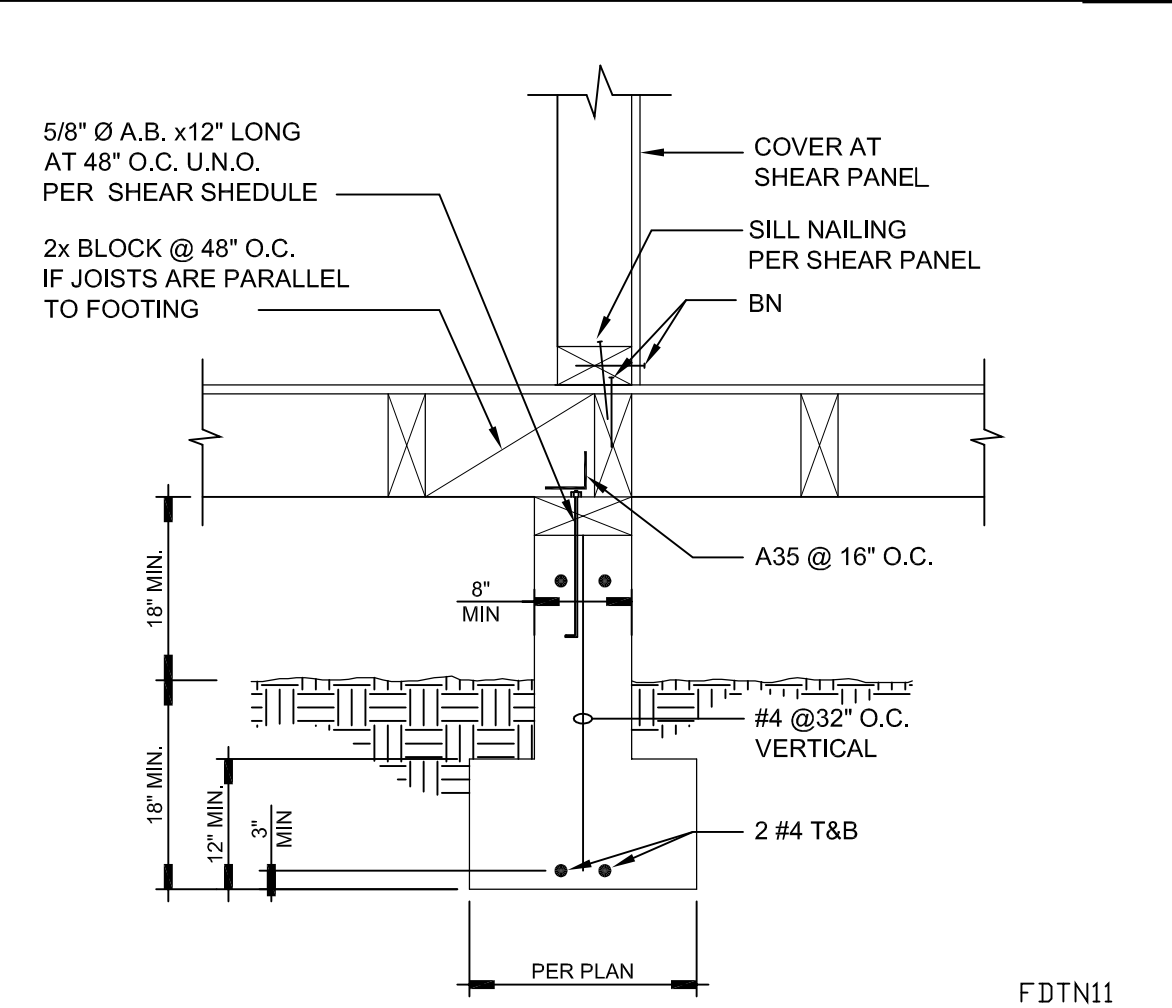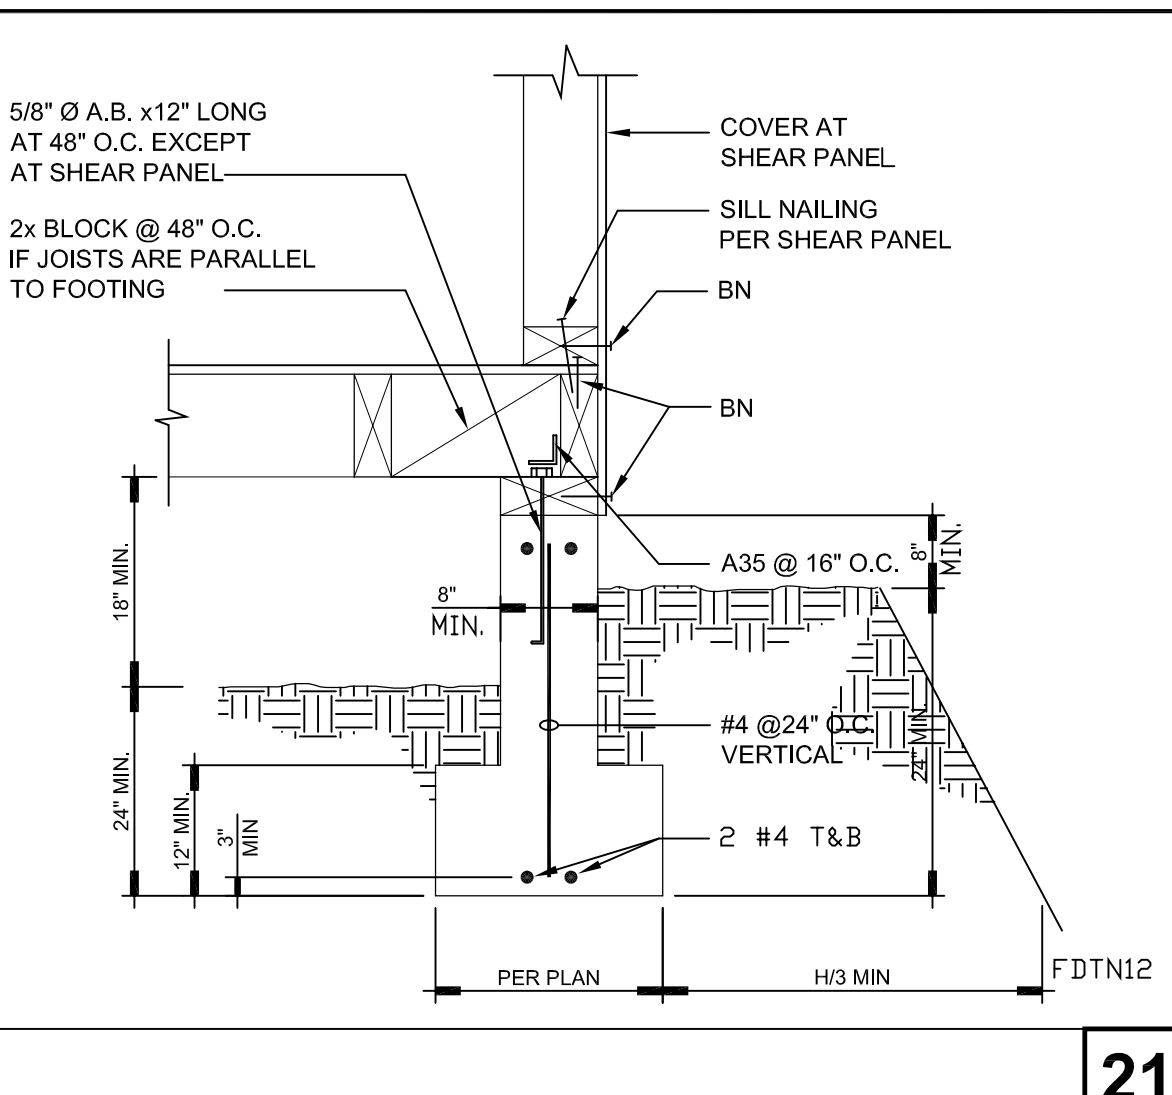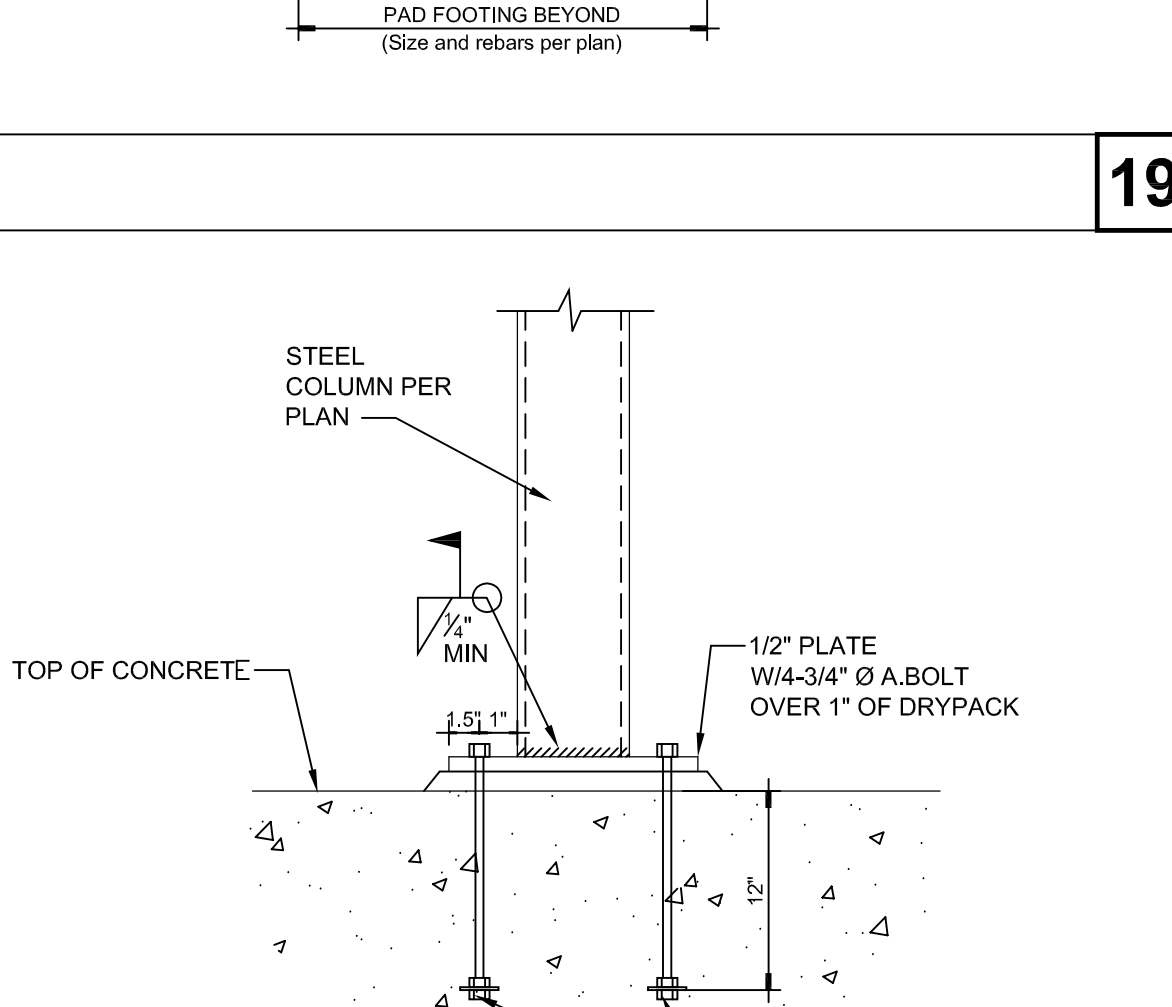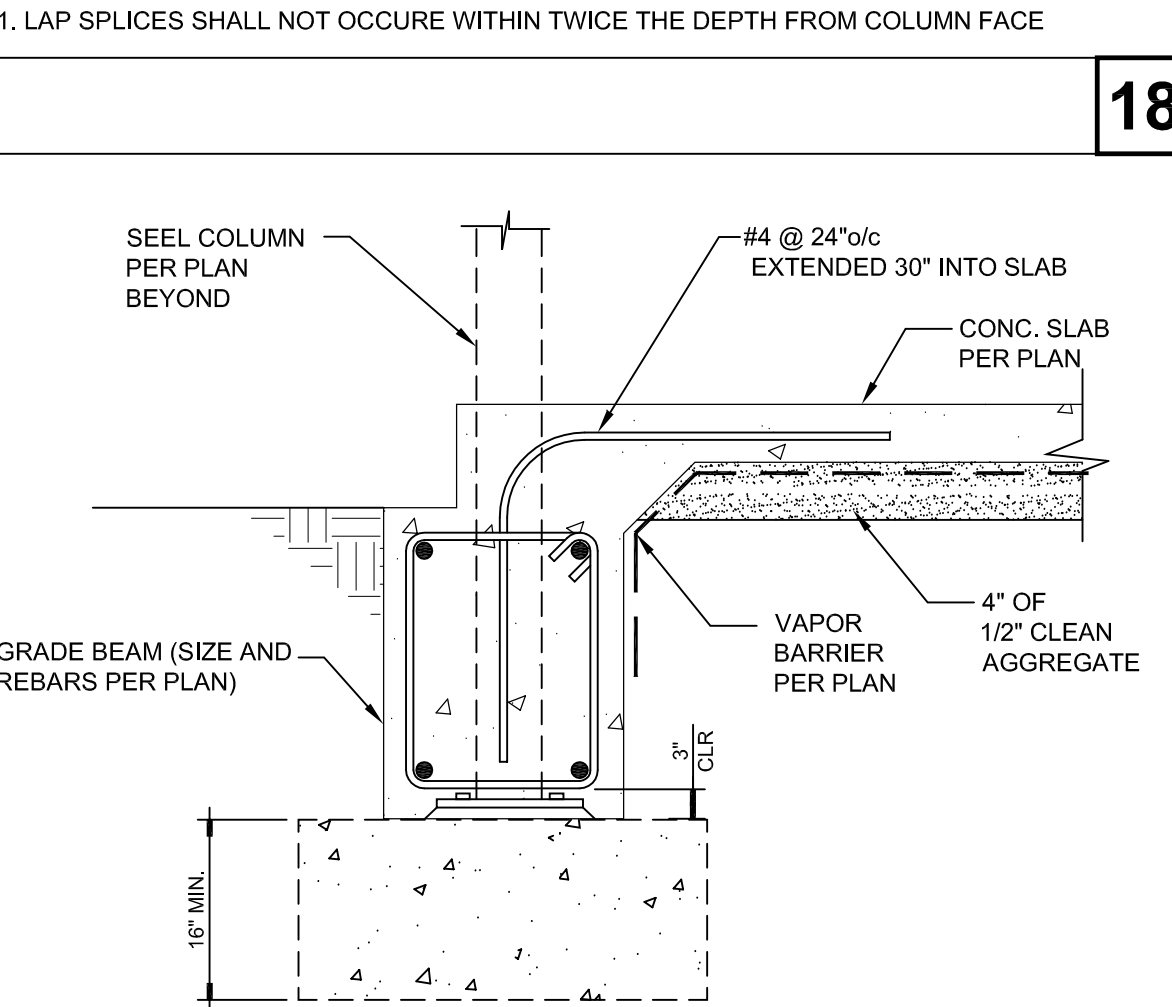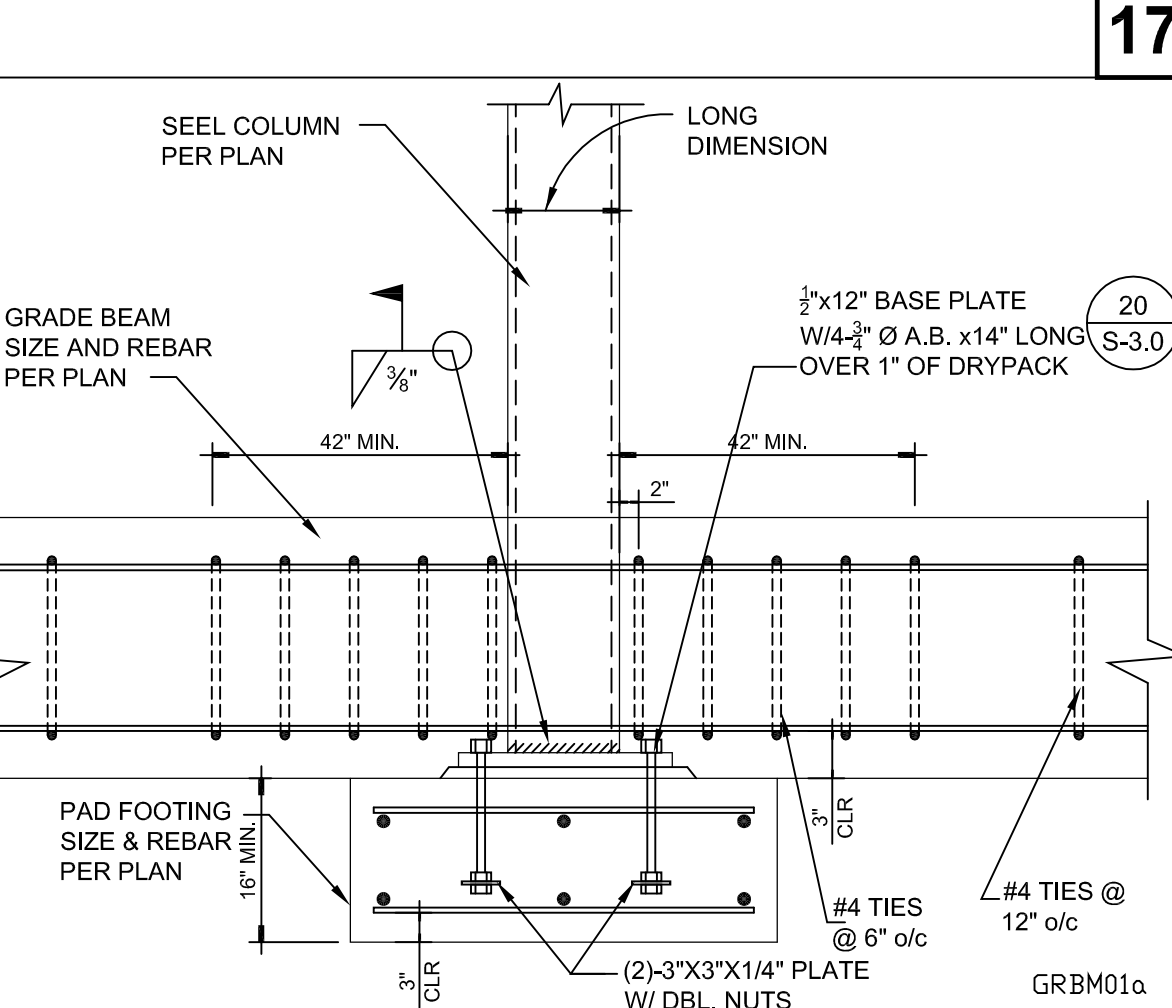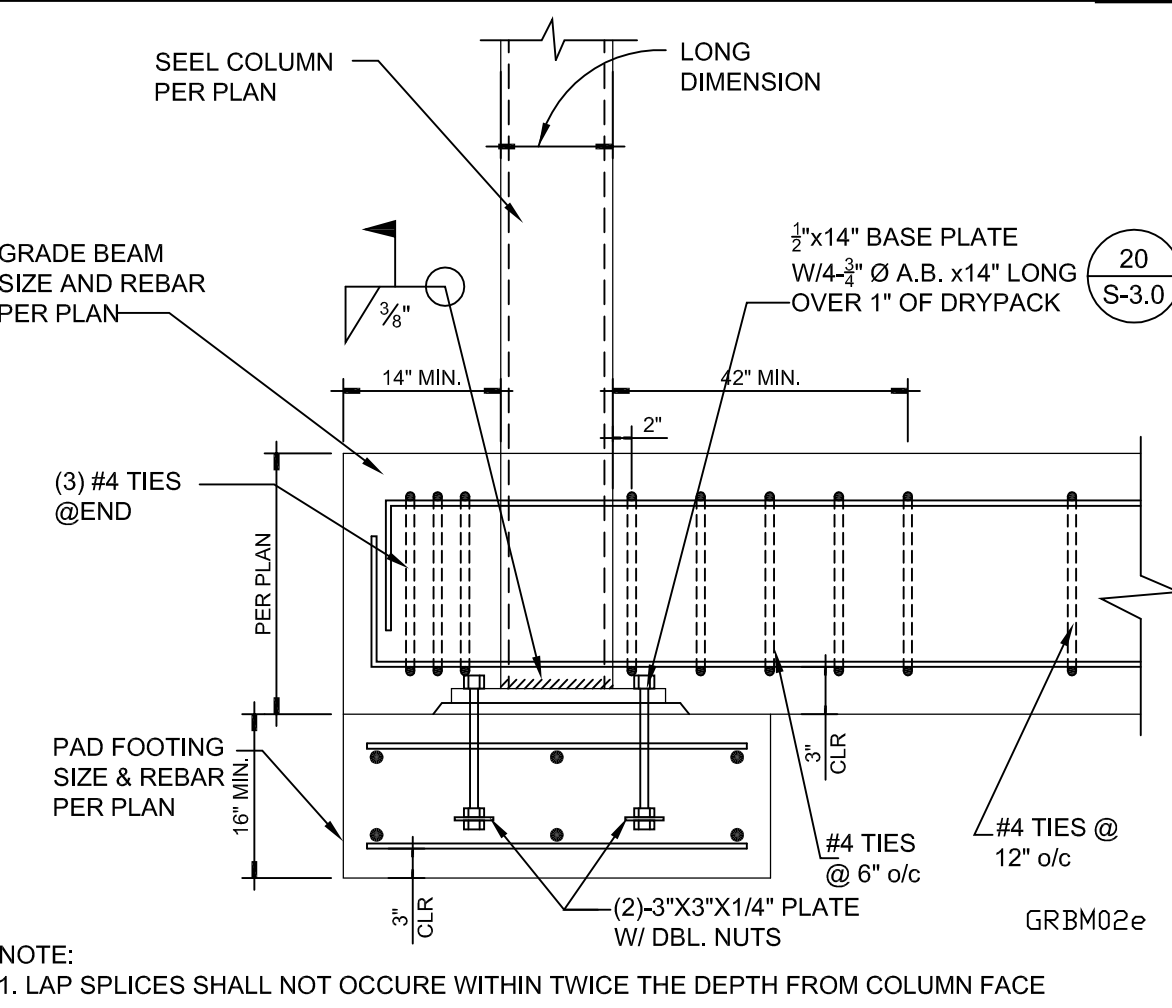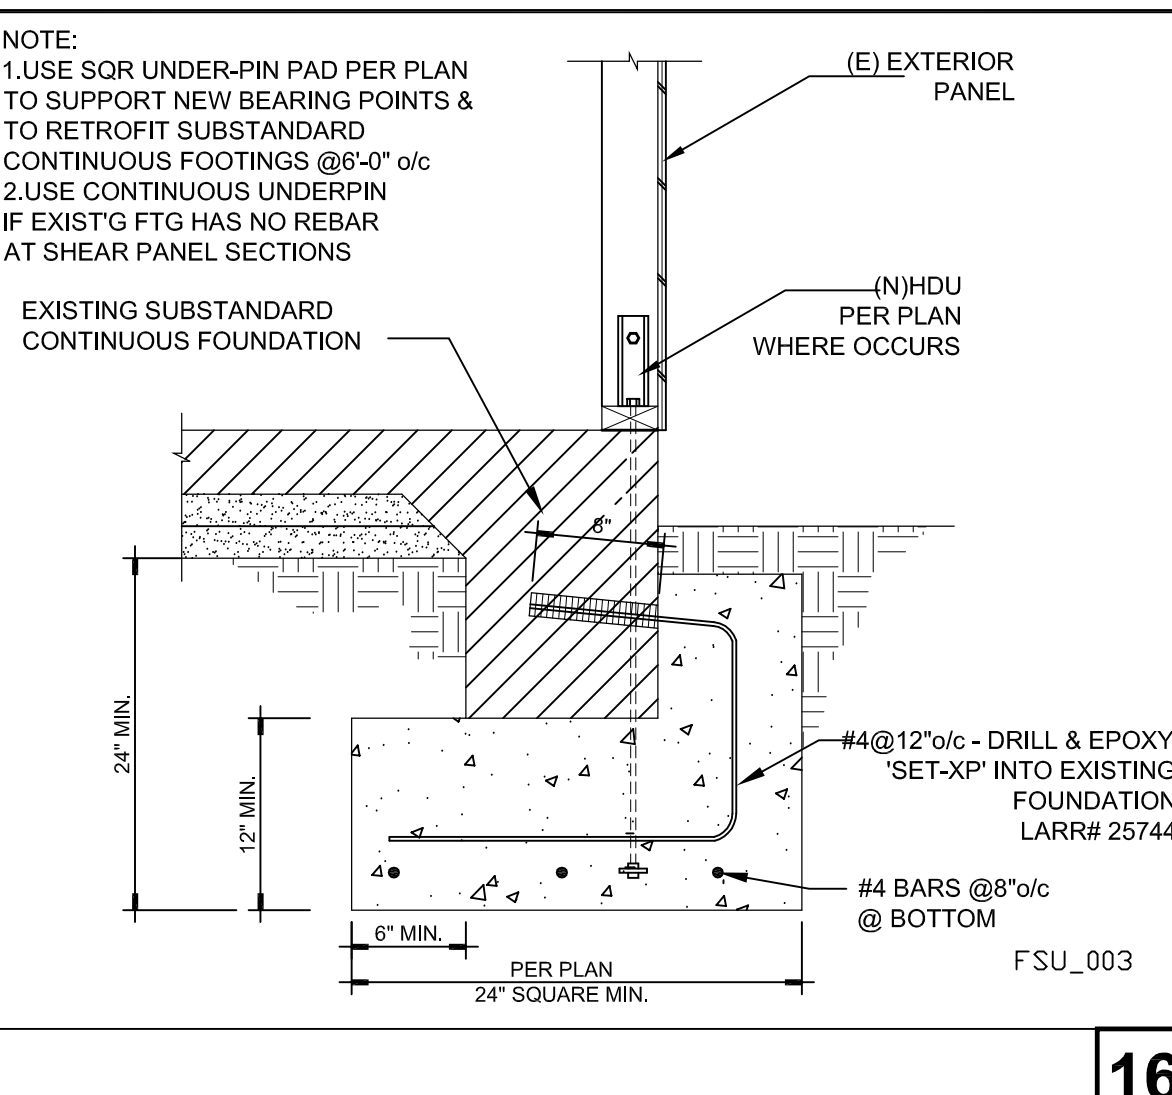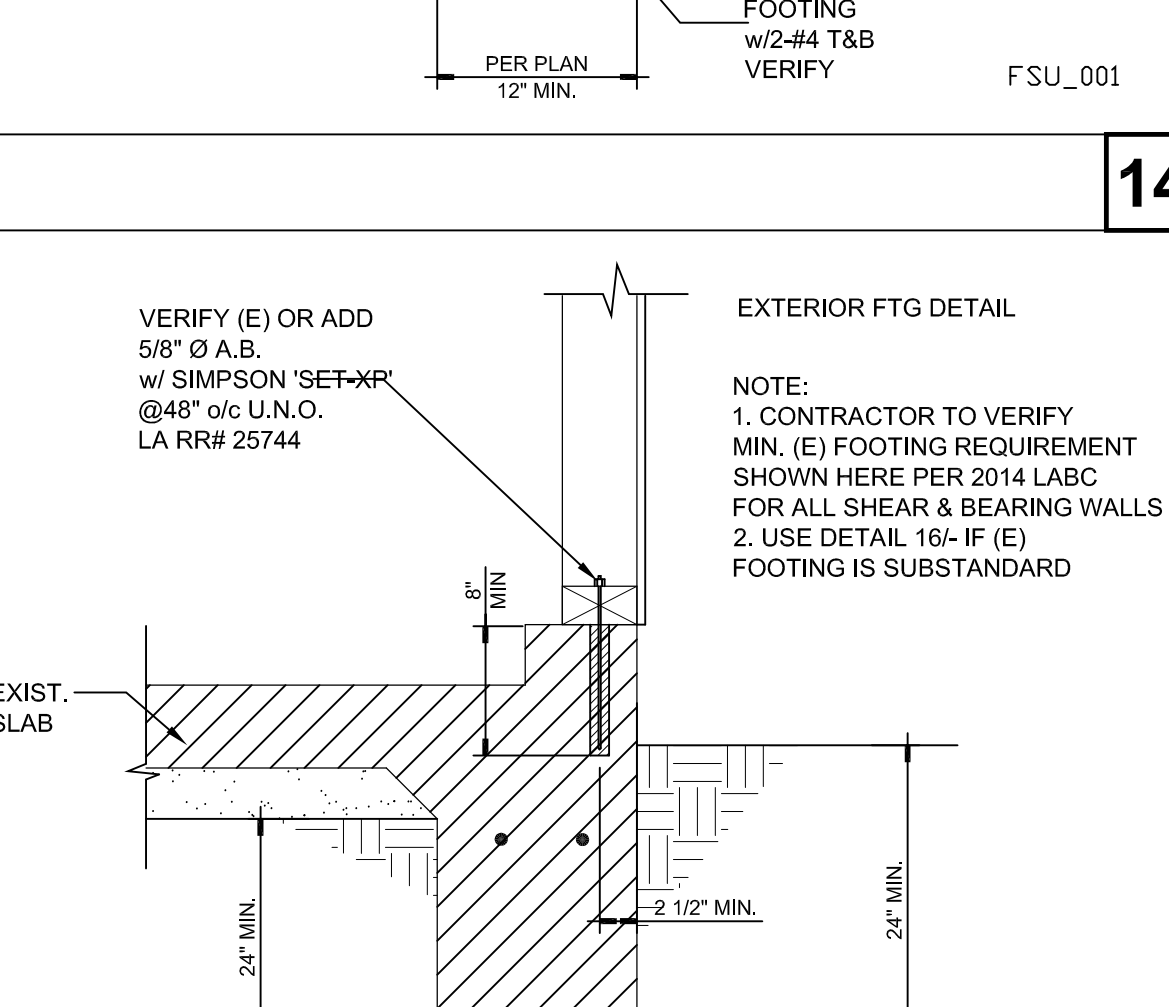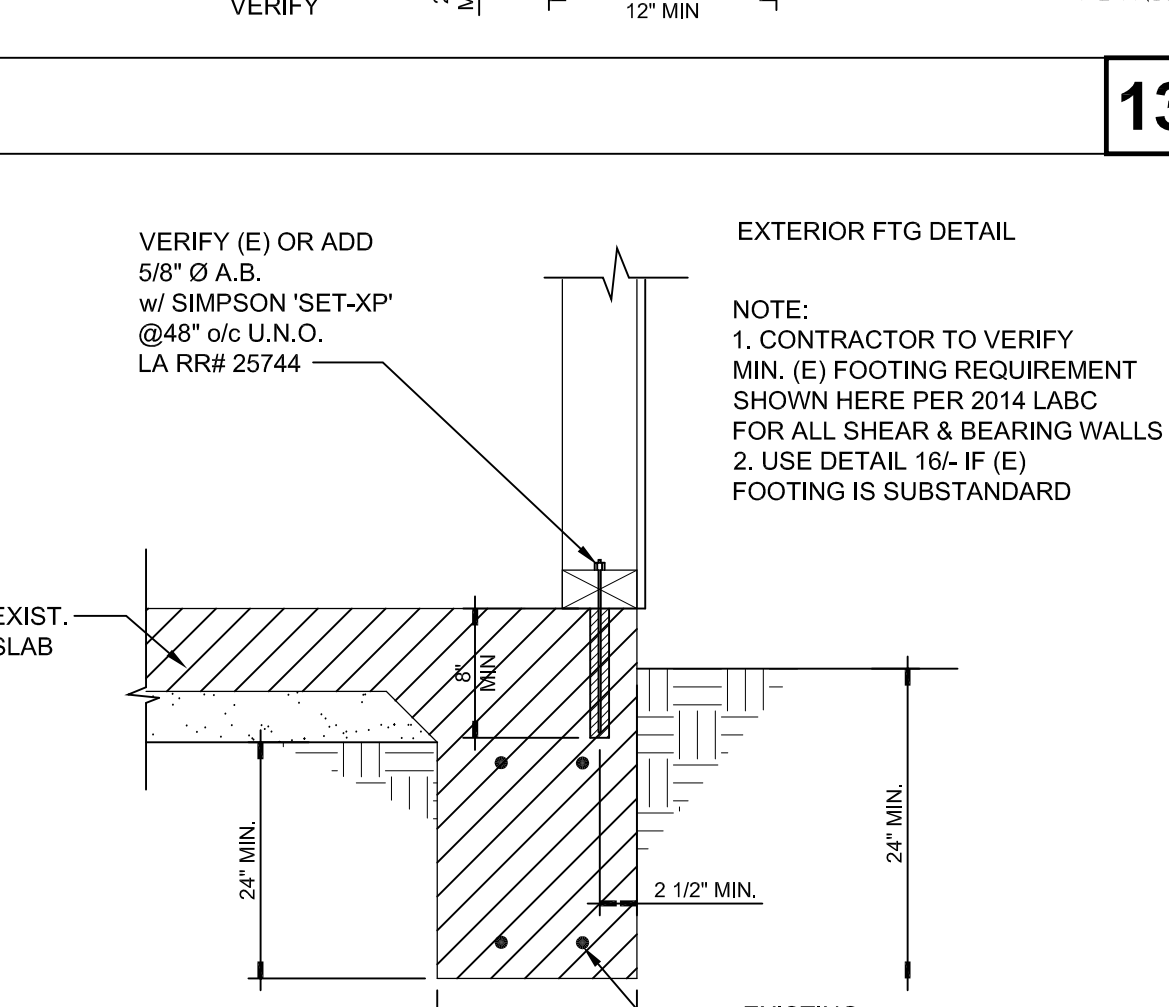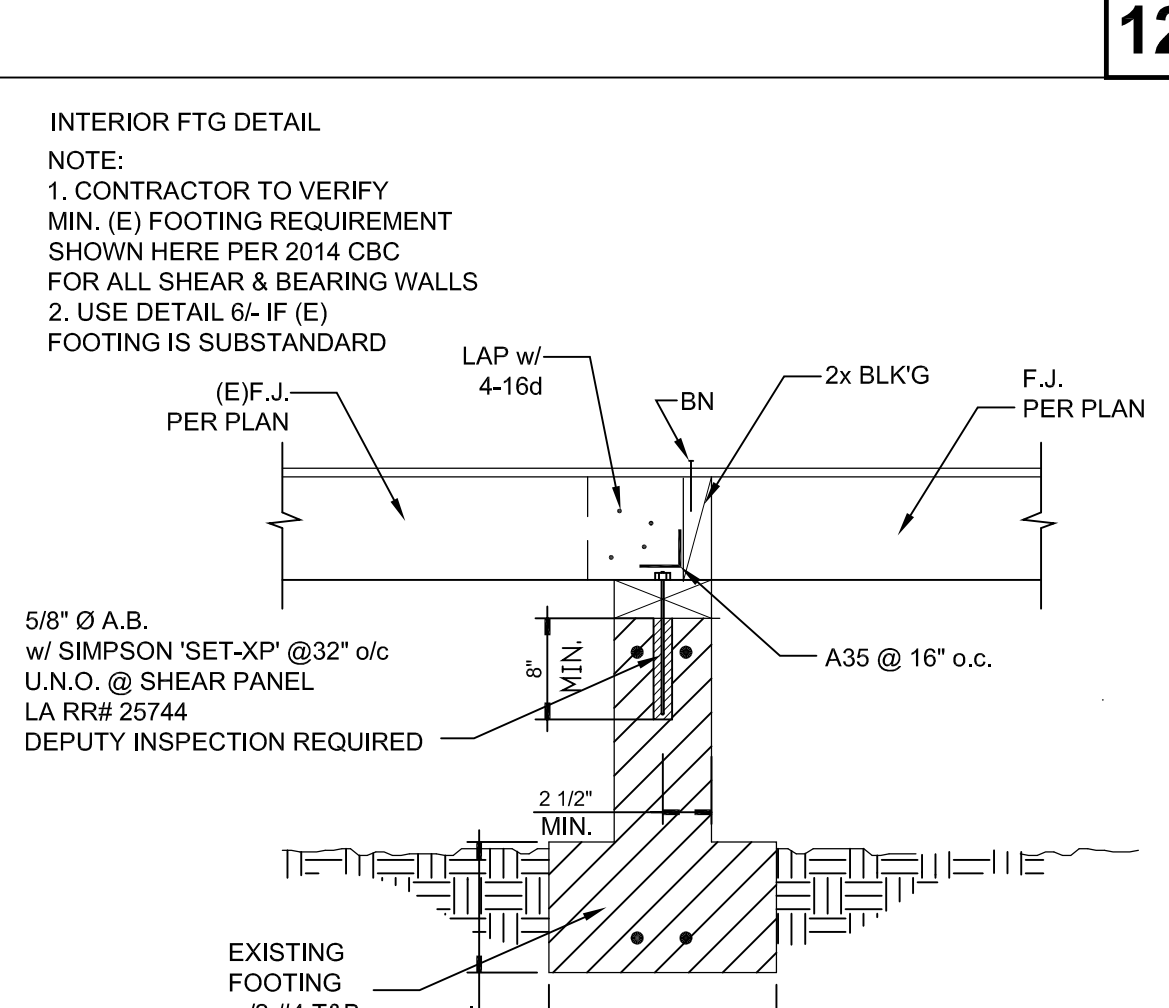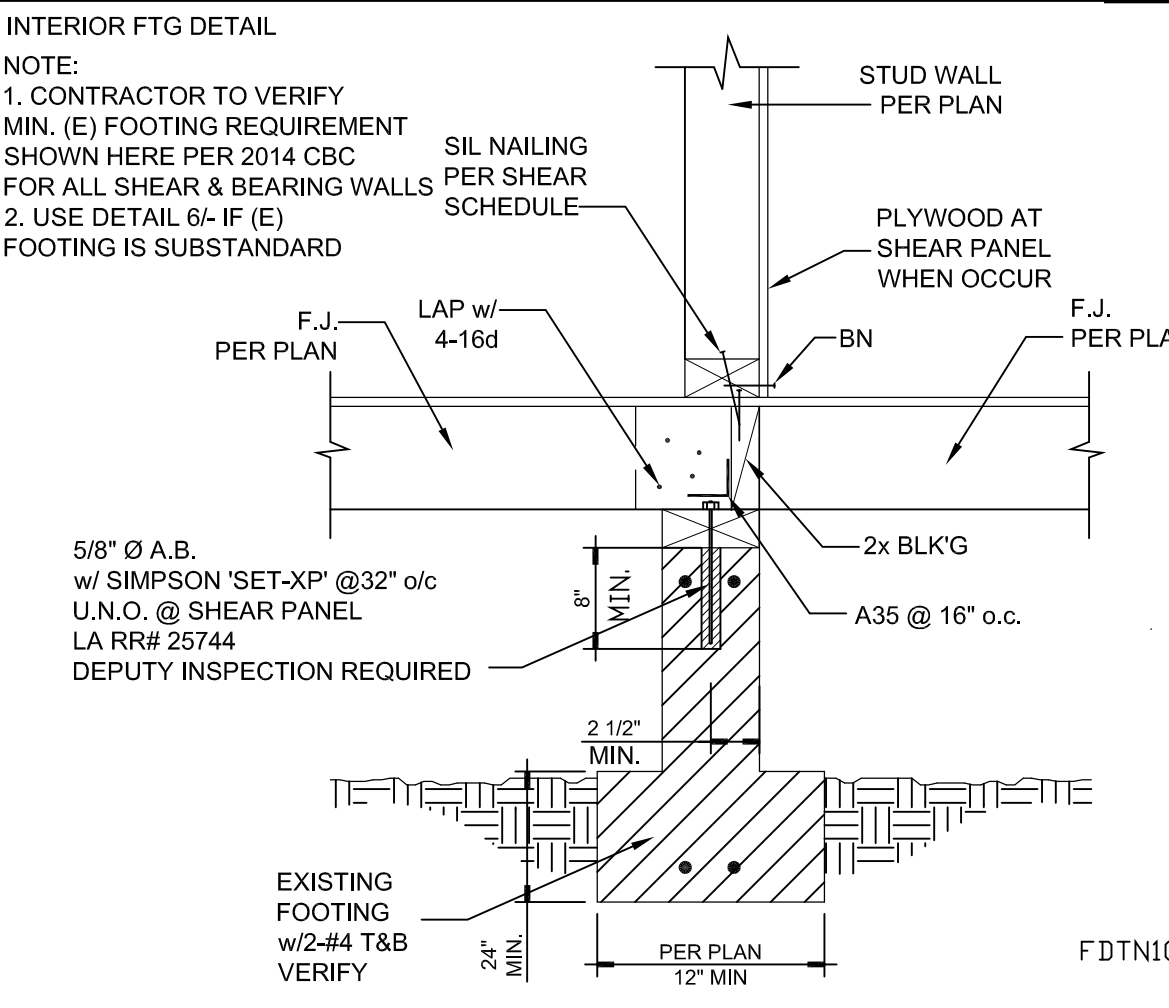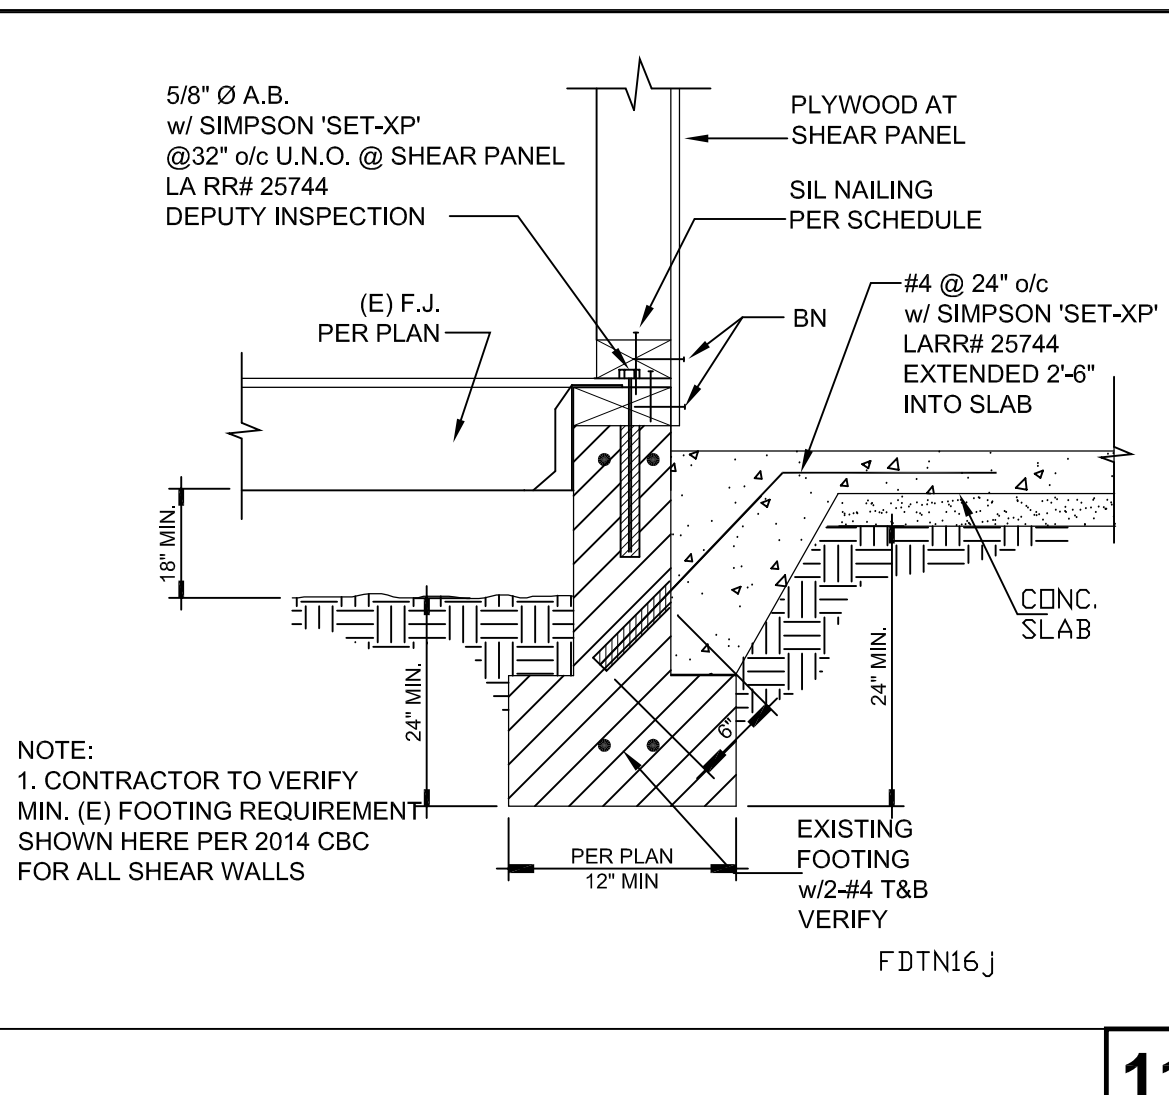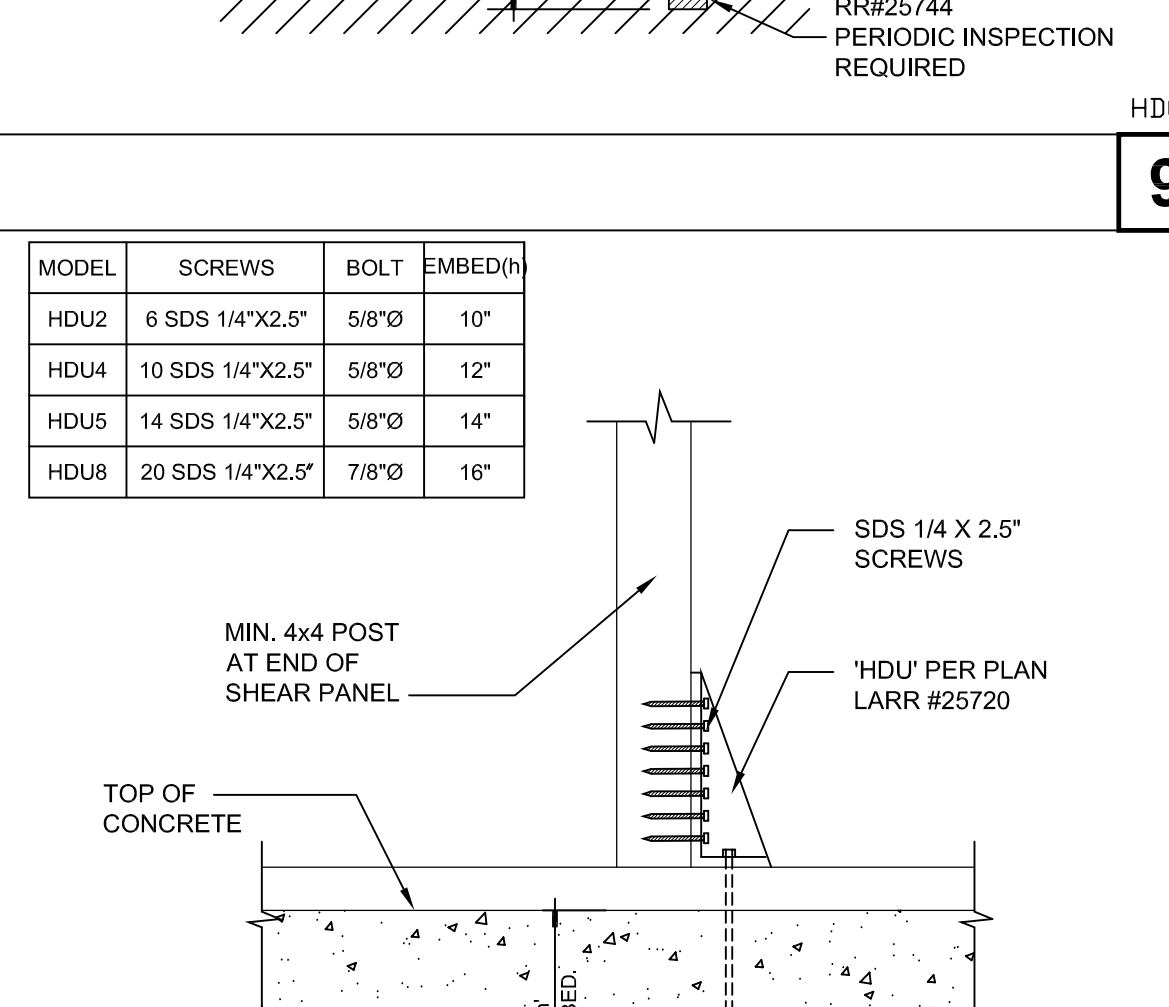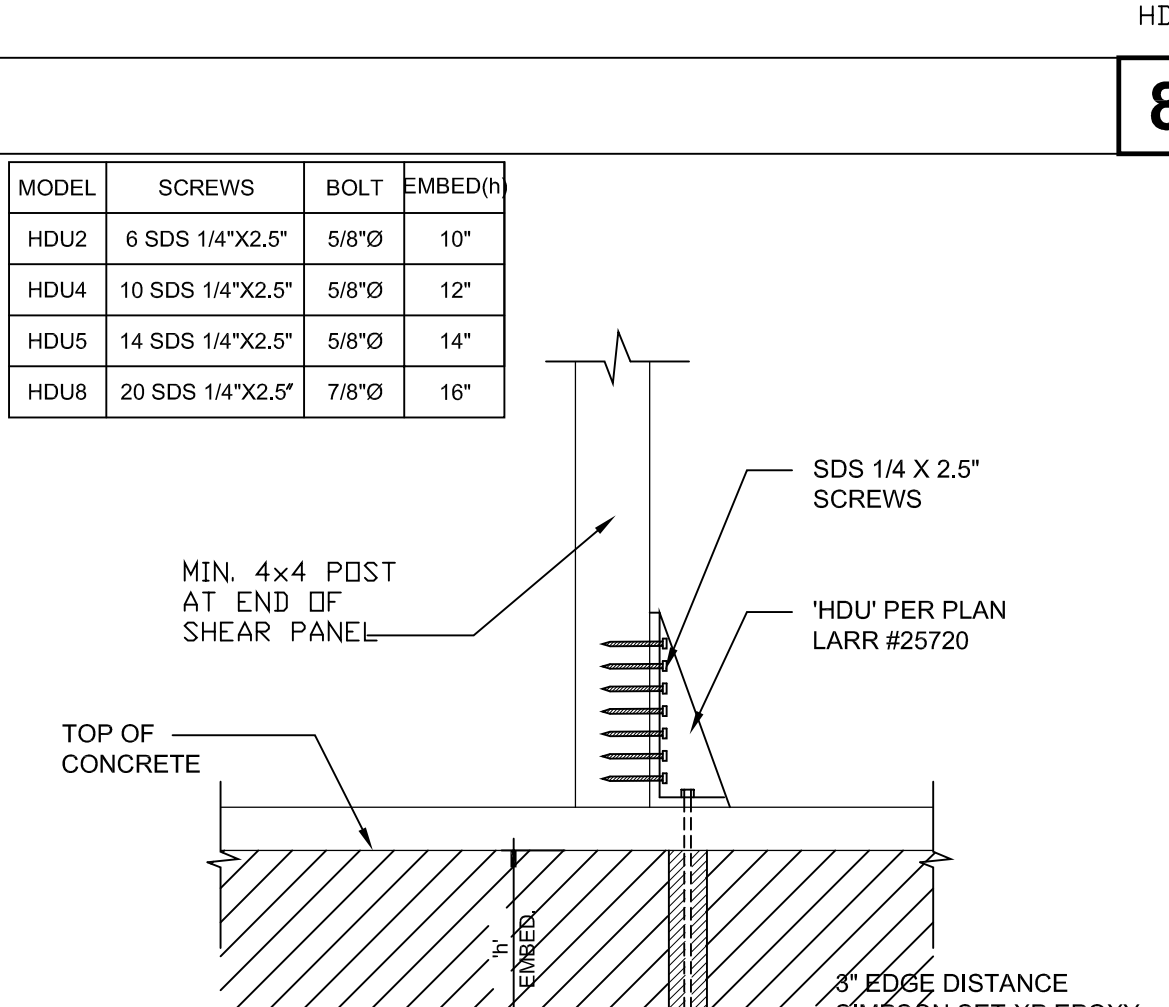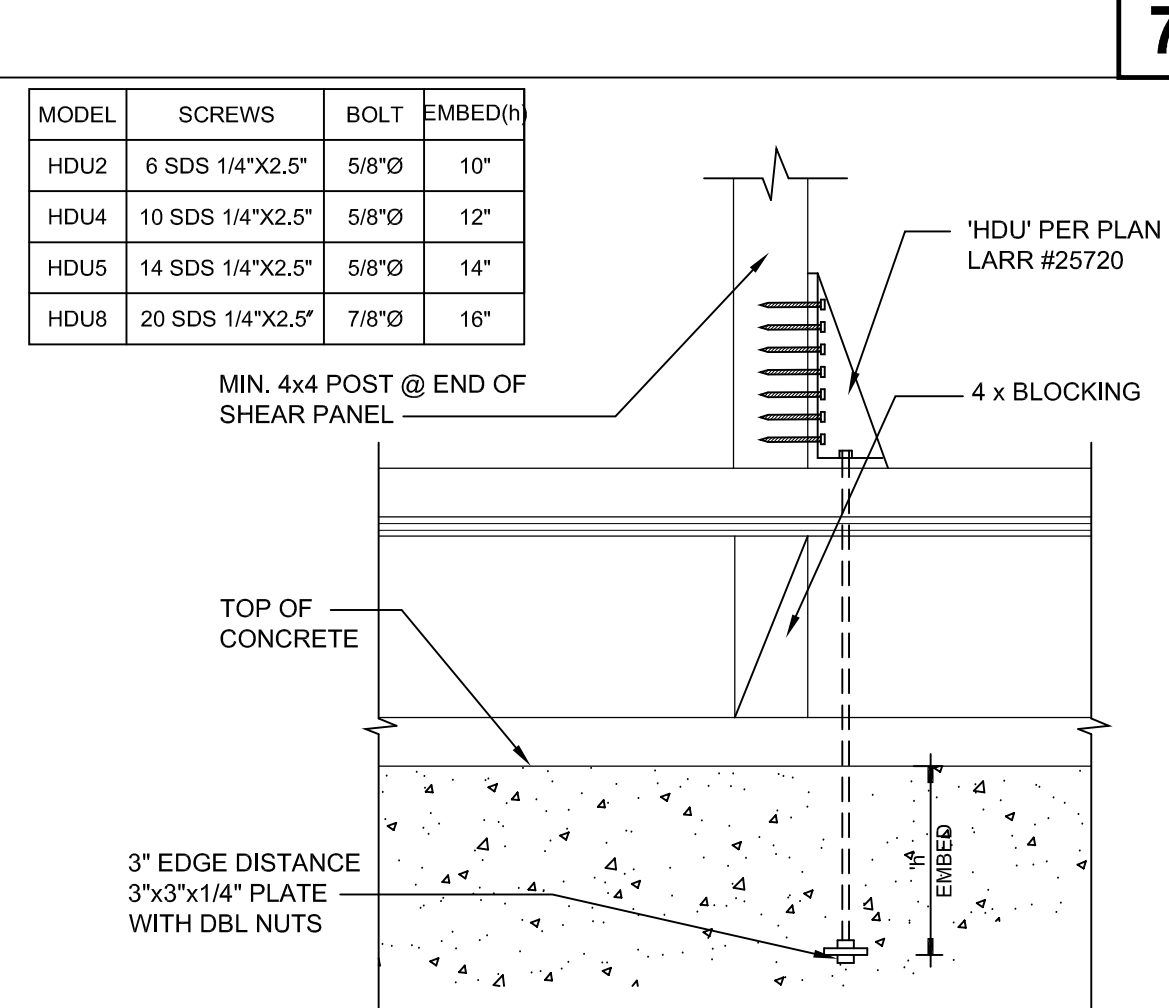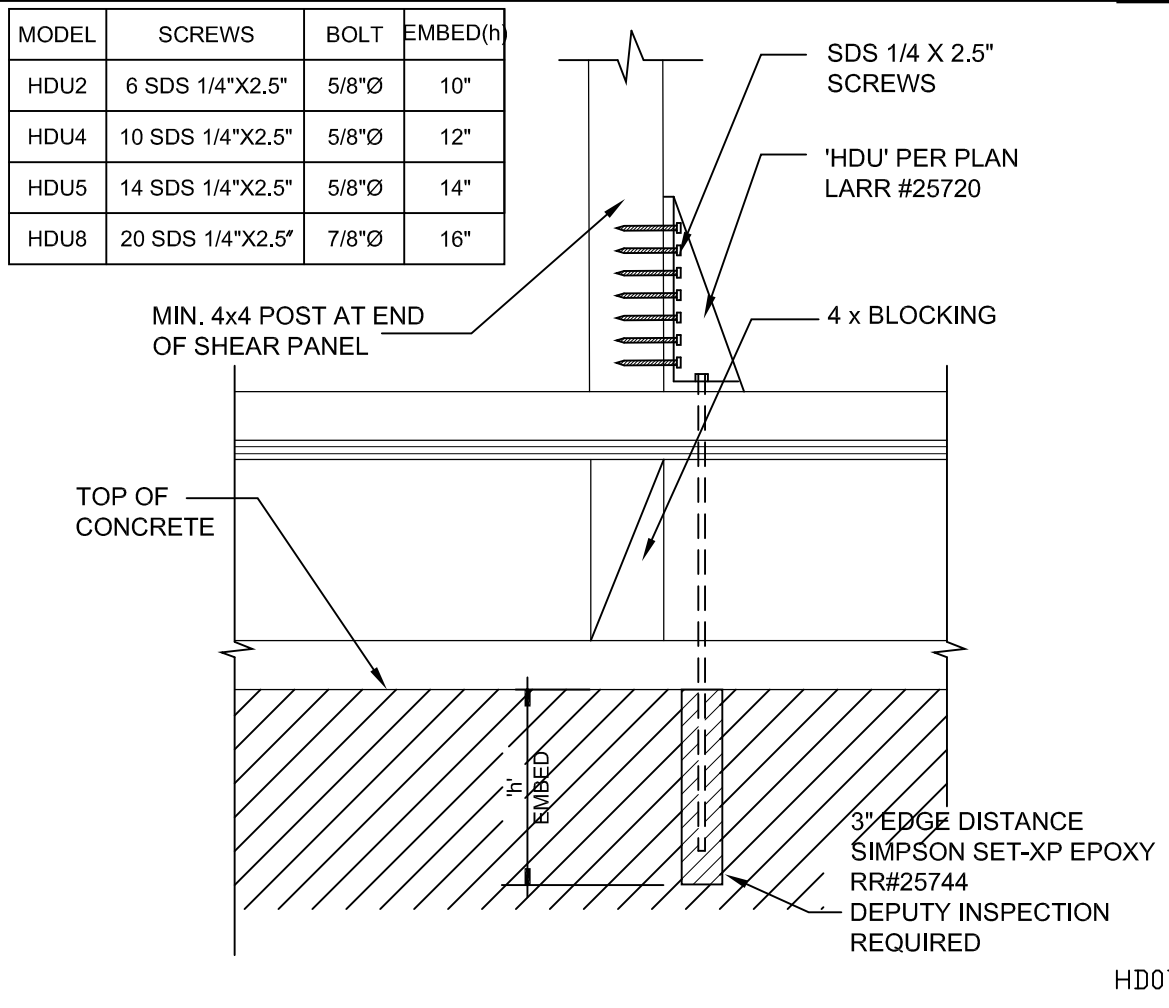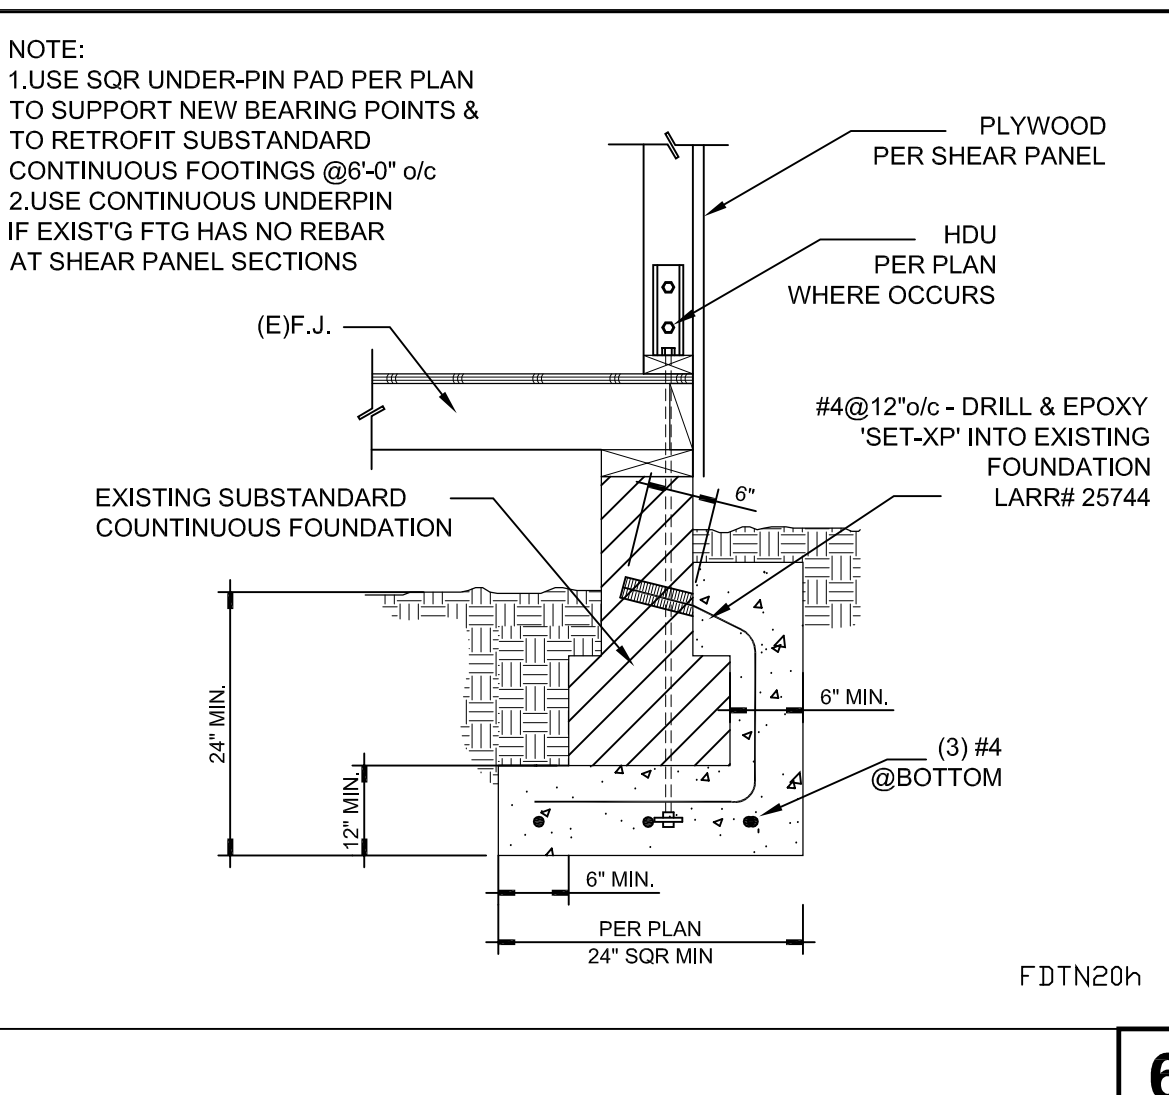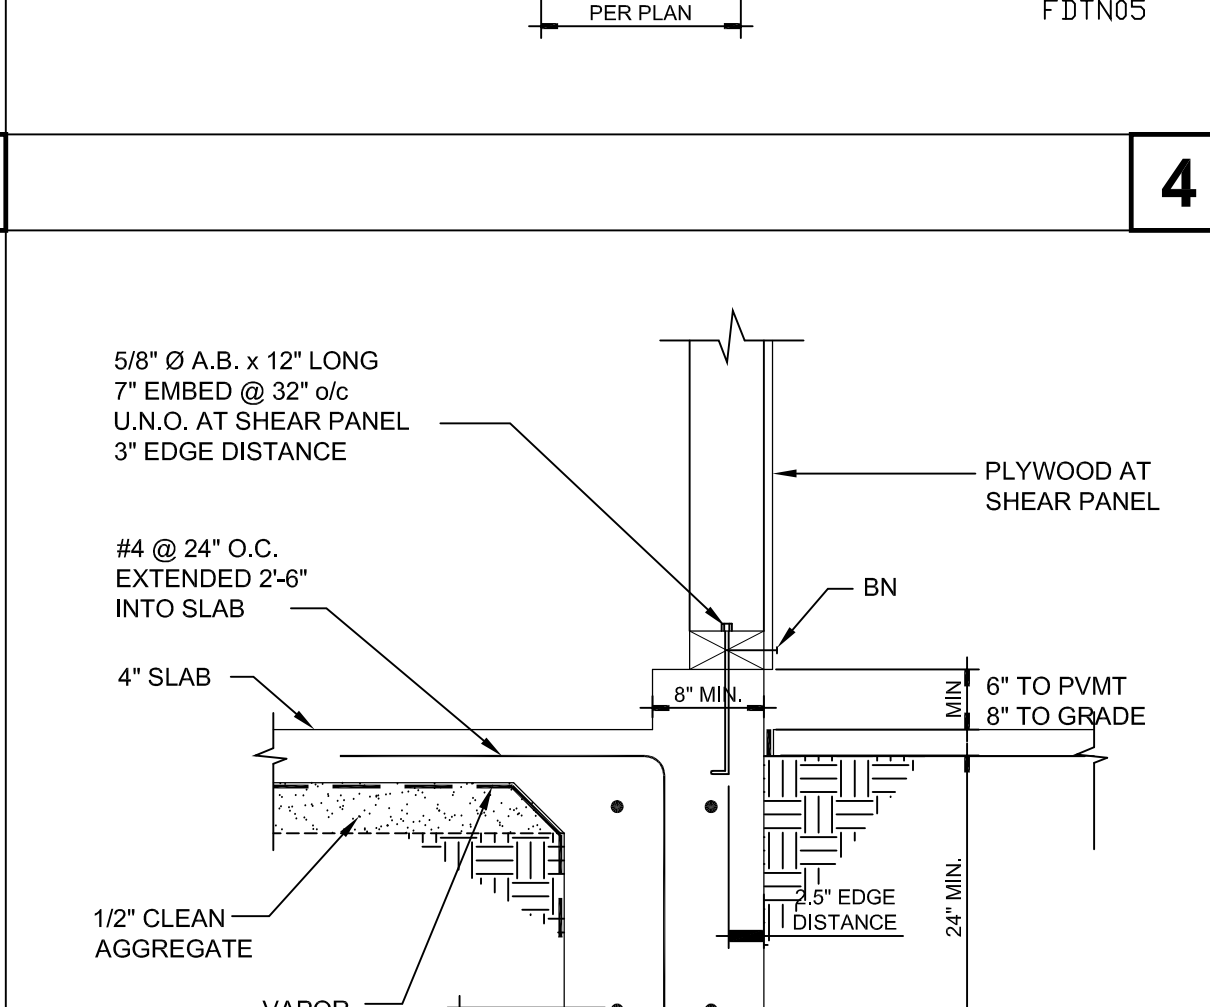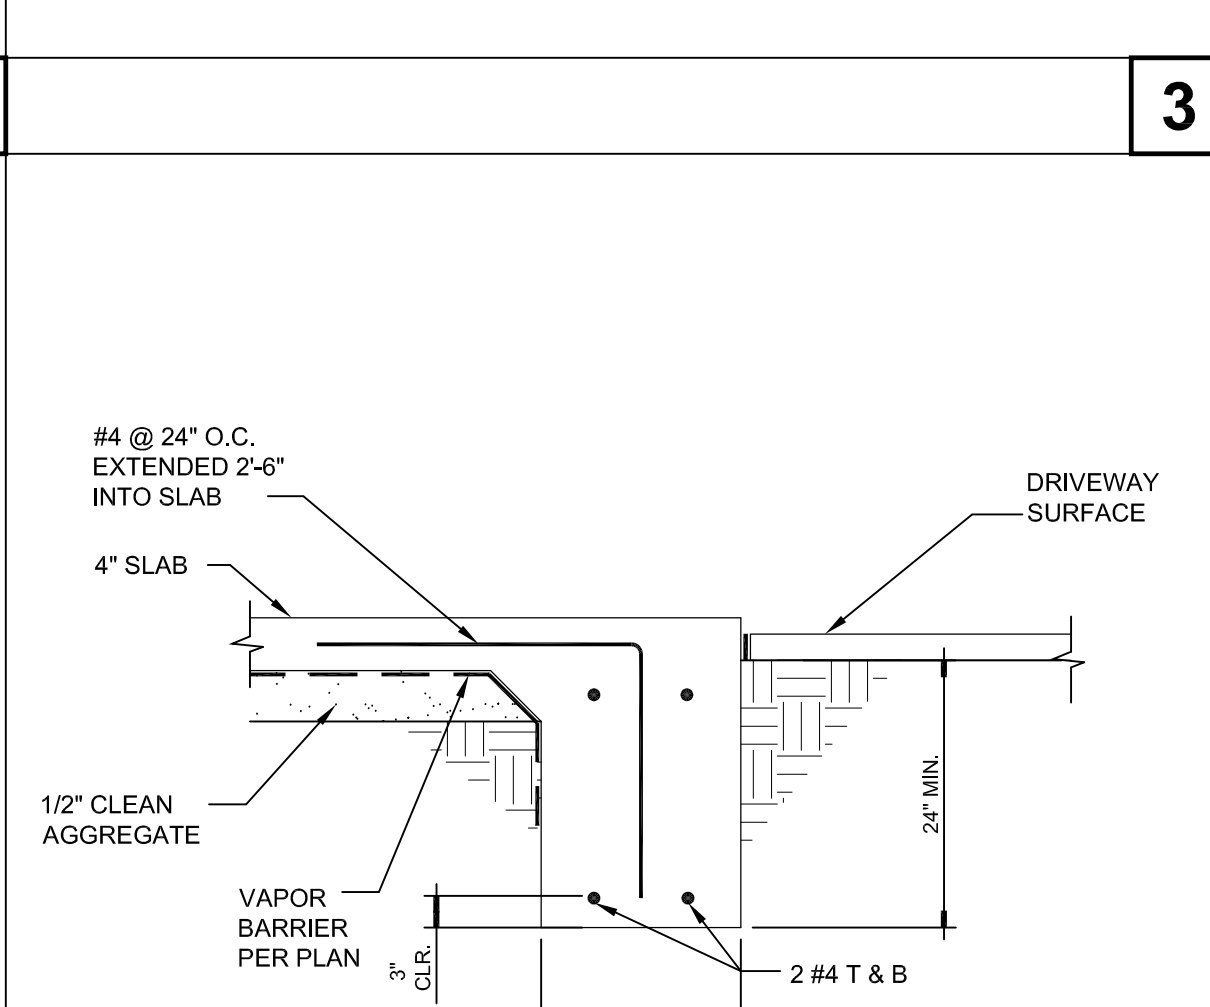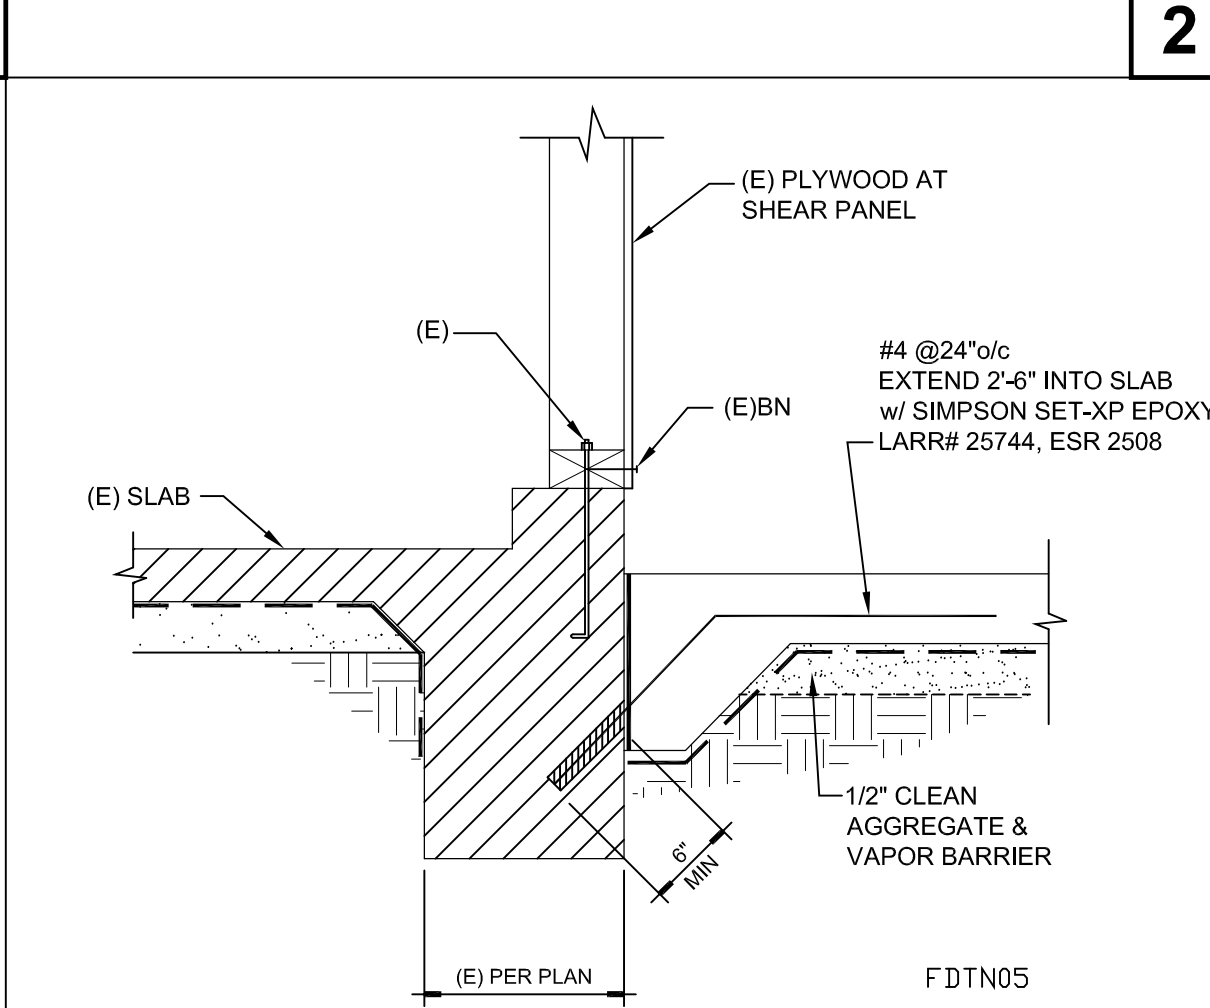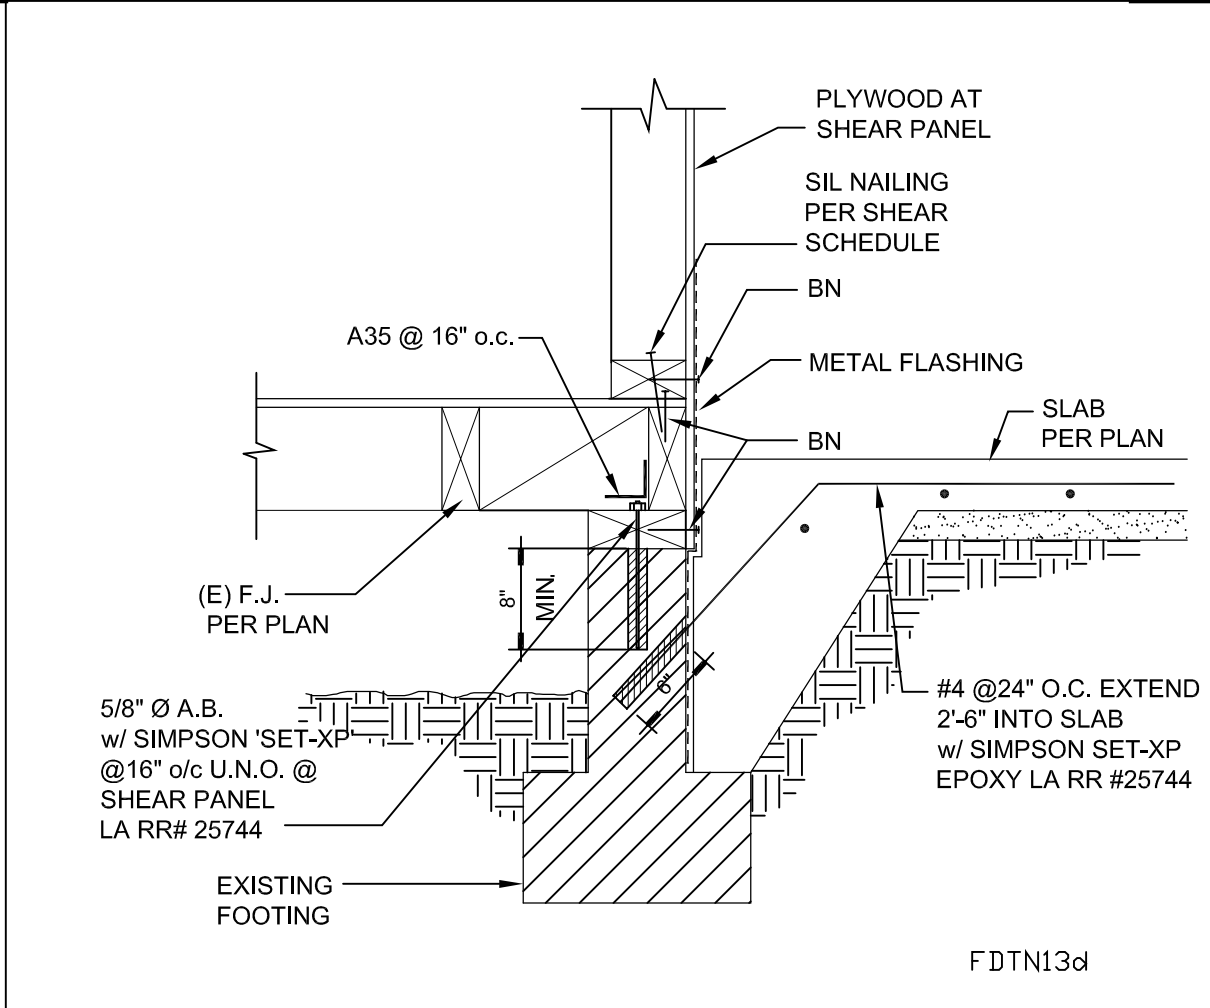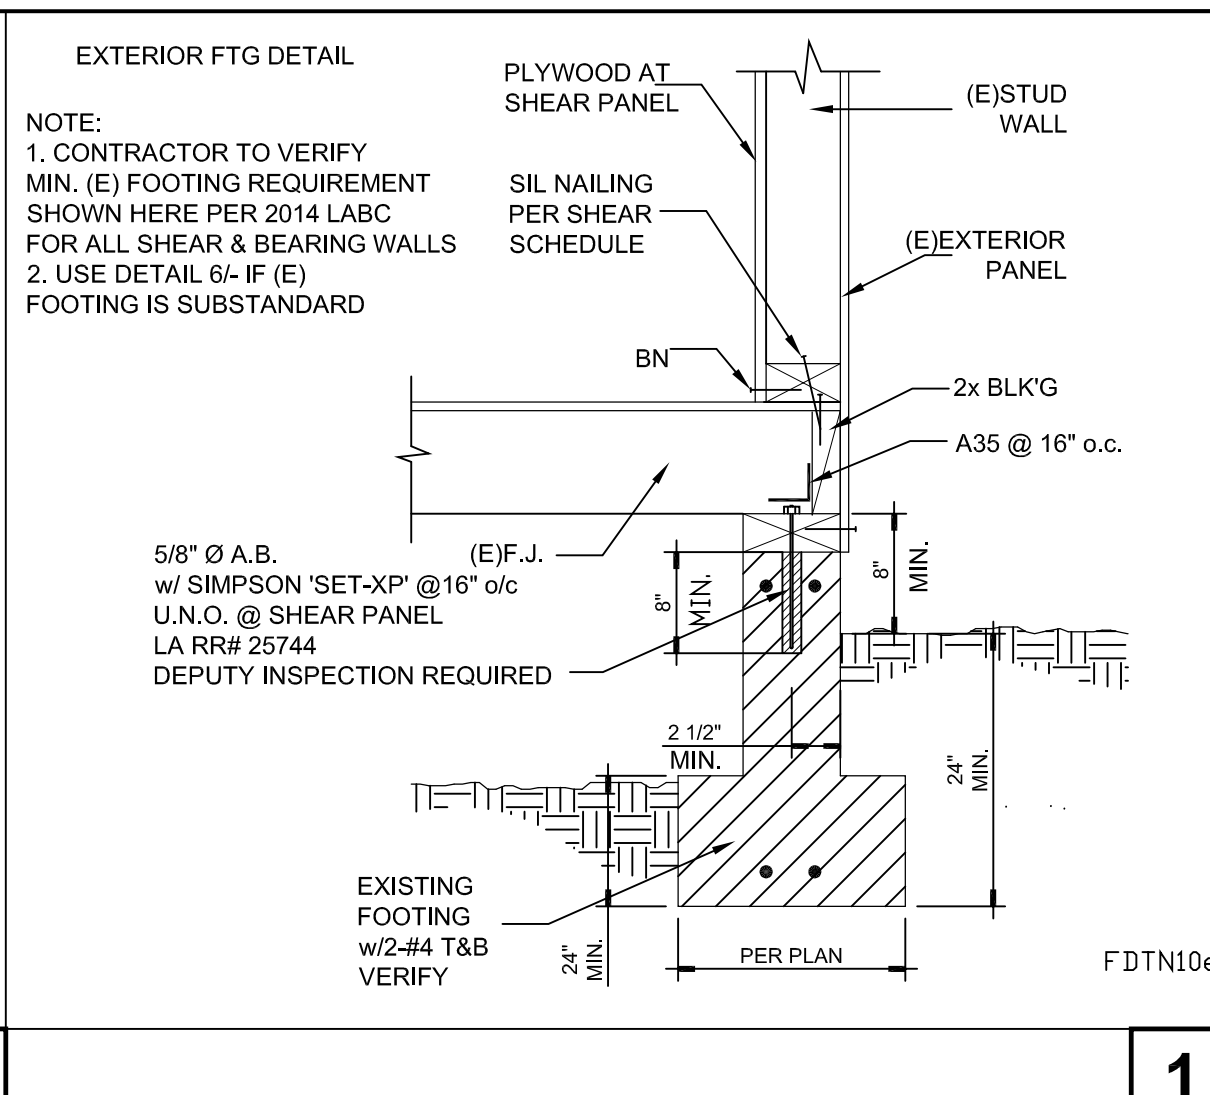


TYPICAL CONNECTION TO EXIST'G FTG

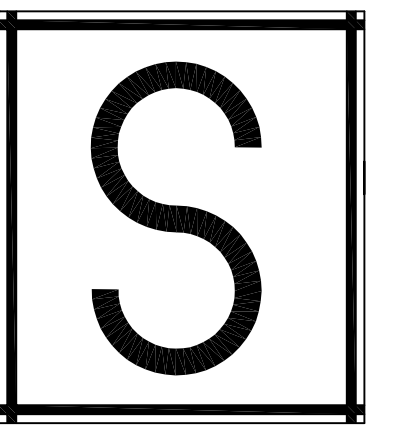

**SAYAH**  
ENGINEERING INC  
Structural - Civil - Design

TEL 818 . 788 . 7887  
15233 Ventura Blvd., Suite 1130  
Sherman Oaks, Ca. 91403-2201  
FAX 818 . 788 . 7827

Without limitation on these drawings, the contractor shall verify and be responsible for all dimensions and conditions on the job and his office must be notified of any variation from the dimensions and conditions shown by these drawings. These drawings, specifications and notes, details and arrangements represented hereby are and shall remain the property of SAYAH ENGINEERING and no part thereof shall be copied, disclosed to others or used in connection with any work or project other than the specific project for which they have been prepared and developed without the written consent of SAYAH ENGINEERING. Visual contact with these drawings or specifications shall constitute conclusive evidence of acceptance of these provisions.

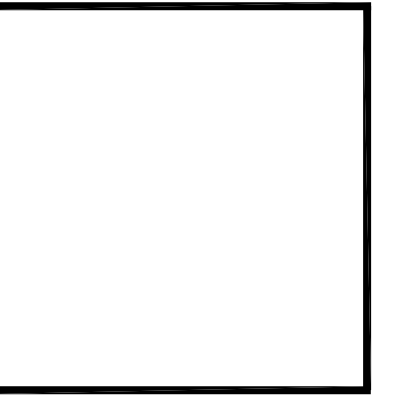


**Candamil Residence**  
1-story addition & remodel  
Candamil Residence  
9700 Portada Drive  
Whittier, Ca 90603

Sheet Contents:

Details

Scale: AS SHOWN

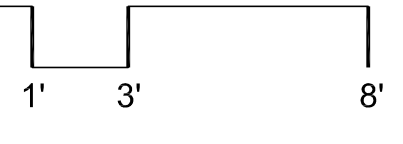


Revisions:


Date: 2017.04.05  
Project No.: S16225  
File Name: S16225\_S  
Sheet No.:

**S-3.1**


Total Sheets:

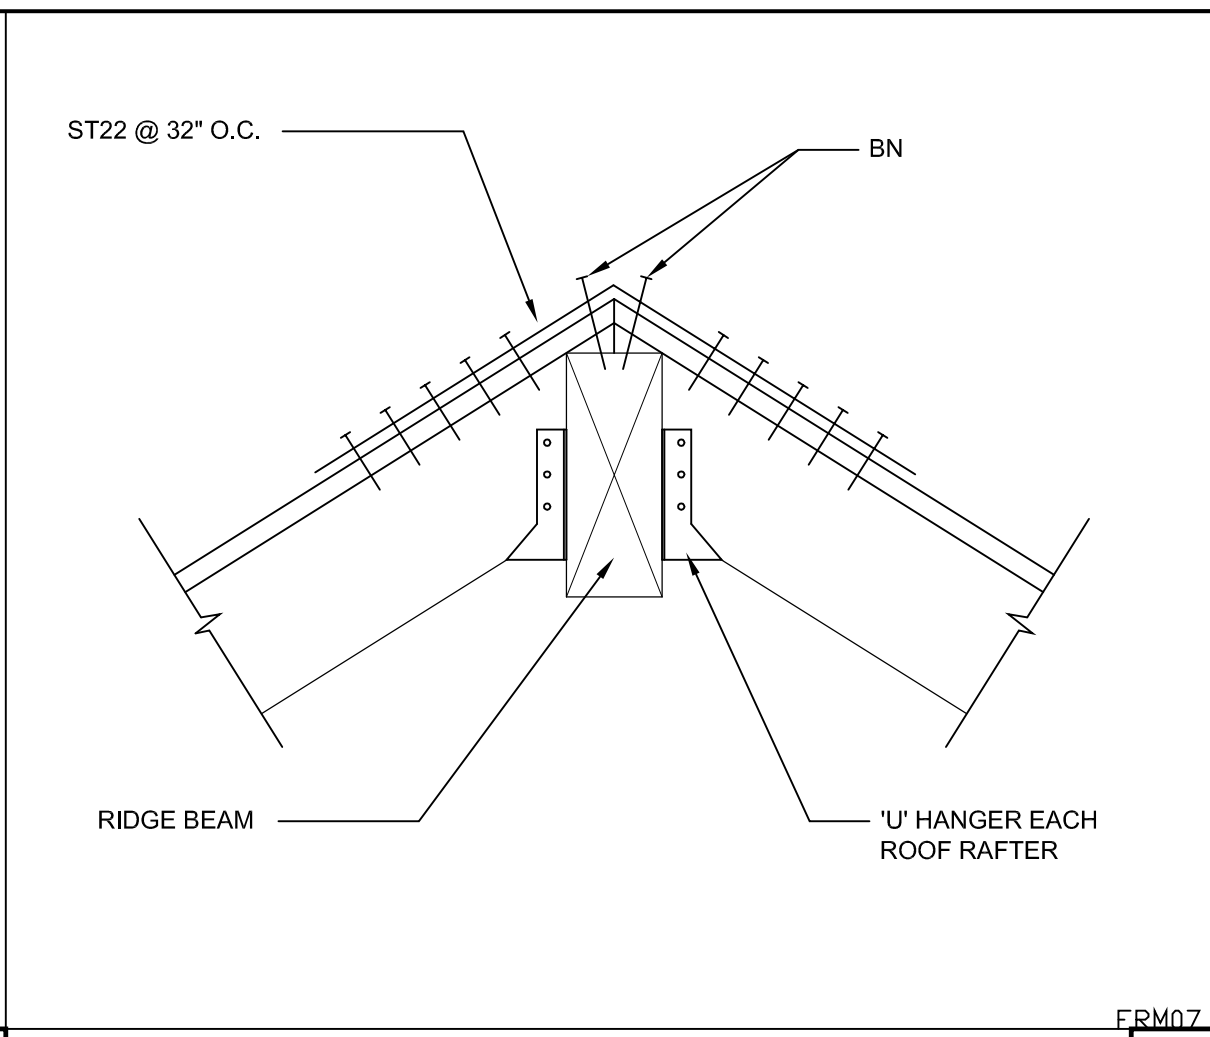


FRM07

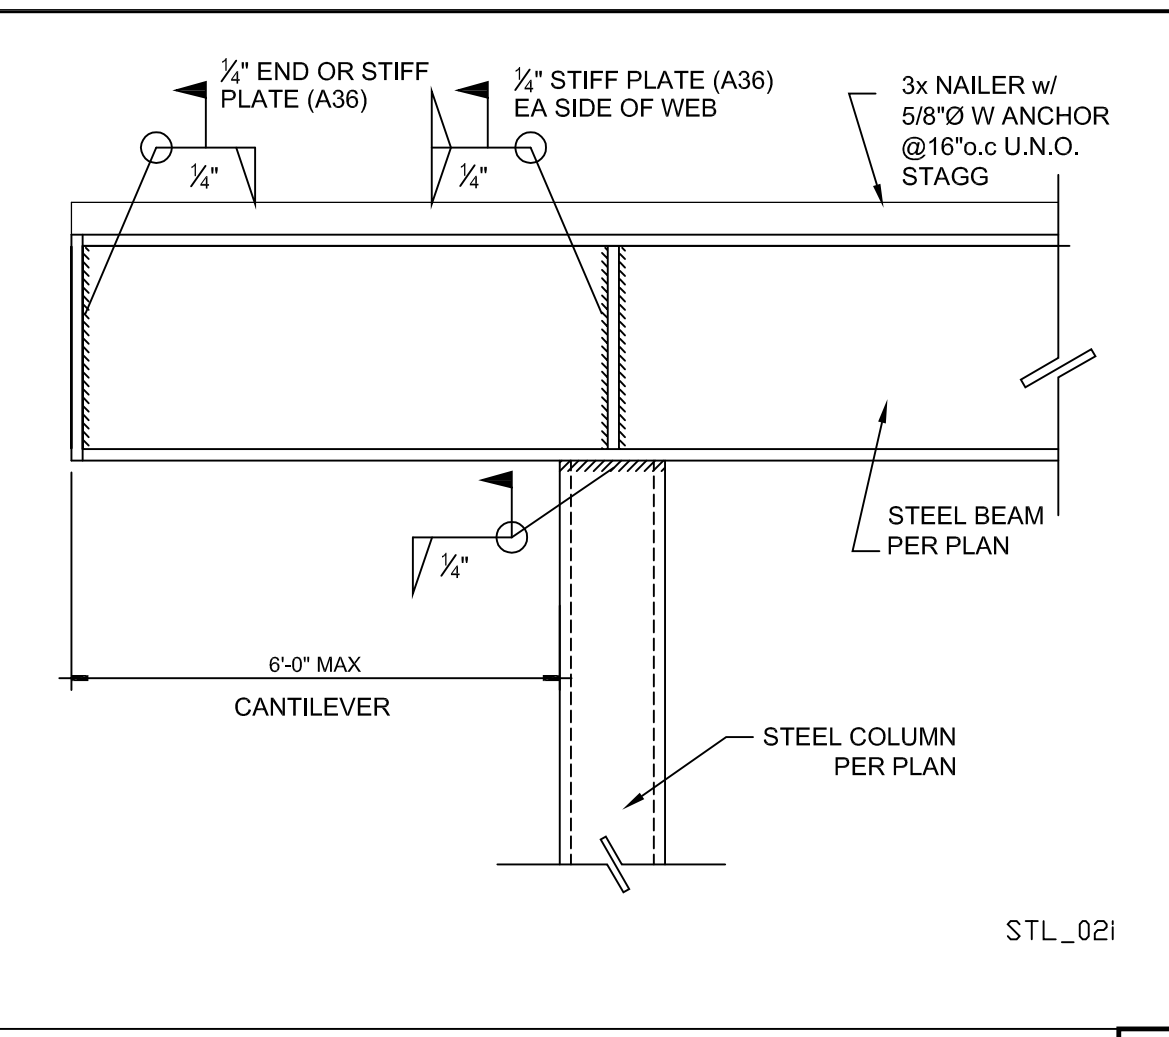


STL\_02I

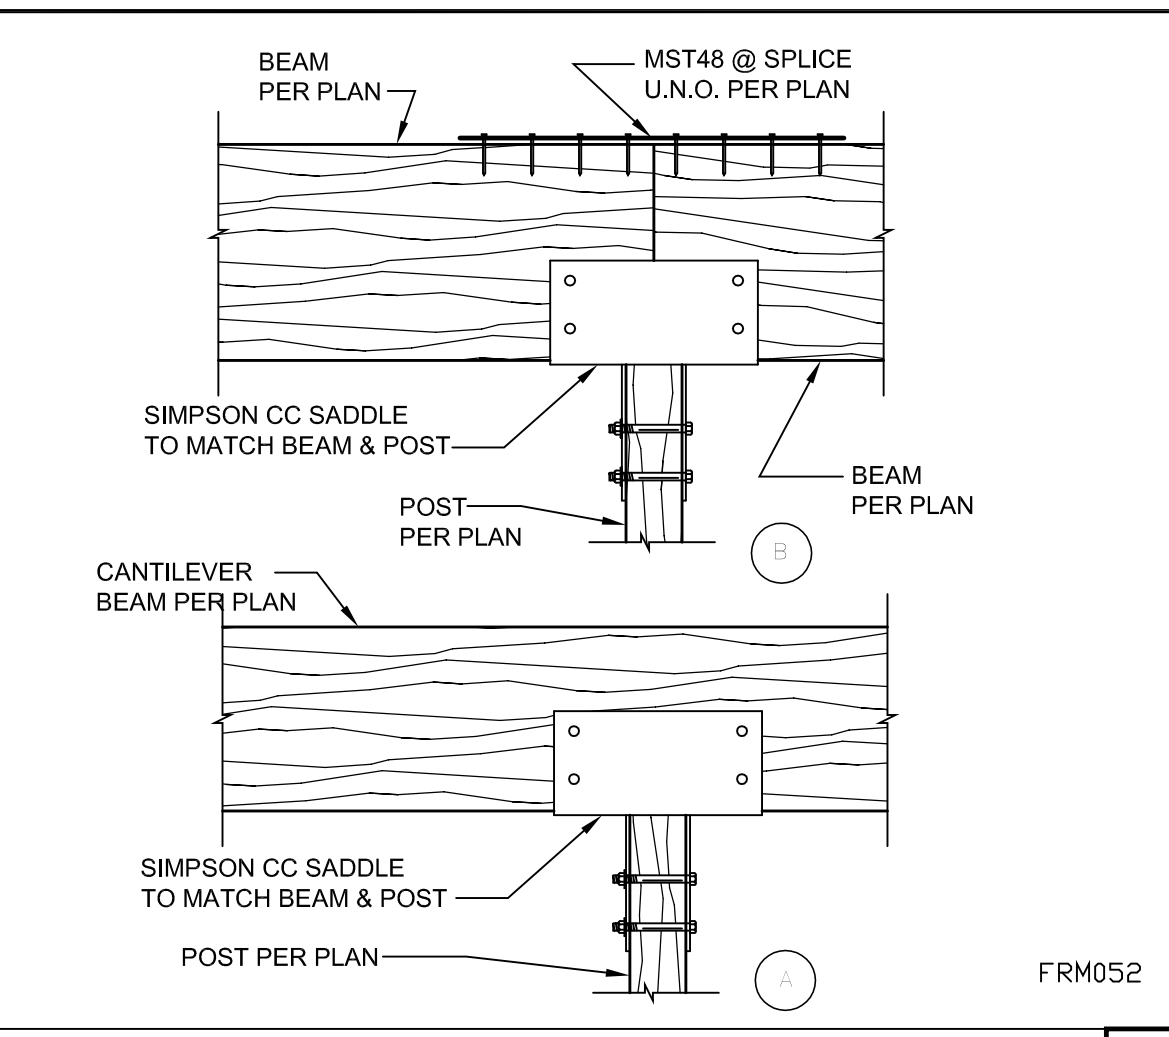


FRM052

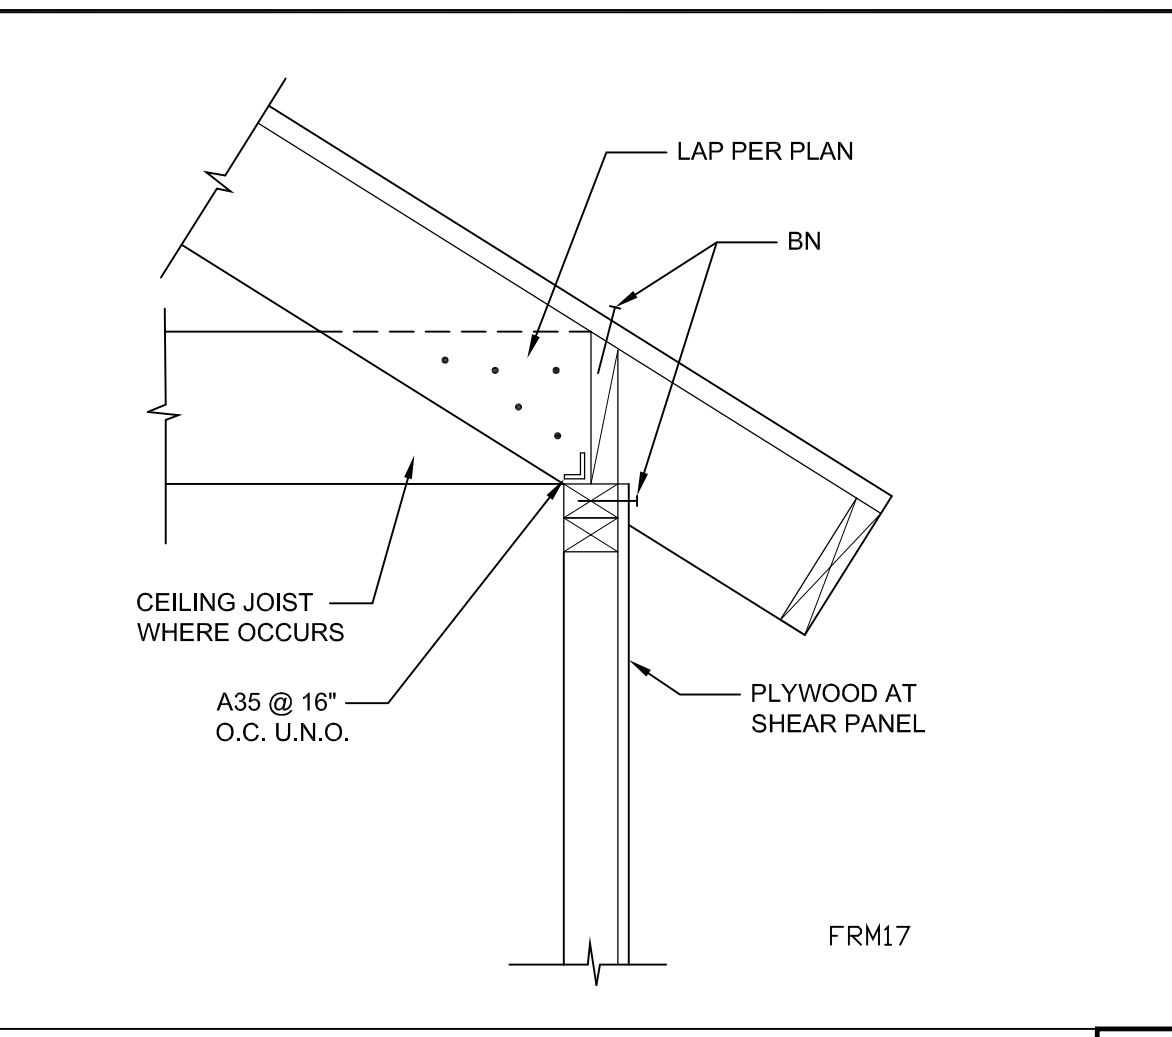


FRM17

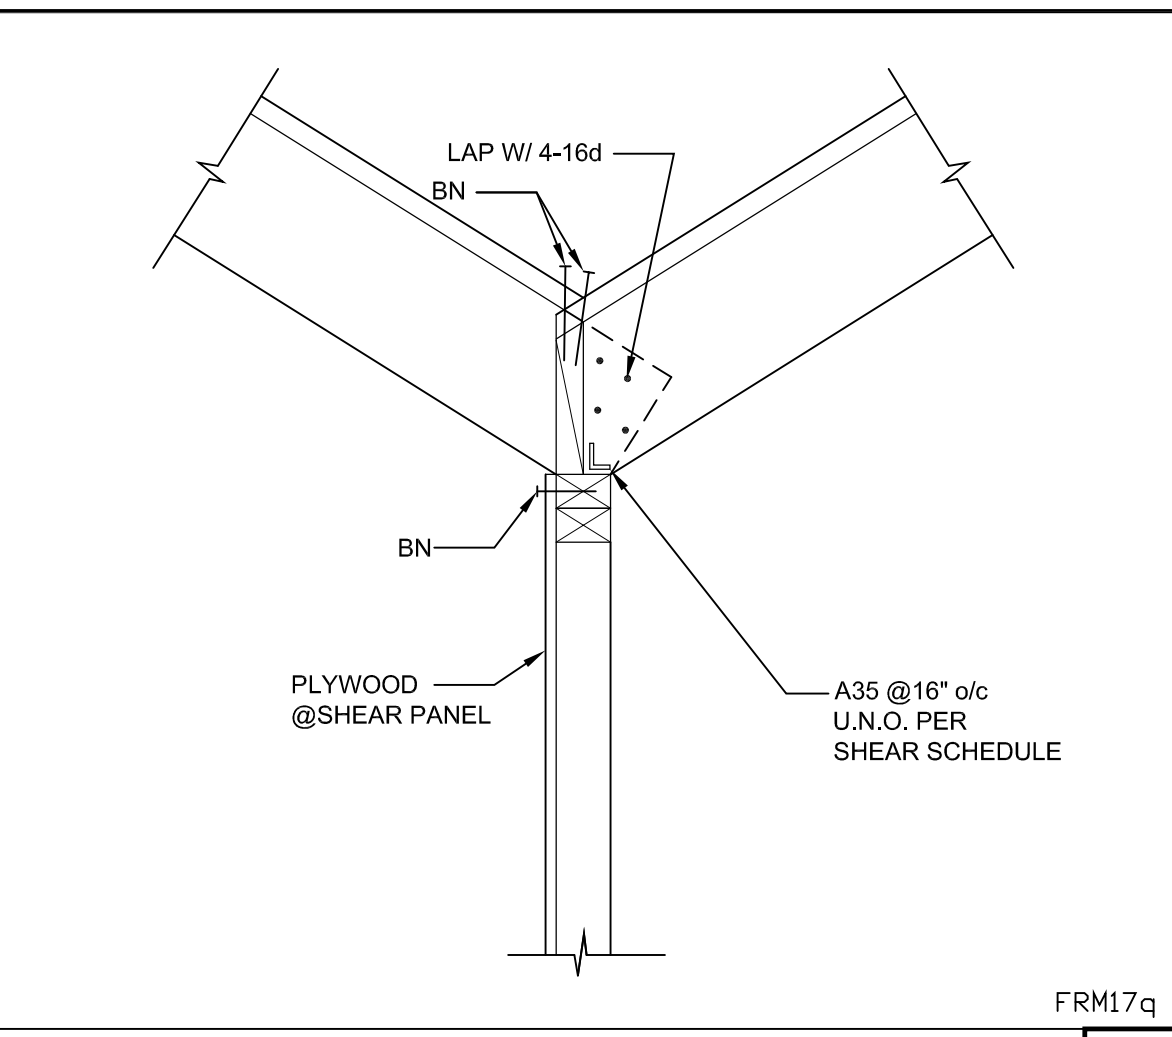


FRM17q

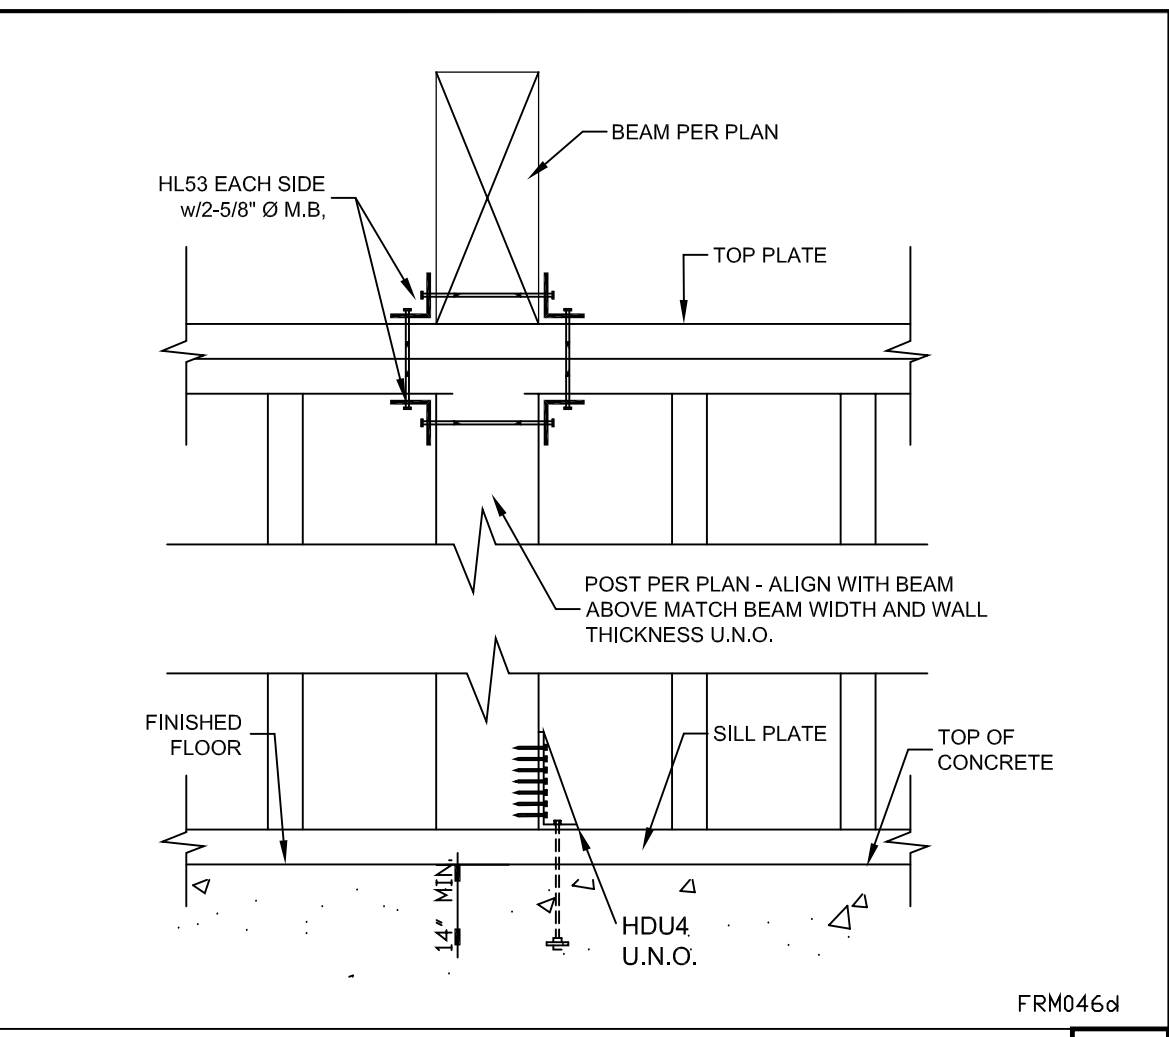


FRM046d

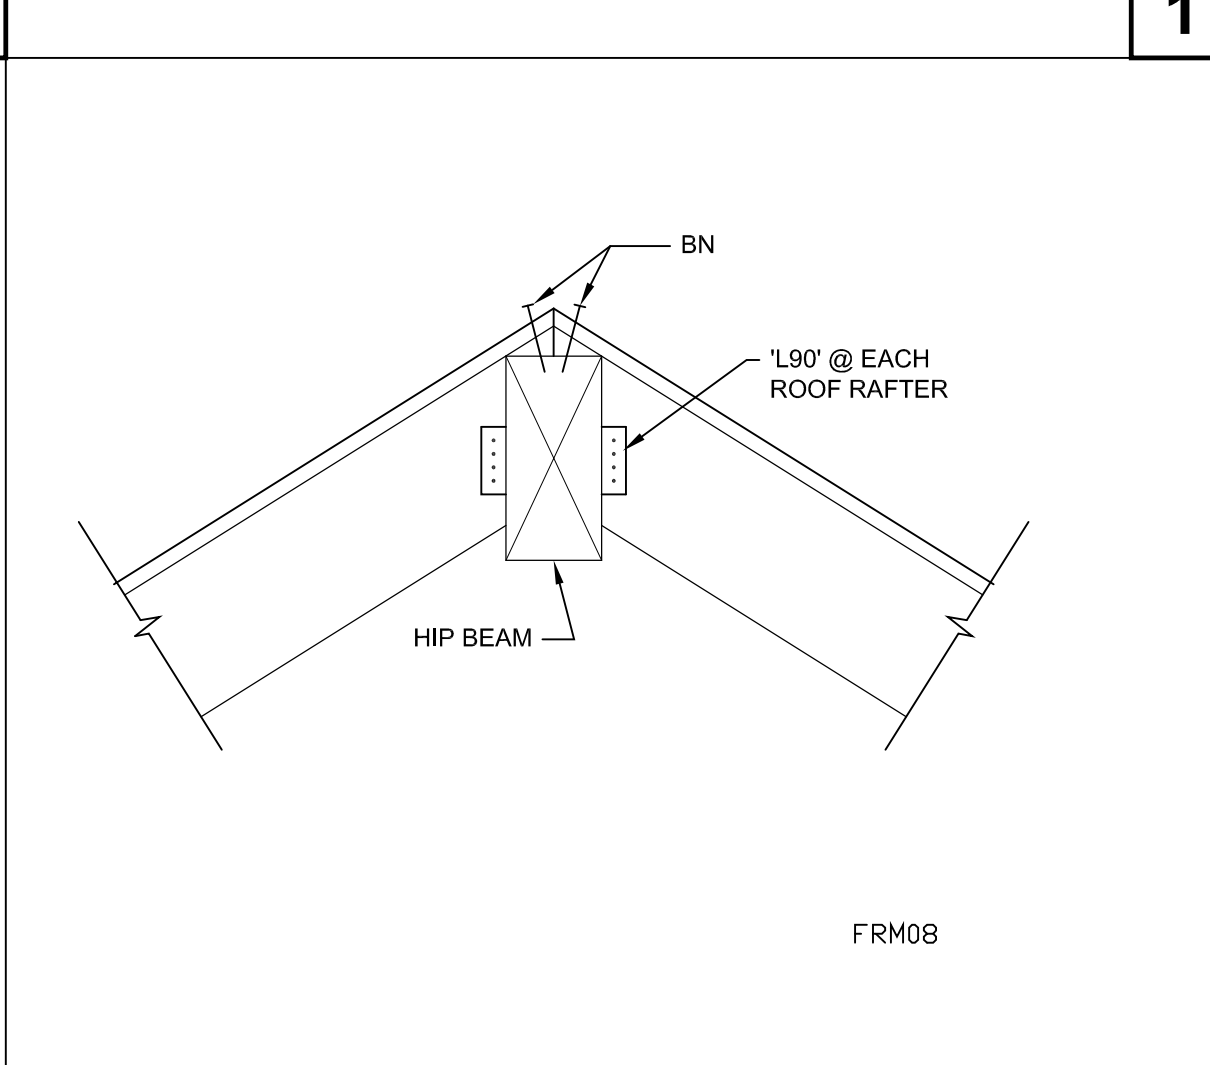


FRM08

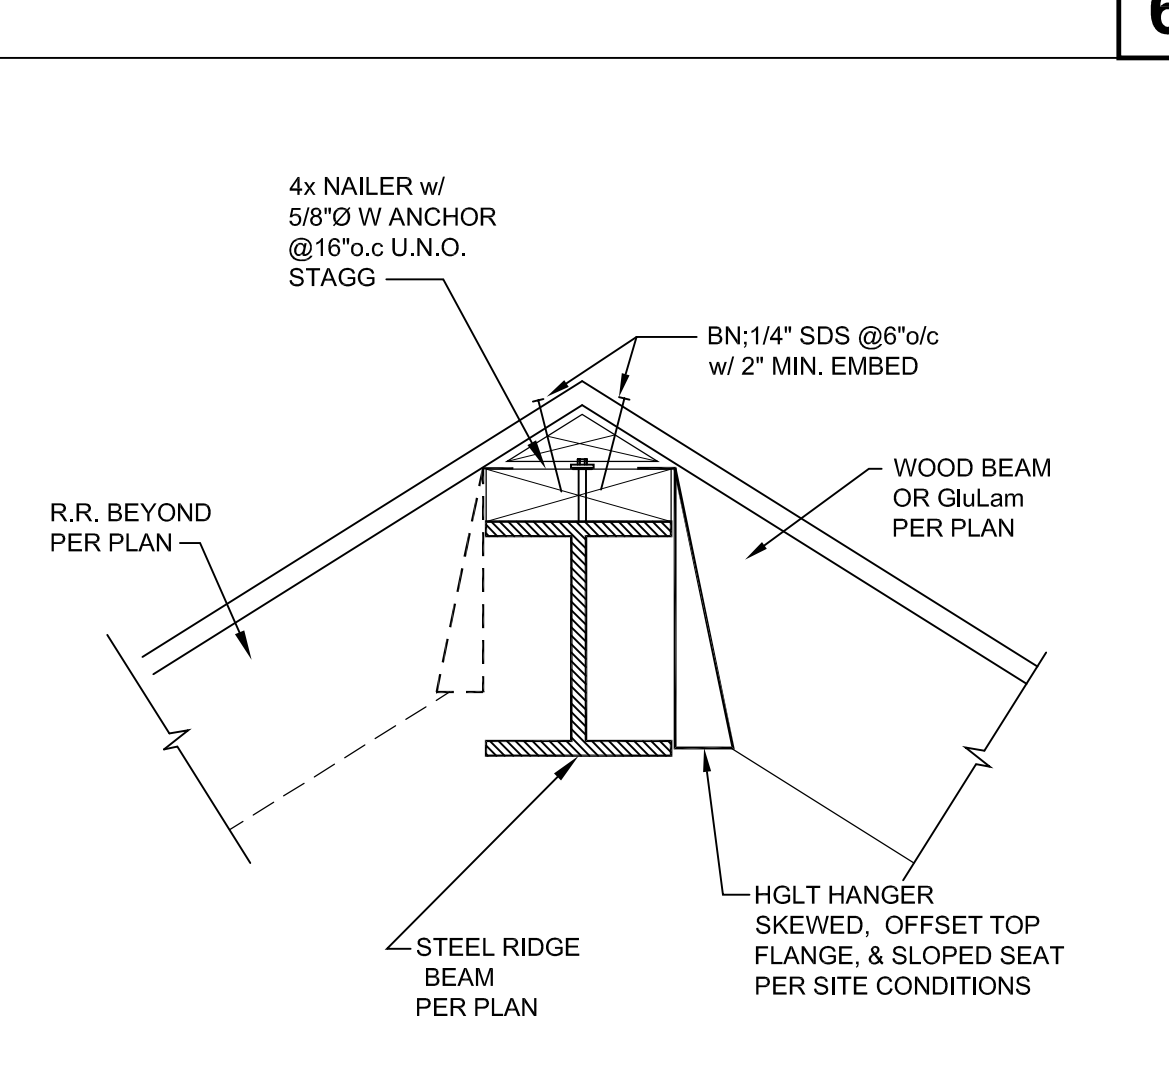


FRM08a

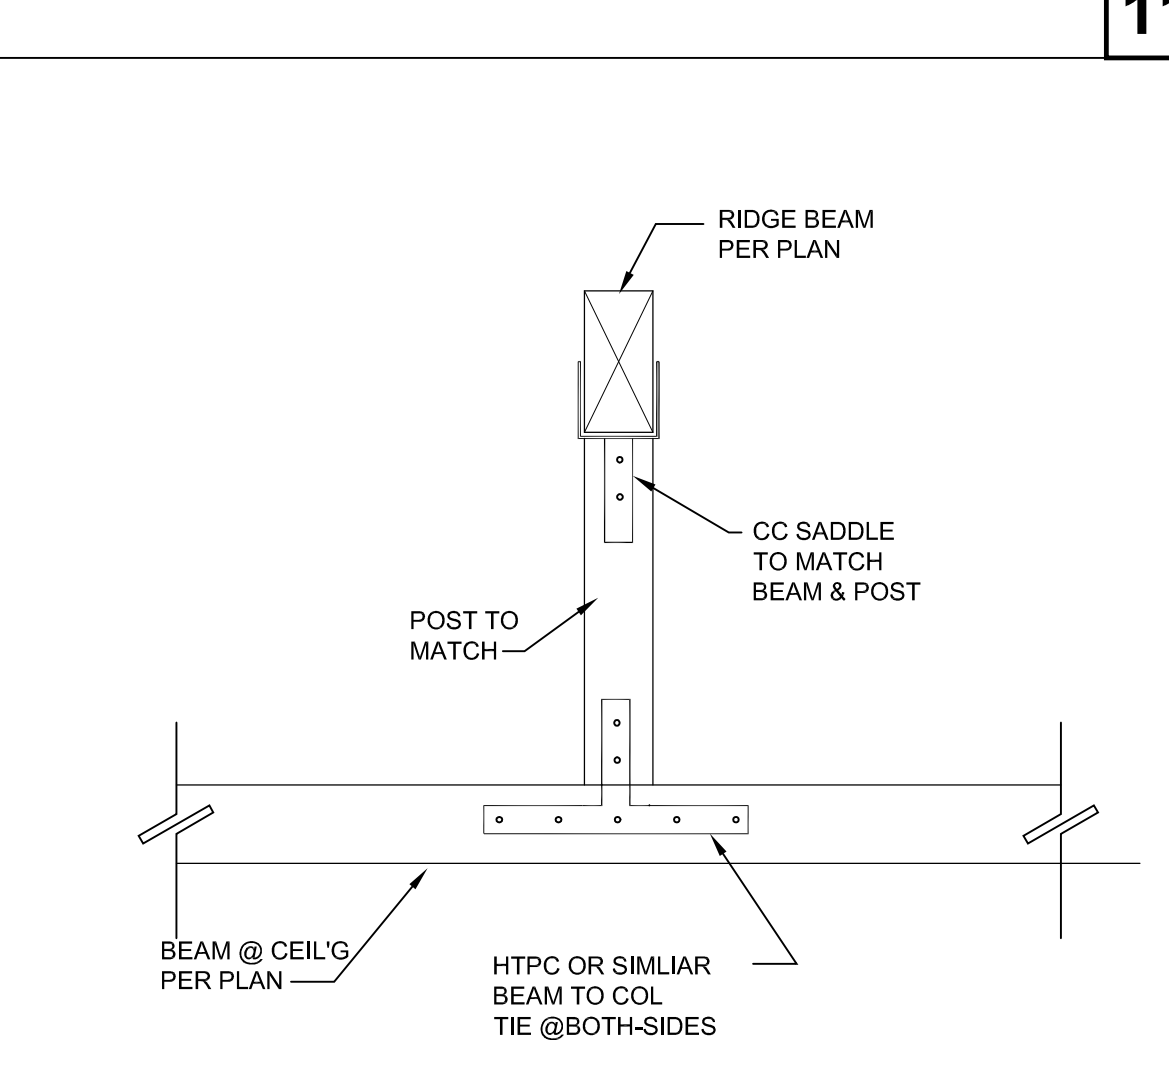


FRM17

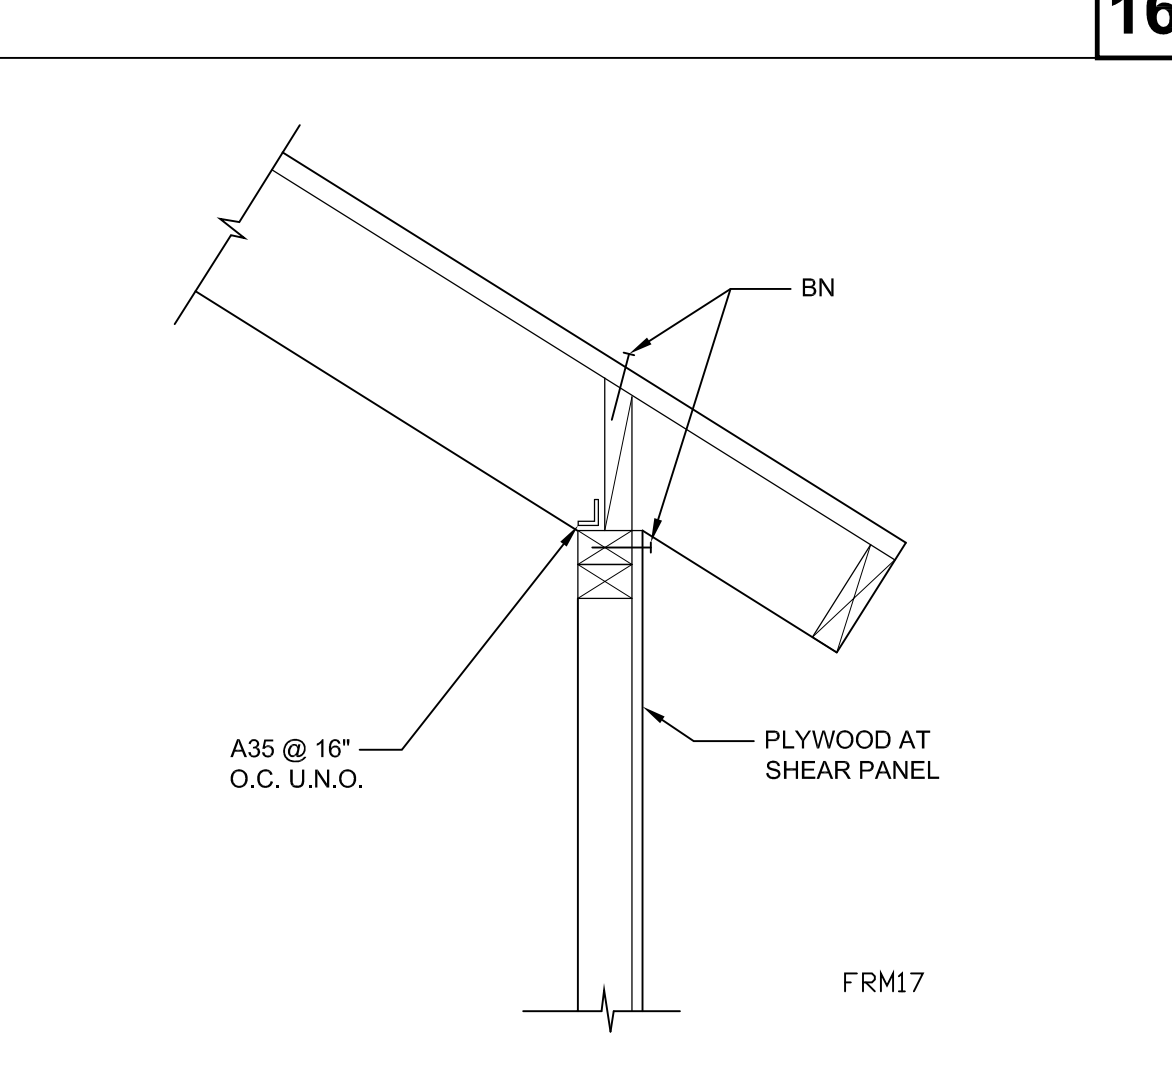


FRM17

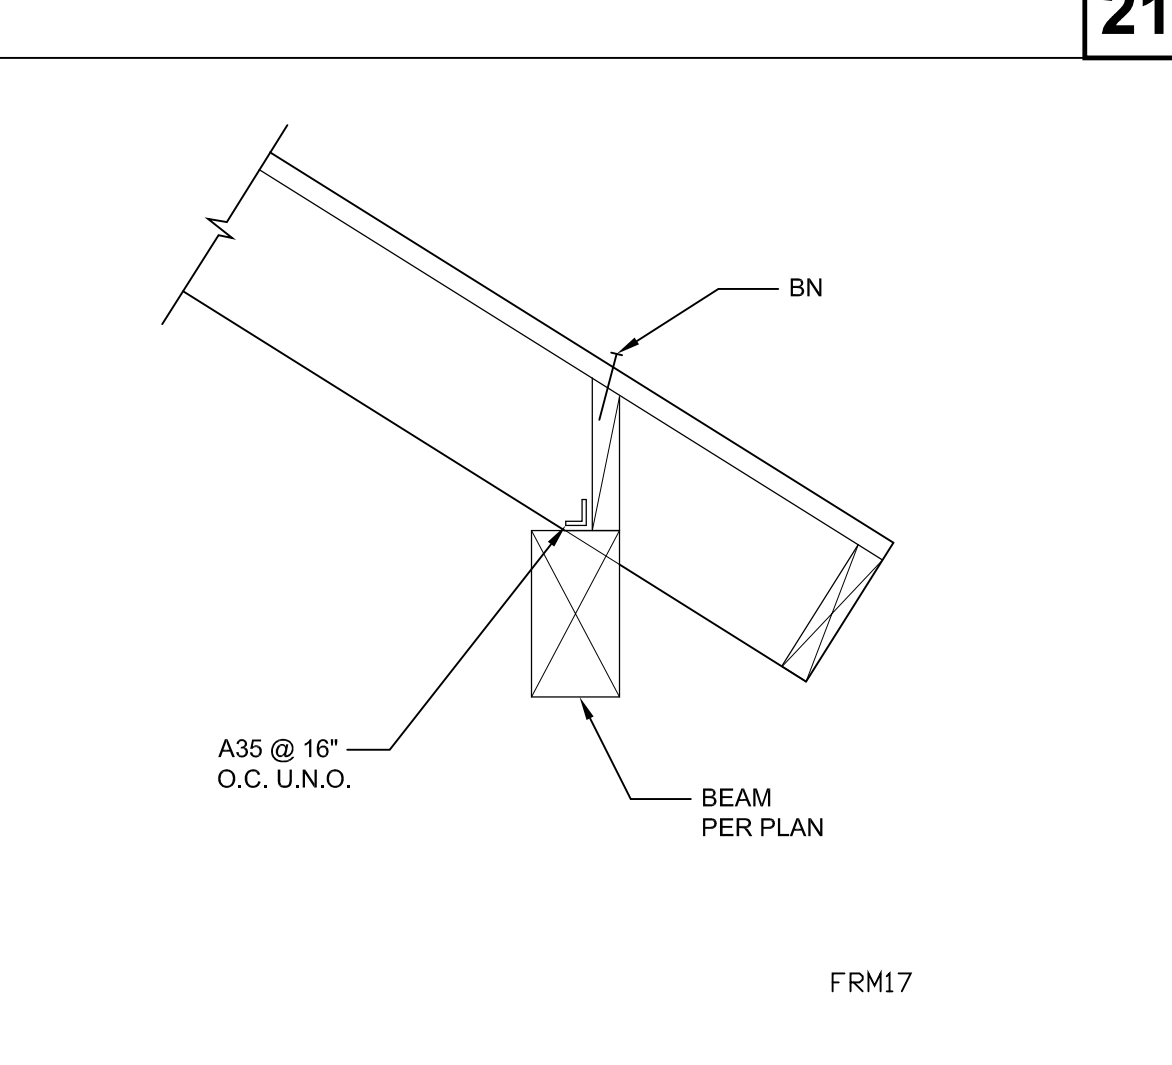


FRM17

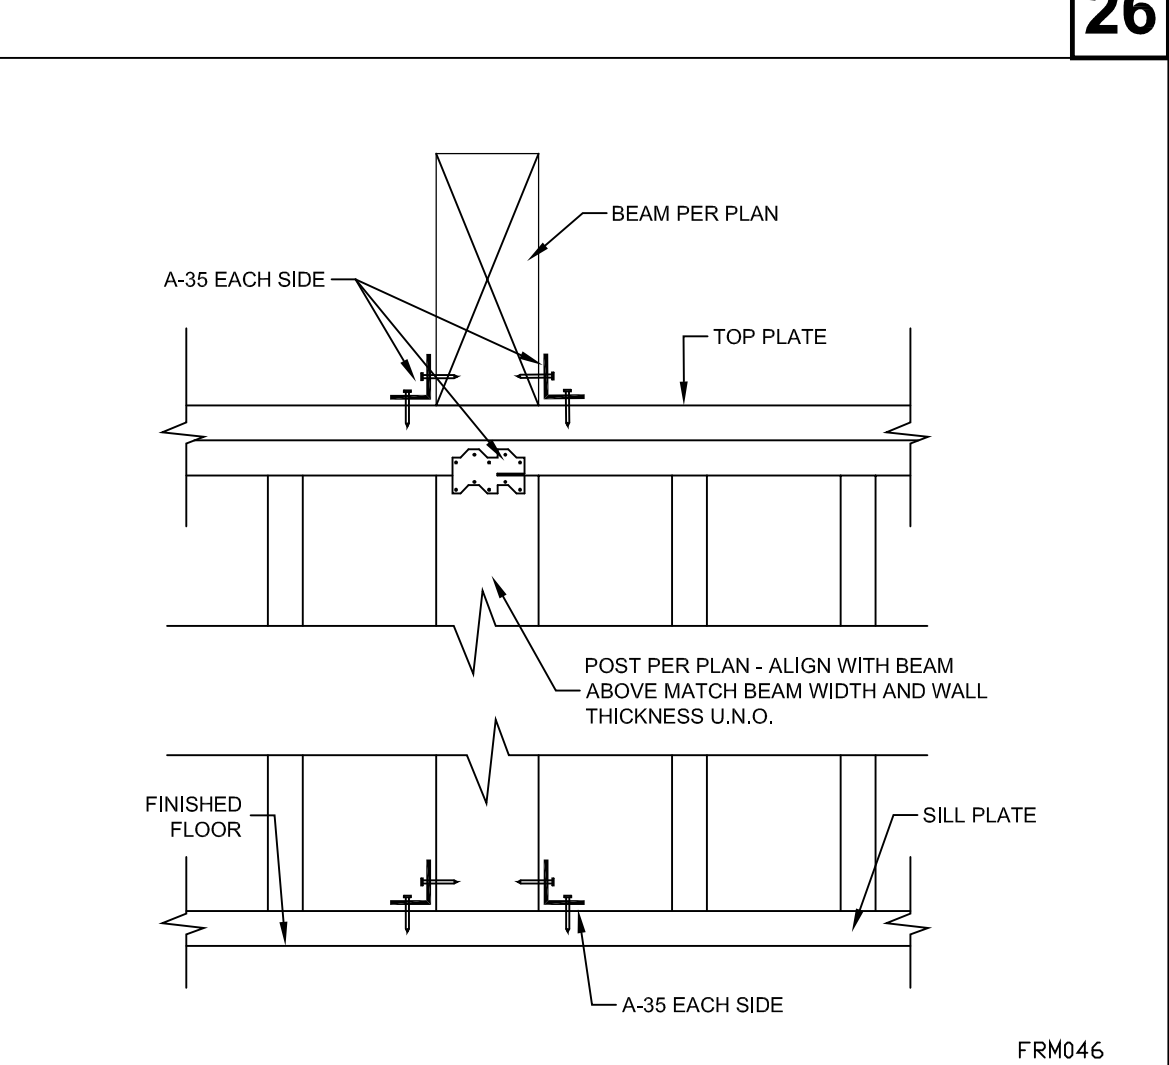


FRM046

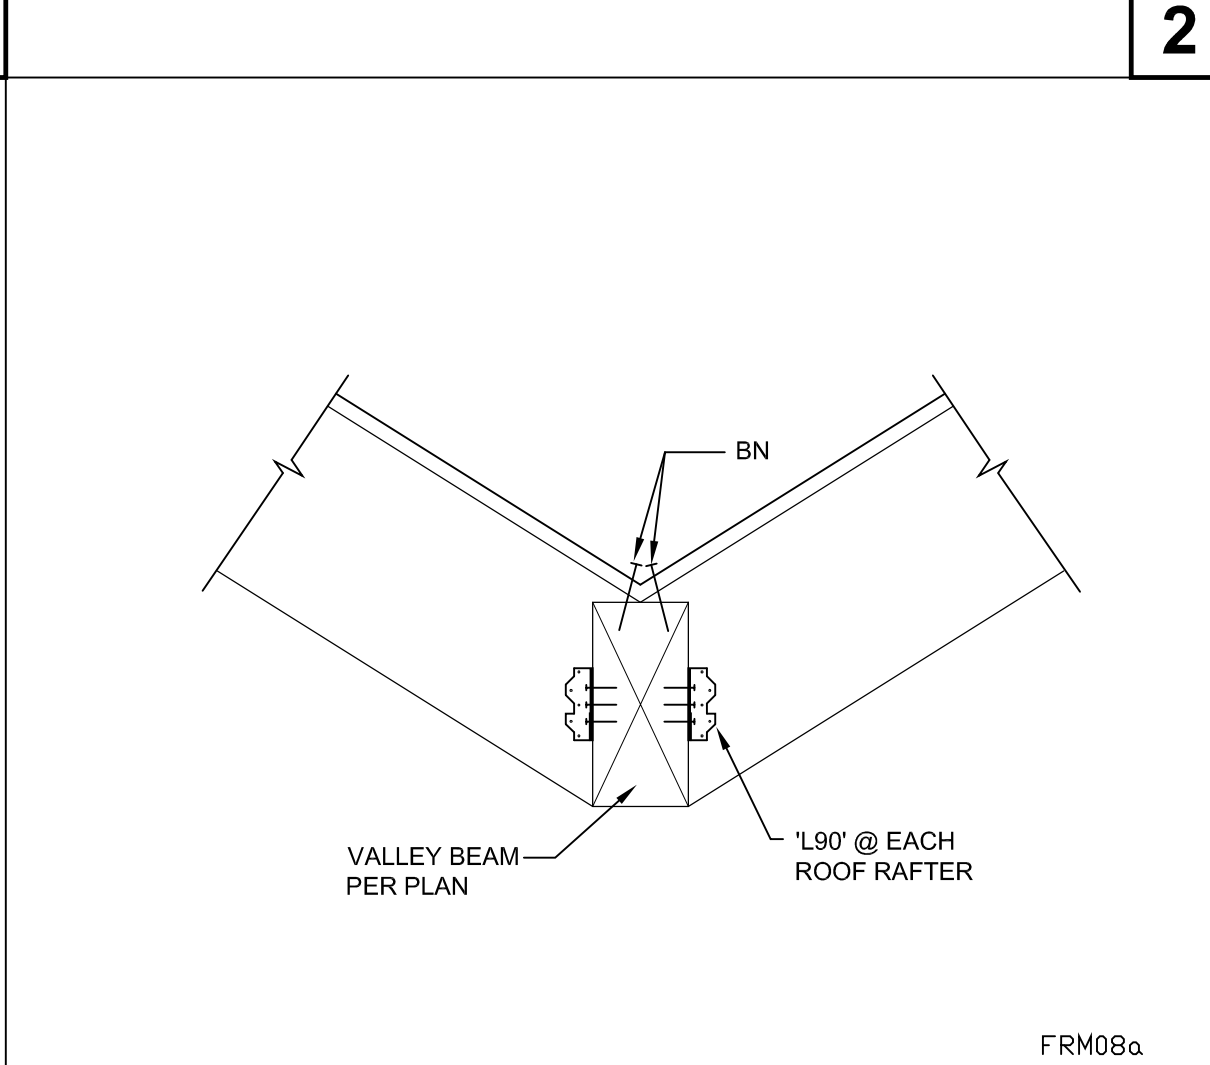


FRM08a

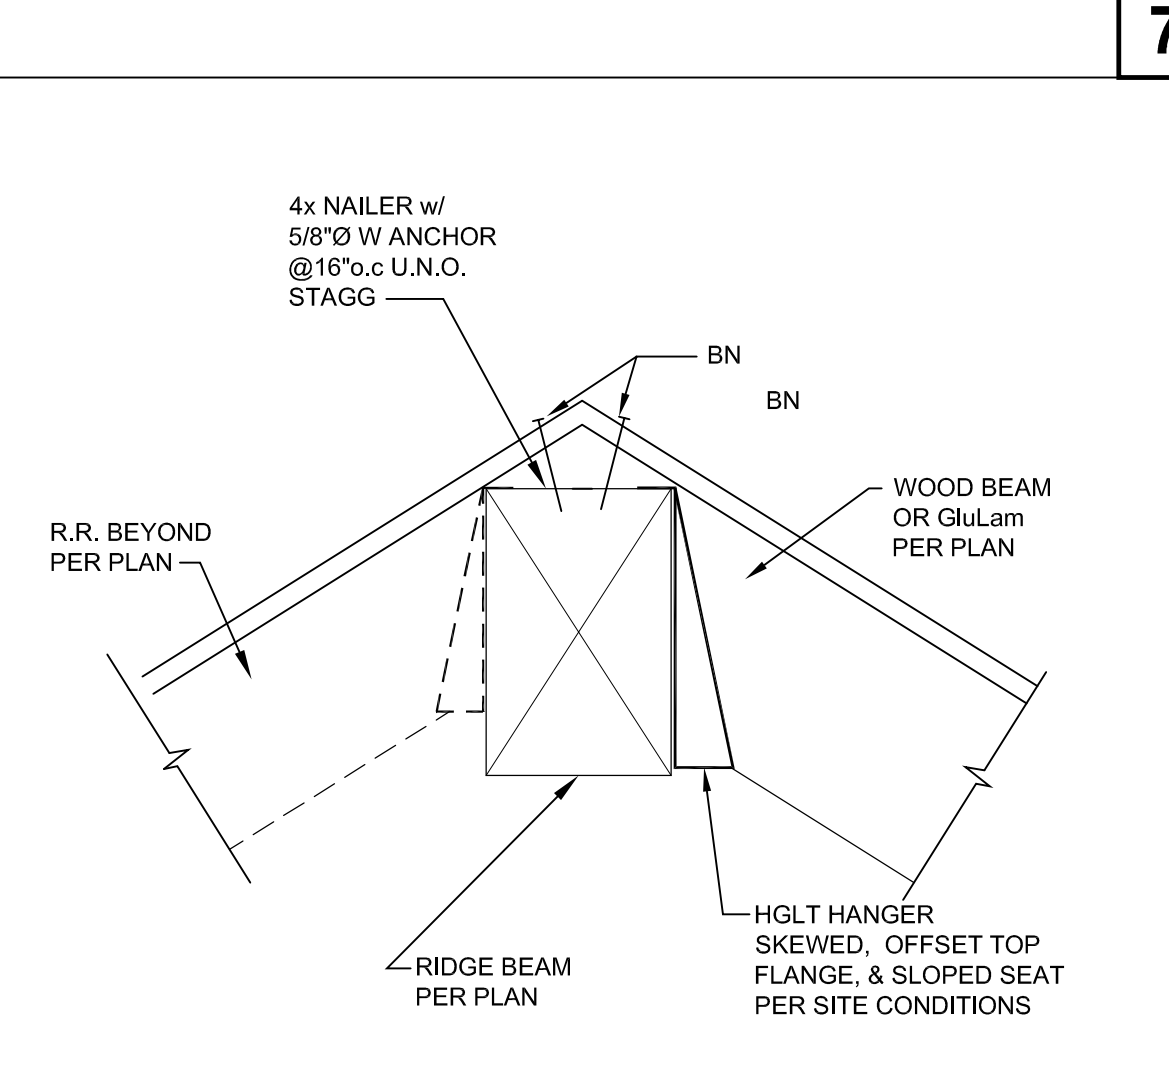


FRM08a

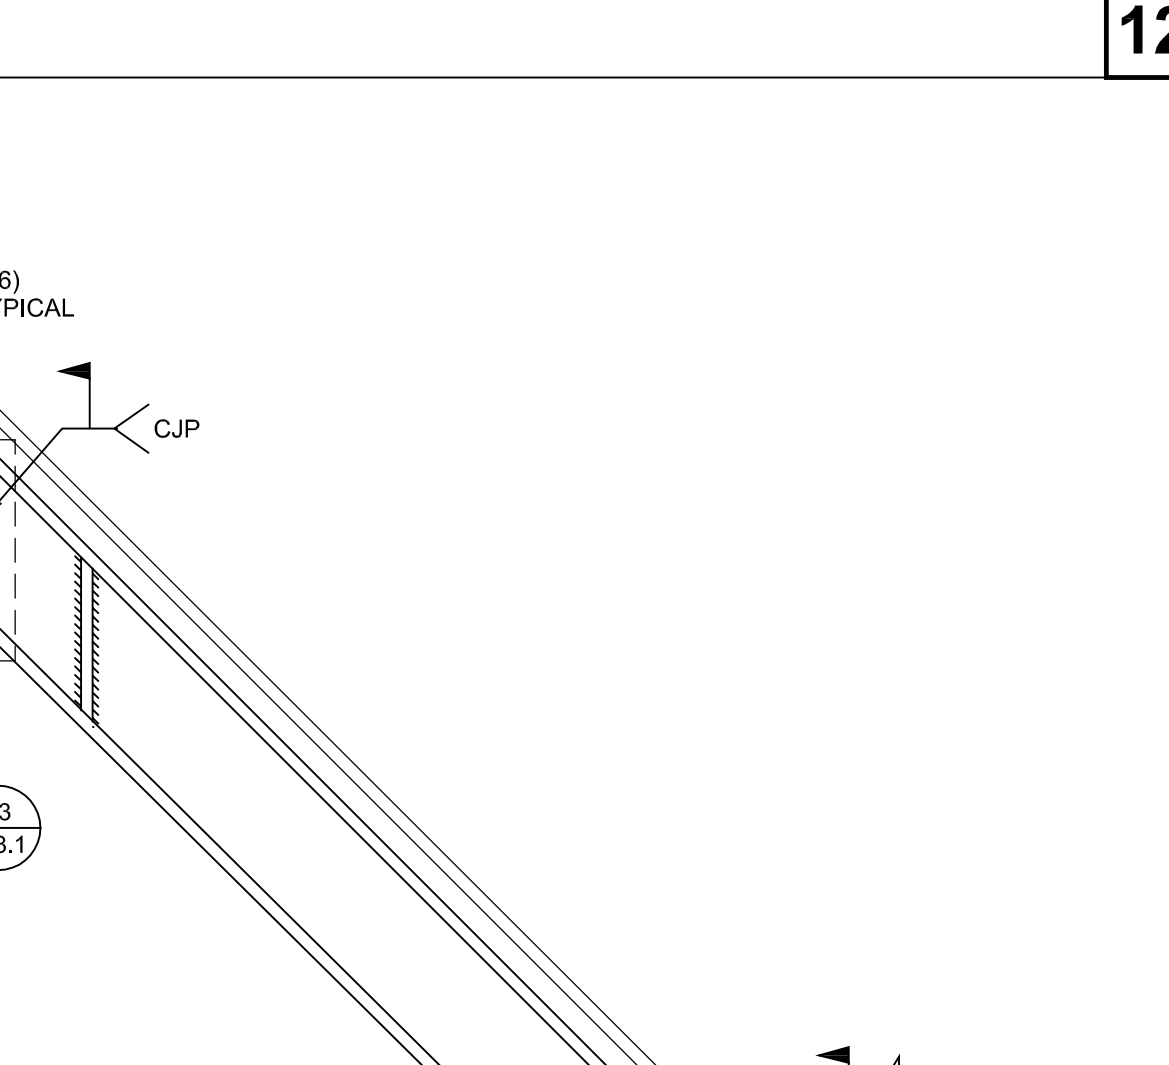


FRM17

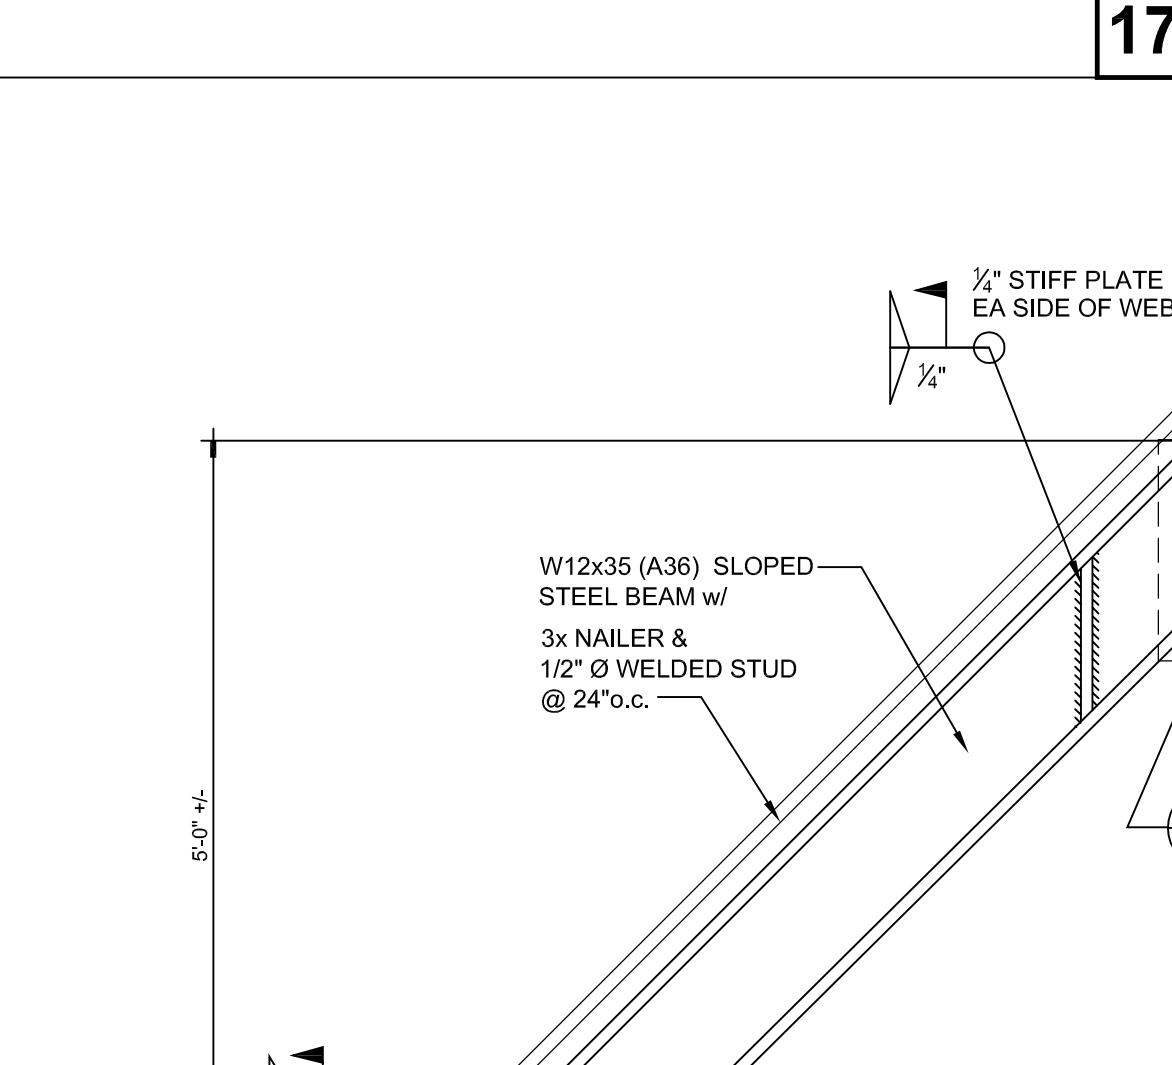


FRM17

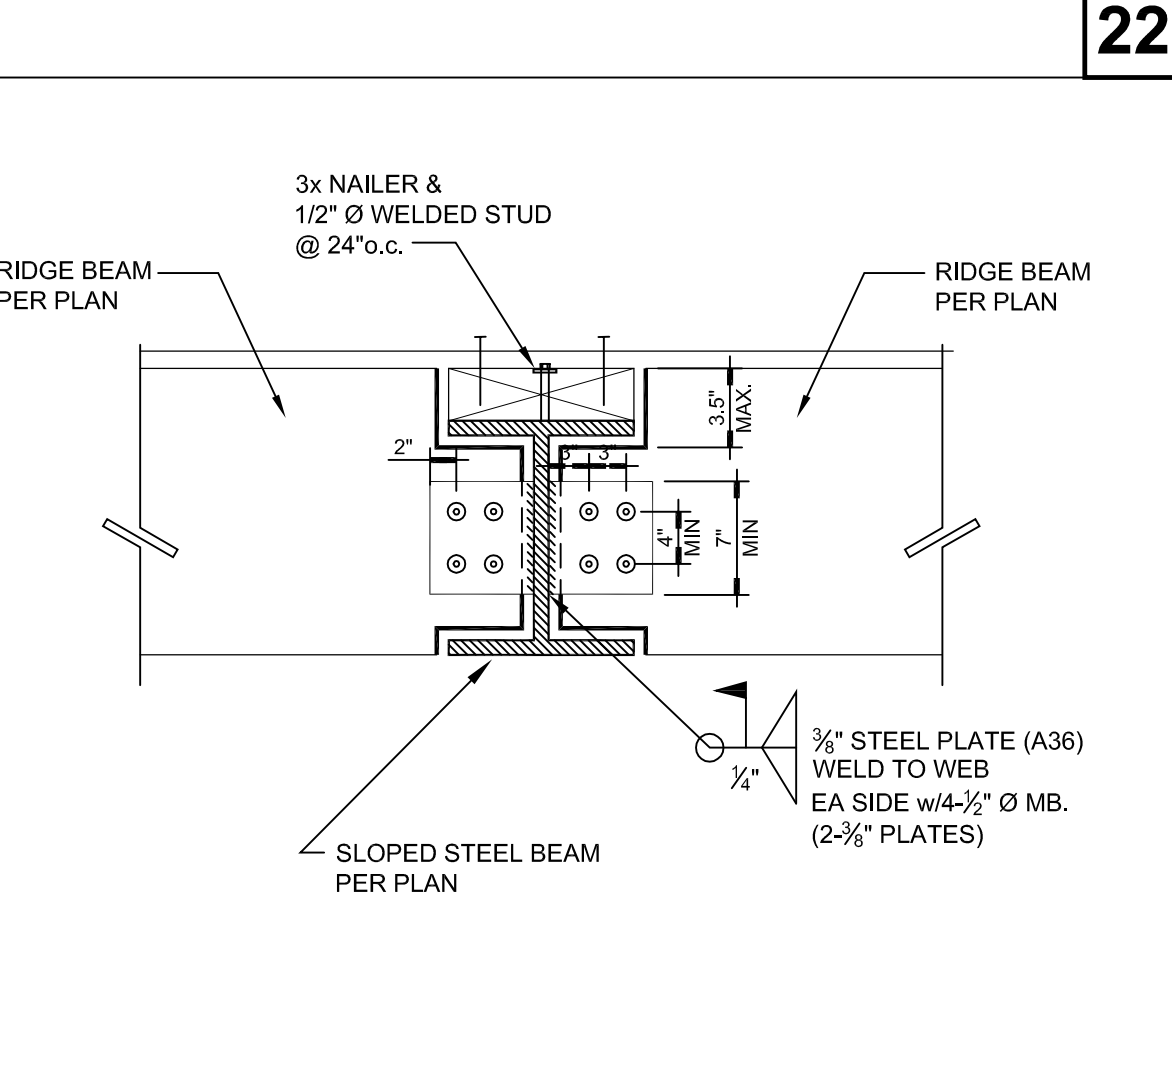


FRM17

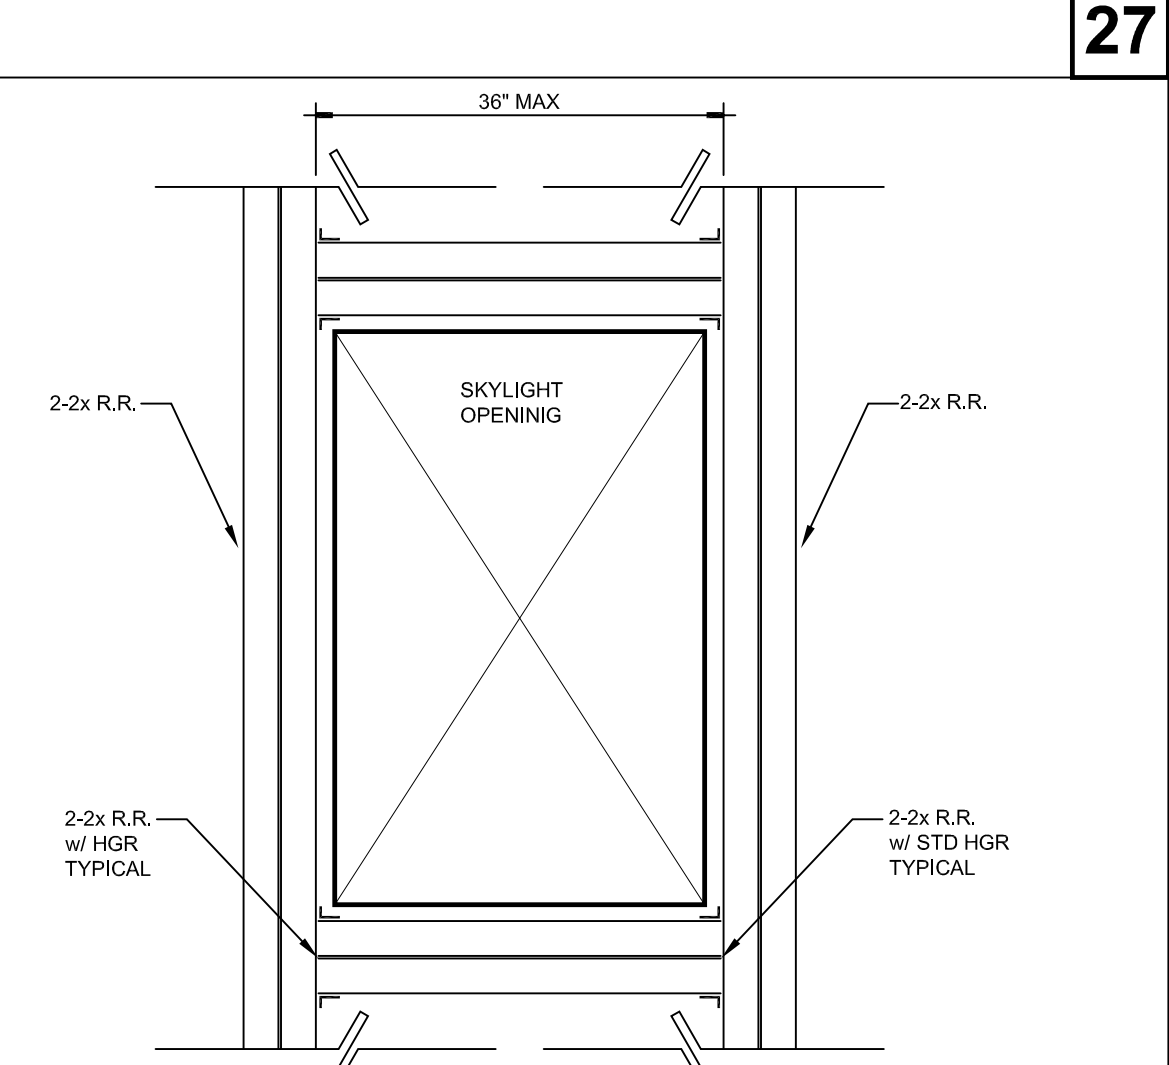


FRM046

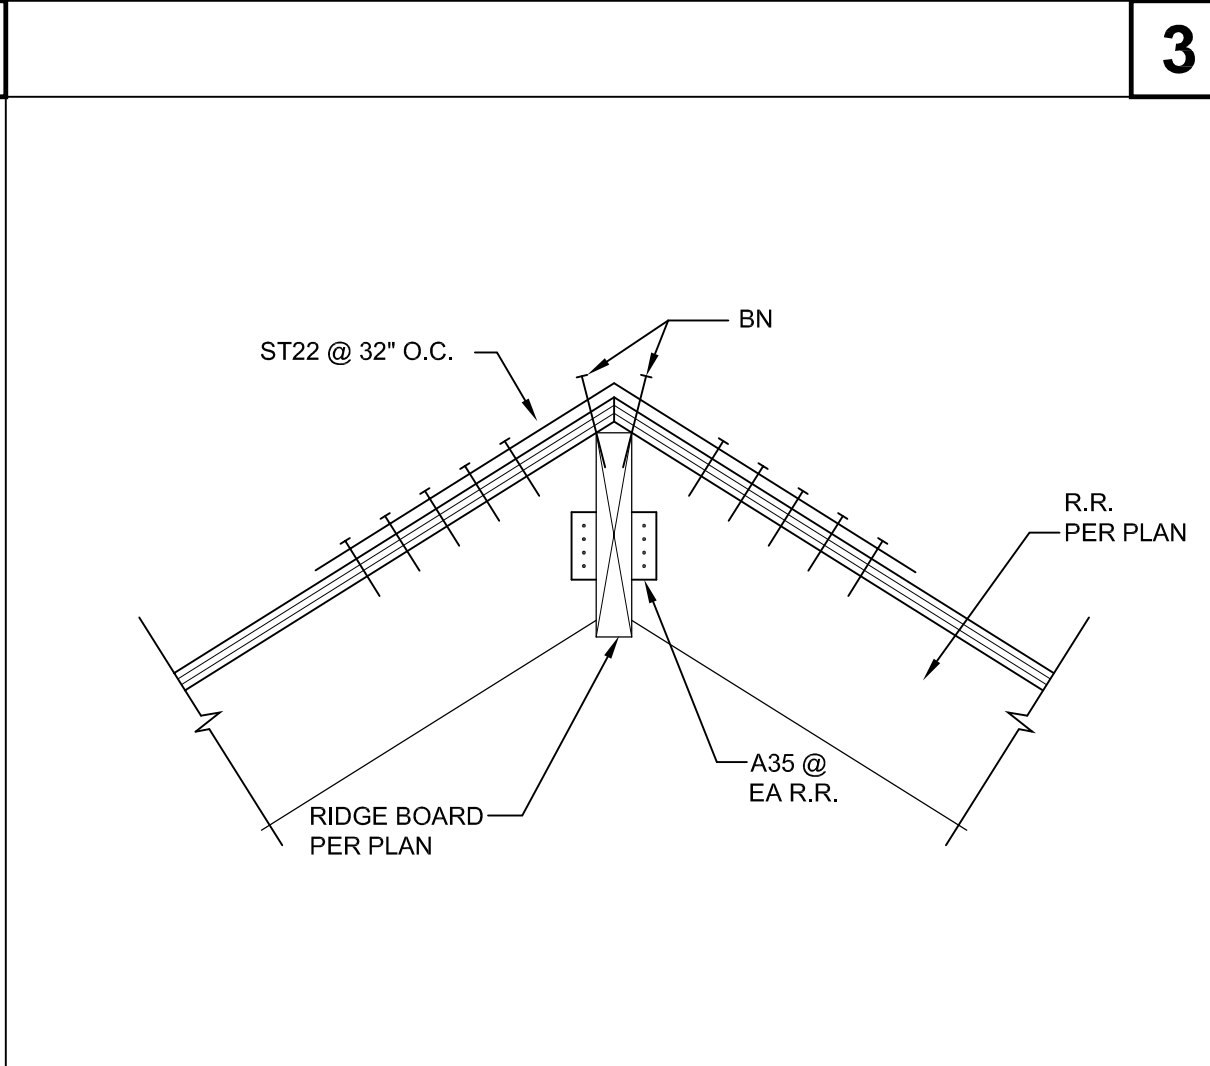


FRM08a

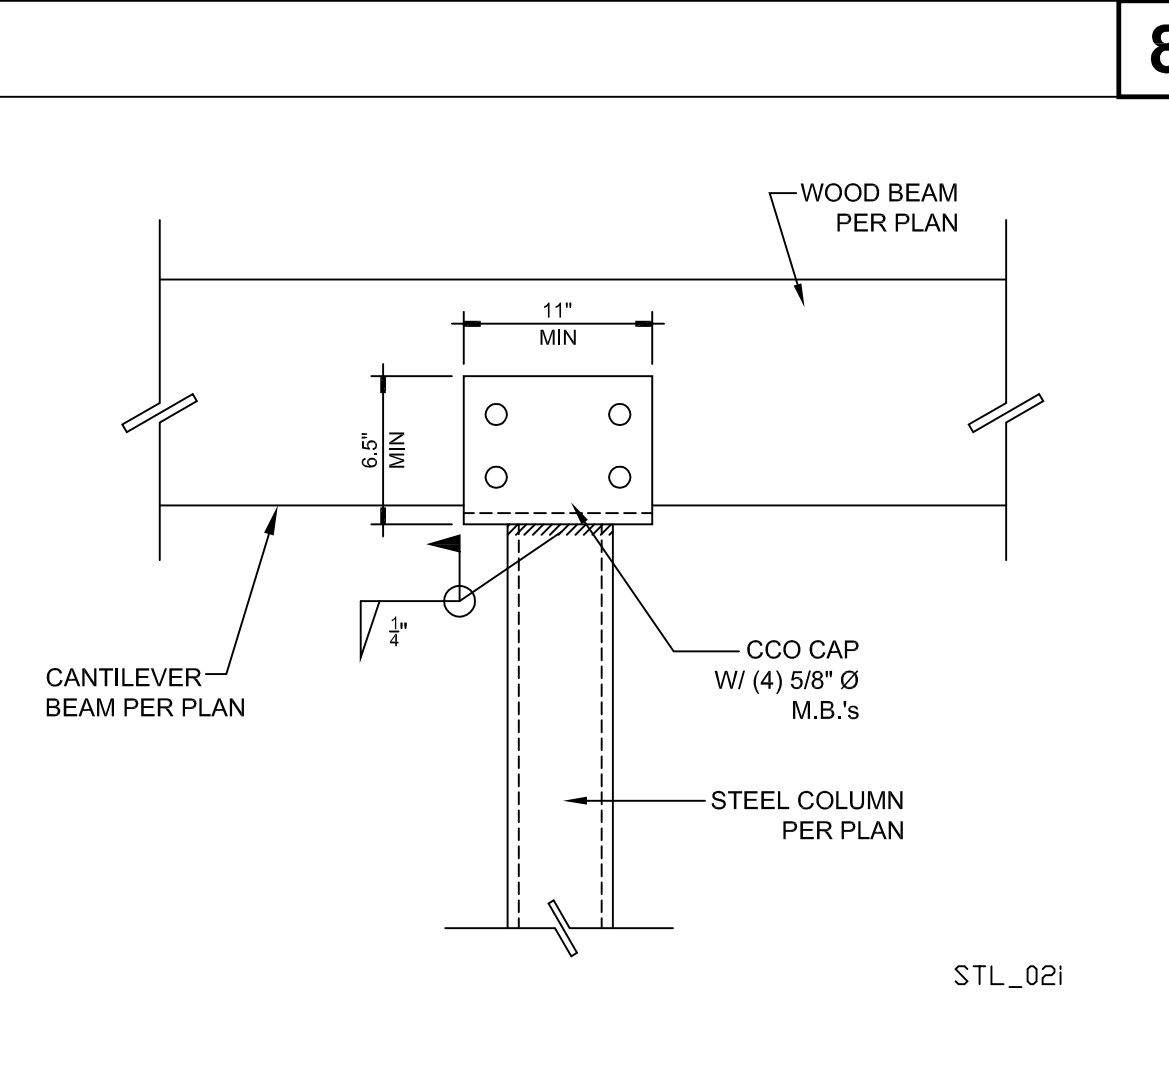


STL\_02I

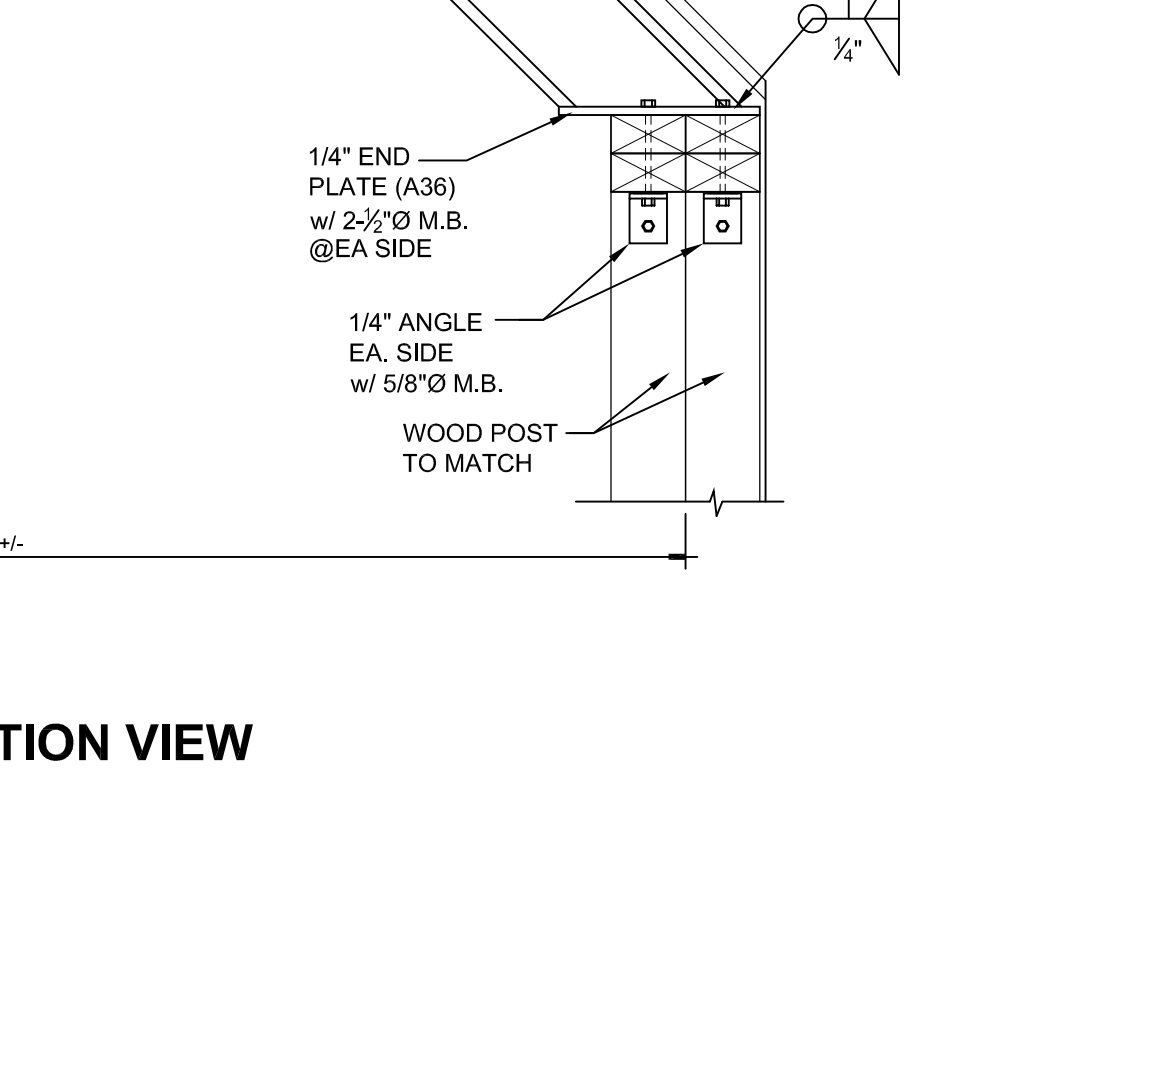


TRUSS ELEVATION VIEW

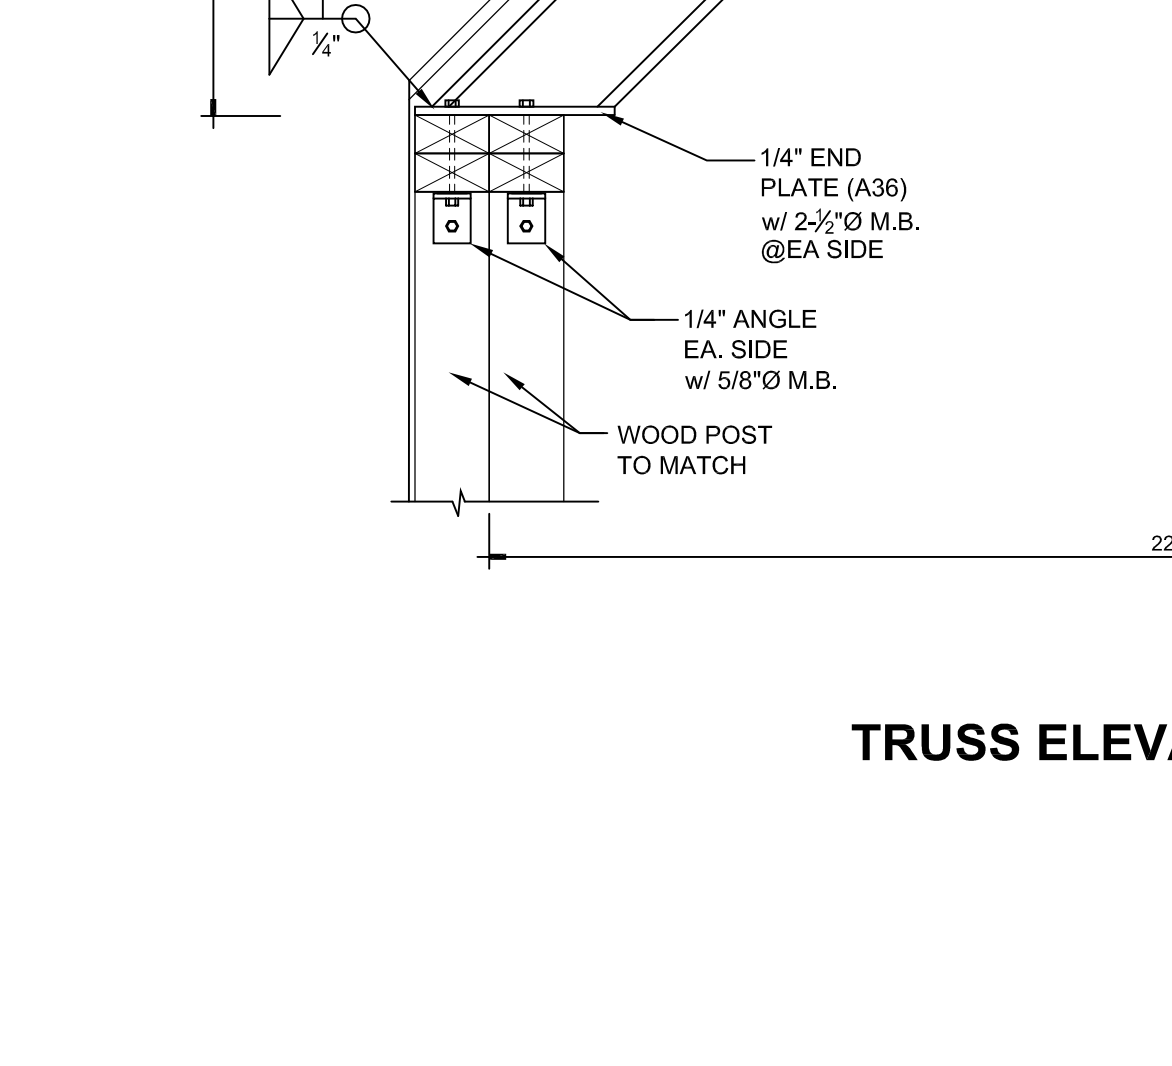


FRM17

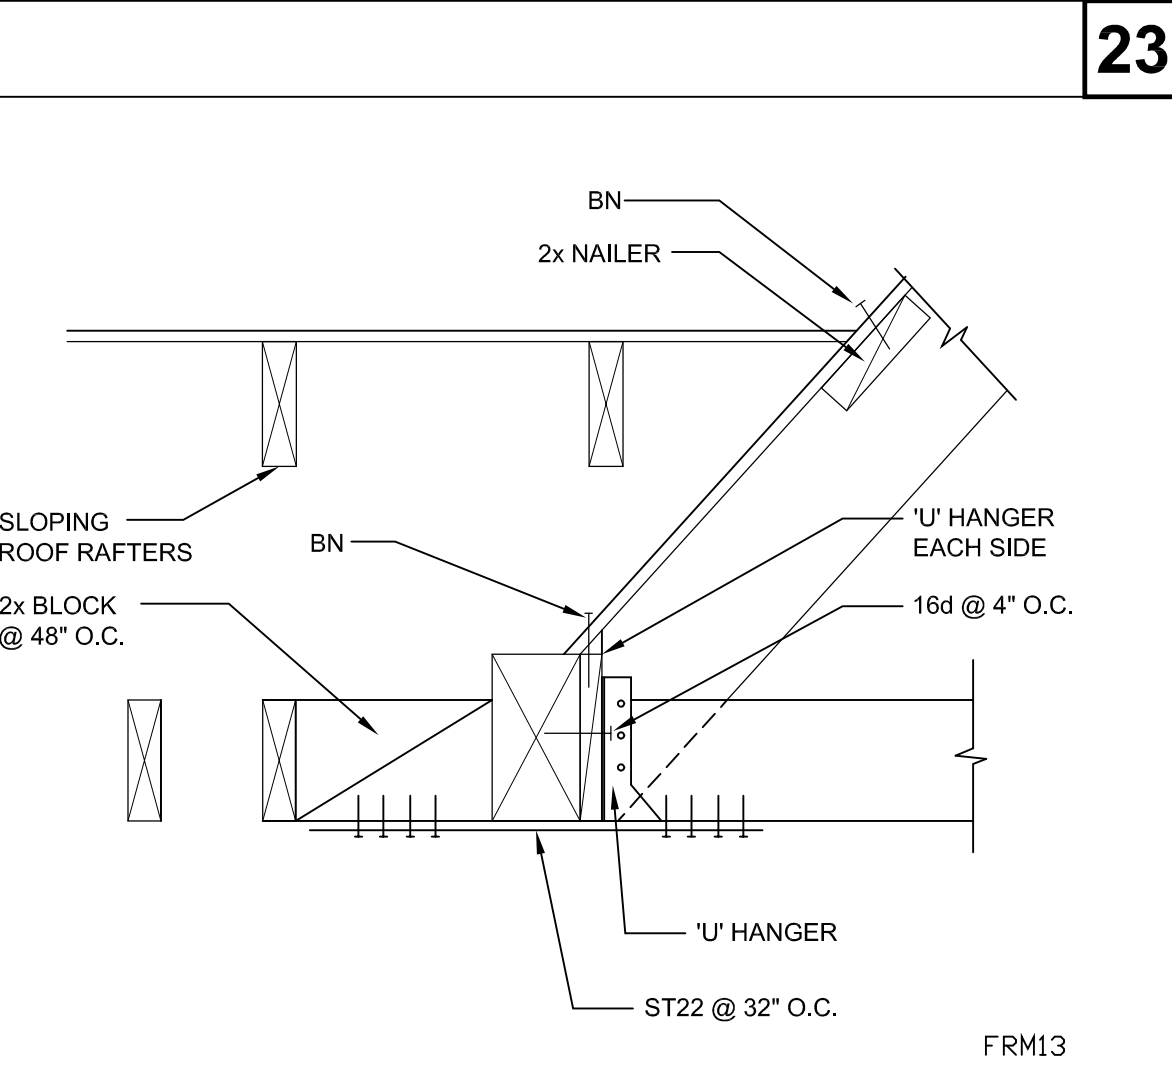


FRM17

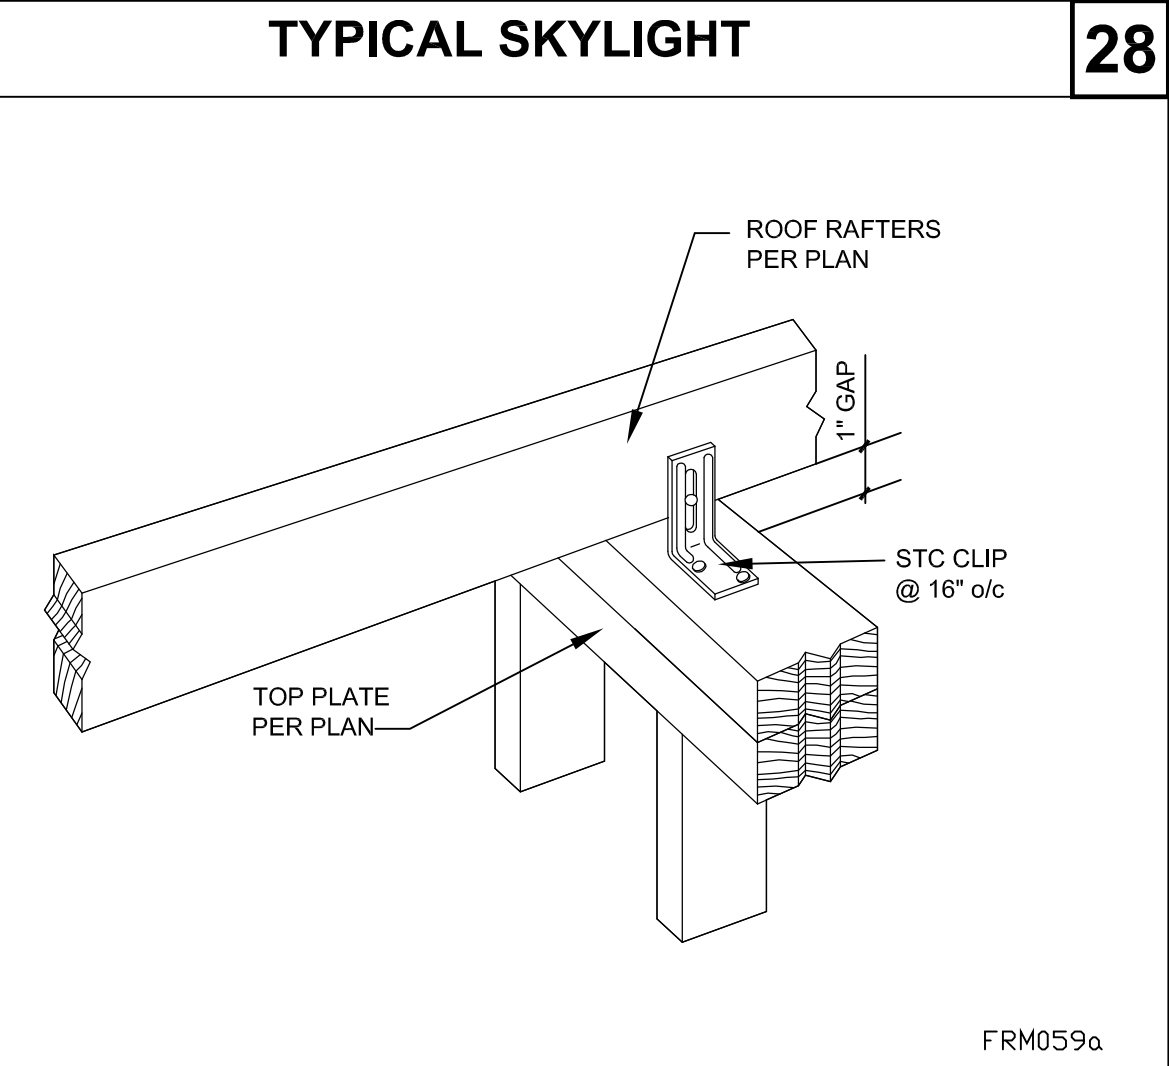


FRM059a

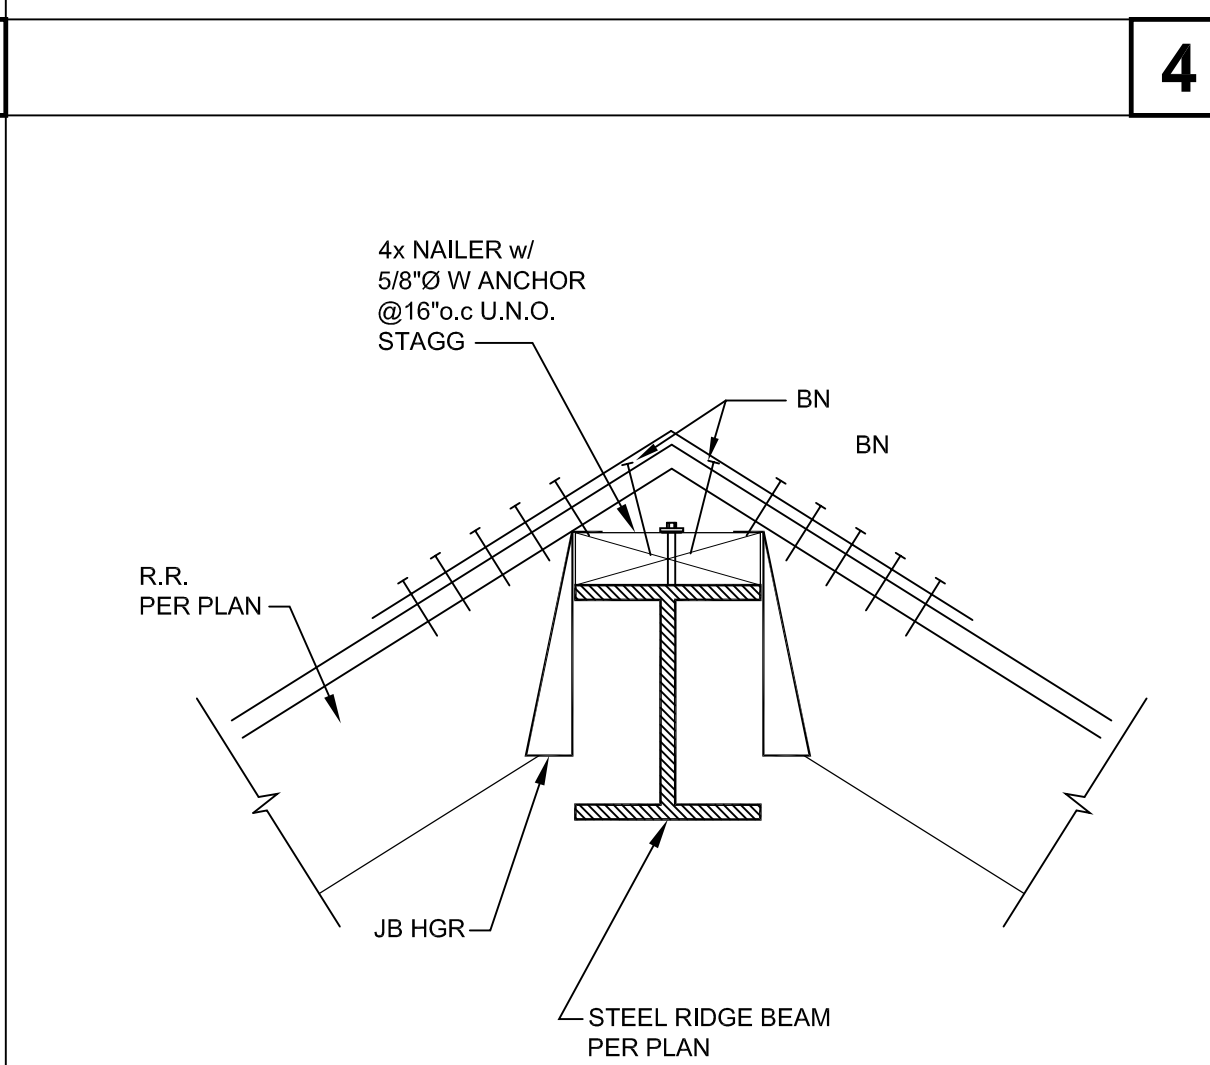


FRM08a

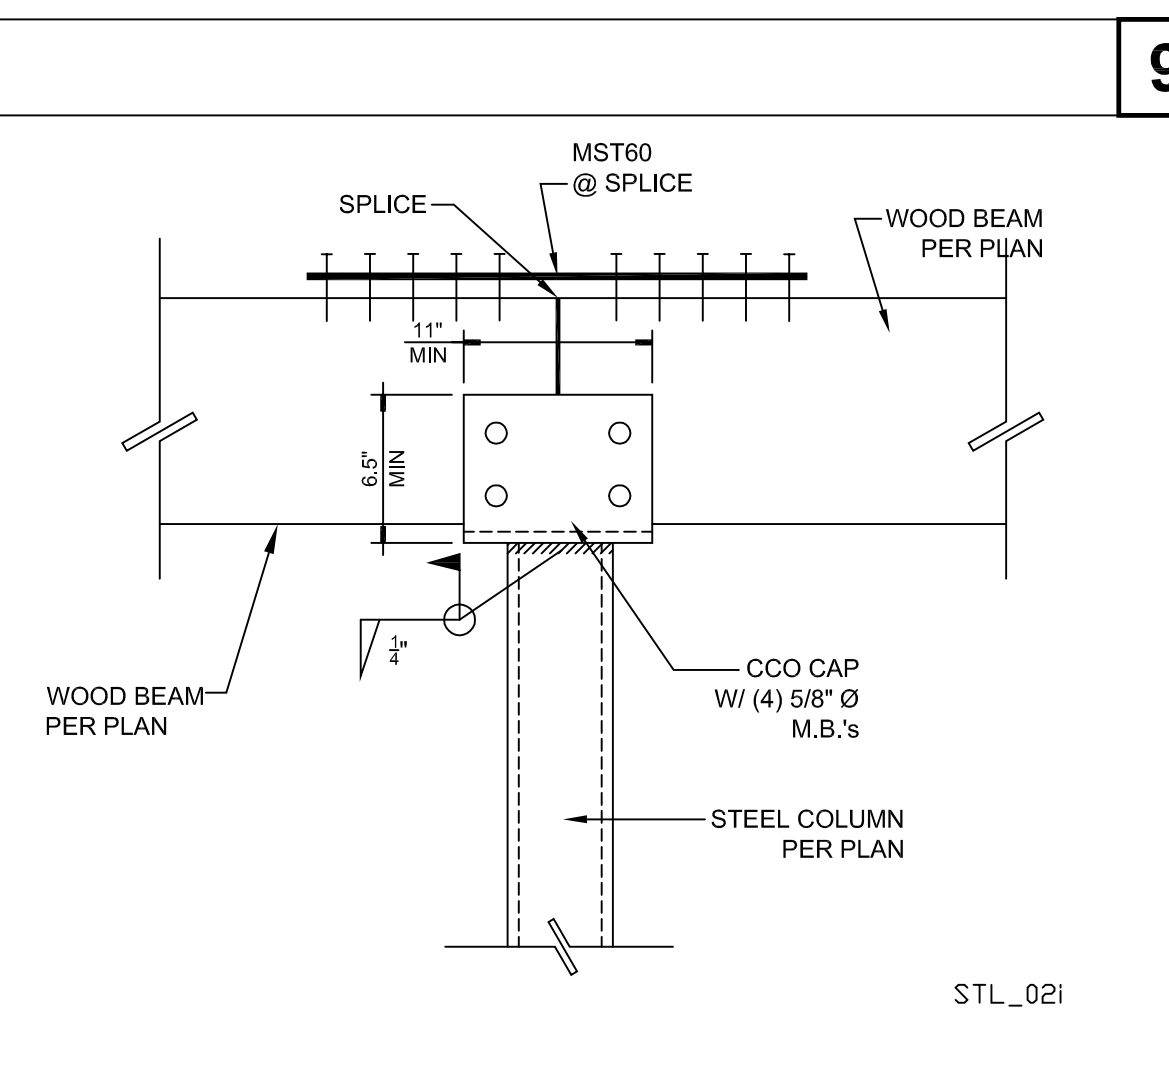


STL\_02I

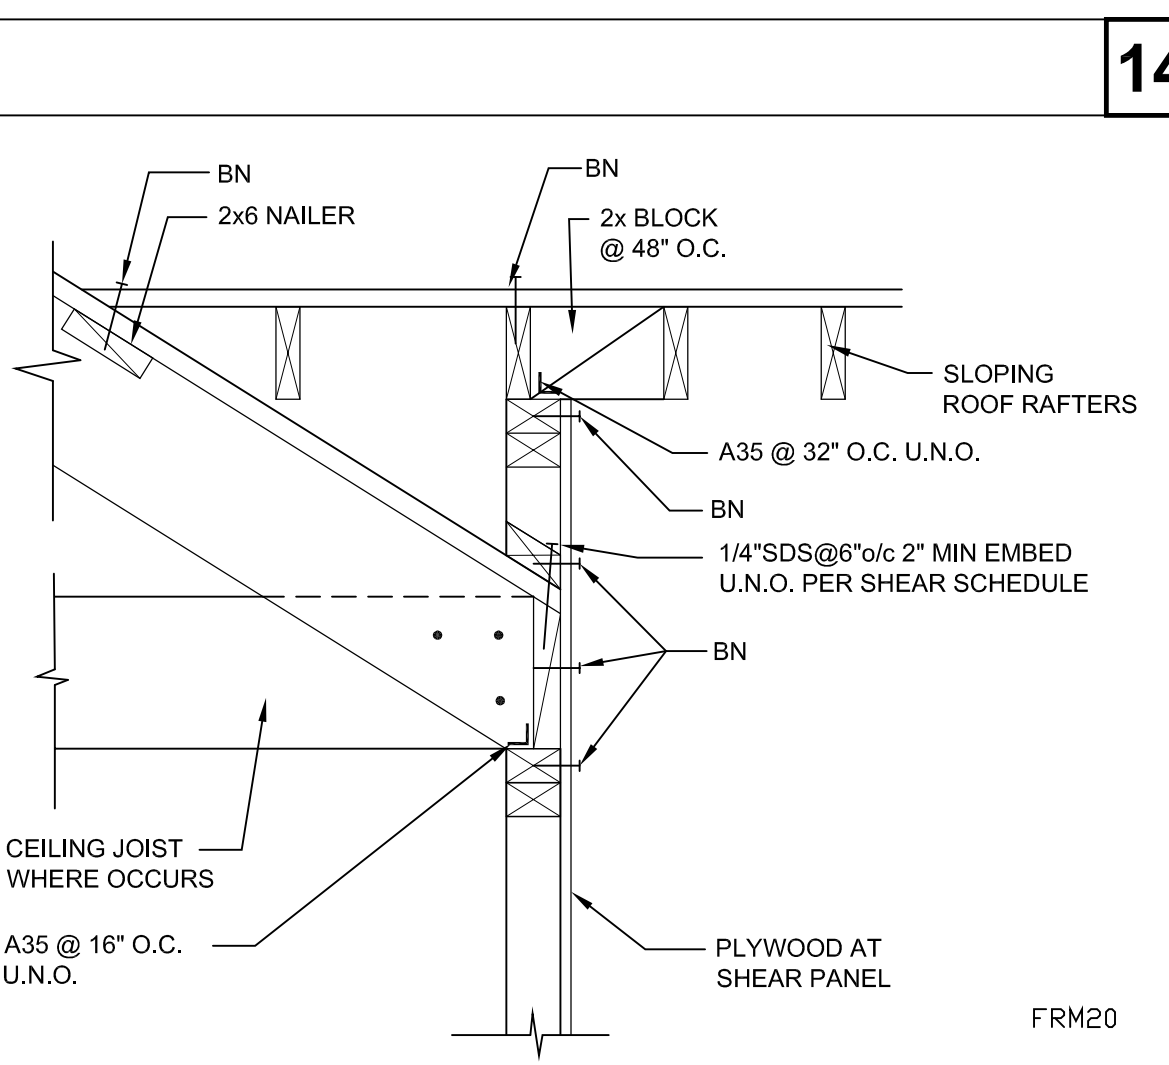


FRM20

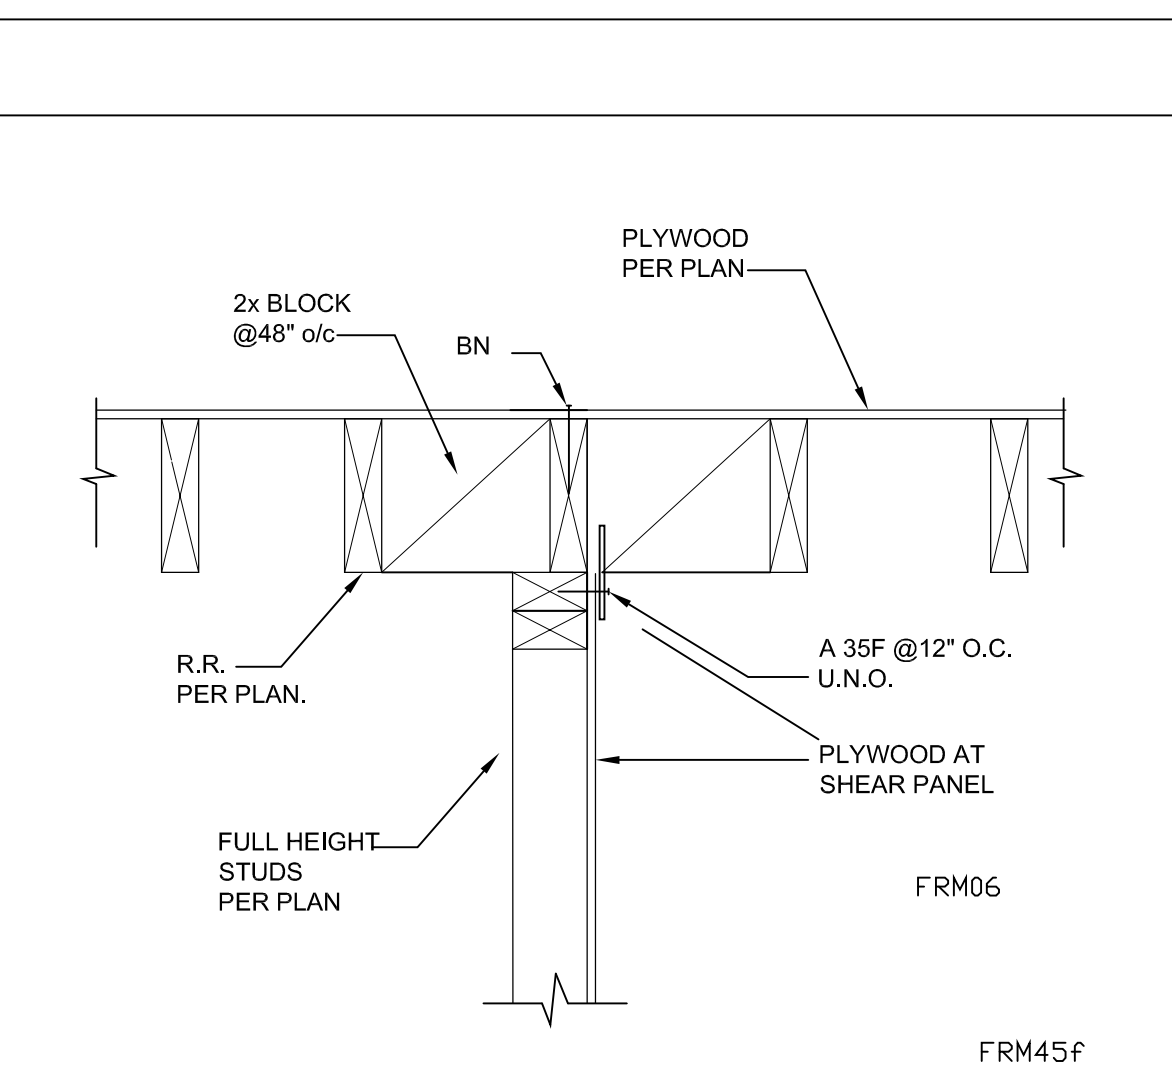


FRM05F

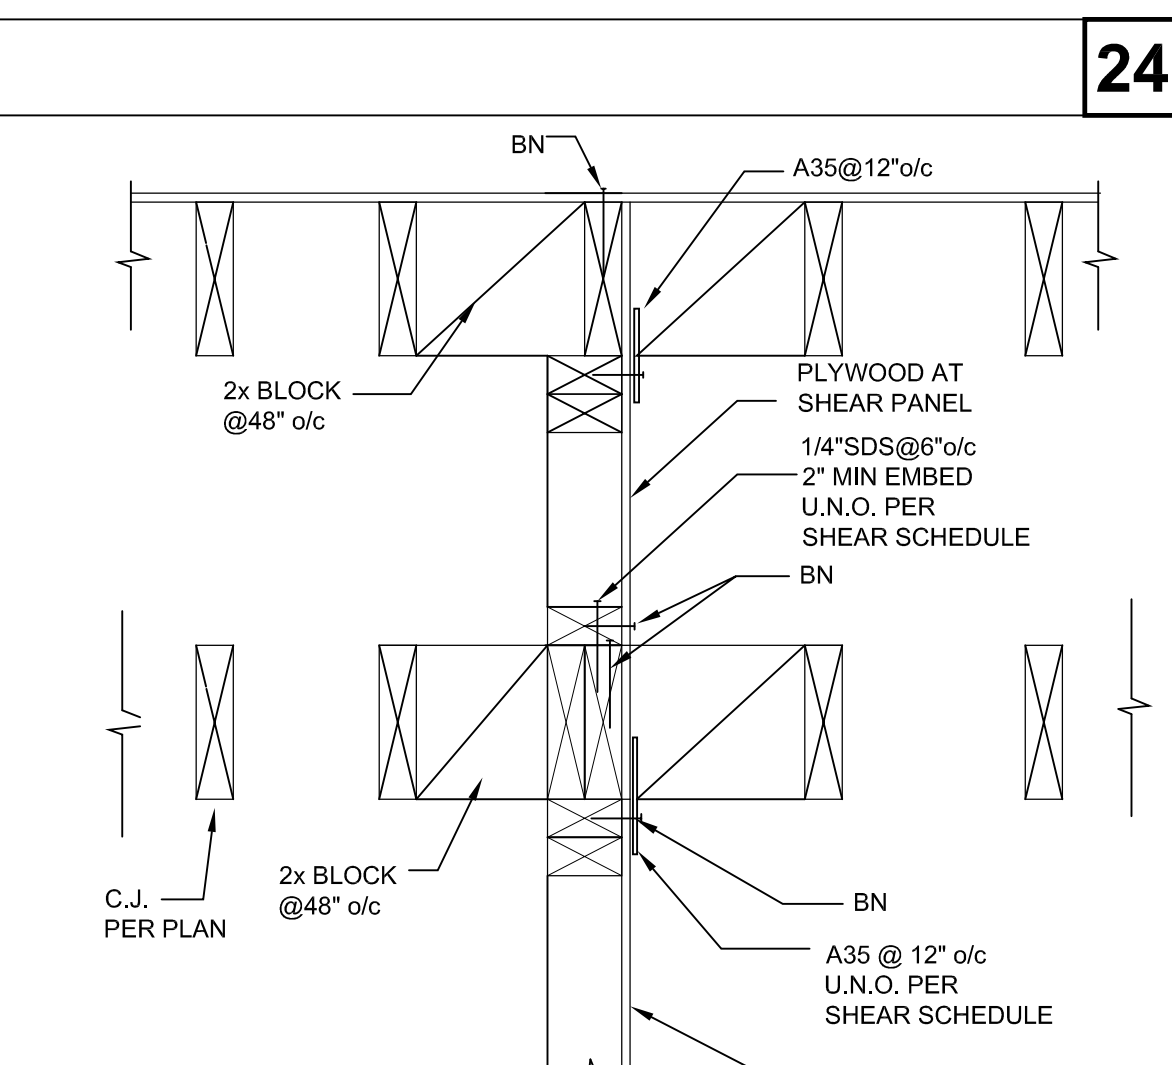


FRM13

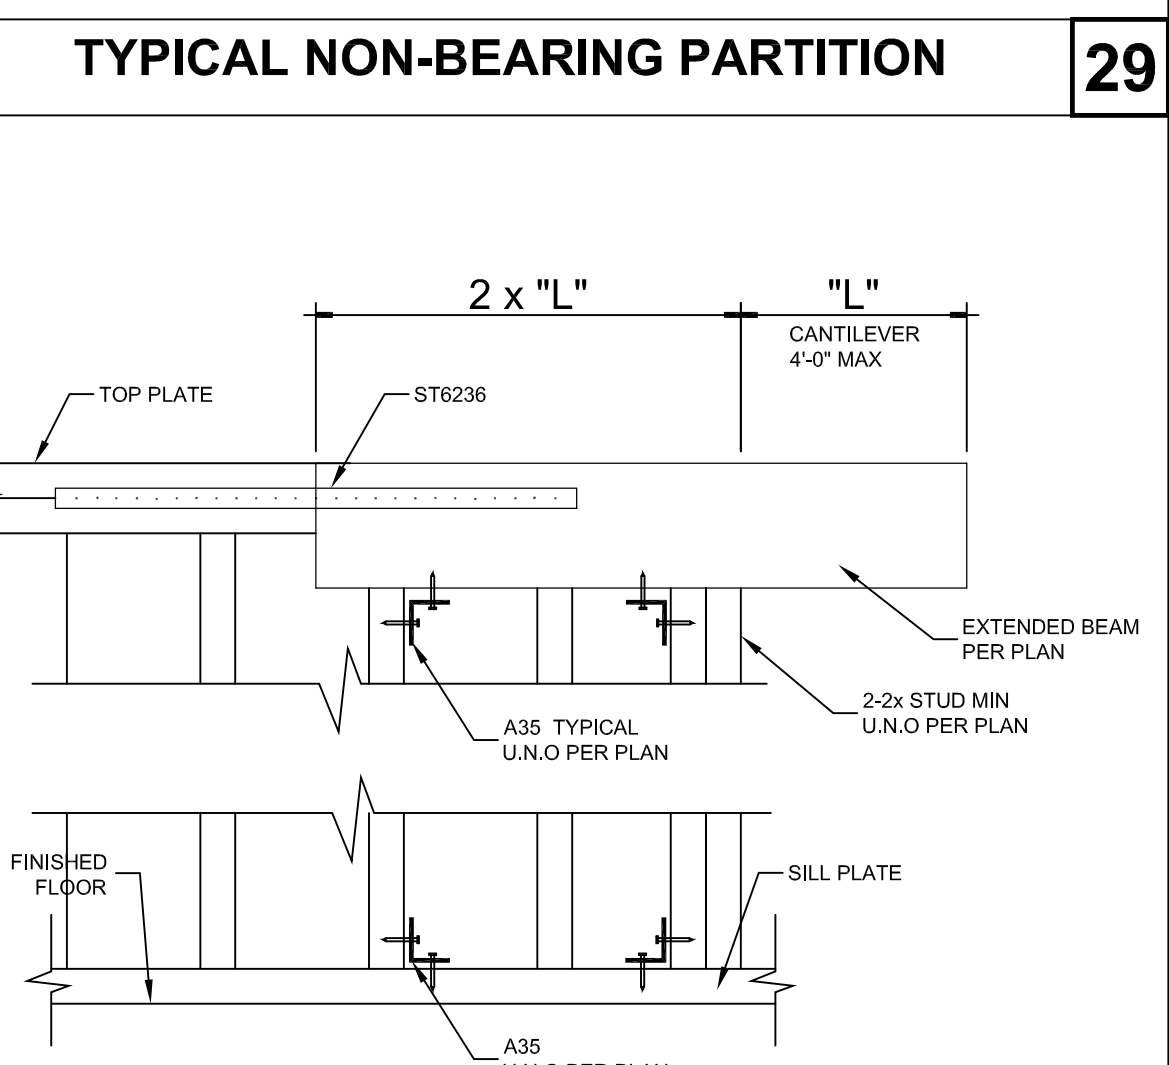


FRM059a

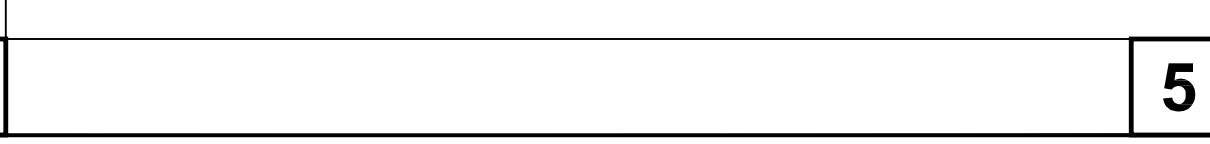


FRM08a

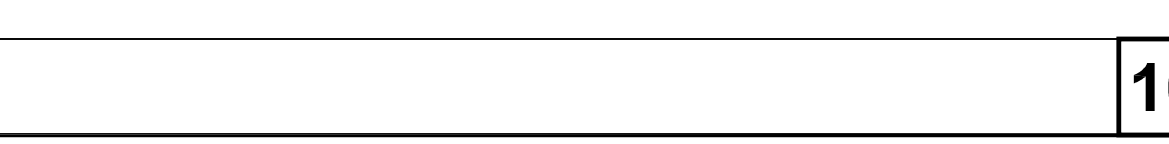


STL\_02I

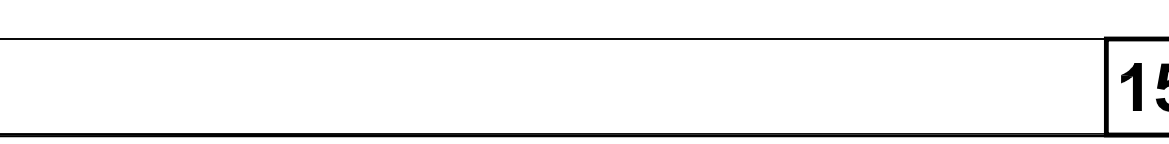

FRM20

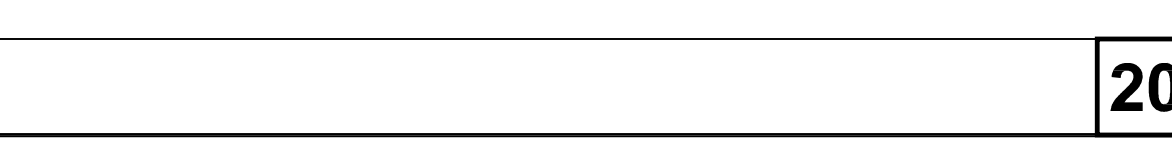

FRM05F

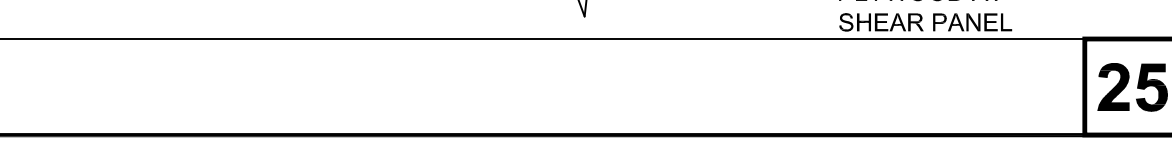

FRM13



FRM059a