

SYMBOL/ABBREV./DEFINITION		
SYMBOL	ABBREV.	DEFINITION
		DETAIL TOP - I.D. NUMBER REFERENCE BOTTOM - SHT NUMBER
	SA	SUPPLY AIR DUCT
	RA	RETURN AIR DUCT
	EA	EXHAUST AIR DUCT
	FC	FLEXIBLE CONNECTION
		INCLINED DUCT RISE
		INCLINED DUCT DROP
		ACOUSTICAL DUCT LINING
		SUPPLY AIR DIFFUSER
		RETURN AIR GRILLE
		45 DEGREE DUCT TAP IN WITH CONICAL FITTING
	S	DOOR LOUVER
	T-STAT	SENSOR
	T-STAT	THERMOSTAT
	T-STAT	EXISTING THERMOSTAT
	T-STAT	RELOCATED THERMOSTAT
	TC	TIME CLOCK
	SD	DUCT SMOKE DETECTOR
		EQUIPMENT SHOWN HATCH IS TO BE REMOVED
		INDICATES CONTROL WIRING
		SUPPLY DUCT THRU ROOF
		RETURN DUCT THRU ROOF
		EXHAUST AIR DUCT THRU ROOF
		SIDEWALL DISCHARGE GRILLE
		DOOR UNDERCUT
	SF	SMOKE FIRE DAMPER
	M	MOTORIZED DAMPER
		FLEX CONNECTION
	POC	POINT OF CONNECTION
	GLV	GLOBE VALVE
	BAL VAL	BALANCING VALVE
	CV	CHECK VALVE
	STR	STRAINER
	BLV	BALL VALVE, BUTTERFLY VALVE
	UN	UNION
	GAC	GAGE COCK
		CAPPED OR PLUGGED OUTLET
	PRV	PRESSURE REDUCING VALVE
	AV	ANGLE VALVE
		PIPE DOWN
		PIPE UP
	PA	PIPE ANCHOR
		PIPE GUIDE
	FC	FLEXIBLE CONNECTION
	CHS	CHILLED WATER SUPPLY
	CHR	CHILLED WATER RETURN
	CS	CONDENSER WATER SUPPLY
	CR	CONDENSER WATER RETURN
	HWS	HEATING HOT WATER SUPPLY
	HWR	HEATING HOT WATER RETURN
	CD	CONDENSATE DRAIN
	VT	EQUIPMENT AND VALVE VENT
	A	AUTOMATIC SPRINKLERS
	IA	INSTRUMENT AIR

ABBREVIATION/DEFINITION	
ABBREV.	DEFINITION
ABV	ABOVE
AD	ACCESS DOOR
AF	ABOVE FINISHED FLOOR
AP	ACCESS PANEL
ARCH	ARCHITECT
BEL	BELOW
BLDG	BUILDING
C	COLD AIR
CFH	CUBIC FEET PER HOUR
CFM	CUBIC FEET PER MINUTE
CI	CAST IRON
CL	CEILING
CL	CENTER LINE
COMP	COMPRESSOR
CONC	CONCRETE
CONT	CONTINUATION
DET	DETAIL
DIA	DIAMETER
DN	DOWN
DR	DRAIN
DRWG	DRAWING
EL	ELEVATION
ENCL	ENCLOSURE
EMS	ENERGY MANAGEMENT SYSTEM
EXH	EXHAUST
EXIST	EXISTING
FA	FRESH AIR
FD	FIRE DAMPER
FG	FLOOR GRILLE
FIN	FINISH
FLR	FLOOR
FFP	FINS PER FOOT
FS	FLOOR SINK
GALV	GALVANIZED
GPM	GALLONS PER MINUTE
GR	GRADE
H	HOT AIR
MAV	MANUAL AIR VENT
MAX	MAXIMUM
MCC	MOTOR CONTROL CENTER
MD	MOTORIZED DAMPER
MIN	MINIMUM
MECH	MECHANICAL
NC	NORMALLY CLOSED
NO	NOT IN CONTRACT
NO	NORMALLY OPEN
OPNG	OPENING
PLBG	PLUMBING
POC	POINT OF CONNECTION
R	RELOCATE
SCR	SCREEN
SD	SMOKE DETECTOR
SF	SMOKE/FIRE DAMPER
SM	SHEET METAL
TEMP	TEMPERATURE
TYP	TYPICAL
UTR	UP THROUGH ROOF
VTR	VENT THROUGH ROOF
VD	VOLUME DAMPER

### GENERAL NOTES

- CONTRACTOR SHALL EXAMINE ALL OTHER SPECIFICATIONS, DRAWINGS AND ALL FEATURES OF BUILDING CONSTRUCTION WHICH MAY AFFECT HIS WORK AND SHALL BE GOVERNED BY THESE AND OTHER SPECIFICATIONS, INCLUDING THE GENERAL CONDITIONS AND PARTICULAR INSTRUCTIONS TO ALL BIDDERS AND SUPPLIERS.
- ALL WORK SHALL BE EXECUTED AND INSPECTED IN STRICT ACCORDANCE WITH ALL LOCAL CODES AND/OR STATE CODES, LAWS, ORDINANCES, RULES AND REGULATIONS APPLICABLE TO THIS PARTICULAR CLASS OF WORK, AND EACH CONTRACTOR SHALL INCLUDE IN HIS PRICE ALL APPLICABLE SERVICE CHARGES, FEES, PERMITS, TAXES, AND OTHER SIMILAR COSTS IN CONNECTION THEREWITH.
- PRIOR TO FABRICATION OF DUCTWORK, CONTRACTOR SHALL EXAMINE AND VERIFY ALL CONDITIONS ABOVE AND BELOW THE CEILING WHICH MAY INTERFERE WITH THE DUCT SYSTEM AND NOTIFY THE ARCHITECT OF ANY CONFLICT ENCOUNTERED. CONTRACTOR SHALL PROVIDE ALL OFFSETS, ETC. WHICH MAY BE REQUIRED, WITHOUT ADDITIONAL COST TO THE OWNER.
- ALL SHEET METAL DUCT CONSTRUCTION SHALL BE IN STRICT ACCORDANCE WITH "SMACNA" LOW OR MED PRESSURE DUCT CONSTRUCTION STANDARD.
- ALL DUCTS SHALL BE SUPPORTED WITH 1" WIDE, 16 GAUGE, GALVANIZED STEEL BANDS.
- ALL DUCT DIMENSIONS SHOWN ON PLANS ARE INTERNAL.
- CONTRACTOR SHALL COORDINATE THE LOCATION OF SUPPLY AND RETURN AIR REGISTERS, DUCTS, GRILLES AND DIFFUSERS WITH LIGHTING AND CEILING PATTERNS.
- PROVIDE LATERAL BRACING OF ALL DUCTS AND PIPES AS REQUIRED BY CODE.
- INSULATE AND SEAL ALL DUCTWORK PER CHAPTER 10 OF THE STATE MECHANICAL CODE (1-24, PART 4).
- MOUNT ALL THERMOSTATS AT 48" ABOVE FINISHED FLOOR.
- ALL BRACING OF DUCTS AND PIPING SHALL BE INSTALLED IN ACCORDANCE WITH SMACNA GUIDELINES AS APPROVED BY THE ARCHITECT.
- WHERE BRACING DETAILS ARE NOT SHOWN ON THE DRAWINGS OR IN THE GUIDELINES, THE FIELD INSTALLATION SHALL BE SUBJECT TO THE APPROVAL OF THE ARCHITECT AND THE MECHANICAL ENGINEER.
- A COPY OF THE GUIDELINES PUBLISHED BY "SMACNA" AND APPROVED BY ARCHITECT SHALL BE PROVIDED BY THE CONTRACTOR AND KEPT ON THE JOB AT ALL TIMES.
- ALL PLUMBING VENTS, EXHAUST EQUIPMENT SHALL BE A MIN. OF 10 FT. FROM ANY AIR INTAKE VENT.
- ALL MECHANICAL EQUIPMENT SHALL BE SECURELY FASTENED IN PLACE.
- ALL DUCT DETECTORS SHALL BE MAGNETICALLY TESTED TO THE MANUFACTURER'S SPECIFICATION IN THE PRESENCE OF THE CITY OF SANTA CLARITA BUILDING INSPECTOR PRIOR TO THE FINAL APPROVAL.
- PROVIDE AIR BALANCE REPORT BY A THIRD PARTY ABC OR NEBB AIR BALANCE CONTRACTOR. INCLUDE THE COST OF MULTIPLE BALANCES IN ORDER TO ACHIEVE THE AIRFLOWS INDICATED.
- PROVIDE MANUAL BALANCING DAMPERS IN ALL DUCT BRANCHES.

### SCOPE OF WORK

TENANT IMPROVEMENT IN AN EXISTING BUILDING. DEMOLISH ALL EXISTING AIR DISTRIBUTION DOWNSTREAM OF EXISTING VAV BOXES. DEMOLISH ALL (E)PNEUMATIC CONTROLS AND T-STATS. RELOCATE (E)VAV BOXES AND INSTALL NEW VAV BOXES AS SHOWN. COORDINATE WITH ELECTRICAL CONTRACTOR FOR POWER REQUIREMENTS OF ALL VAV BOXES INCLUDING LOW VOLTAGE TRANSFORMERS, CONTROLS DESIGN AND REPLACEMENT ARE NOT PART OF THIS PROJECT. ALTHOUGH DDC CONTROLS ARE NOT A PART OF THIS PROJECT, THE MECHANICAL CONTRACTOR SHALL COORDINATE WITH THE CONTROLS CONTRACTOR PERFORMING THE WORK. REQUEST THE PLANS PERTAINING TO THE CONTROLS REPLACEMENT FROM THE OWNER PRIOR TO BEGINNING WORK.

PERFORM AN INITIAL AIR TEST OF ALL AIR DISTRIBUTION SERVING THE THIRD FLOOR WHETHER SHOWN ON THE MECHANICAL PLANS OR NOT. ALL AIR AND WATER TESTING AND BALANCING SHALL BE PERFORMED BY AN NEBB OR AABC AIR BALANCE CONTRACTOR PRIOR TO PERFORMING ANY DEMOLITION AND SUBMIT REPORT TO ARCHITECT FOR RECORD. UPON COMPLETION OF THE NEW WORK, PERFORM A FINAL AIR AND WATER TEST AND BALANCE AND SUBMIT FOR REVIEW. REFERENCE THE AIR BALANCE REQUIREMENT NOTE BOX ON THIS SHEET.

### EQUIPMENT NOTE

ALL EXISTING EQUIPMENT IS MARKED "(E)" ON THESE PLANS. ANY EQUIPMENT NOT MARKED WITH "(E)" SHALL BE CONSIDERED NEW.

### FAN COIL SCHEDULE

SYMBOL	MATCHING UNIT	FC MODEL	SERVICE	CFM	S.P.	CLG. CAP. BTUH	HTG. CAP. BTUH	FAN HP	FAN FLA	UNIT FLA	MCA	MFS	VOLT	PH	FILTERS	WEIGHT	REMARKS
		FLUITSU ASU24RLX	TEL./COMM.	800	-	24,000	24,000	-	-	0.57	0.3	30	208/230	1	-	35	

### CONDENSING UNIT SCHEDULE

SYMBOL	MODEL	COOLING CAPACITY	COMPR. RLA	FAN FLA	SEER	VOLT	PHASE	MCA	MOCOP	HSPF	OPER. WEIGHT	REMARKS
	FLUITSU AOU24RLX	24,000	11.5	1.3	18	208/230	1	15.5	30	10.0	135	REFRIGERANT: R-410

### AIR TERMINAL UNITS SCHEDULE

MARK NO.	TYPE & MODEL	CFM CAP		MAX. Ps	MAX. NC AT 2" INLET S.P.		INLET DUCT SIZE		REMARKS
		MAX.	MIN.		DISCH. RADIATED	COLD	HOT		
A-1	SINGLE DUCT VARIABLE VOLUME ENVIRO-TEC SDR	150		0.25	30	30	4"		5'-0" LINED DUCT
A-2		300					5"		
A-3		400					6"		
A-4		800					8"		
A-5		1300					10"		
A-6		1800					12"		10'-0" LINED DUCT
A-7		2300					14"		
A-8		3100					16"		

NOTES: 1.) HIGH PRESSURE DUCT CONNECTION SIZE FROM HIGH PRESSURE MAIN DUCT TO AIR TERMINAL UNIT UNLESS OTHERWISE NOTED ON DWGS. PROVIDE TRANSITION IF REQUIRED TO SUIT UNIT INLET SIZE.

### FAN-POWERED - VAV AIR TERMINAL UNITS

SYMBOL:								
P.A. CFM RANGE:	105-840	105-840	165-1355	165-1355	165-1355	240-1975	240-1975	335-2750
P.A. INLET SIZE:	8"	8"	10"	10"	10"	12"	12"	14"
TERMINAL UNIT SIZE:	0806	0811	1006	1011	1018	1211	1218	1418
DOWNSTREAM S.P.:	.25	.25	.25	.25	.35	.35	.4	.4
MOTOR SIZE:	1/8	1/4	1/4	1/2	1/2	1/4	1/2	1/2
FAN CFM RANGE:	250-500	450-800	300-500	500-1100	800-1700	500-1050	800-1700	800-1800
MAX HTG. CAPACITY:	33.3	50.6	27.4	66.2	84.5	66.2	84.5	94.3
GPM:	2.0	5.0	1.0	5.0	5.0	5.0	5.0	5.0
POWER SUPPLY:	-	-	-	-	-	-	-	-
DOWNSTREAM DUCT:	5'-0" LINED					10'-0" LINED		
MANUFACTURE:	ENVIRO-TEC	ENVIRO-TEC	ENVIRO-TEC	ENVIRO-TEC	ENVIRO-TEC	ENVIRO-TEC	ENVIRO-TEC	ENVIRO-TEC
MODEL:	VFR-WC	VFR-WC	VFR-WC	VFR-WC	VFR-WC	VFR-WC	VFR-WC	VFR-WC
INLET FILTERS:	YES							

REMARKS: 1.) REHEAT CAPACITY (MBH) BASED ON 2-ROW REHEAT COILS: 180° ENH; 160° LWT; 85° EAT.  
2.) DESIGN SELECTION BASED ON PRIMARY AIR RADIATED NC LEVEL = 30 NC.  
3.) INSTALL SPRING VIBRATION ISOLATORS FOR FAN-POWERED AIR TERMINAL UNITS WITH 1/2 HORSEPOWER MOTORS AND HANDLING 1000 CFM OR GREATER VOLUME OF AIR DESIGNED BY "VIBRO" OR "MASON". INCLUDE SEISMIC RESTRAINT.

### AIR DISTRIBUTION SCHEDULE

(PRICE, MODULAR)

NECK SIZE	CFM	THROW	NECK SIZE (SQUARE) THROW (X=EXHAUST)
6 x 6	*100	A = 4 WAY	
8 x 8	*180	B = 3 WAY	
10 x 10	*300	C = 2 WAY OPP.	
12 x 12	*400	D = 2 WAY CORNER	
14 x 14	*500	E = 1 WAY	
16 x 16	*700	X = EXHAUST	
18 x 18	*950		

T-BAR CEILING, PROVIDE QUAD DAMPERS IN DUCTS OVP CEILING, PROVIDE OBD AT GRILLES COORDINATE WITH ARCHITECTURAL REFLECTED CEILING PLAN FOR CEILING TYPE. SELECT DIFFUSER MOUNTING TYPE ACCORDINGLY.

CEILING	T-BAR	T-BAR	GYPBOARD	GYPBOARD	GYPBOARD
PRICE	PDMC	PDDR	SMCD	520D	80
FACE TYPE	PR	PR	SQ	SW	EG
MOUNTING	FL	FL	S	S	S
PATTERN	ADJ	-	4W	FIX	FIX
DAMPER	VD	VD	OBD	OBD	OBD
MATERIAL	ST	ST	ST	ST	ST
FINISH	W	W	W	W	W
USE	SUPPLY	RETURN	SUPPLY	SUPPLY	EXHAUST

FACE TYPE:  
RO - ROUND  
PR - PERFORATED  
SW - SIDEWALL  
EG - EGGRATE  
MOUNTING:  
FL - FLUSH  
S - SURFACE

PATTERN:  
ADJ - ADJUSTABLE  
4W - FOUR WAY  
FIX - FIXED

DAMPERS:  
OBD - OPPOSED BLADE DAMPER  
VD - VOLUME DAMPER

FINISHES:  
W - WHITE  
MATERIAL:  
ST - STEEL

### RETURN AIR PLENUM REQUIREMENTS

WIRING - ONLY WIRING METHODS CONSISTING OF TYPE MI CABLE OR TYPE MC CABLE EMPLOYING A SMOOTH OR CORRUGATED IMPERVIOUS METAL SHEATH WITHOUT AN OVERALL NONMETALLIC COVERING, ELECTRICAL METALLIC TUBING, FLEXIBLE METALLIC TUBING, INTERMEDIATE METAL CONDUIT, OR RIGID METAL CONDUIT IS PERMITTED. FLEXIBLE METAL CONDUIT AND LIQUID TIGHT FLEXIBLE METAL CONDUIT SHALL BE PERMITTED, IN LENGTHS NOT TO EXCEED 4 FEET, TO CONNECT PHYSICALLY ADJUSTABLE EQUIPMENT AND DEVICES THAT ARE PERMITTED IN THE PLENUM (NEC 300-22B, 22C)

GAS VALVES SHALL NOT BE LOCATED IN SUCH SPACES DUE TO THE POTENTIAL TO LEAK.

COMMUNICATION CABLES - CABLES INSTALLED IN DUCTS, PLENUMS, AND OTHER SPACES USED FOR ENVIRONMENT AIR SHALL BE TYPE CMP. TYPES CMP, CMR, CMG, CM AND CMX AND COMMUNICATIONS WIRE SHALL BE INSTALLED IN ELECTRICAL METALLIC TUBING, FLEXIBLE METAL TUBING, INTERMEDIATE METAL CONDUIT, RIGID METAL CONDUIT, FLEXIBLE METAL CONDUIT, OR WHERE ACCESSIBLE SURFACE METAL RACEWAY OR WIRE WAY WITH METAL COVERS OR SOLID BOTTOM METAL CABLE TRAY WITH SOLID METAL COVERS. (CEC 800.1545A, 300-22A,B,C)

WOOD FRAMING & PLYWOOD - NOT PERMITTED TO BE EXPOSED IN THE PLENUM UNLESS RATED CLASS I. (CMC 602.2)

SUSPENDED CEILING - RATED FOR PLENUM OR A MINIMUM OF 1-HOUR RATED.

INSULATION - CLASS 1 MATERIAL ONLY. BATTS NOT PERMITTED.

LIGHTING - SHALL HAVE A METAL ENCLOSURE, OR NONMETALLIC ENCLOSURE LISTED FOR THE USE WITH ADEQUATE FIRE-RESISTANT AND LOW SMOKE-PRODUCING (CLASS 1 FLAME SPREAD) AND ASSOCIATED WIRING MATERIAL SUITABLE FOR THE AMBIENT TEMPERATURE.

DUCT MATERIALS - CLASS "0" OR "1" ONLY.

### AIR BALANCE REQUIREMENTS

PROVIDE AN INITIAL AIR TEST OF ALL EXISTING HVAC EQUIPMENT, AIR INLETS AND OUTLETS PRIOR TO ANY WORK TAKING PLACE. THIS INCLUDES ALL AREAS SERVED BY THE EXISTING AIR HANDLER AND EXHAUST SYSTEM. SUBMIT TEST TO ARCHITECT FOR REVIEW. PROVIDE FINAL AIR BALANCE AFTER CONSTRUCTION IS COMPLETE BASED ON THE DESIGN AIRFLOWS INDICATED IN THE AIRFLOW TABLE.

TESTING AND BALANCING AIR DISTRIBUTION SYSTEMS:

- OBTAIN THE SERVICES OF AN INDEPENDENT TEST AND BALANCE AGENCY THAT SPECIALIZES IN AND WHOSE BUSINESS IS LIMITED TO THE TESTING AND BALANCING OF AIR CONDITION SYSTEMS.
- THE AGENCY SELECTED SHALL BE A FULLY CERTIFIED MEMBER OF THE AABC OR NEBB. AT LEAST ONE MEMBER OF THE AGENCY SHALL BE QUALIFIED AS A CERTIFIED TEST AND BALANCE ENGINEER BY THE NATIONAL EXAMINING BOARD. ALL FINAL REPORTS SHALL BE SIGNED BY THIS CERTIFIED TEST AND BALANCE ENGINEER AND SHALL INCLUDE HIS OFFICIAL STAMP, THE NATIONAL EXAMINING BOARD. ALL FINAL REPORTS SHALL BE SIGNED BY THIS CERTIFIED TEST.
- TESTING AND BALANCING SHALL BE PERFORMED IN COMPLETE ACCORDANCE WITH AABC STANDARDS FOR FIELD MEASUREMENT AND INSTRUMENTATION. TESTING AND BALANCING SHALL BE PERFORMED ON ALL SYSTEMS.
- INSTRUMENTS USED FOR TESTING AND BALANCING OF SYSTEMS MUST HAVE BEEN CALIBRATED WITHIN PERIOD OF SIX MONTHS AND BEEN CHECKED FOR ACCURACY PRIOR TO START OF WORK.
- MEASURE MAXIMUM AIR FLOW QUANTITY OF EACH SUPPLY AIR DIFFUSER. SET BALANCING DAMPER AND LOCK INTO PLACE.

### EQUIPMENT AND MATERIALS

- ALL EQUIPMENT SHALL BE LABELED OR LISTED BY A RECOGNIZED APPROVAL AGENCY.
- FOR SUPPLY, RETURN, AND EXHAUST DUCT, MATERIALS SHALL BE GALVANIZED STEEL.
- ALL EXTERIOR REFRIGERANT PIPING INSULATION SHALL BE CLAD WITH ALUMINUM AND SECURED WITH ALUMINUM BANDS.

### GOVERNING CODES

2016 CALIFORNIA ADMINISTRATIVE CODE, TITLE 24 PART 1  
2016 CALIFORNIA BUILDING CODE, TITLE 24 PART 2  
(INCLUDES THE CALIFORNIA HISTORICAL BUILDING CODE, PART 8 AND CALIFORNIA EXISTING BUILDING CODE, PART 10)  
2016 CALIFORNIA ELECTRICAL CODE, TITLE 24 PART 3  
2016 CALIFORNIA MECHANICAL CODE, TITLE 24, PART 4  
2016 CALIFORNIA PLUMBING CODE, TITLE 24, PART 5  
2016 CALIFORNIA FIRE CODE, TITLE 24 PART 9  
2016 CALIFORNIA REFERENCED STANDARDS CODE, TITLE 24 PART 12

### SHEET INDEX

M-T24 MECHANICAL TITLE 24 FORMS  
M-0.1 MECHANICAL LEGENDS, SCHEDULES AND NOTES  
M-1.0 MECHANICAL THIRD FLOOR DEMOLITION PLAN - NORTH WING  
M-1.1 MECHANICAL THIRD FLOOR DEMOLITION PLAN - SOUTH WING  
M-2.0 MECHANICAL THIRD FLOOR PLAN - NORTH WING  
M-2.1 MECHANICAL THIRD FLOOR PLAN - SOUTH WING  
M-2.2 MECHANICAL ROOF PLAN - NORTH WING  
M-2.3 MECHANICAL ROOF PLAN - SOUTH WING  
M-3.0 MECHANICAL DETAILS

### GREEN BUILDING CODE

- ALL DUCT AND OTHER RELATED AIR DISTRIBUTION COMPONENT OPENINGS SHALL BE COVERED WITH TAPE, PLASTIC, OR SHEETMETAL UNTIL THE FINAL STARTUP OF THE HEATING AND COOLING EQUIPMENT. (504.3)
- ADHESIVES, CAULKS, AND SEALANTS SHALL COMPLY WITH VOLATILE ORGANIC COMPOUND (VOC) LIMITS LISTED IN TABLES 504.4.1-504.4.3 (504.4)
- IN MECHANICALLY VENTILATED BUILDINGS, PROVIDE REGULARLY OCCUPIED AREAS OF THE BUILDING WITH CLEARLY LABELED AIR FILTRATION MEDIA FOR OUTSIDE AND RETURN AIR PRIOR TO OCCUPANCY THAT PROVIDES AT LEAST A MINIMUM EFFICIENCY REPORTING VALUE (MERV) OF 8. (5.504.5.3)
- FOR TESTING, BALANCING, AND REPORTING, REFER TO AIR BALANCE REQUIREMENTS NOTE BOX THIS SHEET.
- ALL INSTALLED HVAC, REFRIGERATION, AND FIRE SUPPRESSION EQUIPMENT SHALL NOT CONTAIN CHLOROFLUOROCARBONS (CFCs).
- ALL INSTALLED HVAC, REFRIGERATION, AND FIRE SUPPRESSION EQUIPMENT SHALL NOT CONTAIN HALONS.
- PROVIDE TEMPORARY VENTILATION DURING CONSTRUCTION IN ACCORDANCE WITH SECTION 120.1 OF THE CALIFORNIA ENERGY CODE CCR TITLE 24 PART 6 AND CHAPTER 4 OF CCR TITLE 8, AND AS FOLLOWS:
  - VENTILATION DURING CONSTRUCTION SHALL BE ACHIEVED THROUGH OPENINGS IN THE BUILDING SHELL USING FANS TO PRODUCE A MINIMUM OF THREE AIR CHANGES PER HOUR.
  - IF THE BUILDING IS OCCUPIED DURING DEMOLITION OR CONSTRUCTION, MEET OR EXCEED THE RECOMMENDED CONTROL MEASURES OF THE SHEET METAL AND AIR CONDITIONING NATIONAL CONTRACTORS ASSOCIATION (SMACNA) IAQ GUIDELINES FOR OCCUPIED BUILDINGS UNDER CONSTRUCTION, 1995, CHAPTER 3.
- PROVIDE THE BUILDING OWNER WITH DETAILED OPERATING AND MAINTENANCE INSTRUCTIONS AND COPIES OF WARRANTIES/WARRANTIES FOR EACH SYSTEM PRIOR TO FINAL INSPECTION. INCLUDE A COPY OF ALL INSPECTION VERIFICATIONS AND REPORTS REQUIRED BY THE ENFORCING AGENCY.




EXISTING VAV BOX SCHEDULE				
MARK NO.	MAKE	MODEL	INLET DUCT SIZE	REMARKS:
(A)	ENVIRO-TECH	VFRWC	8"	
(B)	ENVIRO-TECH	VFRWC	10"	
(C)	ENVIRO-TECH	VFRWC	12"	
(D)	ENVIRO-TECH	SDR	8"	
(E)	ENVIRO-TECH	SDR	10"	
(F)	ENVIRO-TECH	SDR	12"	
(G)	ENVIRO-TECH	SDR	14"	

EXISTING VAV BOX SCHEDULE(CONT.)				
MARK NO.	MAKE	MODEL	INLET DUCT SIZE	REMARKS:
(H)	ENVIRO-TECH	SDR	6"	
(I)	PRICE	SPV	6"	
(J)	PRICE	SPV	8"	
(K)	PRICE	FPV	12"	

NOTES:  
 DASHED LINES REPRESENT EXISTING DUCTS, EQUIPMENT, ETC.  
 "LIGHT TEXT" PERTAINS TO EXISTING DUCTS AND EQUIPMENT  
 "HEAVY TEXT" PERTAINS TO NEW DUCTS AND EQUIPMENT  
 CROSSHATCHED AREAS INDICATED "NIC" NO MECHANICAL WORK REQUIRED.


**DEMOLITION NOTES**

- DISCONNECT (E)HWS&R AND MEDIUM PRESSURE DUCTWORK. RELOCATE TO SERVE ZONE #3. SEE SHEET M-2.0 FOR NEW LOCATION.
- DISCONNECT (E)HWS&R AND MEDIUM PRESSURE DUCTWORK. RELOCATE TO SERVE ZONE #2. SEE SHEET M-2.0 FOR NEW LOCATION.
- DISCONNECT (E)HWS&R AND MEDIUM PRESSURE DUCTWORK. RELOCATE TO SERVE ZONE #4. SEE SHEET M-2.0 FOR NEW LOCATION.
- DEMOLISH EXISTING THERMOSTATS AND REPLACE WITH NEW. SEE SHEET M-2.0 FOR NEW LOCATION.
- DEMOLISH EXISTING PARTIAL DUCTWORK TO ALLOW FOR INSTALLATION OF COMBINATION SMOKE-FIRE DAMPER. SEE SHEET M-2.0 FOR LOCATIONS.
- DISCONNECT (E)HWS&R AND MEDIUM PRESSURE DUCTWORK. RELOCATE TO SERVE ZONE #11. SEE SHEET M-2.0 FOR NEW LOCATION.
- DEMOLISH EXISTING VAV ZONE AND ALL ASSOCIATED HWS&R PIPING. LOW PRESSURE DUCTWORK, DIFFUSERS, ETC.
- DISCONNECT (E)HWS&R AND MEDIUM PRESSURE DUCTWORK. RELOCATE TO SERVE ZONE #12. SEE SHEET M-2.0 FOR NEW LOCATION.
- RELOCATED (E)VAV BOX SLIGHTLY EAST TO CENTER WITH NEW OFFICE LAYOUT. SEE SHEET M-2.0 FOR NEW LOCATION.
- DISCONNECT (E)HWS&R AND MEDIUM PRESSURE DUCTWORK. RELOCATE TO SERVE ZONE #4. SEE SHEET M-2.0 FOR NEW LOCATION.
- DISCONNECT (E)HWS&R AND MEDIUM PRESSURE DUCTWORK. RELOCATE TO SERVE ZONE #23. SEE SHEET M-2.0 FOR NEW LOCATION.
- DISCONNECT (E)HWS&R AND MEDIUM PRESSURE DUCTWORK. RELOCATE TO SERVE ZONE #24. SEE SHEET M-2.0 FOR NEW LOCATION.
- DISCONNECT (E)HWS&R AND MEDIUM PRESSURE DUCTWORK. RELOCATE TO SERVE ZONE #16. SEE SHEET M-2.0 FOR NEW LOCATION.
- DISCONNECT (E)HWS&R AND MEDIUM PRESSURE DUCTWORK. RELOCATE TO SERVE ZONE #15. SEE SHEET M-2.0 FOR NEW LOCATION.
- DISCONNECT (E)HWS&R AND MEDIUM PRESSURE DUCTWORK. RELOCATE TO SERVE ZONE #20. SEE SHEET M-2.0 FOR NEW LOCATION.
- RELOCATED (E)VAV BOX SLIGHTLY TO THE EAST. SEE SHEET M-2.0 FOR NEW LOCATION.
- DISCONNECT (E)HWS&R AND MEDIUM PRESSURE DUCTWORK. RELOCATE TO SERVE ZONE #20. SEE SHEET M-2.0 FOR NEW LOCATION.
- RELOCATED (E)VAV BOX SLIGHTLY TO THE WEST. SEE SHEET M-2.0 FOR NEW LOCATION.
- RELOCATE (E)VAV BOX TO MAINTAIN ADEQUATE CLEARANCE IN FRONT OF CONTROLS SECTION OF BOX (2-0). SEE SHEET M-2.0 FOR NEW LOCATION.
- RELOCATE (E)VAV BOX TO DUE TO NEW FULL HEIGHT WALL BEING LOCATED AT CURRENT BOX LOCATION. SEE SHEET M-2.0 FOR NEW LOCATION.
- DEMOLISH ALL ASSOCIATED EXISTING DUCTWORK DOWNSTREAM FROM (E)SA PLENUM/ATTENUATOR OF (E)VAV BOX AND ALL (E)SA DIFFUSERS. (E)SA PLENUM/ATTENUATOR IS EXISTING TO REMAIN.

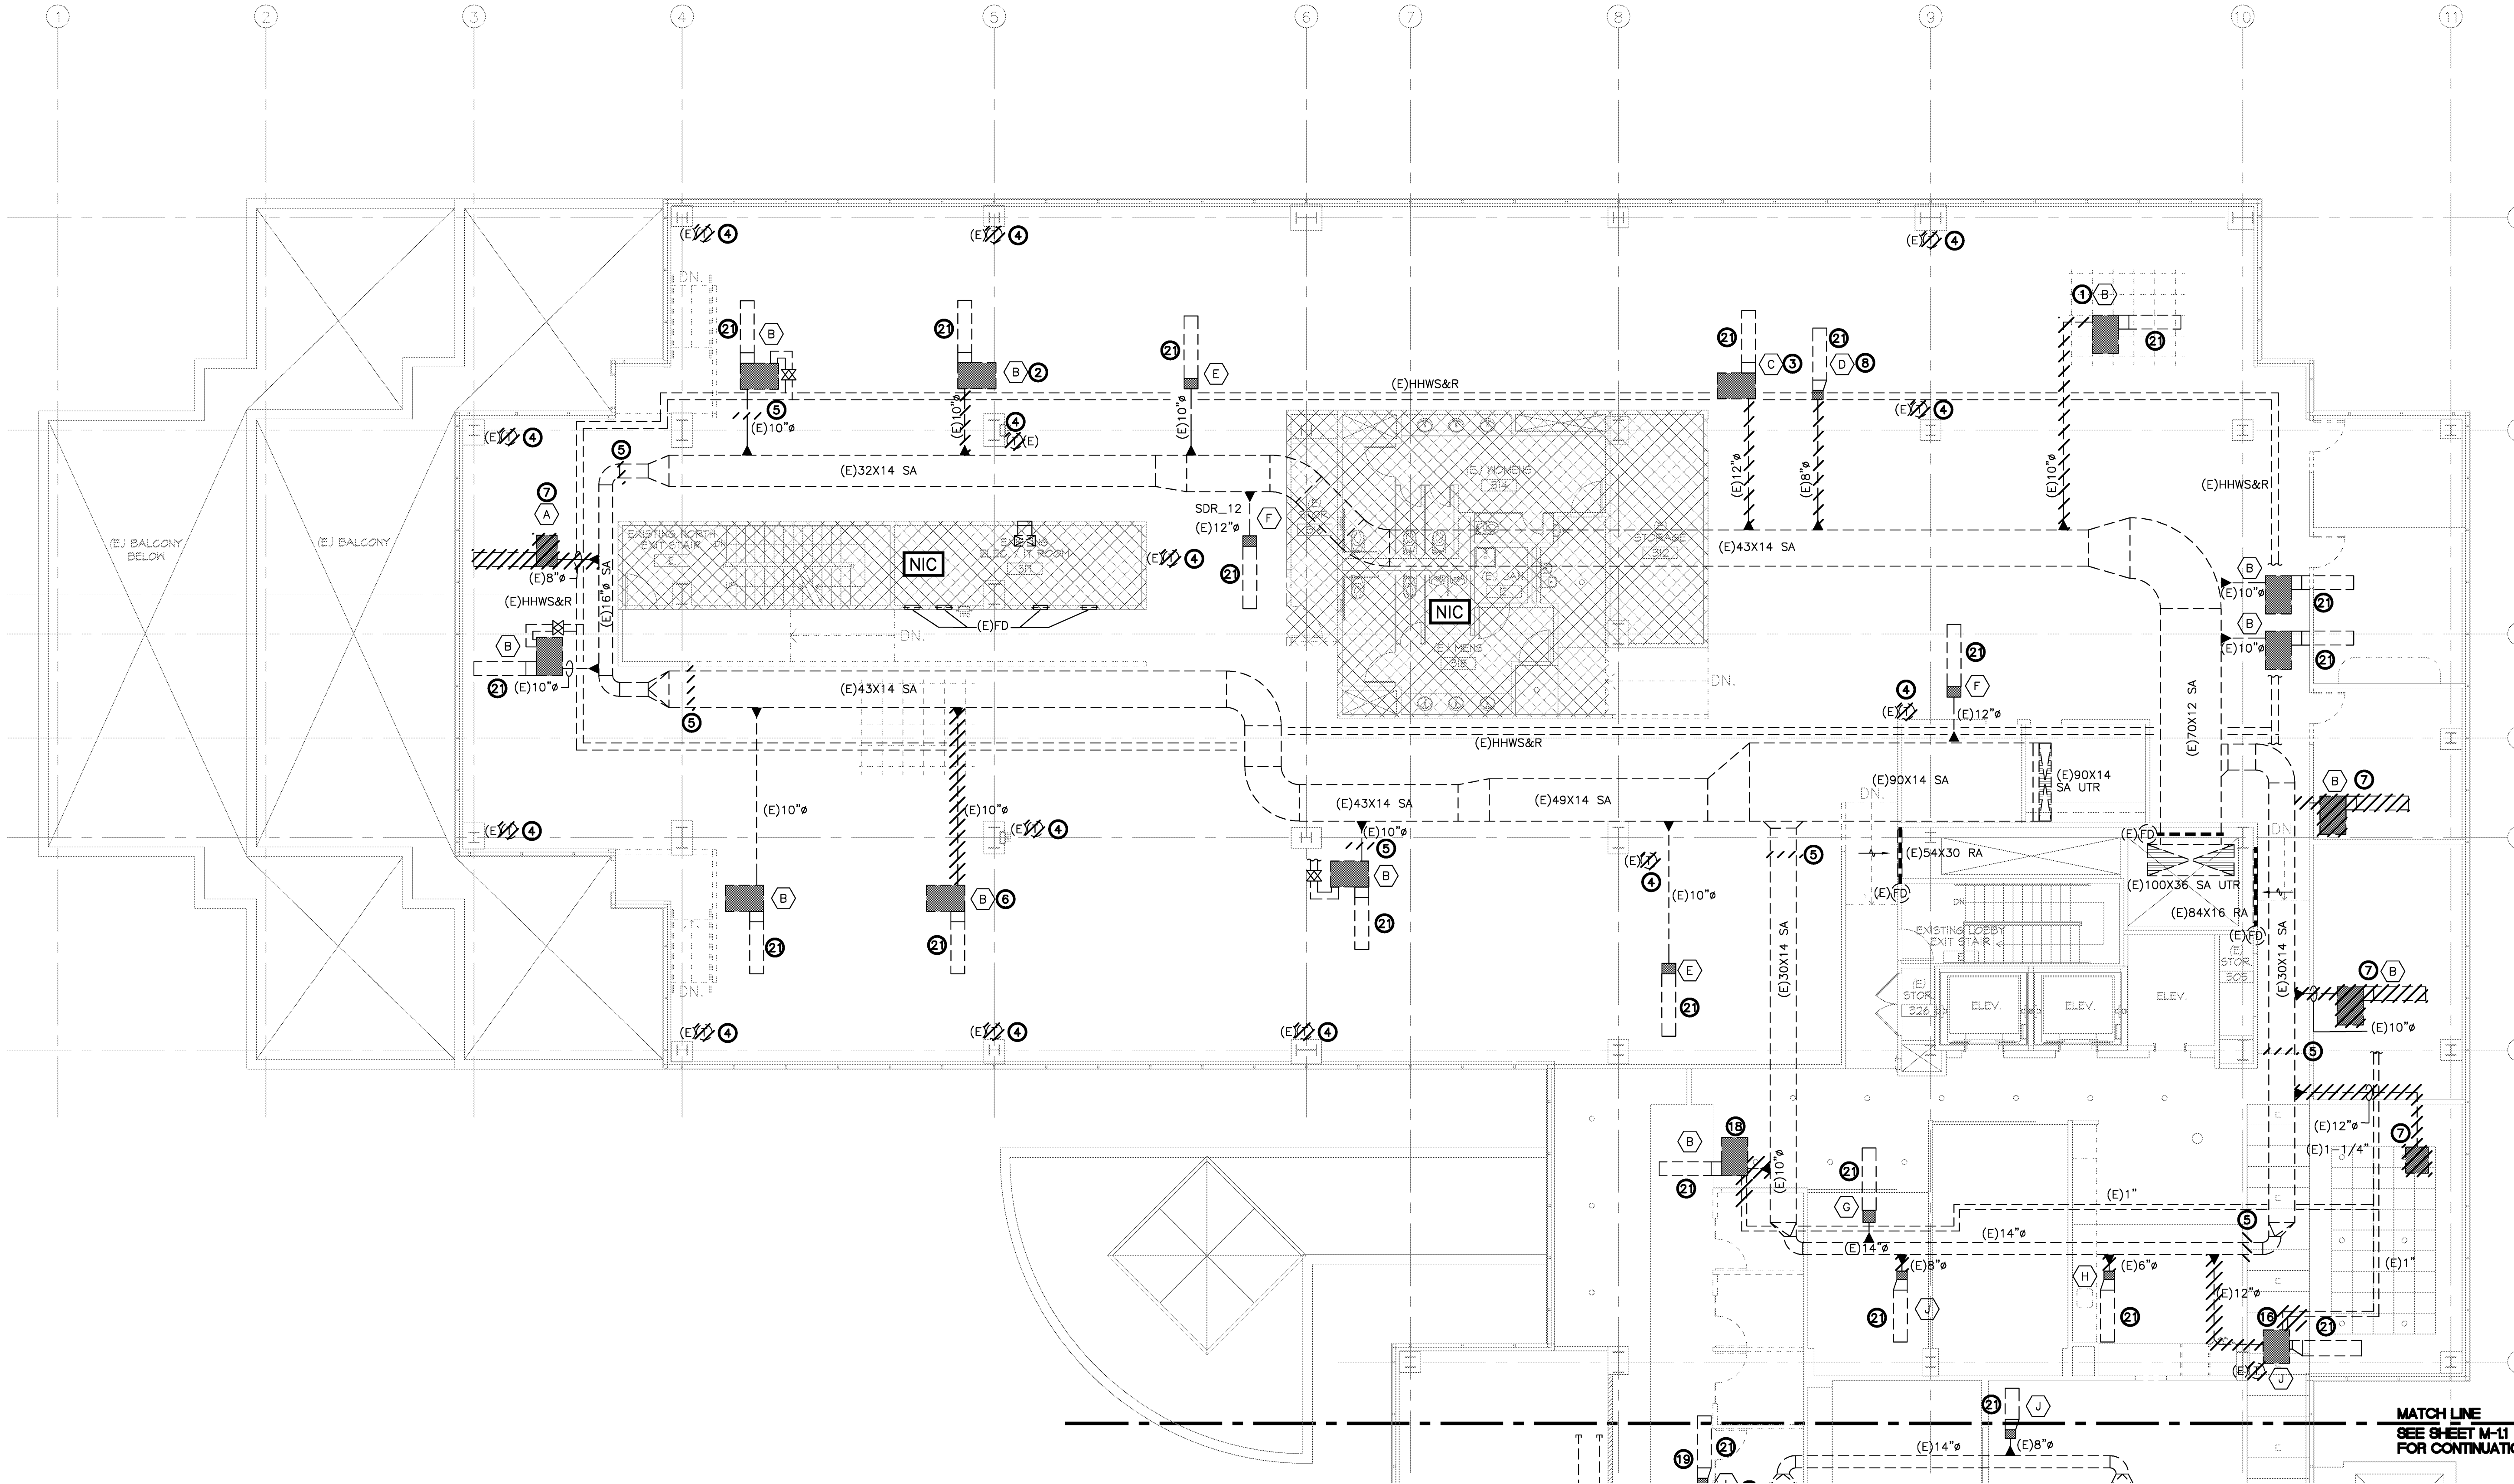

MECHANICAL THIRD FLOOR DEMOLITION PLAN - NORTH WING  
 SCALE: 1/8" = 1'-0"

MATCH LINE  
 SEE SHEET M-11  
 FOR CONTINUATION

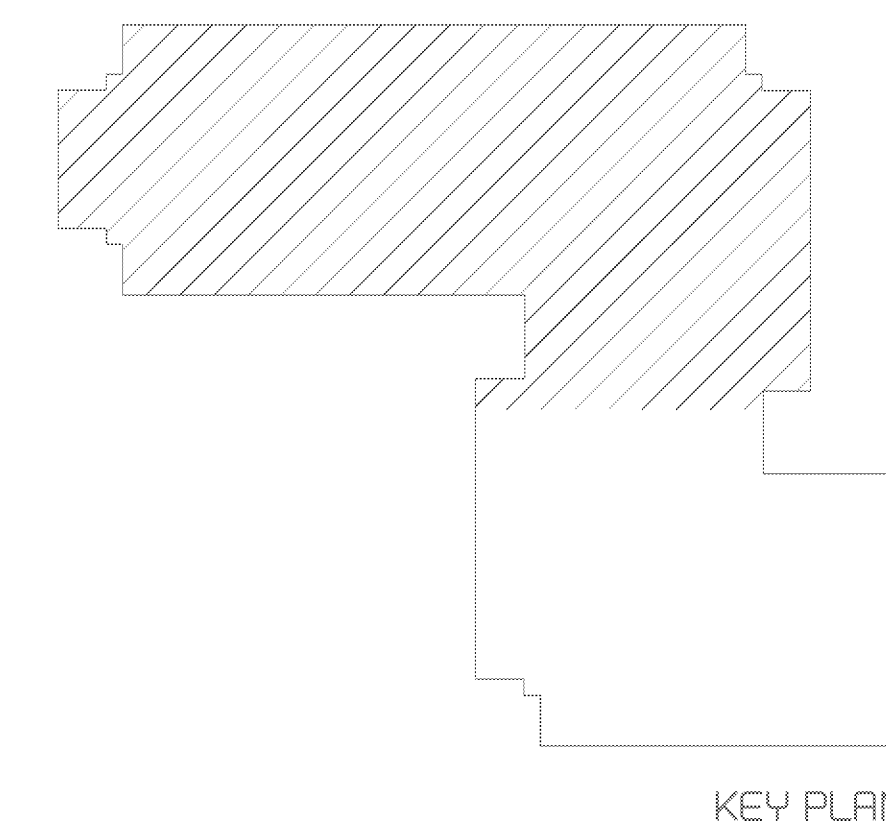

all drawings and written material appearing herein constitute the original and unaltered work of the architect and the same may not be duplicated used or disclosed without the written consent of the architect.

remarks	date
PLAN CHECK SUBMIT.	04/15/19
BID SUBMIT.	04/22/19
P.C. CORRECT/ADD-B	05/30/19


EXISTING VAV BOX SCHEDULE				
MARK NO.	MAKE	MODEL	INLET DUCT SIZE	REMARKS:
(A)	ENVIRO-TECH	VFRWC	8"	
(B)	ENVIRO-TECH	VFRWC	10"	
(C)	ENVIRO-TECH	VFRWC	12"	
(D)	ENVIRO-TECH	SDR	8"	
(E)	ENVIRO-TECH	SDR	10"	
(F)	ENVIRO-TECH	SDR	12"	
(G)	ENVIRO-TECH	SDR	14"	

EXISTING VAV BOX SCHEDULE(CONT.)				
MARK NO.	MAKE	MODEL	INLET DUCT SIZE	REMARKS:
(H)	ENVIRO-TECH	SDR	6"	
(I)	PRICE	SPV	6"	
(J)	PRICE	SPV	8"	
(K)	PRICE	FPV	12"	


NOTES:  
 DASHED LINES REPRESENT EXISTING DUCTS, EQUIPMENT, ETC.  
 "LIGHT TEXT" PERTAINS TO EXISTING DUCTS AND EQUIPMENT  
 "HEAVY TEXT" PERTAINS TO NEW DUCTS AND EQUIPMENT  
 CROSSHATCHED AREAS INDICATED "NIC" NO MECHANICAL WORK REQUIRED.

**DEMOLITION NOTES**

- DISCONNECT (E)HWS&R AND MEDIUM PRESSURE DUCTWORK. RELOCATE TO SERVE ZONE #3. SEE SHEET M-2.0 FOR NEW LOCATION.
- DISCONNECT (E)HWS&R AND MEDIUM PRESSURE DUCTWORK. RELOCATE TO SERVE ZONE #2. SEE SHEET M-2.0 FOR NEW LOCATION.
- DISCONNECT (E)HWS&R AND MEDIUM PRESSURE DUCTWORK. RELOCATE TO SERVE ZONE #4. SEE SHEET M-2.0 FOR NEW LOCATION.
- DEMOLISH EXISTING THERMOSTATS AND REPLACE WITH NEW. SEE SHEET M-2.0 FOR NEW LOCATION.
- DEMOLISH EXISTING PARTIAL DUCTWORK TO ALLOW FOR INSTALLATION OF COMBINATION SMOKE-FIRE DAMPER. SEE SHEET M-2.0 FOR LOCATIONS.
- DISCONNECT (E)HWS&R AND MEDIUM PRESSURE DUCTWORK. RELOCATE TO SERVE ZONE #11. SEE SHEET M-2.0 FOR NEW LOCATION.
- DEMOLISH EXISTING VAV ZONE AND ALL ASSOCIATED HWS&R PIPING, LOW PRESSURE DUCTWORK, DIFFUSERS, ETC.
- DISCONNECT (E)HWS&R AND MEDIUM PRESSURE DUCTWORK. RELOCATE TO SERVE ZONE #12. SEE SHEET M-2.0 FOR NEW LOCATION.
- RELOCATE (E)VAV BOX SLIGHTLY EAST TO CENTER WITH NEW OFFICE LAYOUT. SEE SHEET M-2.0 FOR NEW LOCATION.
- DISCONNECT (E)HWS&R AND MEDIUM PRESSURE DUCTWORK. RELOCATE TO SERVE ZONE #4. SEE SHEET M-2.0 FOR NEW LOCATION.
- DISCONNECT (E)HWS&R AND MEDIUM PRESSURE DUCTWORK. RELOCATE TO SERVE ZONE #23. SEE SHEET M-2.0 FOR NEW LOCATION.
- DISCONNECT (E)HWS&R AND MEDIUM PRESSURE DUCTWORK. RELOCATE TO SERVE ZONE #24. SEE SHEET M-2.0 FOR NEW LOCATION.
- DISCONNECT (E)HWS&R AND MEDIUM PRESSURE DUCTWORK. RELOCATE TO SERVE ZONE #16. SEE SHEET M-2.0 FOR NEW LOCATION.
- DISCONNECT (E)HWS&R AND MEDIUM PRESSURE DUCTWORK. RELOCATE TO SERVE ZONE #15. SEE SHEET M-2.0 FOR NEW LOCATION.
- DISCONNECT (E)HWS&R AND MEDIUM PRESSURE DUCTWORK. RELOCATE TO SERVE ZONE #21. SEE SHEET M-2.0 FOR NEW LOCATION.
- RELOCATED (E)VAV BOX SLIGHTLY TO THE EAST. SEE SHEET M-2.0 FOR NEW LOCATION.
- DISCONNECT (E)HWS&R AND MEDIUM PRESSURE DUCTWORK. RELOCATE TO SERVE ZONE #20. SEE SHEET M-2.0 FOR NEW LOCATION.
- RELOCATED (E)VAV BOX SLIGHTLY TO THE WEST. SEE SHEET M-2.0 FOR NEW LOCATION.
- RELOCATE (E)VAV BOX TO MAINTAIN ADEQUATE CLEARANCE IN FRONT OF CONTROLS SECTION OF BOX (2'-0"). SEE SHEET M-2.0 FOR NEW LOCATION.
- RELOCATE (E)VAV BOX TO DUE TO NEW FULL HEIGHT WALL BEING LOCATED AT CURRENT BOX LOCATION. SEE SHEET M-2.0 FOR NEW LOCATION.
- DEMOLISH ALL ASSOCIATED EXISTING DUCTWORK DOWNSTREAM FROM (E)SA PLENUM/ATTENUATOR OF (E)VAV BOX AND ALL (E)SA DIFFUSERS. (E)SA PLENUM/ATTENUATOR IS EXISTING TO REMAIN.

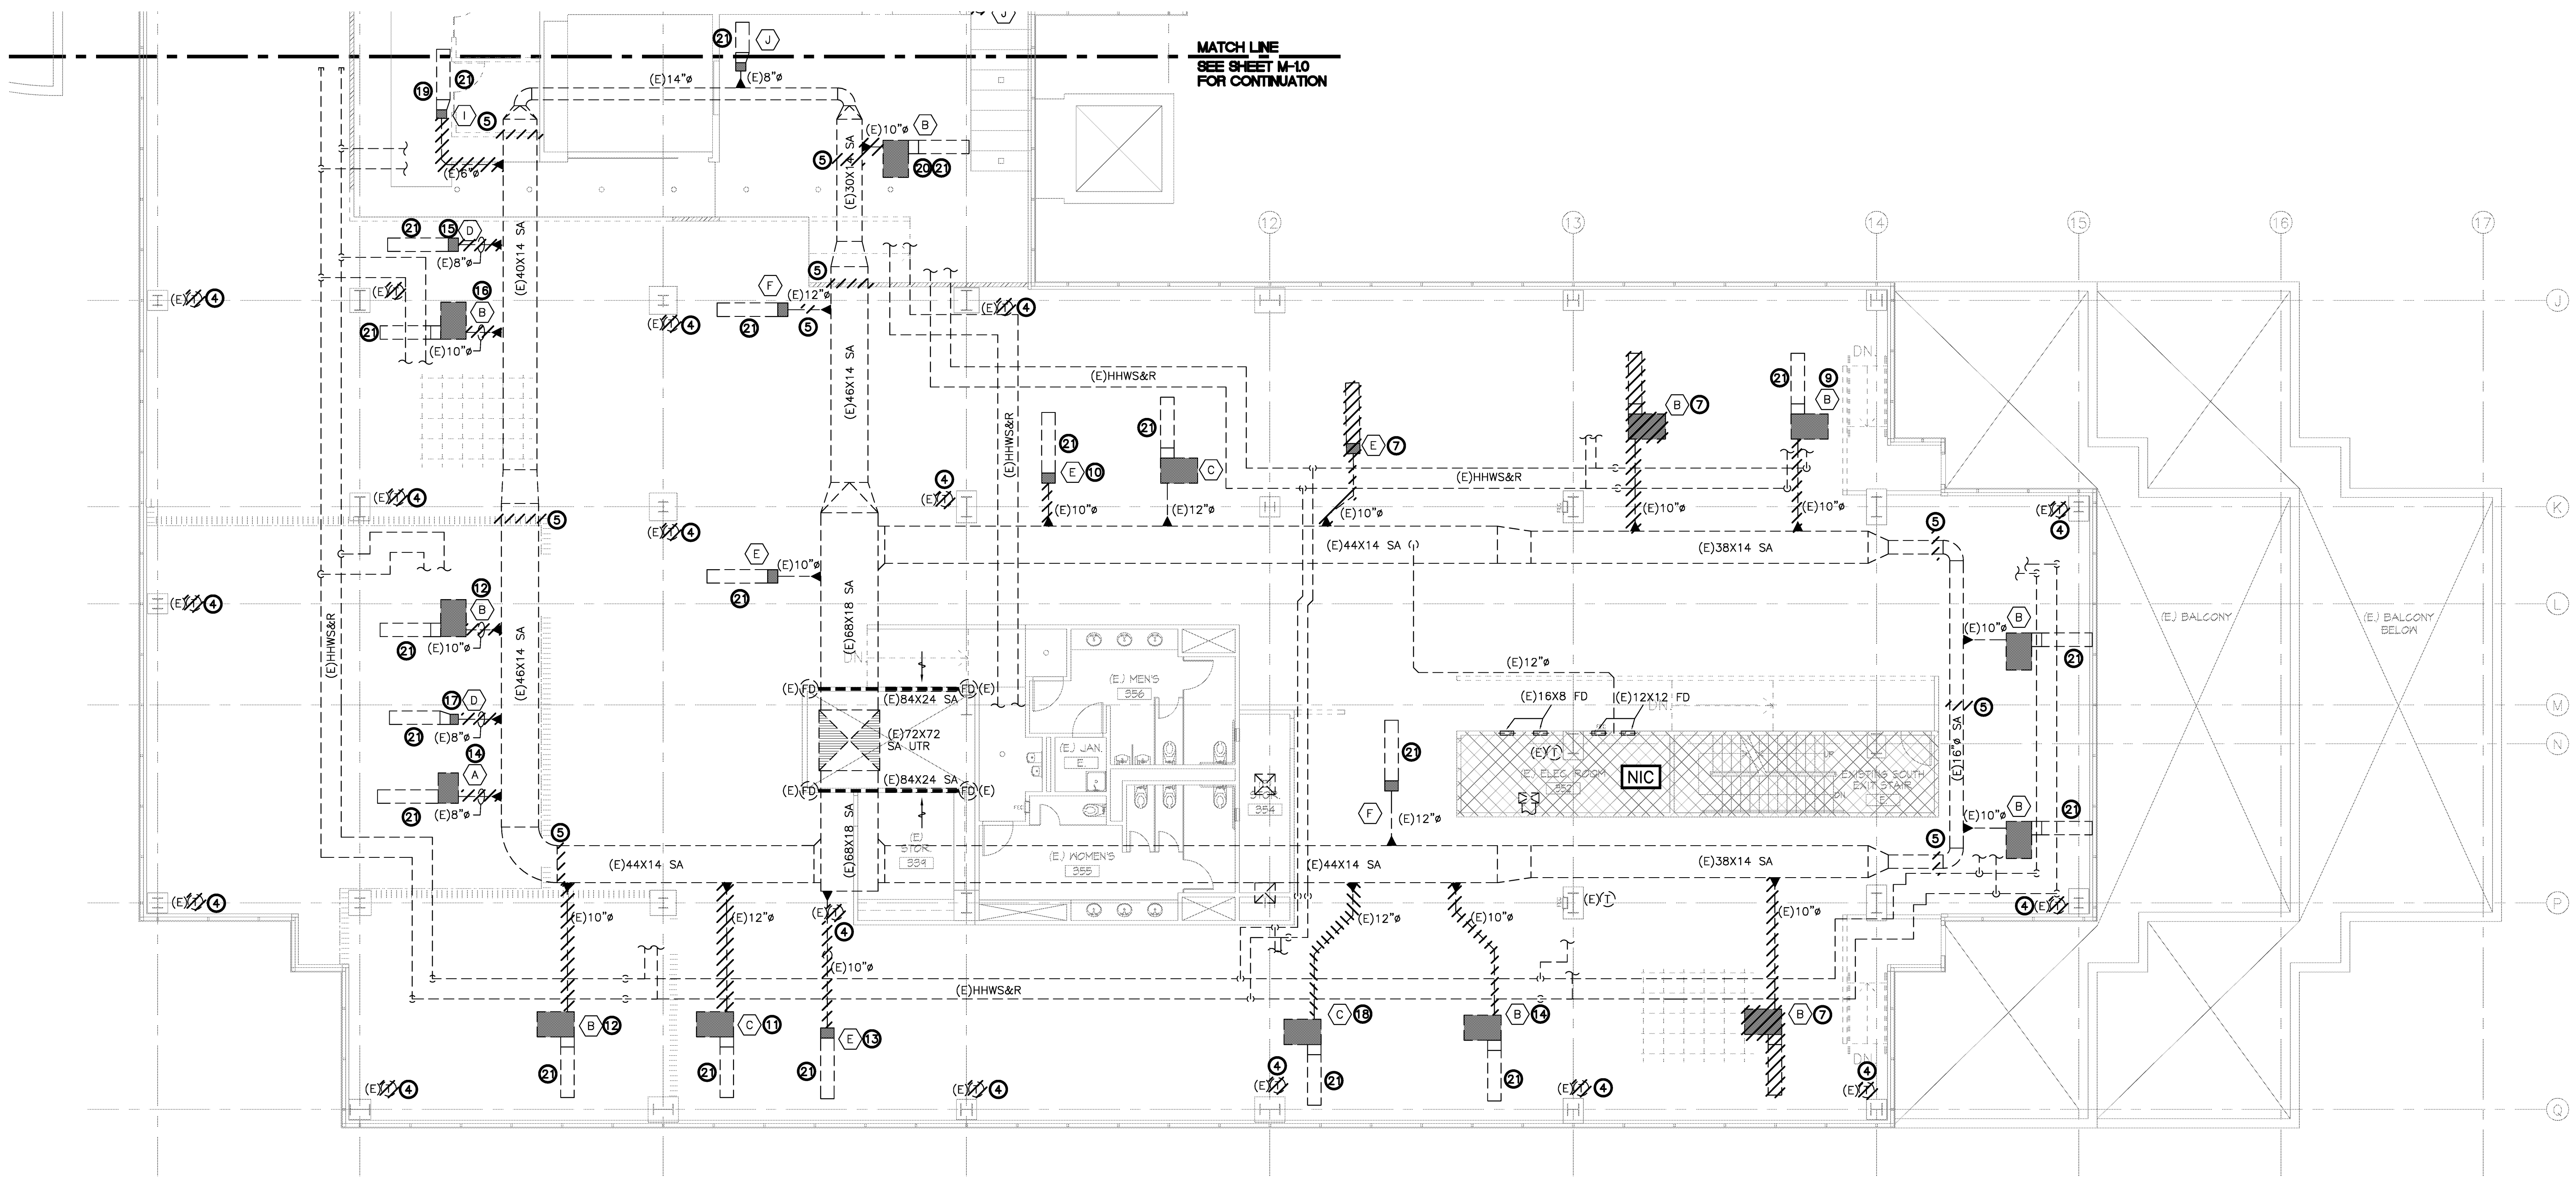

MECHANICAL THIRD FLOOR DEMOLITION PLAN - SOUTH WING  
 SCALE: 1/8" = 1'-0"

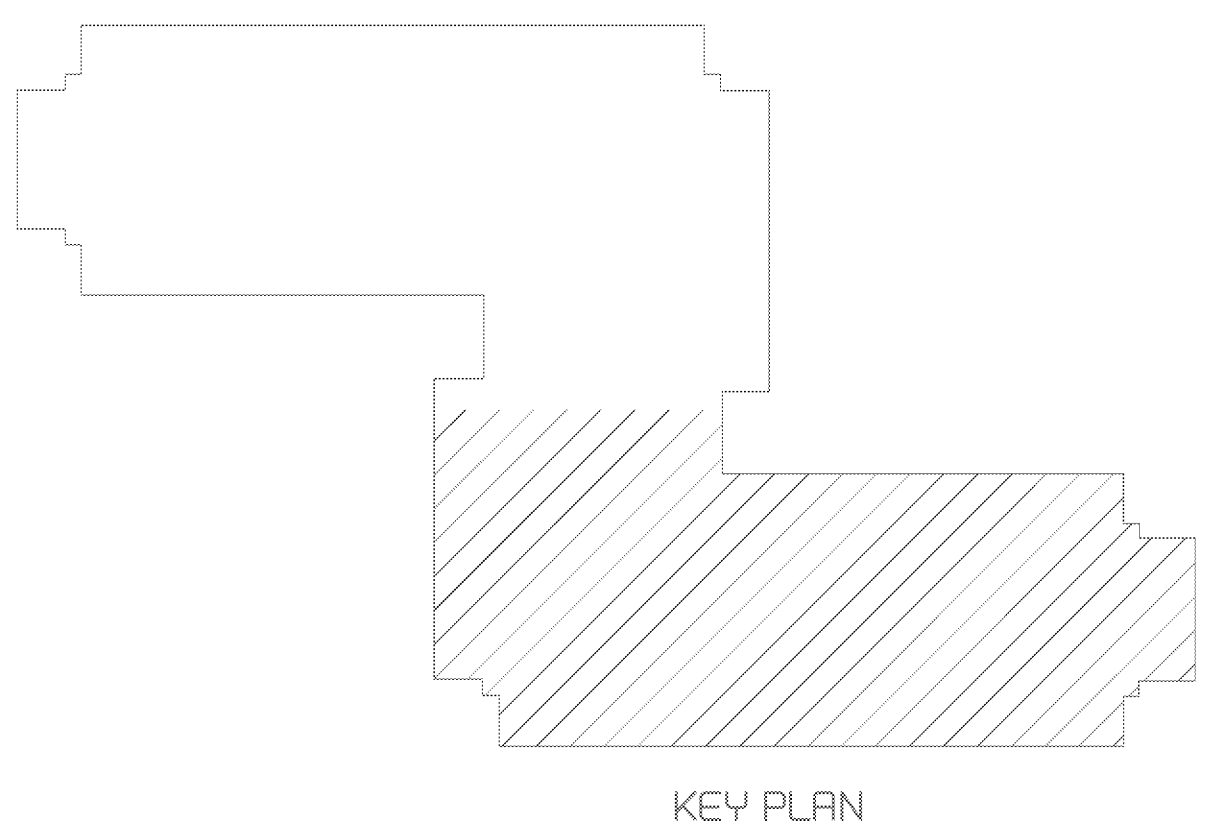


all drawings and written material appearing herein constitute the original and unaltered work of the architect and the same may not be duplicated used or disclosed without the written consent of the architect.

remarks	date
PLAN CHECK SUBMIT.	04/15/19
BID SUBMIT.	04/22/19
P.C. CORRECT/ADD-B	05/30/19




NOTES:  
 DASHED LINES REPRESENT EXISTING DUCTS, EQUIPMENT, ETC.  
 "LIGHT TEXT" PERTAINS TO EXISTING DUCTS AND EQUIPMENT  
 "HEAVY TEXT" PERTAINS TO NEW DUCTS AND EQUIPMENT  
 CROSSHATCHED AREAS INDICATED "NIC" NO MECHANICAL WORK REQUIRED.  
 SEE SHEET M1.0 & M1.1 FOR EXISTING VAV BOX SCHEDULE.

- PLAN NOTES**
- 3/8" AND 5/8" INSULATED REFRIGERANT PIPING UP FROM CU-1 ON ROOF.
  - 3/8" AND 5/8" INSULATED REFRIGERANT PIPING UP FROM CU-2 ON ROOF.

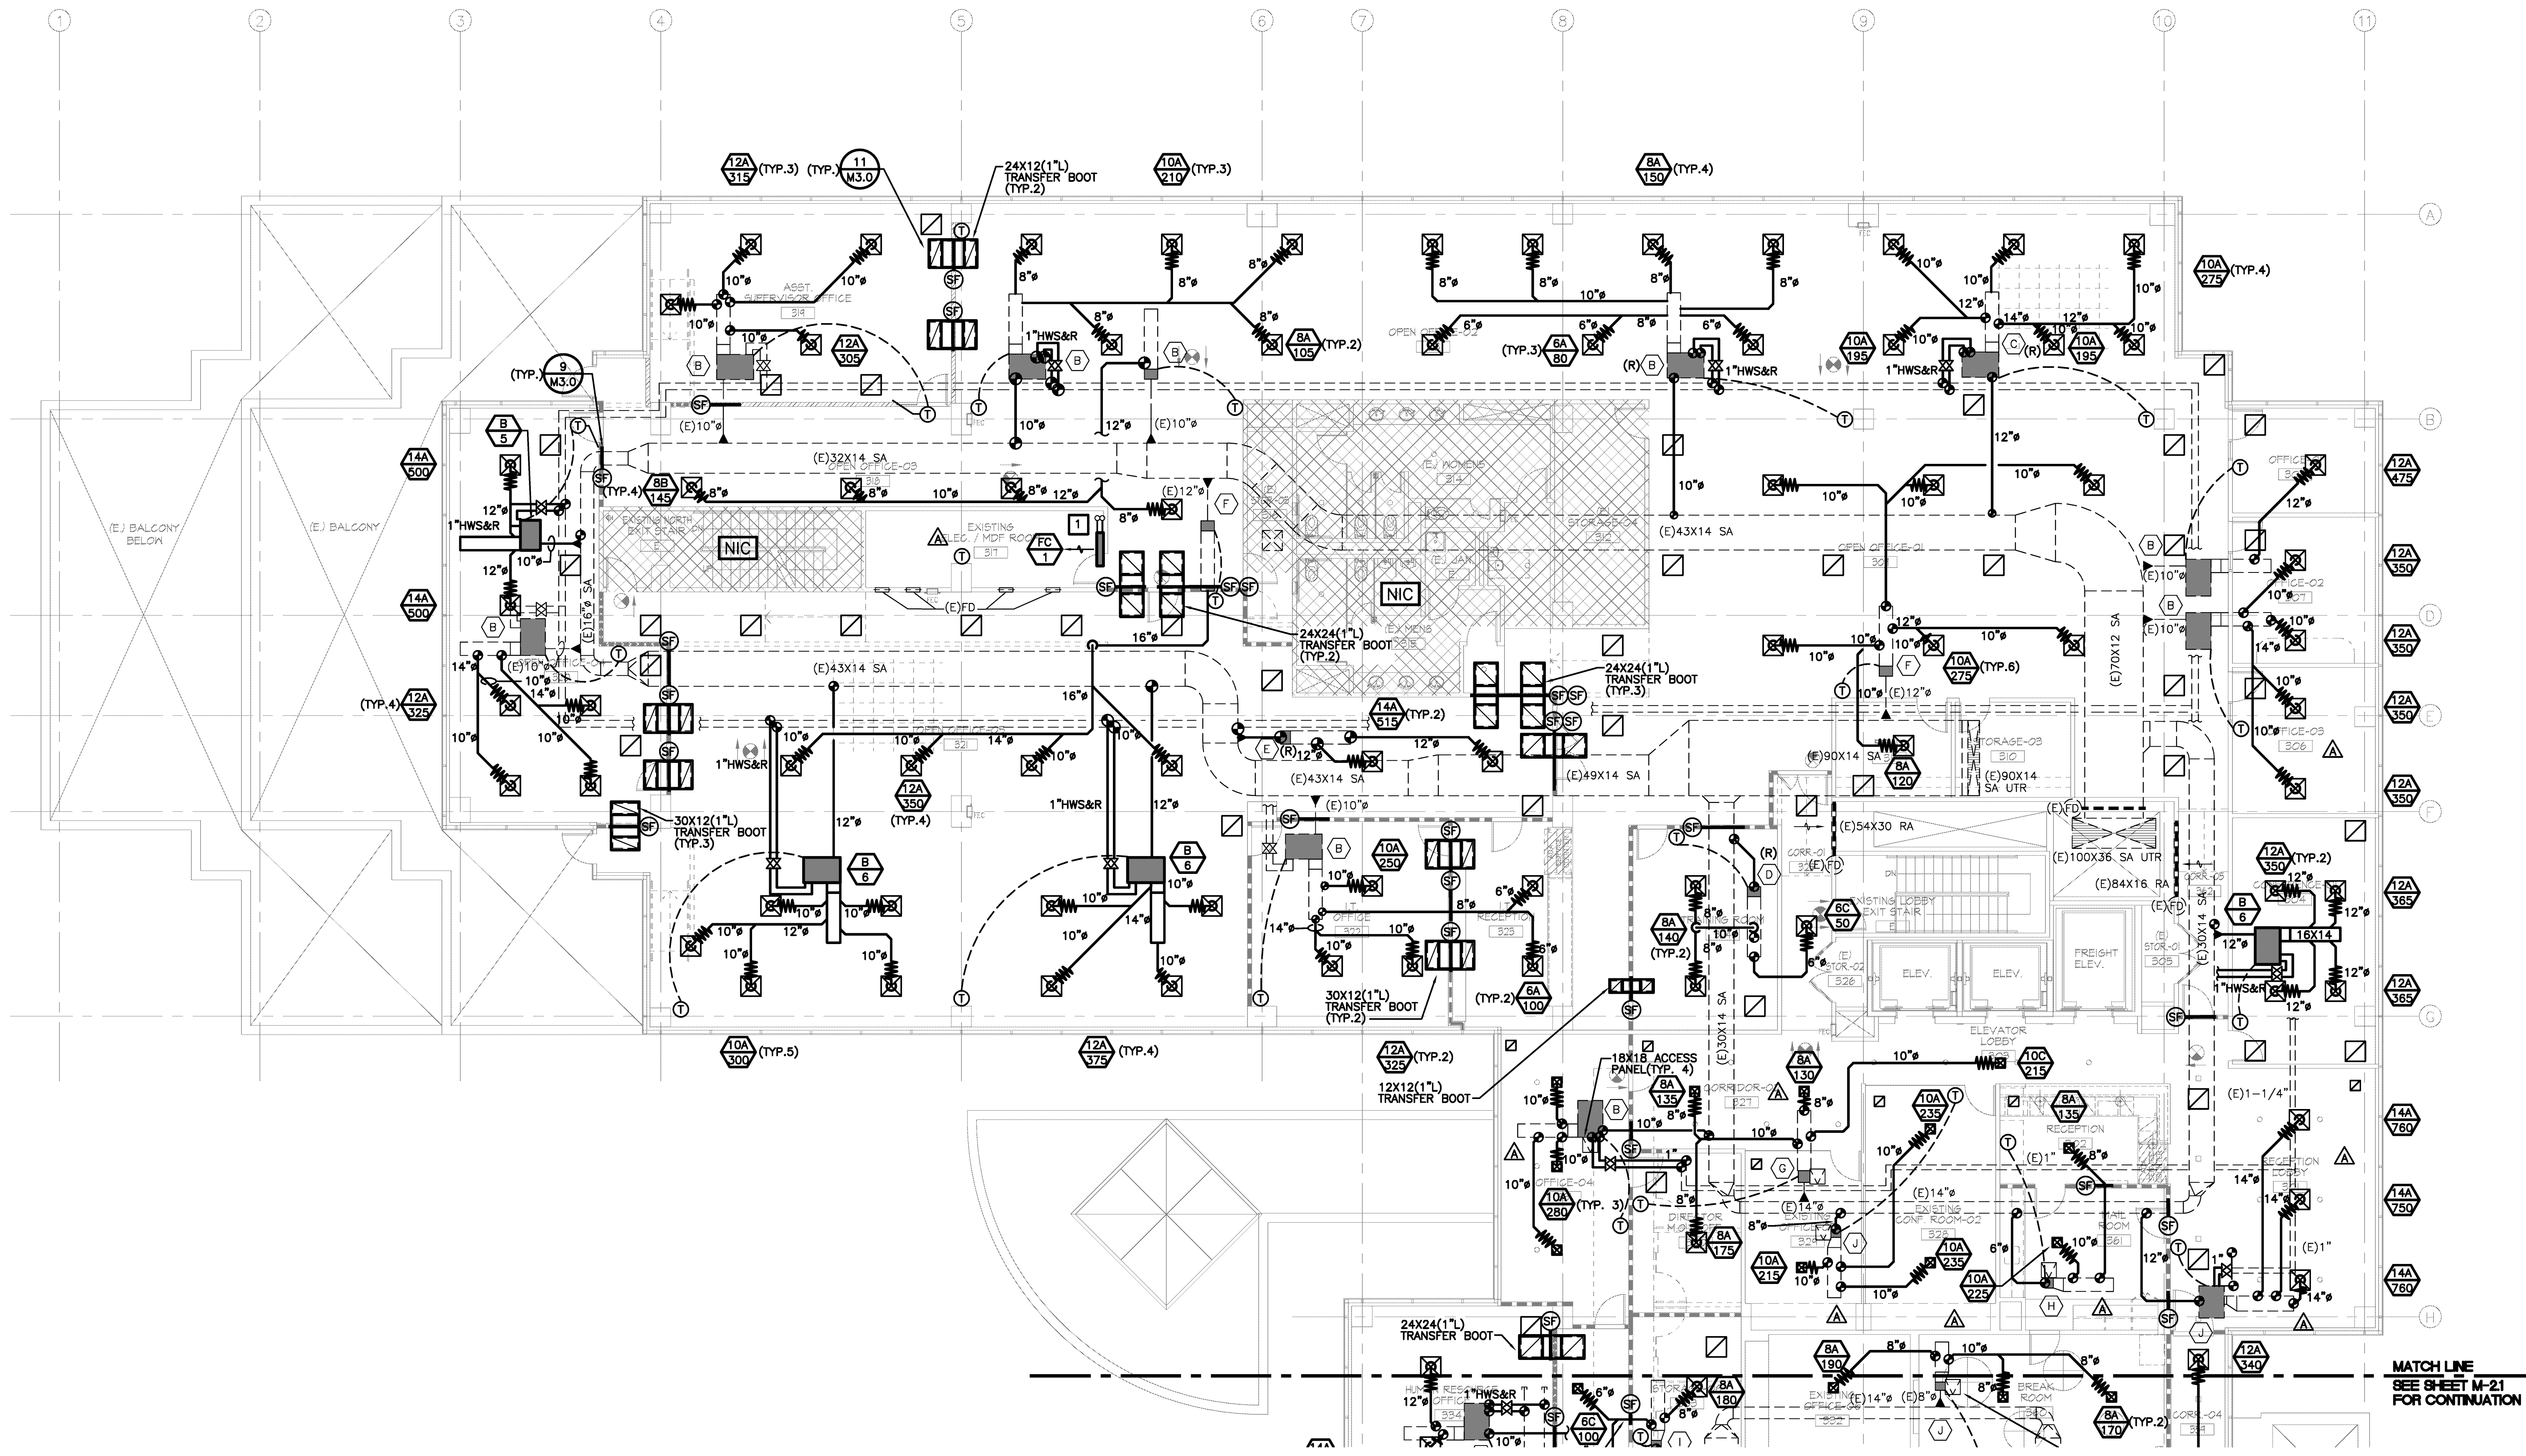

MECHANICAL THIRD FLOOR PLAN - NORTH WING  
 SCALE: 1/8" = 1'-0"

MATCH LINE  
 SEE SHEET M-21  
 FOR CONTINUATION

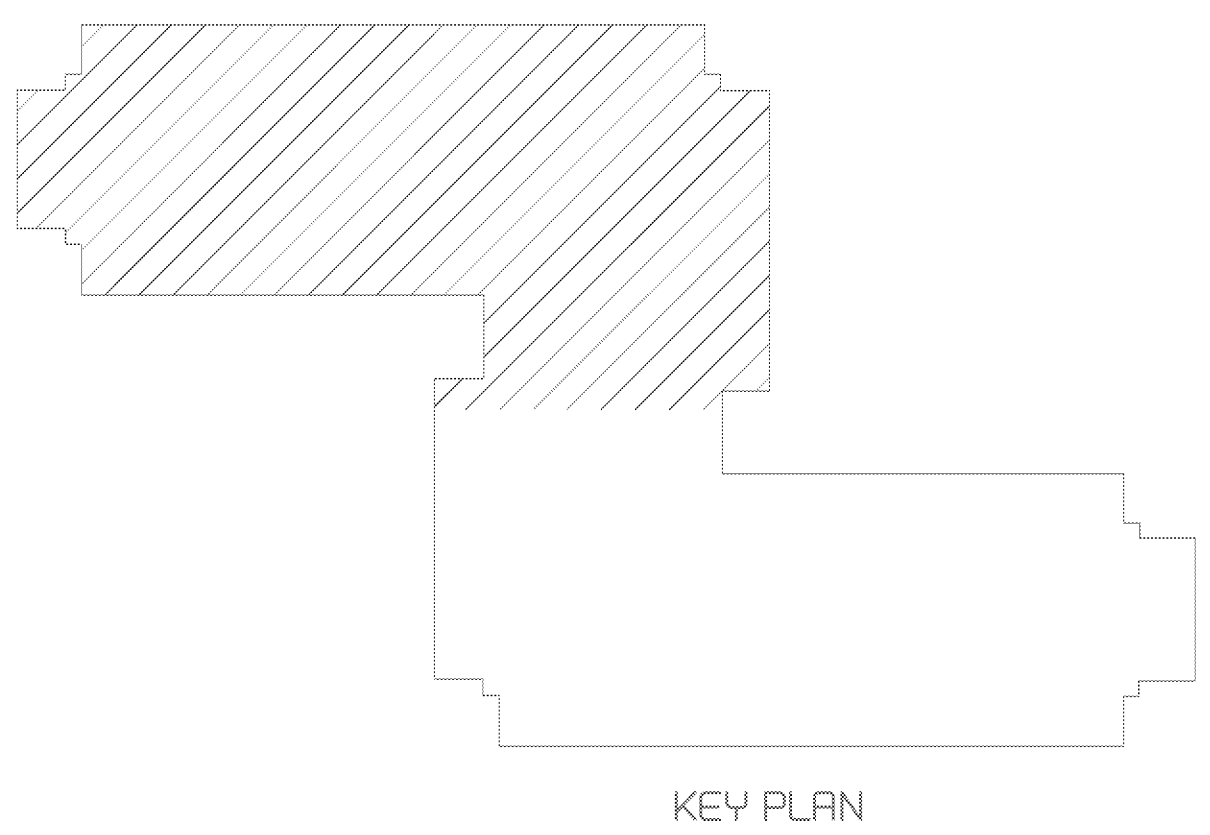

KEY PLAN

all drawings and written material appearing herein constitute the original and unaltered work of the architect and the same may not be duplicated used or disclosed without the written consent of the architect.

△	remarks	date
	PLAN CHECK SUBMIT.	04/15/19
	BID SUBMIT.	04/22/19
▲	ISSUED FOR BID/ADD-R	04/30/19
	P.C. CORRECT/ADD-B	05/30/19

sheet title

MECHANICAL  
 THIRD FLOOR PLAN-  
 NORTH WING

drawn by: CM  
 project no: 43028  
 date: 06/18/19  
 scale: AS SHOWN

m2.0












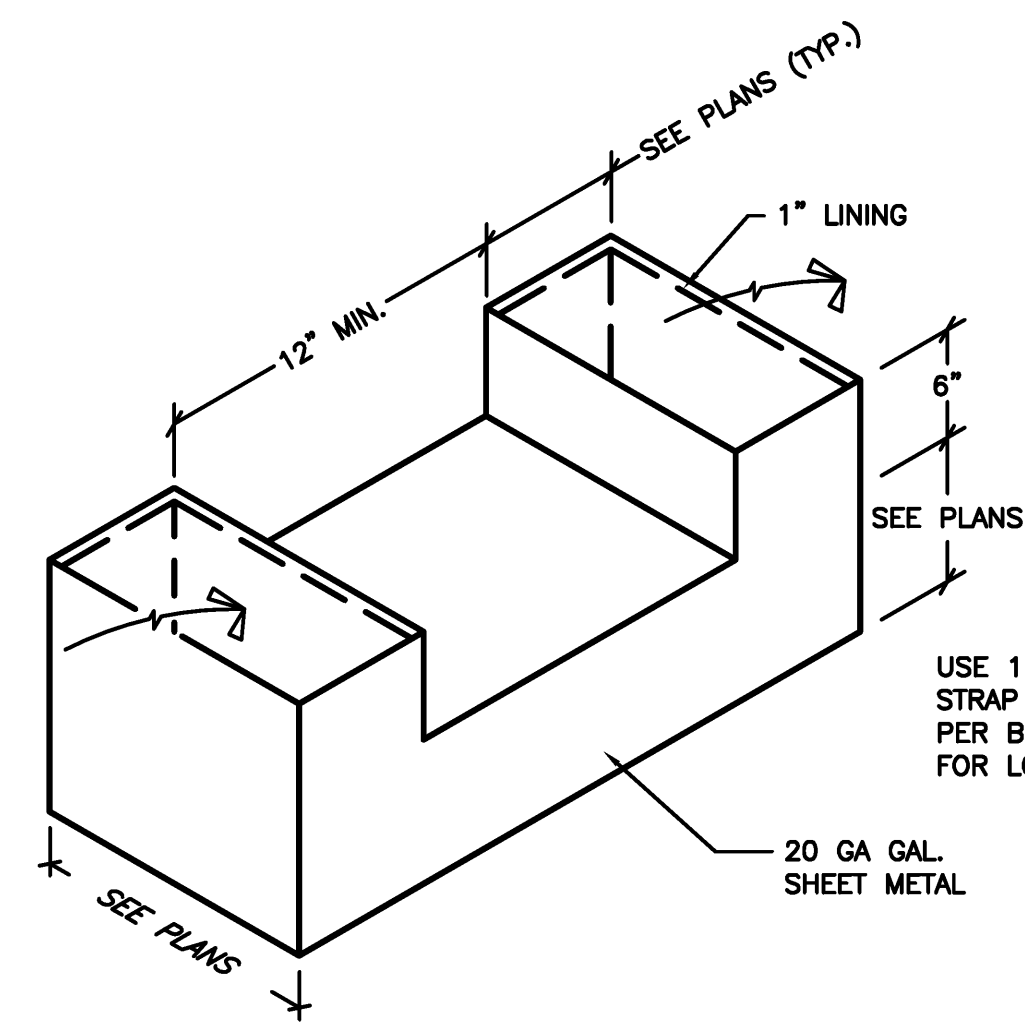


NONE

SCALE: NONE  
15


TRANSFER BOOT DETAIL

SCALE: NONE  
11

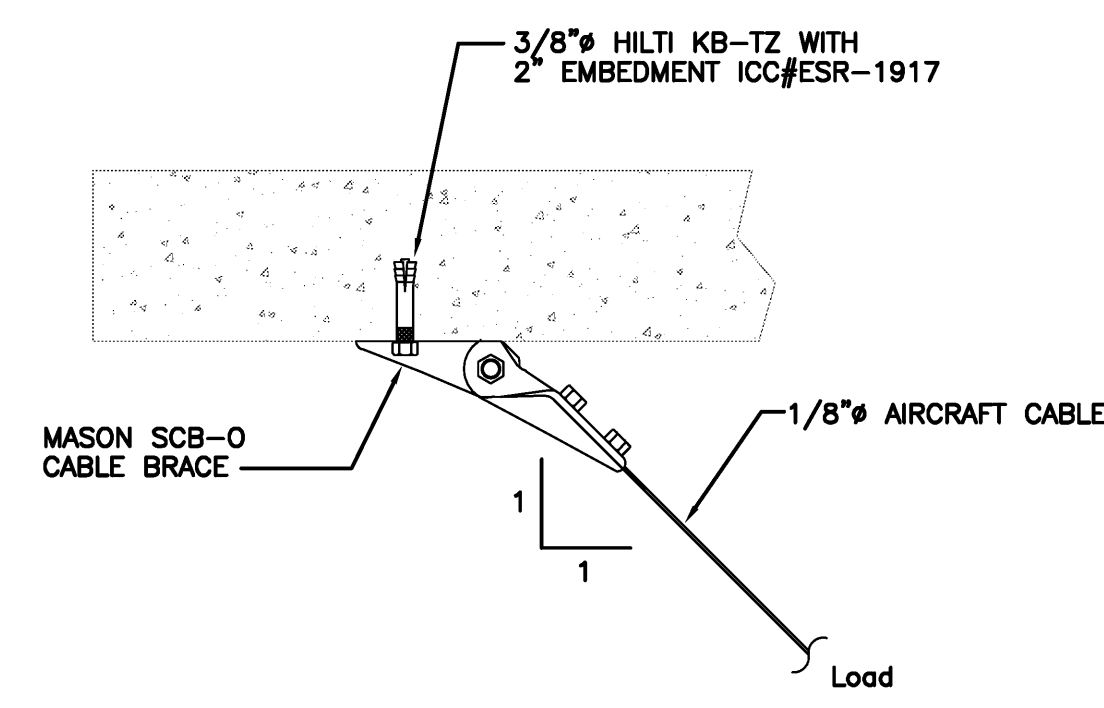


BRACE CONNECTION DETAIL

SCALE: NONE  
8

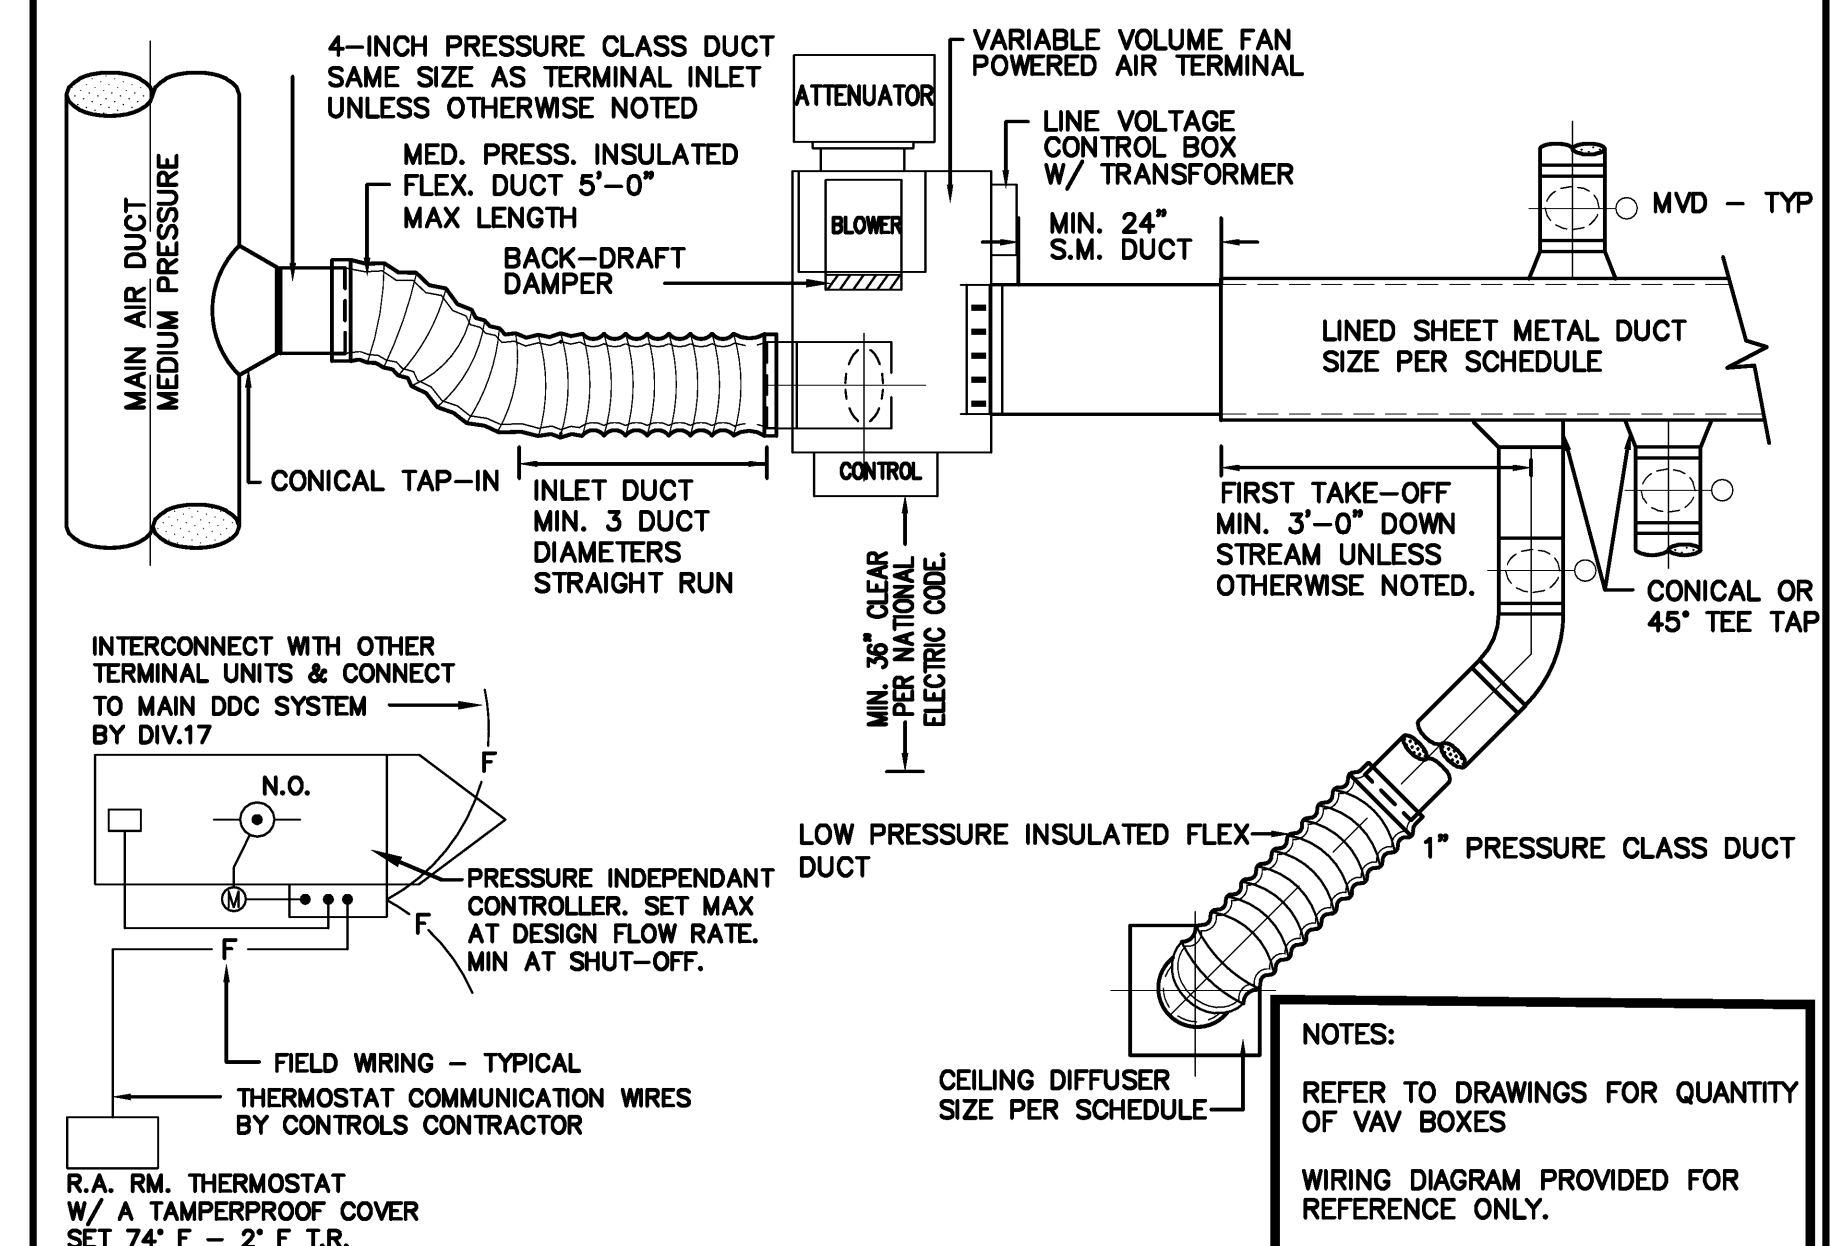

EXTERIOR ZONE VAV BOX DETAIL

SCALE: NONE  
4

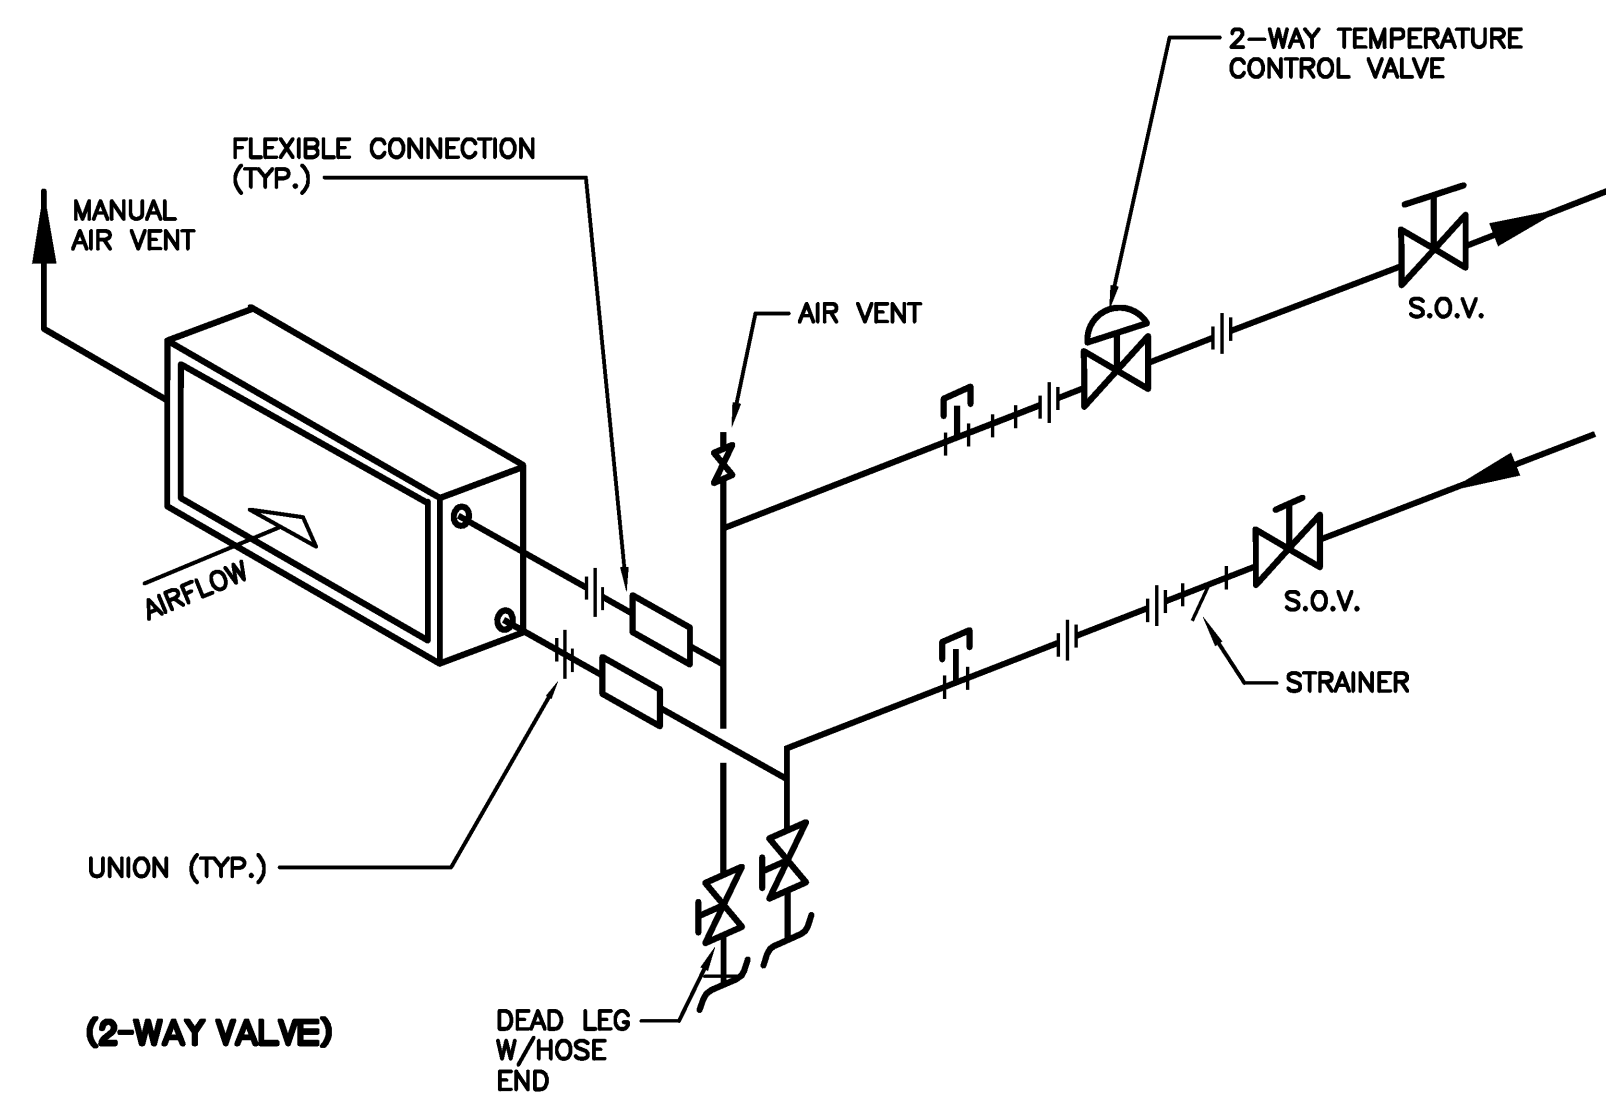


NONE

SCALE: NONE  
14

REHEAT COIL CONNECTION DETAIL

SCALE: NONE  
10

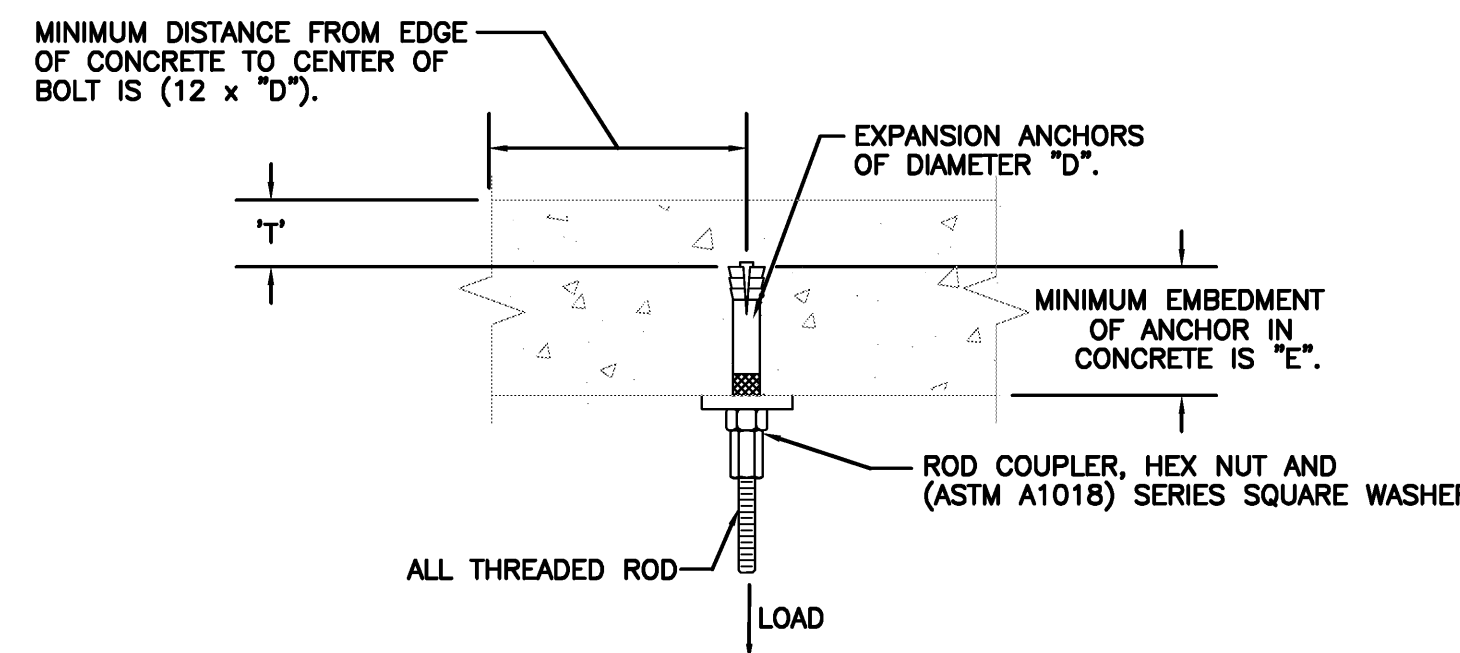


HANGER ANCHORING DETAIL

SCALE: NONE  
7


DIAMETER "D"	ALLOWABLE LOAD (IN TENSION)	MINIMUM EMBEDMENT "E"	MINIMUM CONCRETE COVERAGE "T"
IN.	IN.	IN.	IN.
3/8"	605	2 1/2"	1 1/4"
1/2"	1000	3 1/2"	1 3/4"
5/8"	1335	4"	2"
3/4"	1940	4 3/4"	2 3/8"

\*HILTI KB TZ IN 3000 PSI (20.7 MPA) MINIMUM NORMAL WEIGHT CONCRETE.

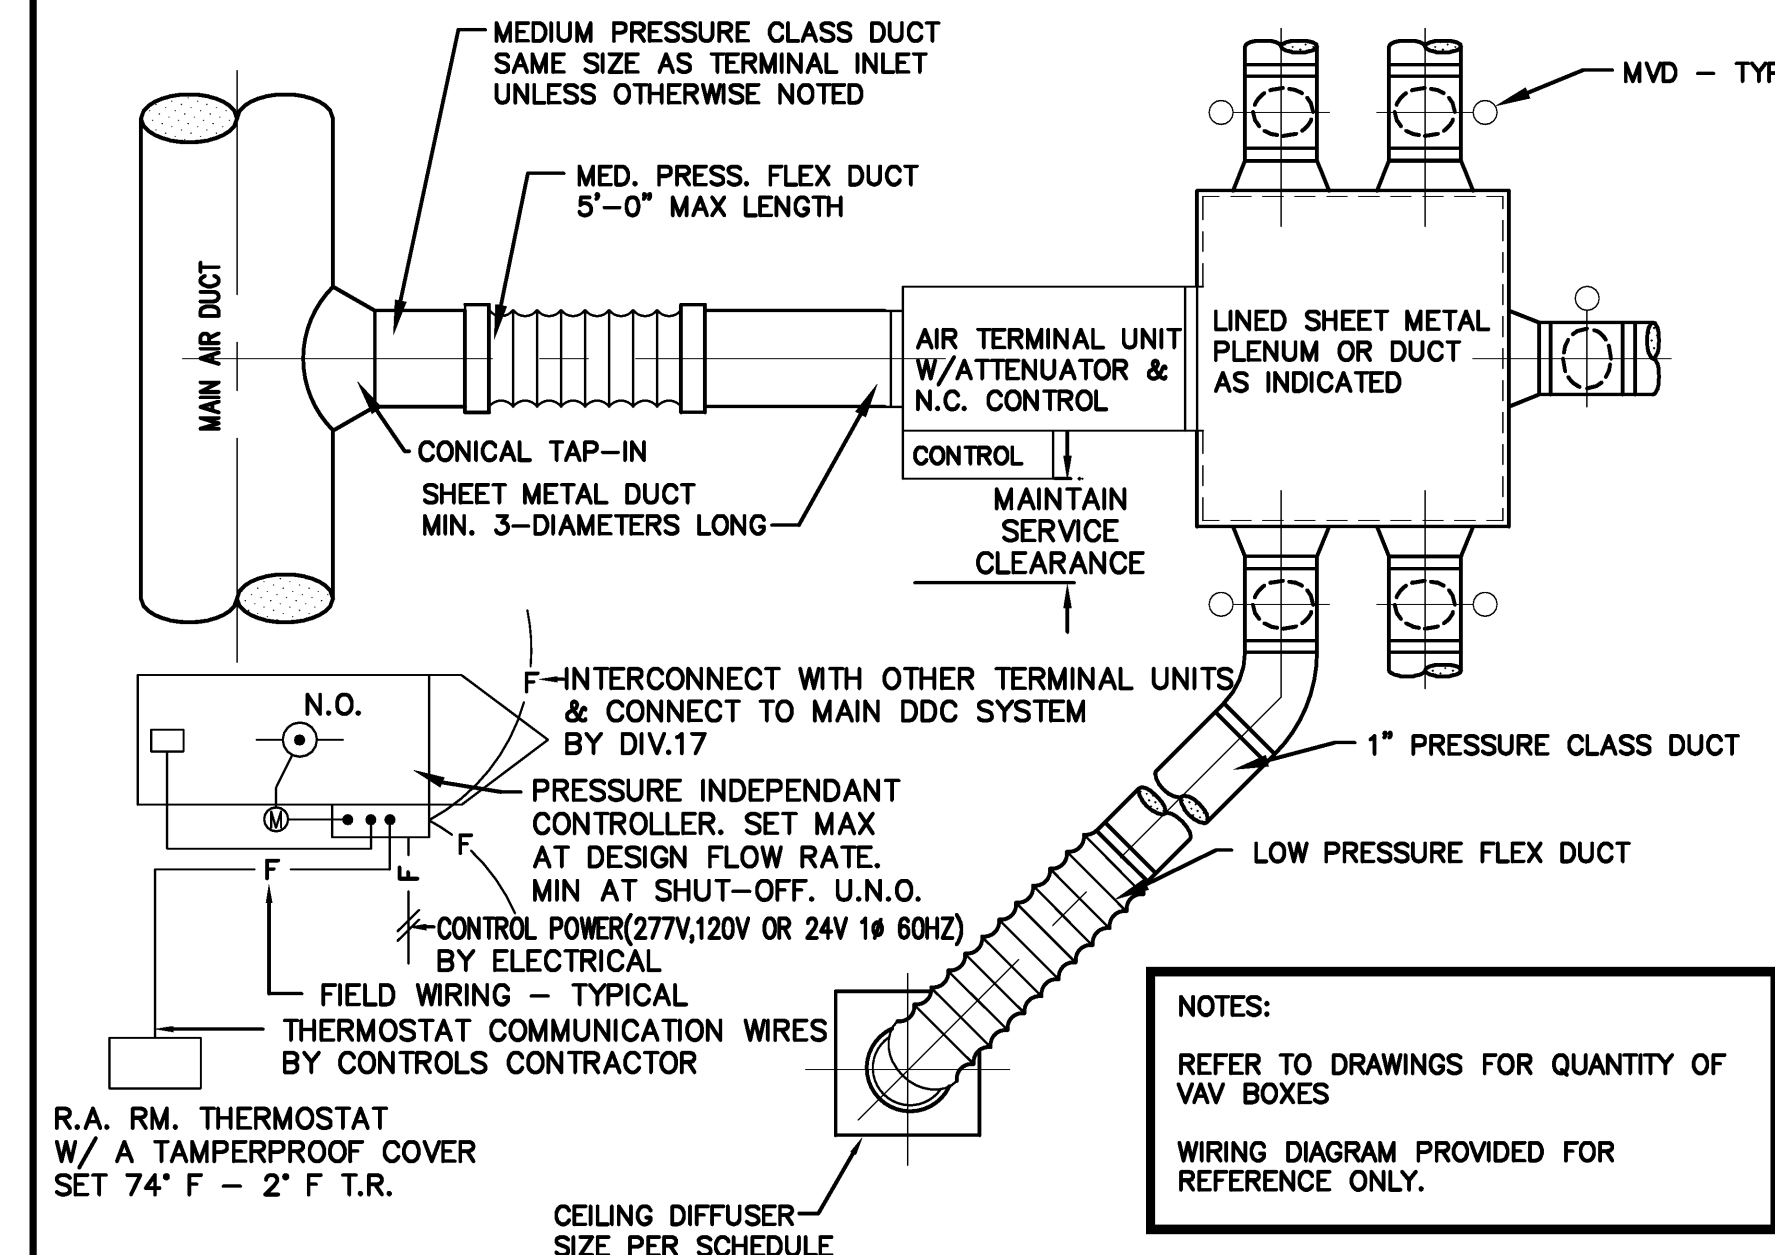


INTERIOR ZONE VAV BOX DETAIL

SCALE: NONE  
3

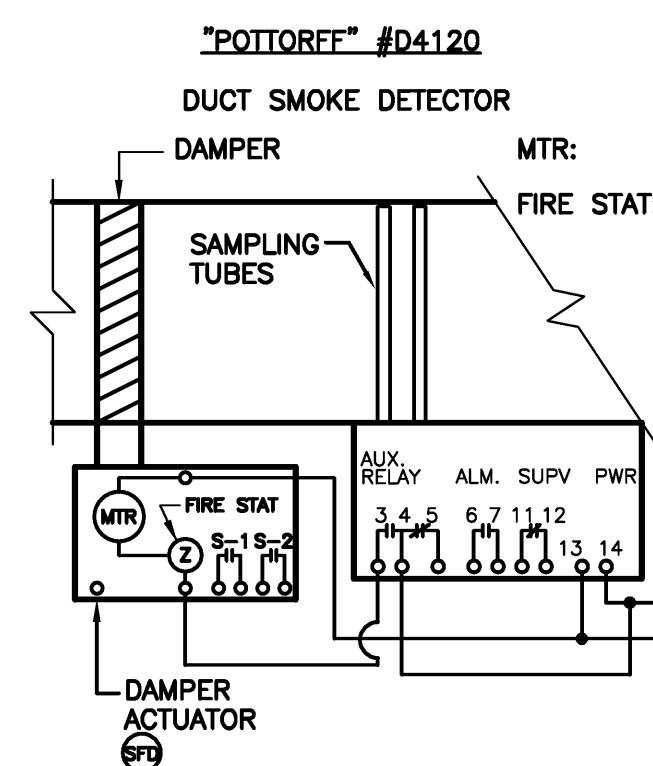

- SMOKE/FIRE DAMPERS SHALL BE STATE FIRE MARSHAL APPROVED AND INSTALLED STRICTLY PER MANUFACTURER'S PRINTED INSTRUCTIONS. MANUFACTURER'S INSTALLATION INSTRUCTIONS SHALL BE MADE AVAILABLE TO THE INSPECTING AUTHORITIES.
- SMOKE DAMPER TO BE PROVIDED WITH SMOKE/FIRE DAMPER BY MECH. CNTR. 120V POWER PROVIDED BY ELECTRICAL CNTR. COORDINATE WITH ALL TRADES FOR A COMPLETE OPERATING ASSEMBLY AND INSTALLATION.
- DAMPER SHALL BE FAIL/SAFE DESIGN, ASSUMES CLOSED POSITION IN CASE OF POWER FAILURE.

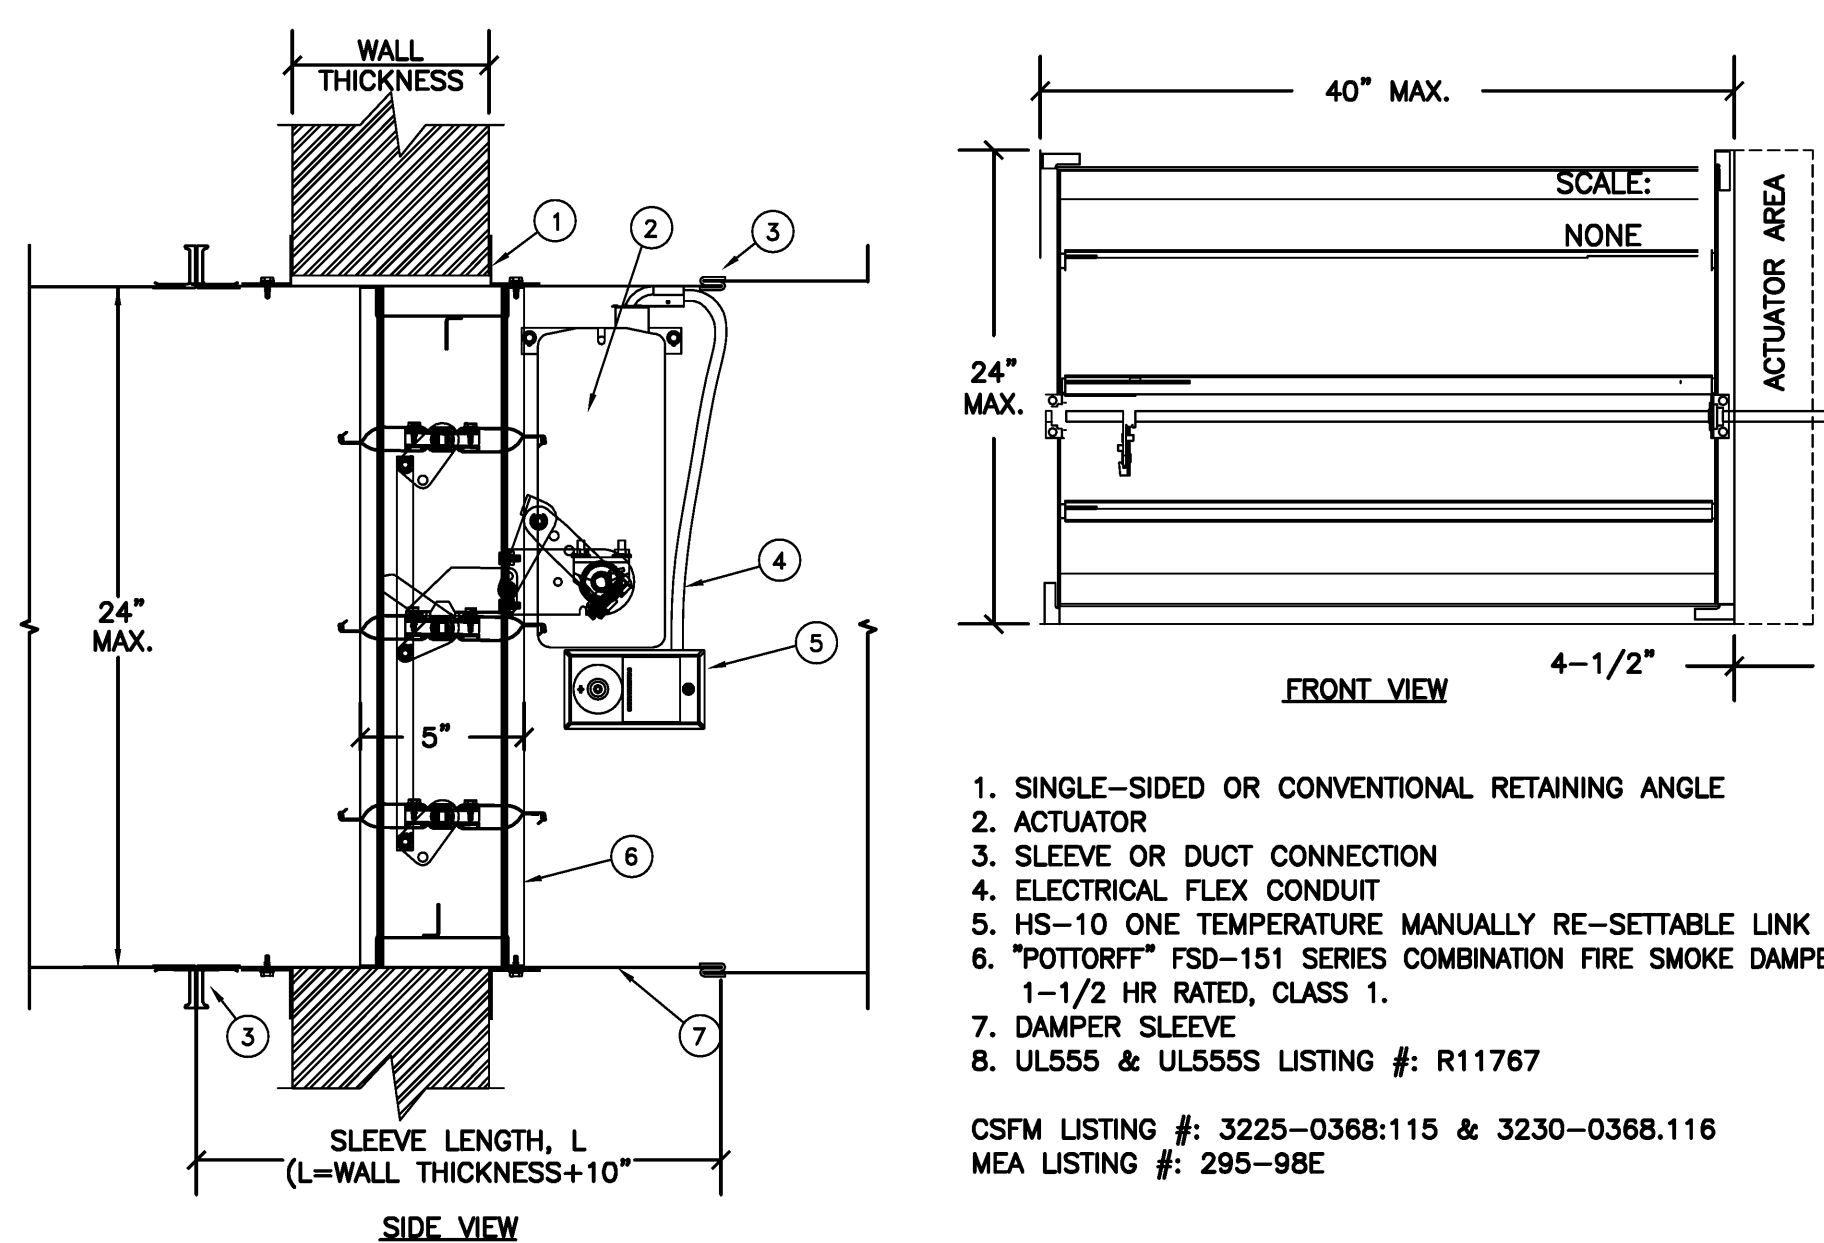


NONE

SCALE: NONE  
13


COMBINATION SMOKE/FIRE DAMPER DETAIL

SCALE: NONE  
9

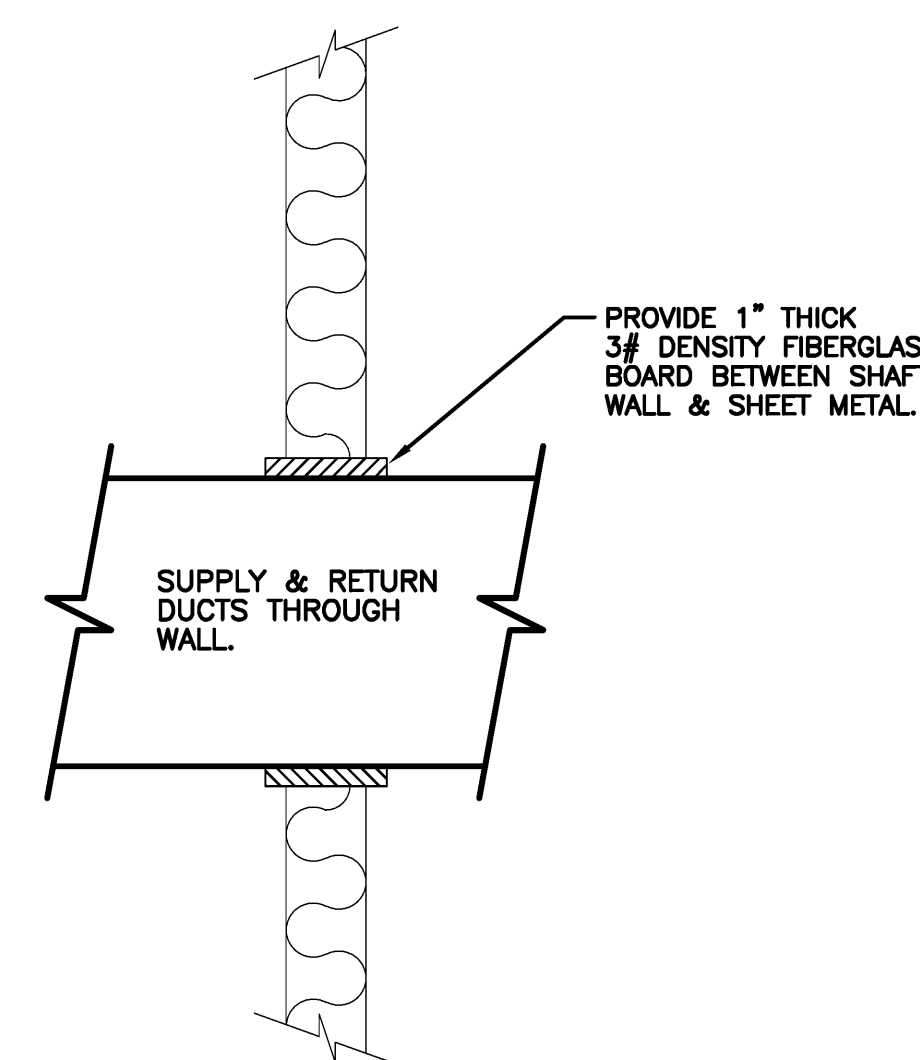


DUCT THRU NON-RATED WALL

SCALE: NONE  
6

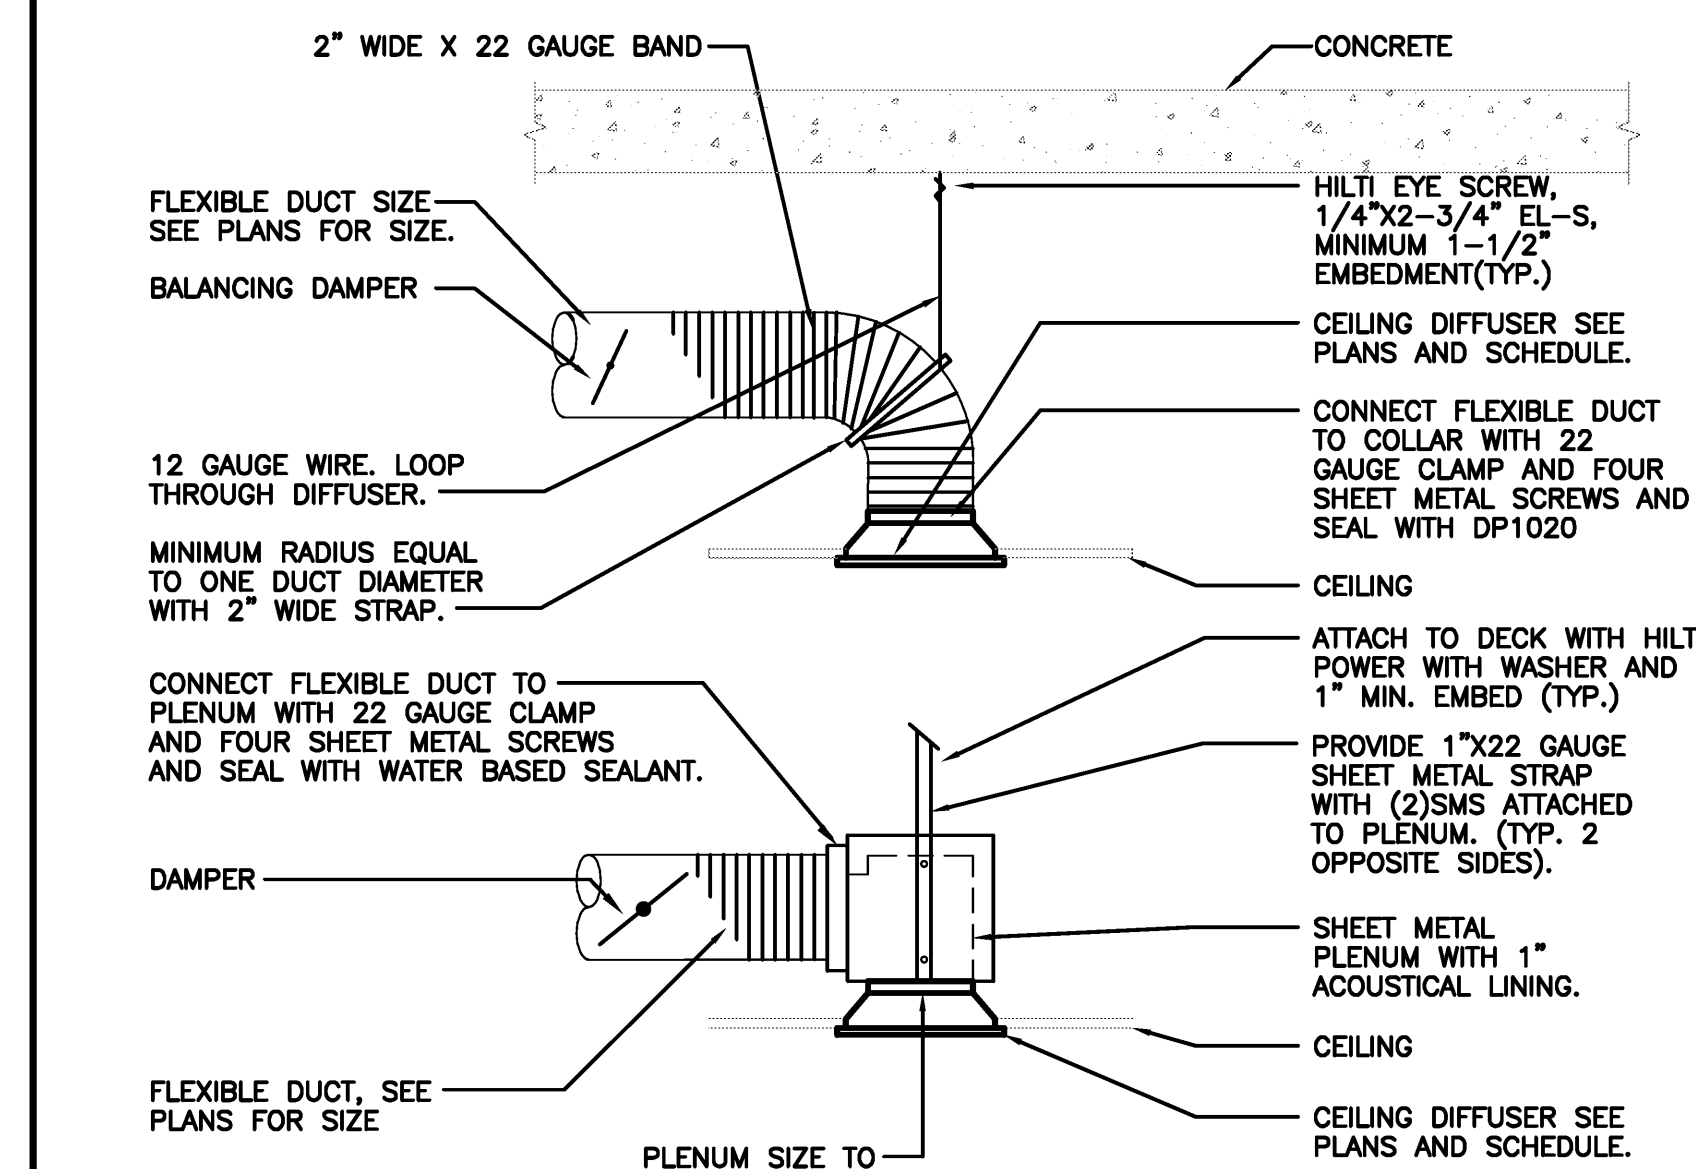


DIFFUSER DUCT CONNECTOR DETAIL

SCALE: NONE  
2

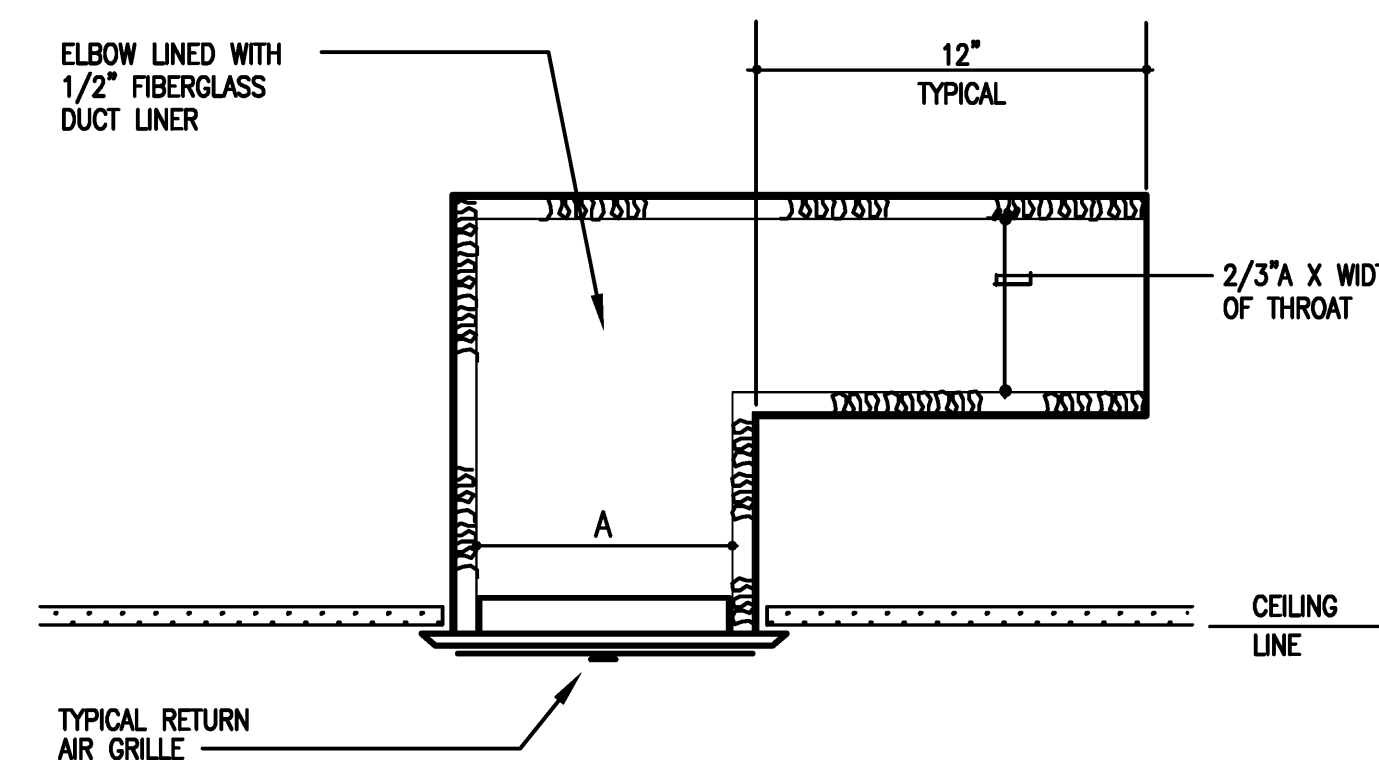

RETURN AIR BOOT DETAIL

SCALE: NONE  
5

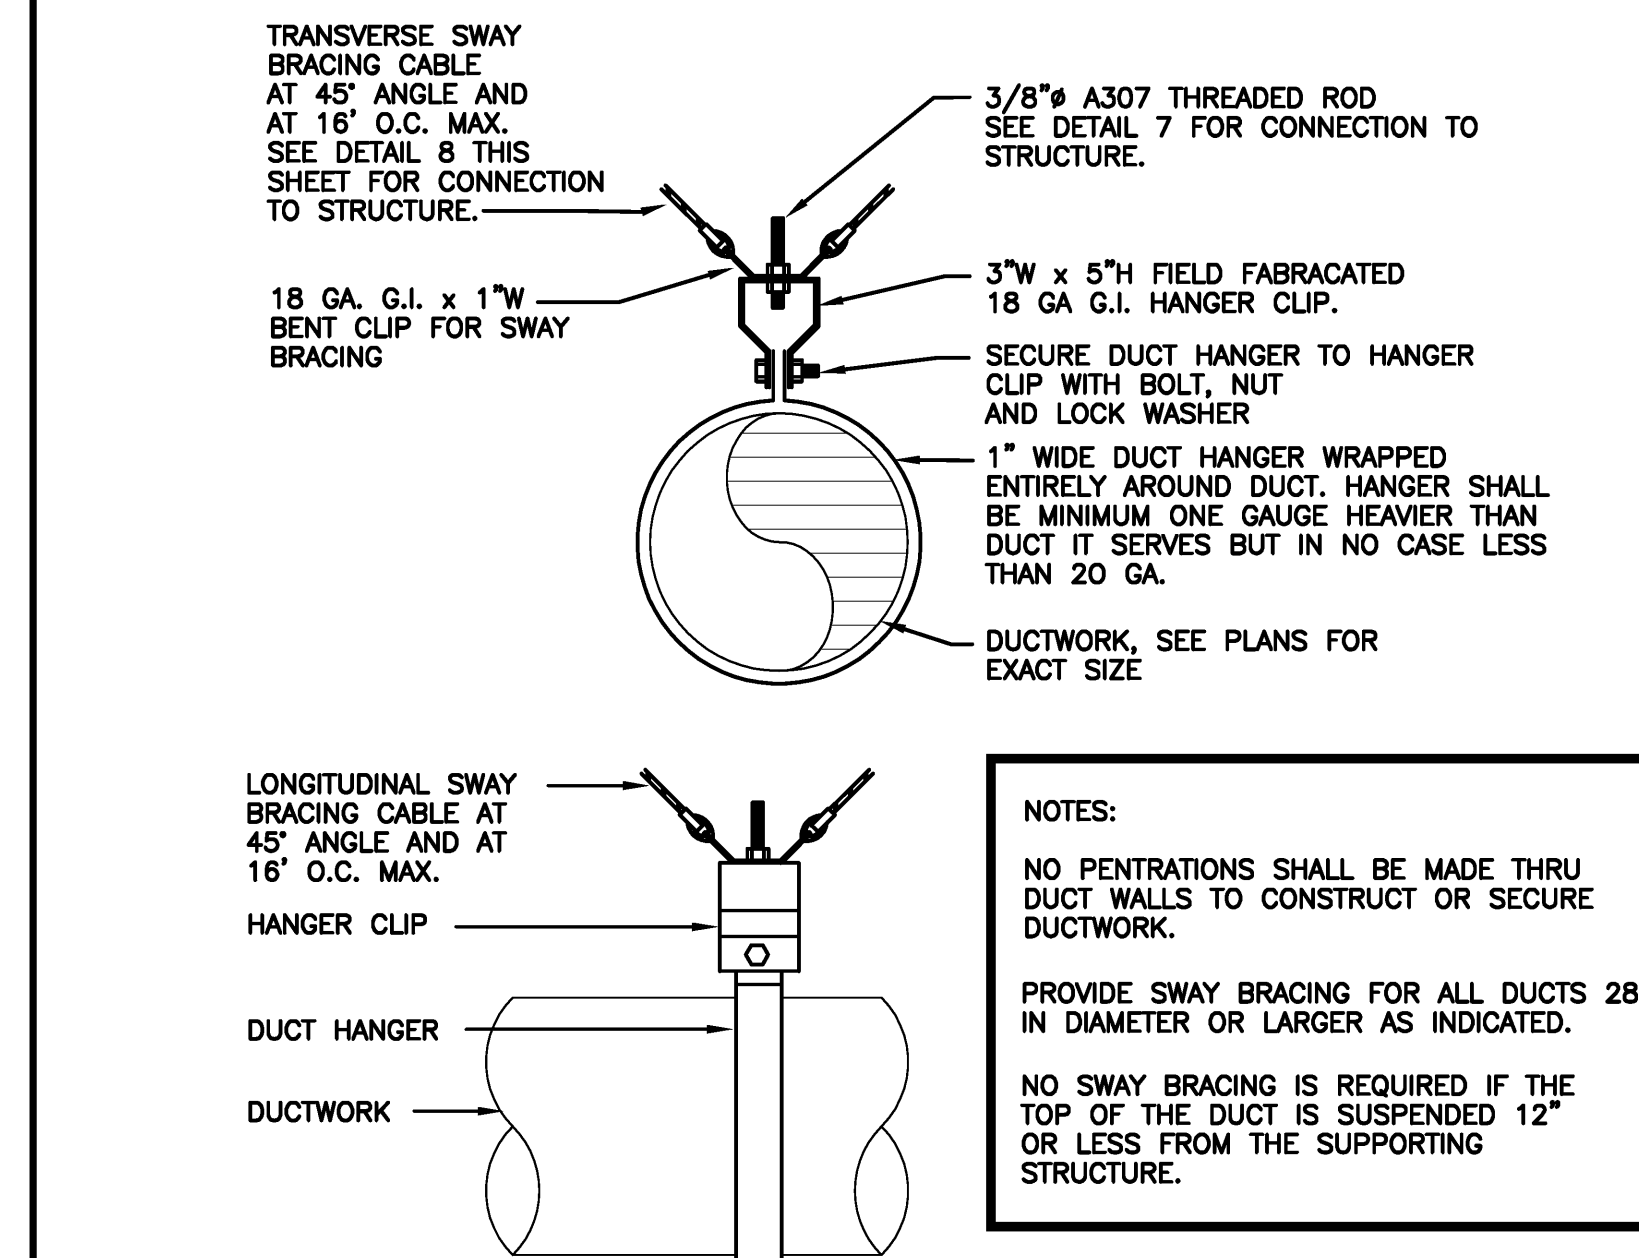

DUCT HANGER DETAIL

SCALE: NONE  
1

remarks	date
PLAN CHECK SUBMIT.	04/15/19
BID SUBMIT.	04/22/19
P.C. CORRECT/ADD-B	05/30/19





all drawings and written material appearing herein constitute the original and unpublished work of the architect and the same may not be duplicated used or disclosed without the written consent of the architect.

remarks	date
PLAN CHECK SUBMIT.	04/15/19
BID SUBMIT.	04/22/19
P.C. CORRECT / ADD - B	05/30/19

sheet title


MECHANICAL DETAILS

drawn by	cm
project no	43028
date	06/18/19
scale	AS SHOWN

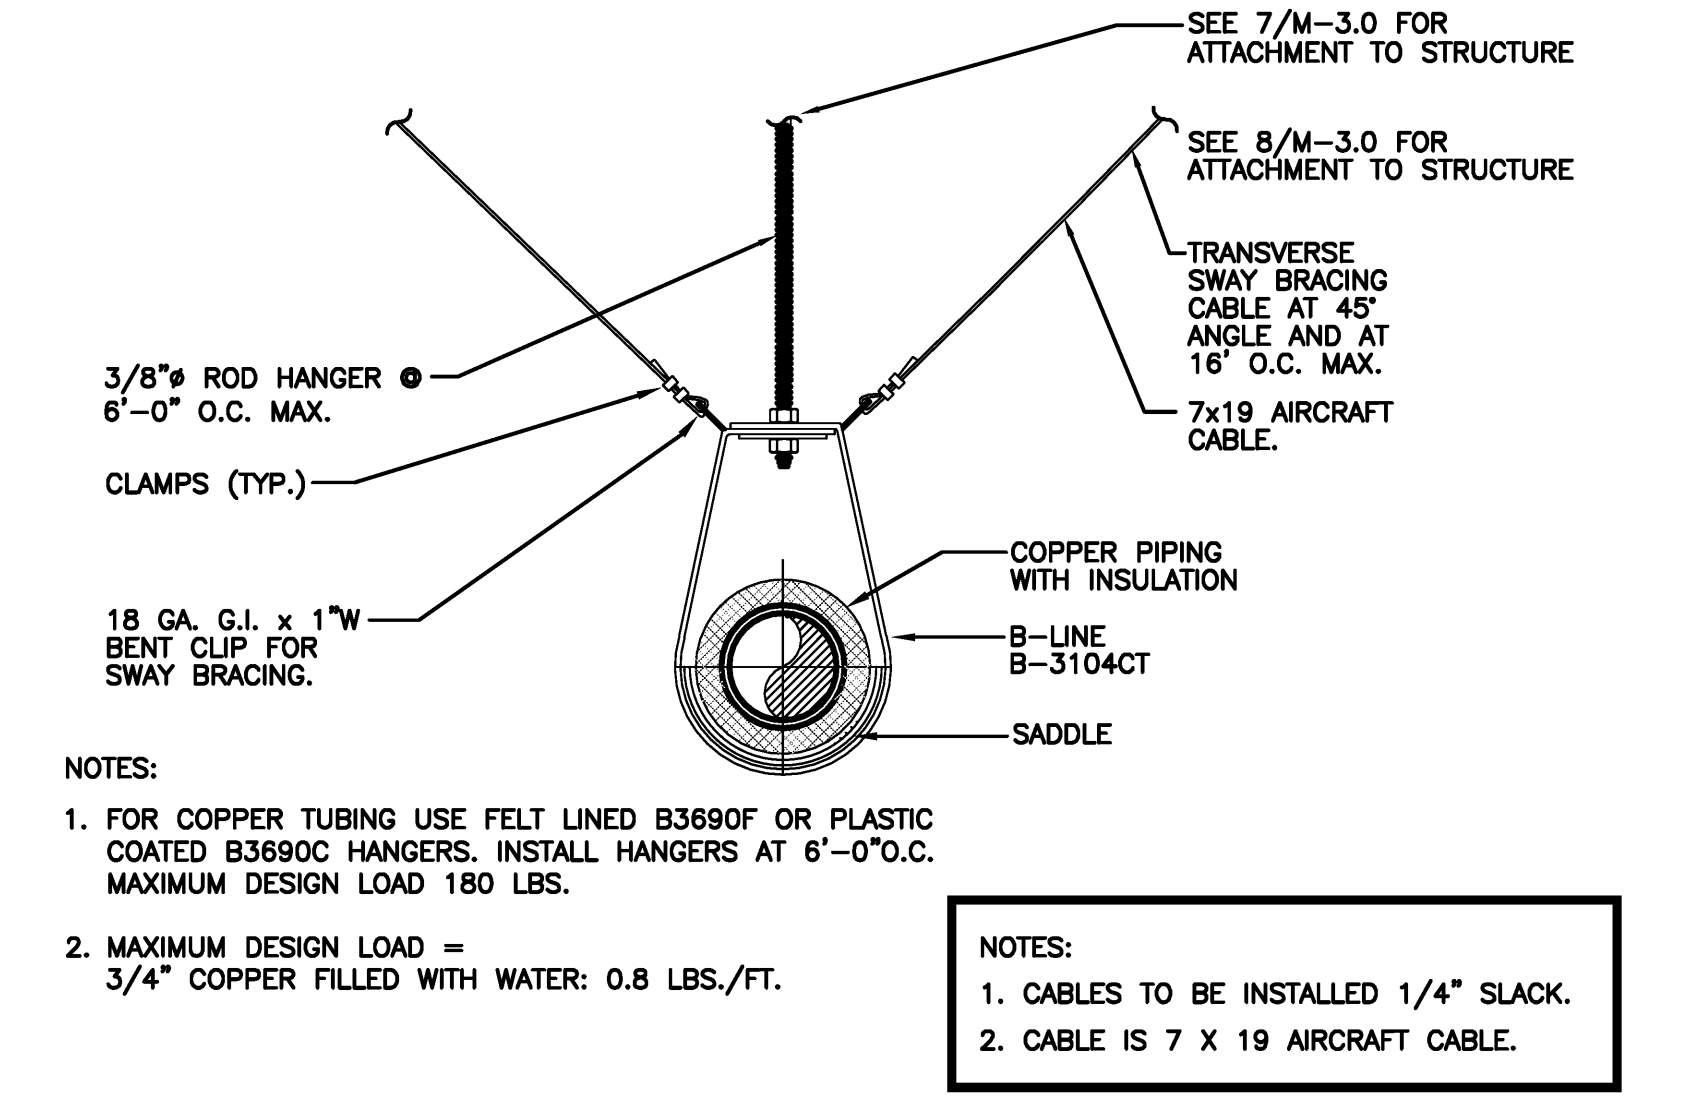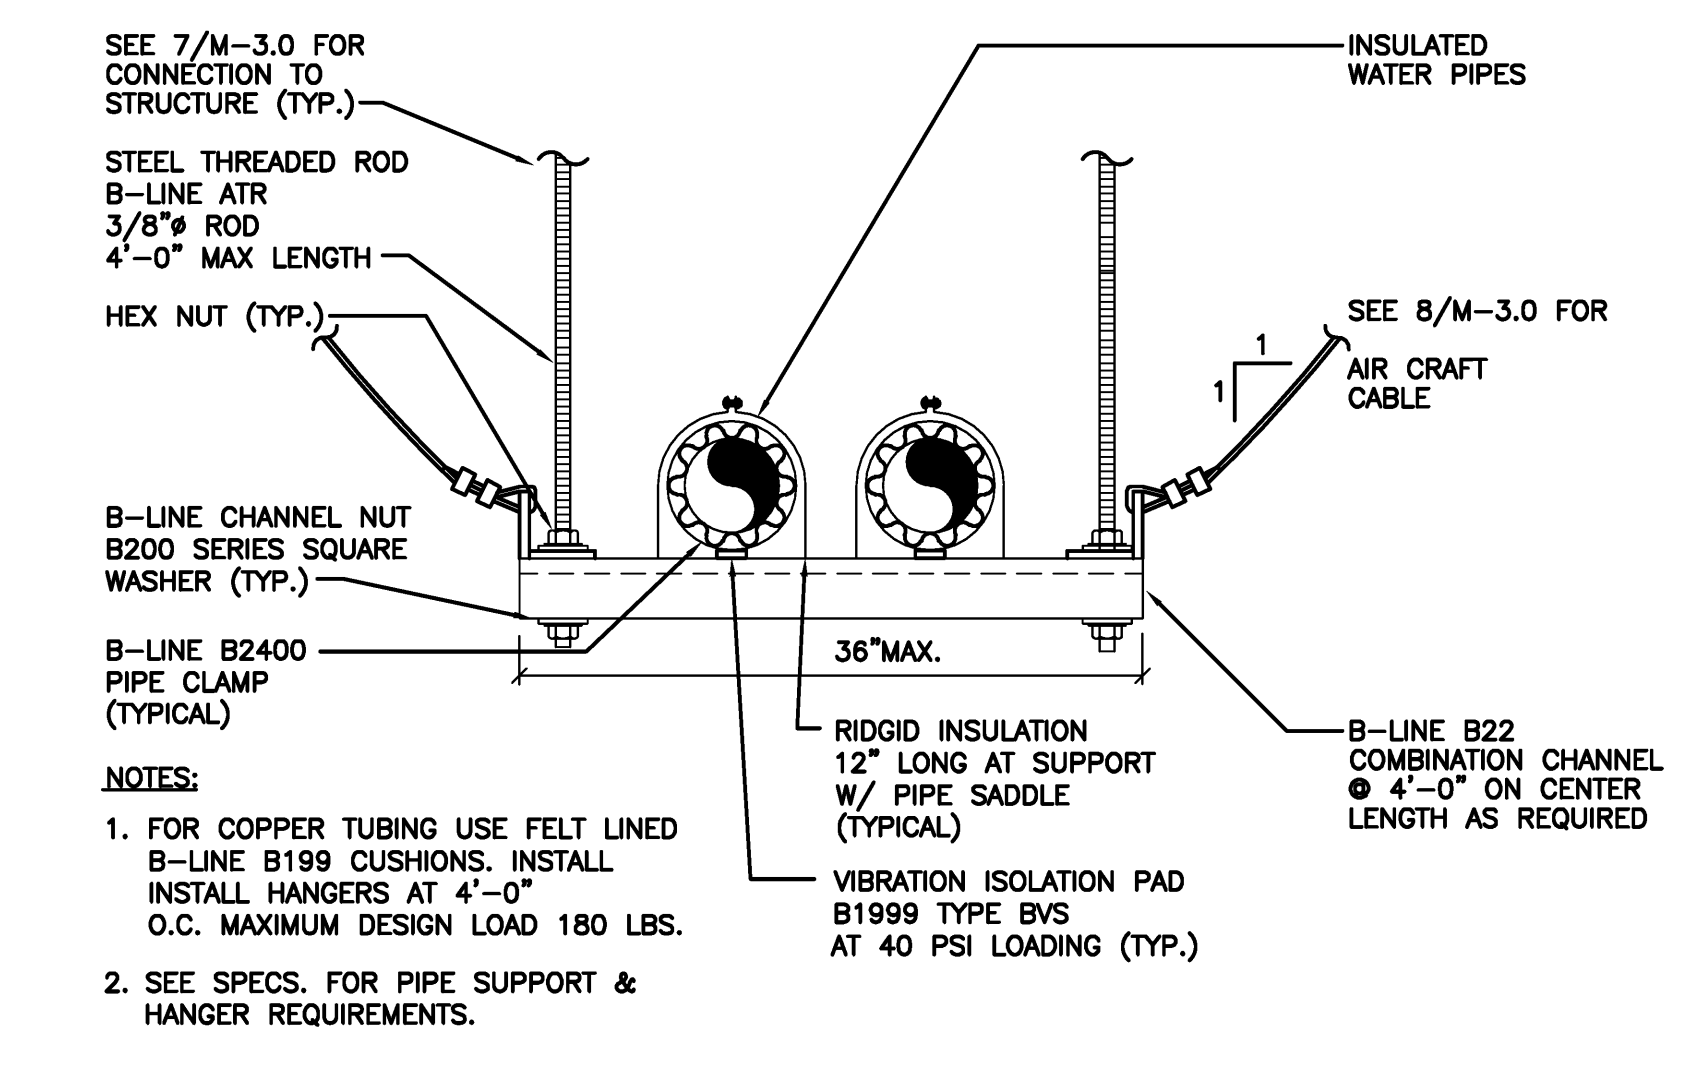

PIPING HANGER DETAIL

- NOTES:  
 3M FIRE BARRIER PRODUCTS:  
 CALIFORNIA STATE FIRE MARSHALL LISTING NO. 4485-941:100  
 UNINSULATED PIPE:  
 U.L. DESIGN NO. WL1001 (STUD WALL)  
 INSULATED PIPE:  
 U.L. DESIGN NO. WL5001 (STUD WALL)

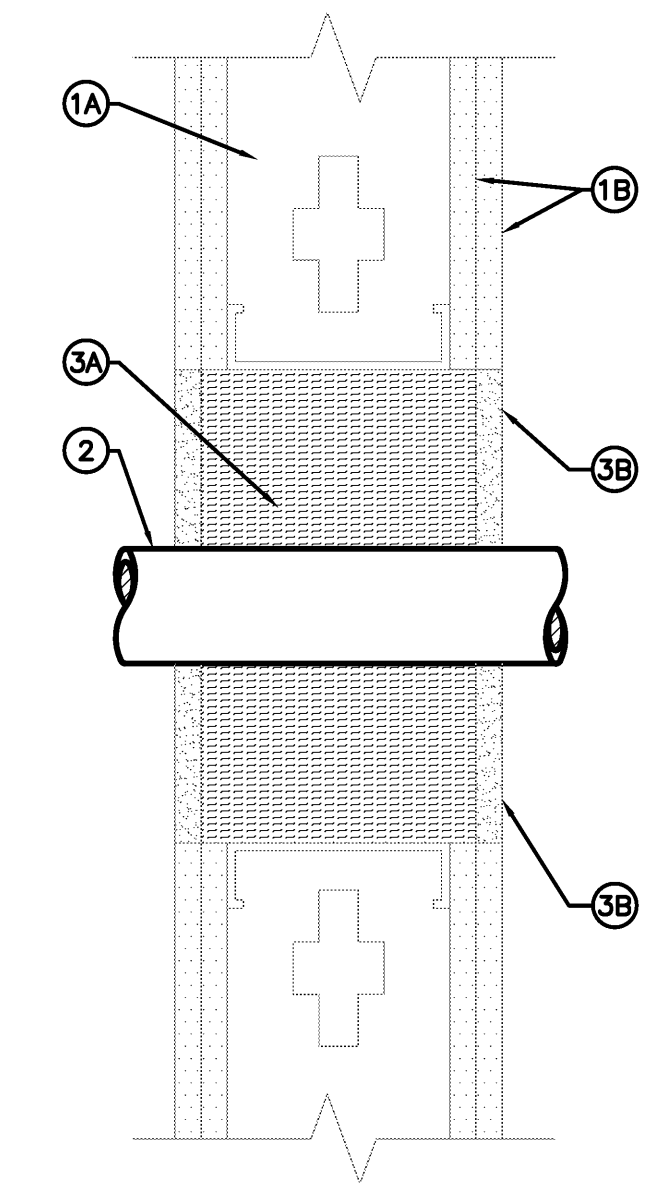

- SPECIFICATIONS:  
 PENETRATIONS IN FIRE RESTRICTIVE WALLS, PARTITIONS AND FLOORS WHERE PROTECTED OPENINGS ARE REQUIRED SHALL BE FIRE STOPPED USING APPROVED MATERIALS, SECURELY INSTALLED AND CAPABLE OF MAINTAINING THEIR INTEGRITY AND PREVENTING THE MOVEMENT OF FLAMES AND/OR GASES THROUGH THE VOID SPACES BETWEEN PENETRATING MATERIALS AND WALLS, PARTITIONS AND FLOORS WHEN TESTED IN ACCORDANCE WITH ASTM STANDARD E-814 OR UL STANDARD 1479
- PROVIDE DESIGN DETAILS ON DRAWINGS DEPICTING APPROVED (LISTED) METHODS AND MATERIALS USED TO PROTECT PENETRATIONS WALLS, PARTITIONS AND FLOORS.
- DESIGNS ARE LISTED BY UNDERWRITER'S LABORATORIES (FIRE RESISTANCE DIRECTORY) AND THE CALIFORNIA STATE FIRE MARSHALL (BUILDING MATERIAL LISTINGS). SPECIFIC DESIGN INFORMATION IS AVAILABLE FROM U.L. CSFM OR THE PRODUCT MANUFACTURER.
- FIRESTOP CONFIGURATION
- WALL ASSEMBLY - THE 1 OR 2 HOUR FIRE-RATED GYPSUM WALLBOARD/ STUD WALL ASSEMBLY SHALL BE CONSTRUCTED OF THE MATERIALS AND IN THE MANNER SPECIFIED IN THE INDIVIDUAL U300 OR U400 SERIES WALL AND PARTITION DESIGNS IN THE UL FIRE RESISTANCE DIRECTORY AND SHALL INCLUDE THE FOLLOWING CONSTRUCTION FEATURES:
    - STUDS - WALL FRAMING MAY CONSIST OF EITHER WOOD STUDS OR STEEL CHANNEL STUDS. WOOD STUDS TO CONSIST OF NOM 2 BY 4" LUMBER SPACED 16" O.C. STEEL STUDS TO BE MIN 3-1/2" WIDE AND SPACED MAX 24" O.C FOR 1 HOUR RATED WALLS. STEEL STUDS TO BE MIN. 2-1/2" WIDE AND SPACED MAX 24" O.C FOR 2 HOUR RATED WALLS.
    - GYPSUM BOARD - ONE OR TWO LAYERS OF NOM 5/8" THICK GYPSUM WALLBOARD, AS SPECIFIED IN THE INDIVIDUAL WALL AND PARTITION DESIGN. MAX AREA OF OPENING IS 585 SQ. IN. WITH MAX DIMENSIONS OF 21" WIDE BY 27-7/8" HIGH. THE HOURLY F RATING OF THE FIRESTOP SYSTEM IS EQUAL TO THE HOURLY RATING OF THE WALL.
  - THROUGH-PENETRANTS - METALLIC PIPE, CONDUIT OR TUBING INSTALLED WITHIN THE FIRESTOP SYSTEM. PIPE, CONDUIT OR TUBING TO BE RIGIDLY SUPPORTED ON BOTH SIDES OF WALL ASSEMBLY. THE FOLLOWING TYPES OF PIPE, CONDUIT OR TUBING MAY BE USED.
    - STEEL PIPE - NOM 4" IN DIAMETER (OR SMALLER) SCHEDULE 5 (OR HEAVIER) STEEL PIPE.
    - COPPER TUBING - NOM 3" IN DIAMETER (OR SMALLER) TYPE L (OR HEAVIER) COPPER TUBING.
    - COPPER PIPE - NOM 3" IN DIAMETER (OR SMALLER) REGULAR (OR HEAVIER) COPPER PIPE.
    - CONDUIT - NOM 4" IN DIAMETER (OR SMALLER) ELECTRICAL METALLIC TUBING (EMT) OR STEEL CONDUIT.
  - FIRESTOP SYSTEM - THE FIRESTOP SYSTEM SHALL CONSIST OF THE FOLLOWING.
    - PACKING MATERIAL - MIN. 4" THICKNESS OF MIN. 4 PCF MINERAL WOOL BATT INSULATION PACKED AT 50 PERCENT COMPRESSION INTO OPENING AS A PERMANENT FORM. PACKING MATERIAL TO BE RECESSED FROM BOTH SURFACES OF WALL AS REQUIRED TO ACCOMMODATE THE REQUIRED THICKNESS OF FILL MATERIAL.
    - FILL, VOID, OR CAVITY MATERIAL - SEALANT - MIN 3/8" THICKNESS OF FILL MATERIAL APPLIED WITHIN THE ANNULAR SPACE BETWEEN THE PIPE COVERING AND THE PERIPHERY OF THE OPENING, FLUSH WITH BOTH SURFACES OF WALL. 3M COMPANY - FB-1000 NS OR FB-3000 WT.

PIPE THRU RATED WALL (UL-W-L-8022)

NONE

SCALE: NONE 12

NONE

SCALE: NONE 8

NONE

SCALE: NONE 4

NONE

SCALE: NONE 11

NONE

SCALE: NONE 7

NONE

SCALE: NONE 3

SCALE: NONE 2

NONE

SCALE: NONE 10

NONE

SCALE: NONE 6

NONE

SCALE: NONE 9

NONE

SCALE: NONE 5

SCALE: NONE 1

STATE OF CALIFORNIA  
**MECHANICAL VENTILATION AND REHEAT**  
 CERTIFICATE OF COMPLIANCE  
 Mechanical Ventilation & Reheat  
 Project Name: TI for RIO School District Date Prepared: 4/12/2019  
 NRCC-MCH-03-E (Page 1 of 2)

ACTUAL DESIGN INFO (FROM EQUIPMENT SCHEDULES, ETC)		AREA BASIS		OCCUPANCY BASIS		ROOM BASIS	MINIMUM	VAV Scheduling Primary AS CFM	VAV Deadband Primary AS CFM												
01	02	03	04	05	06	07	08	09	10	11	12	13	14	15	16	17	18	19	20	21	
ZONE (SYSTEM/VAV BOX TAG)	DESIGN PRIMARY COOLING AIRFLOW (CFM)	DESIGN PRIMARY HEATING AIRFLOW (CFM)	DESIGN MAX HEATING AIRFLOW (CFM)	CENTRAL TYPIC (Y/N)	TRANSFER AIRFLOW (CFM)	CONDITIONED (Y/N)	MIN. CMV PER AREA	MIN. CMV BY AREA	MIN. CMV PER AREA	MIN. CMV BY AREA	MIN. CMV PER PERSON	MIN. CMV BY PERSON	MIN. CMV PER OCCUPANT	MIN. CMV BY OCCUPANT	MIN. CMV PER ROOM	MIN. CMV BY ROOM	MIN. CMV PER ROOM	MIN. CMV BY ROOM	MIN. CMV PER ROOM	MIN. CMV BY ROOM	
1	1,250	250	Y		647	0.15	97	3.2	30.0	97		97		X Pass <input type="checkbox"/> Fail <input type="checkbox"/> N/A	625	625		X Pass <input type="checkbox"/> Fail <input type="checkbox"/> N/A	250	250	X Pass <input type="checkbox"/> Fail <input type="checkbox"/> N/A
2	840	168	Y		840	0.15	126	4.2	30.0	126		126		X Pass <input type="checkbox"/> Fail <input type="checkbox"/> N/A	420	420		X Pass <input type="checkbox"/> Fail <input type="checkbox"/> N/A	168	168	X Pass <input type="checkbox"/> Fail <input type="checkbox"/> N/A
3	840	168	Y		840	0.15	126	4.2	30.0	126		126		X Pass <input type="checkbox"/> Fail <input type="checkbox"/> N/A	420	420		X Pass <input type="checkbox"/> Fail <input type="checkbox"/> N/A	168	168	X Pass <input type="checkbox"/> Fail <input type="checkbox"/> N/A
4	1,490	298	Y		865	0.15	130	4.3	30.0	130		130		X Pass <input type="checkbox"/> Fail <input type="checkbox"/> N/A	745	745		X Pass <input type="checkbox"/> Fail <input type="checkbox"/> N/A	298	298	X Pass <input type="checkbox"/> Fail <input type="checkbox"/> N/A
5	580	116	Y		114	1.535	0.15	230	7.7	30.0	230		230	X Pass <input type="checkbox"/> Fail <input type="checkbox"/> N/A	290	290		X Pass <input type="checkbox"/> Fail <input type="checkbox"/> N/A	116	230	X Pass <input type="checkbox"/> Fail <input type="checkbox"/> N/A
6	1,850	330	Y		104	2.890	0.15	434	14.5	30.0	434		434	X Pass <input type="checkbox"/> Fail <input type="checkbox"/> N/A	825	825		X Pass <input type="checkbox"/> Fail <input type="checkbox"/> N/A	330	434	X Pass <input type="checkbox"/> Fail <input type="checkbox"/> N/A
7	475	95	Y		170	0.15	26	0.9	30.0	26		26		X Pass <input type="checkbox"/> Fail <input type="checkbox"/> N/A	238	238		X Pass <input type="checkbox"/> Fail <input type="checkbox"/> N/A	95	95	X Pass <input type="checkbox"/> Fail <input type="checkbox"/> N/A

CA Building Energy Efficiency Standards - 2016 Nonresidential Compliance May 2016

STATE OF CALIFORNIA  
**MECHANICAL VENTILATION AND REHEAT**  
 CERTIFICATE OF COMPLIANCE  
 Mechanical Ventilation & Reheat  
 Project Name: TI for RIO School District Date Prepared: 4/12/2019  
 NRCC-MCH-03-E (Page 1 of 2)

ACTUAL DESIGN INFO (FROM EQUIPMENT SCHEDULES, ETC)		AREA BASIS		OCCUPANCY BASIS		ROOM BASIS	MINIMUM	VAV Scheduling Primary AS CFM	VAV Deadband Primary AS CFM												
01	02	03	04	05	06	07	08	09	10	11	12	13	14	15	16	17	18	19	20	21	
ZONE (SYSTEM/VAV BOX TAG)	DESIGN PRIMARY COOLING AIRFLOW (CFM)	DESIGN PRIMARY HEATING AIRFLOW (CFM)	DESIGN MAX HEATING AIRFLOW (CFM)	CENTRAL TYPIC (Y/N)	TRANSFER AIRFLOW (CFM)	CONDITIONED (Y/N)	MIN. CMV PER AREA	MIN. CMV BY AREA	MIN. CMV PER AREA	MIN. CMV BY AREA	MIN. CMV PER PERSON	MIN. CMV BY PERSON	MIN. CMV PER OCCUPANT	MIN. CMV BY OCCUPANT	MIN. CMV PER ROOM	MIN. CMV BY ROOM	MIN. CMV PER ROOM	MIN. CMV BY ROOM	MIN. CMV PER ROOM	MIN. CMV BY ROOM	
22	915	183	Y		335	0.15	50	1.7	30.0	50		50		X Pass <input type="checkbox"/> Fail <input type="checkbox"/> N/A	458	458		X Pass <input type="checkbox"/> Fail <input type="checkbox"/> N/A	183	183	X Pass <input type="checkbox"/> Fail <input type="checkbox"/> N/A
23	1,760	352	Y		757	0.15	114	3.8	30.0	114		114		X Pass <input type="checkbox"/> Fail <input type="checkbox"/> N/A	880	880		X Pass <input type="checkbox"/> Fail <input type="checkbox"/> N/A	352	352	X Pass <input type="checkbox"/> Fail <input type="checkbox"/> N/A
24	2,100	420	Y		930	0.15	140	4.7	30.0	140		140		X Pass <input type="checkbox"/> Fail <input type="checkbox"/> N/A	1,050	1,050		X Pass <input type="checkbox"/> Fail <input type="checkbox"/> N/A	420	420	X Pass <input type="checkbox"/> Fail <input type="checkbox"/> N/A
25	1,800	360	Y		730	0.15	110	3.7	30.0	110		110		X Pass <input type="checkbox"/> Fail <input type="checkbox"/> N/A	900	900		X Pass <input type="checkbox"/> Fail <input type="checkbox"/> N/A	360	360	X Pass <input type="checkbox"/> Fail <input type="checkbox"/> N/A
26	1,700	340	Y		680	0.15	102	3.4	30.0	102		102		X Pass <input type="checkbox"/> Fail <input type="checkbox"/> N/A	850	850		X Pass <input type="checkbox"/> Fail <input type="checkbox"/> N/A	340	340	X Pass <input type="checkbox"/> Fail <input type="checkbox"/> N/A
27	1,160	232	Y		335	0.15	50	1.7	30.0	50		50		X Pass <input type="checkbox"/> Fail <input type="checkbox"/> N/A	580	580		X Pass <input type="checkbox"/> Fail <input type="checkbox"/> N/A	232	232	X Pass <input type="checkbox"/> Fail <input type="checkbox"/> N/A
21	945	189	Y		913	0.15	137	4.6	30.0	137		137		X Pass <input type="checkbox"/> Fail <input type="checkbox"/> N/A	473	473		X Pass <input type="checkbox"/> Fail <input type="checkbox"/> N/A	189	189	X Pass <input type="checkbox"/> Fail <input type="checkbox"/> N/A

CA Building Energy Efficiency Standards - 2016 Nonresidential Compliance May 2016

STATE OF CALIFORNIA  
**MECHANICAL VENTILATION AND REHEAT**  
 CERTIFICATE OF COMPLIANCE  
 Mechanical Ventilation & Reheat  
 Project Name: TI for RIO School District Date Prepared: 4/12/2019  
 NRCC-MCH-03-E (Page 1 of 2)

ACTUAL DESIGN INFO (FROM EQUIPMENT SCHEDULES, ETC)		AREA BASIS		OCCUPANCY BASIS		ROOM BASIS	MINIMUM	VAV Scheduling Primary AS CFM	VAV Deadband Primary AS CFM												
01	02	03	04	05	06	07	08	09	10	11	12	13	14	15	16	17	18	19	20	21	
ZONE (SYSTEM/VAV BOX TAG)	DESIGN PRIMARY COOLING AIRFLOW (CFM)	DESIGN PRIMARY HEATING AIRFLOW (CFM)	DESIGN MAX HEATING AIRFLOW (CFM)	CENTRAL TYPIC (Y/N)	TRANSFER AIRFLOW (CFM)	CONDITIONED (Y/N)	MIN. CMV PER AREA	MIN. CMV BY AREA	MIN. CMV PER AREA	MIN. CMV BY AREA	MIN. CMV PER PERSON	MIN. CMV BY PERSON	MIN. CMV PER OCCUPANT	MIN. CMV BY OCCUPANT	MIN. CMV PER ROOM	MIN. CMV BY ROOM	MIN. CMV PER ROOM	MIN. CMV BY ROOM	MIN. CMV PER ROOM	MIN. CMV BY ROOM	
8	1,400	280	Y		452	0.15	68	2.3	30.0	68		68		X Pass <input type="checkbox"/> Fail <input type="checkbox"/> N/A	700	700		X Pass <input type="checkbox"/> Fail <input type="checkbox"/> N/A	280	280	X Pass <input type="checkbox"/> Fail <input type="checkbox"/> N/A
9	2,300	460	Y		910	0.15	137	4.6	30.0	137		137		X Pass <input type="checkbox"/> Fail <input type="checkbox"/> N/A	1,150	1,150		X Pass <input type="checkbox"/> Fail <input type="checkbox"/> N/A	460	460	X Pass <input type="checkbox"/> Fail <input type="checkbox"/> N/A
10	3,000	600	Y		1,270	0.15	191	6.4	30.0	191		191		X Pass <input type="checkbox"/> Fail <input type="checkbox"/> N/A	1,500	1,500		X Pass <input type="checkbox"/> Fail <input type="checkbox"/> N/A	600	600	X Pass <input type="checkbox"/> Fail <input type="checkbox"/> N/A
11	1,200	240	Y		820	0.15	123	4.1	30.0	123		123		X Pass <input type="checkbox"/> Fail <input type="checkbox"/> N/A	600	600		X Pass <input type="checkbox"/> Fail <input type="checkbox"/> N/A	240	240	X Pass <input type="checkbox"/> Fail <input type="checkbox"/> N/A
12	330	66	Y		435	0.15	65	2.2	30.0	65		65		X Pass <input type="checkbox"/> Fail <input type="checkbox"/> N/A	165	165		X Pass <input type="checkbox"/> Fail <input type="checkbox"/> N/A	66	66	X Pass <input type="checkbox"/> Fail <input type="checkbox"/> N/A
13	1,430	286	Y		375	0.15	56	1.9	30.0	56		56		X Pass <input type="checkbox"/> Fail <input type="checkbox"/> N/A	715	715		X Pass <input type="checkbox"/> Fail <input type="checkbox"/> N/A	286	286	X Pass <input type="checkbox"/> Fail <input type="checkbox"/> N/A
14	1,180	236	Y		425	0.15	64	2.1	30.0	64		64		X Pass <input type="checkbox"/> Fail <input type="checkbox"/> N/A	590	590		X Pass <input type="checkbox"/> Fail <input type="checkbox"/> N/A	236	236	X Pass <input type="checkbox"/> Fail <input type="checkbox"/> N/A

CA Building Energy Efficiency Standards - 2016 Nonresidential Compliance May 2016

STATE OF CALIFORNIA  
**MECHANICAL VENTILATION AND REHEAT**  
 CERTIFICATE OF COMPLIANCE  
 Mechanical Ventilation & Reheat  
 Project Name: TI for RIO School District Date Prepared: 4/12/2019  
 NRCC-MCH-03-E (Page 1 of 2)

ACTUAL DESIGN INFO (FROM EQUIPMENT SCHEDULES, ETC)		AREA BASIS		OCCUPANCY BASIS		ROOM BASIS	MINIMUM	VAV Scheduling Primary AS CFM	VAV Deadband Primary AS CFM											
01	02	03	04	05	06	07	08	09	10	11	12	13	14	15	16	17	18	19	20	21
ZONE (SYSTEM/VAV BOX TAG)	DESIGN PRIMARY COOLING AIRFLOW (CFM)	DESIGN PRIMARY HEATING AIRFLOW (CFM)	DESIGN MAX HEATING AIRFLOW (CFM)	CENTRAL TYPIC (Y/N)	TRANSFER AIRFLOW (CFM)	CONDITIONED (Y/N)	MIN. CMV PER AREA	MIN. CMV BY AREA	MIN. CMV PER AREA	MIN. CMV BY AREA	MIN. CMV PER PERSON	MIN. CMV BY PERSON	MIN. CMV PER OCCUPANT	MIN. CMV BY OCCUPANT	MIN. CMV PER ROOM	MIN. CMV BY ROOM	MIN. CMV PER ROOM	MIN. CMV BY ROOM	MIN. CMV PER ROOM	MIN. CMV BY ROOM
Total							4,021		X Pass <input type="checkbox"/> Fail <input type="checkbox"/> N/A		X Pass <input type="checkbox"/> Fail <input type="checkbox"/> N/A		X Pass <input type="checkbox"/> Fail <input type="checkbox"/> N/A		X Pass <input type="checkbox"/> Fail <input type="checkbox"/> N/A		X Pass <input type="checkbox"/> Fail <input type="checkbox"/> N/A		X Pass <input type="checkbox"/> Fail <input type="checkbox"/> N/A	

CA Building Energy Efficiency Standards - 2016 Nonresidential Compliance May 2016

STATE OF CALIFORNIA  
**MECHANICAL VENTILATION AND REHEAT**  
 CERTIFICATE OF COMPLIANCE  
 Mechanical Ventilation & Reheat  
 Project Name: TI for RIO School District Date Prepared: 4/12/2019  
 NRCC-MCH-03-E (Page 1 of 2)


ACTUAL DESIGN INFO (FROM EQUIPMENT SCHEDULES, ETC)		AREA BASIS		OCCUPANCY BASIS		ROOM BASIS	MINIMUM	VAV Scheduling Primary AS CFM	VAV Deadband Primary AS CFM												
01	02	03	04	05	06	07	08	09	10	11	12	13	14	15	16	17	18	19	20	21	
ZONE (SYSTEM/VAV BOX TAG)	DESIGN PRIMARY COOLING AIRFLOW (CFM)	DESIGN PRIMARY HEATING AIRFLOW (CFM)	DESIGN MAX HEATING AIRFLOW (CFM)	CENTRAL TYPIC (Y/N)	TRANSFER AIRFLOW (CFM)	CONDITIONED (Y/N)	MIN. CMV PER AREA	MIN. CMV BY AREA	MIN. CMV PER AREA	MIN. CMV BY AREA	MIN. CMV PER PERSON	MIN. CMV BY PERSON	MIN. CMV PER OCCUPANT	MIN. CMV BY OCCUPANT	MIN. CMV PER ROOM	MIN. CMV BY ROOM	MIN. CMV PER ROOM	MIN. CMV BY ROOM	MIN. CMV PER ROOM	MIN. CMV BY ROOM	
15	1,440	288	Y		685	0.15	103	3.4	30.0	103		103		X Pass <input type="checkbox"/> Fail <input type="checkbox"/> N/A	720	720		X Pass <input type="checkbox"/> Fail <input type="checkbox"/> N/A	288	288	X Pass <input type="checkbox"/> Fail <input type="checkbox"/> N/A
16	900	180	Y		1,265	0.15	190	6.3	30.0	190		190		X Pass <input type="checkbox"/> Fail <input type="checkbox"/> N/A	450	450		X Pass <input type="checkbox"/> Fail <input type="checkbox"/> N/A	180	190	X Pass <input type="checkbox"/> Fail <input type="checkbox"/> N/A
17	1,355	271	Y		1,260	0.15	189	6.3	30.0	189		189		X Pass <input type="checkbox"/> Fail <input type="checkbox"/> N/A	678	678		X Pass <input type="checkbox"/> Fail <input type="checkbox"/> N/A	271	271	X Pass <input type="checkbox"/> Fail <input type="checkbox"/> N/A
18	1,145	229	Y		680	0.15	102	3.4	30.0	102		102		X Pass <input type="checkbox"/> Fail <input type="checkbox"/> N/A	573	573		X Pass <input type="checkbox"/> Fail <input type="checkbox"/> N/A	229	229	X Pass <input type="checkbox"/> Fail <input type="checkbox"/> N/A
19	3,000	600	Y		1,565	0.15	235	7.8	30.0	235		235		X Pass <input type="checkbox"/> Fail <input type="checkbox"/> N/A	1,500	1,500		X Pass <input type="checkbox"/> Fail <input type="checkbox"/> N/A	600	600	X Pass <input type="checkbox"/> Fail <input type="checkbox"/> N/A
20	1,380	276	Y		1,780	0.15	267	8.9	30.0	267		267		X Pass <input type="checkbox"/> Fail <input type="checkbox"/> N/A	690	690		X Pass <input type="checkbox"/> Fail <input type="checkbox"/> N/A	276	276	X Pass <input type="checkbox"/> Fail <input type="checkbox"/> N/A
21	2,200	440	Y		2,420	0.15	363	12.1	30.0	363		363		X Pass <input type="checkbox"/> Fail <input type="checkbox"/> N/A	1,100	1,100		X Pass <input type="checkbox"/> Fail <input type="checkbox"/> N/A	440	440	X Pass <input type="checkbox"/> Fail <input type="checkbox"/> N/A

CA Building Energy Efficiency Standards - 2016 Nonresidential Compliance May 2016

STATE OF CALIFORNIA  
**MECHANICAL VENTILATION AND REHEAT**  
 CERTIFICATE OF COMPLIANCE  
 Mechanical Ventilation & Reheat  
 Project Name: TI for RIO School District Date Prepared: 4/12/2019  
 NRCC-MCH-03-E (Page 2 of 2)

**DOCUMENTATION AUTHOR'S DECLARATION STATEMENT**  
 I certify that this Certificate of Compliance documentation is accurate and complete.  
 Documentation Author Name: Richard Armado  
 Signature: *Richard Armado*  
 Date: 4/12/2019  
 Company: Kevin A. Smola and Associates  
 Address: 16025 Arrow Hwy Ste C  
 City/State/Zip: Irwindale, CA 91706  
 Phone: 626-585-9338  
**RESPONSIBLE PERSON'S DECLARATION STATEMENT**  
 I certify the following under penalty of perjury, under the laws of the State of California:  
 1. The information provided on this Certificate of Compliance is true and correct.  
 2. I am eligible under Division 3 of the Business and Professions Code to accept responsibility for the building design or system design identified on this Certificate of Compliance (responsible designer).  
 3. The energy features and performance specifications, materials, components, and manufactured devices for the building design or system design identified on this Certificate of Compliance conform to the requirements of Title 24, Part 1 and Part 6 of the California Code of Regulations.  
 4. The building design features or system design features identified on this Certificate of Compliance are consistent with the information provided on other applicable compliance documents, worksheets, calculations, plans and specifications submitted to the enforcement agency for approval with this building permit application.  
 5. I will ensure that a completed signed copy of this Certificate of Compliance shall be made available with the building permit(s) issued for the building, and made available to the enforcement agency for all applicable inspections. I understand that a completed signed copy of this Certificate of Compliance is required to be included with the documentation the BOM provides to the building owner at occupancy.  
 Responsible Designer Name: Kevin A. Smola  
 Signature: *Kevin A. Smola*  
 Date Signed: 4/12/19  
 Company: Kevin A. Smola and Associates  
 Address: 16025 Arrow Hwy Ste C  
 City/State/Zip: Irwindale, CA 91706  
 License: M21106  
 Phone: 626-585-9338

CA Building Energy Efficiency Standards - 2016 Nonresidential Compliance May 2016

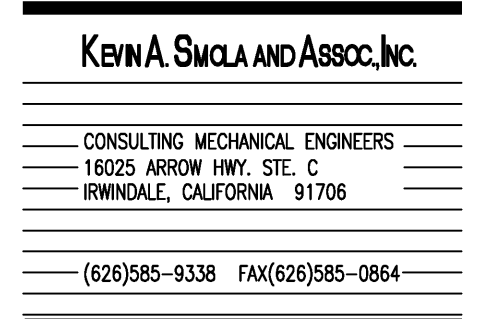

TENANT IMPROVEMENTS FOR  
 1800 N SOLAR DRIVE - 3RD FLOOR  
 OXNARD, CALIFORNIA

all drawings and written material appearing herein constitute the original and unaltered work of the architect and the same may not be duplicated, used or disclosed without the written consent of the architect.

remarks	date
PLAN CHECK SUBMIT.	04.15.19
BID SUBMIT.	04.22.19
P.C. CORRECT / ADD - B.	05.30.19

sheet title

MECHANICAL  
 TITLE 24 FORMS

drawn by: cm  
 project no: 40028  
 date: 06/18/19  
 scale: PS 3/4"=1'-0"

MT24

































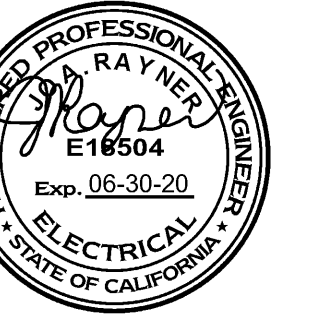

TENANT IMPROVEMENTS FOR:

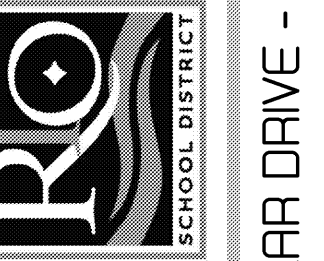

1800 N SOLAR DRIVE - 3RD FLOOR  
OXNARD, CALIFORNIA

all drawings and written material appearing herein constitute the original and unqualified work of the architect and the same may not be duplicated, used or disclosed without the written consent of the architect.

remarks date

PLAN CHECK SUBMIT. 04/15/19  
ISSUED FOR BID/ADD-R. 04/30/19

P.C. CORRECT/ADD-B. 05/30/19

sheet title

POWER FLOOR PLAN (NORTH)


drawn by

project no. 18-87.60


date

scale


E-2.1

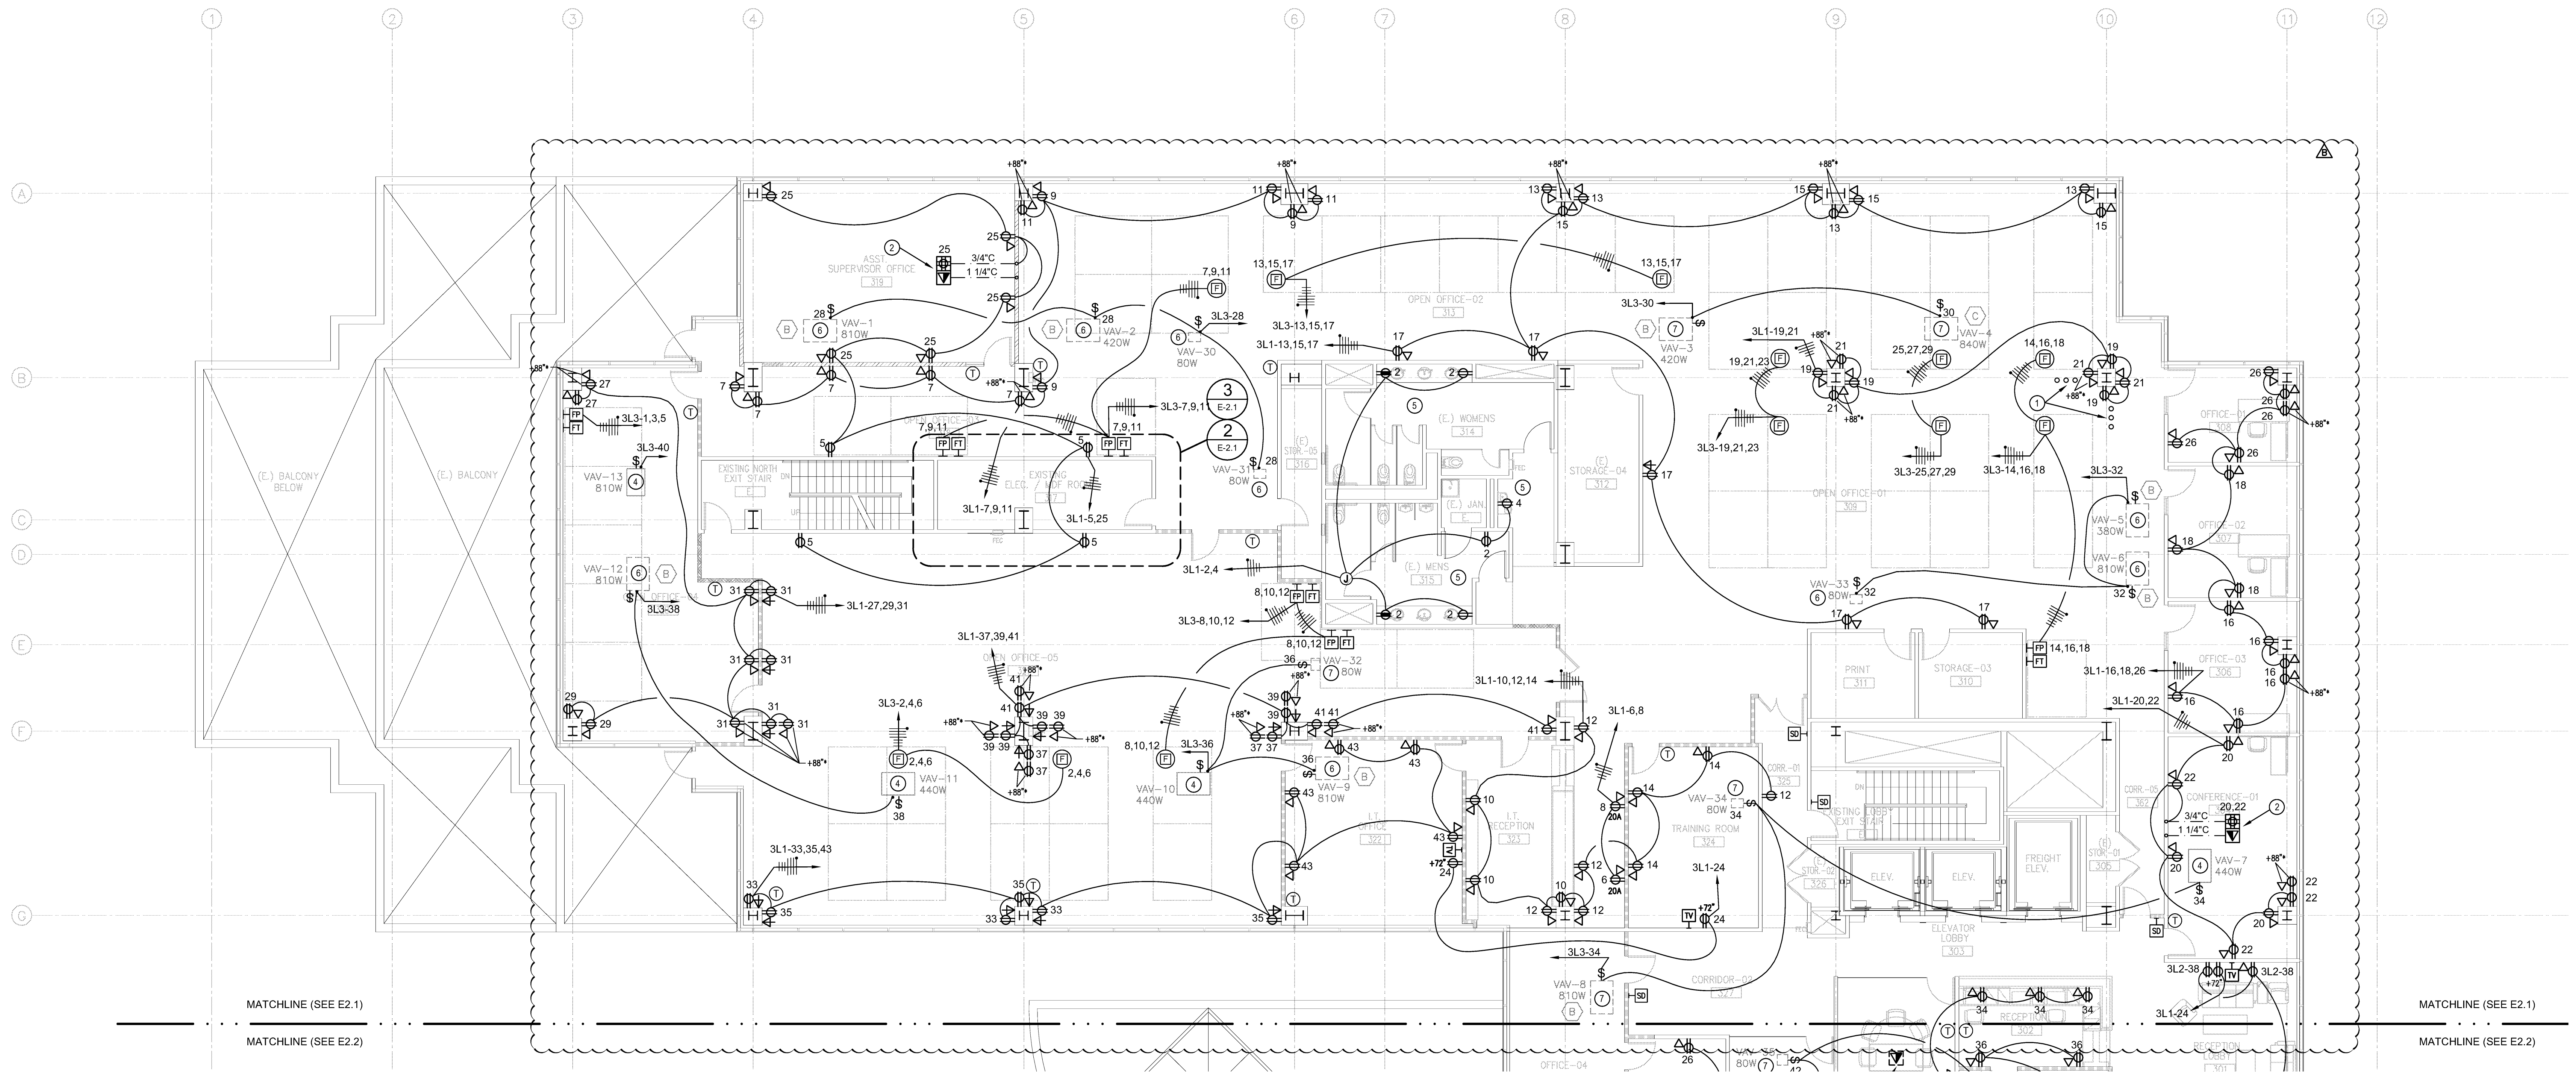

1 POWER FLOOR PLAN (NORTH)  
E-2.1 1/8" = 1'-0"

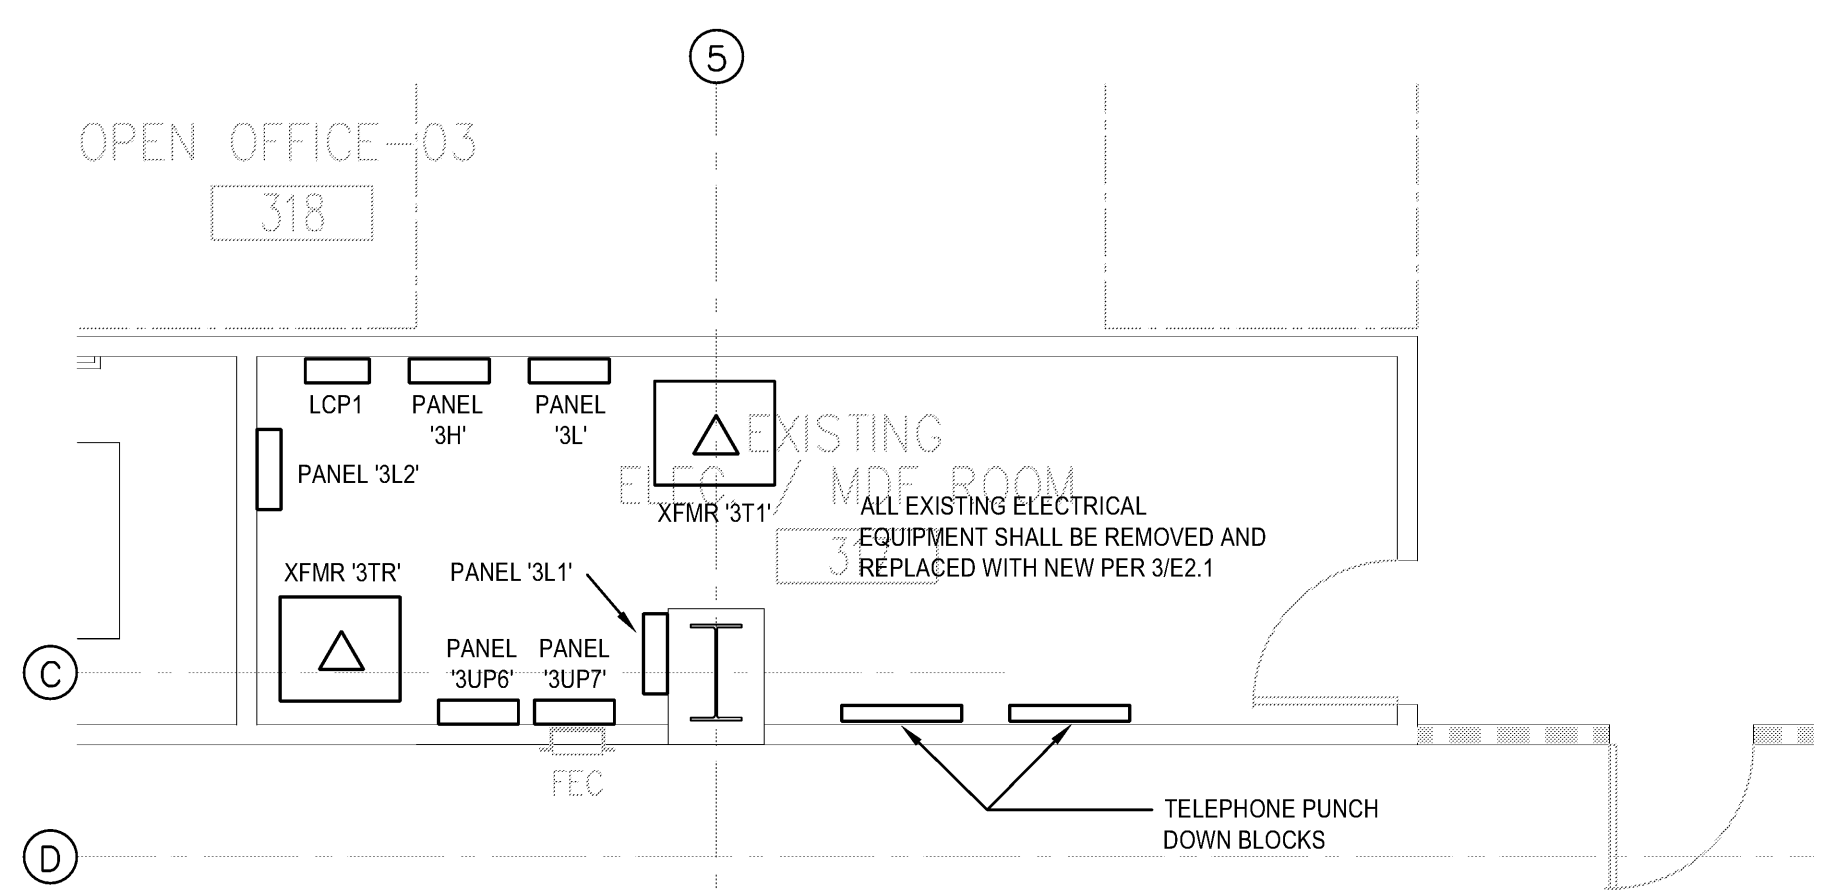

2 ENLARGED ELECTRICAL ROOM #317 DEMOLITION PLAN  
E-2.1 1/4" = 1'-0"

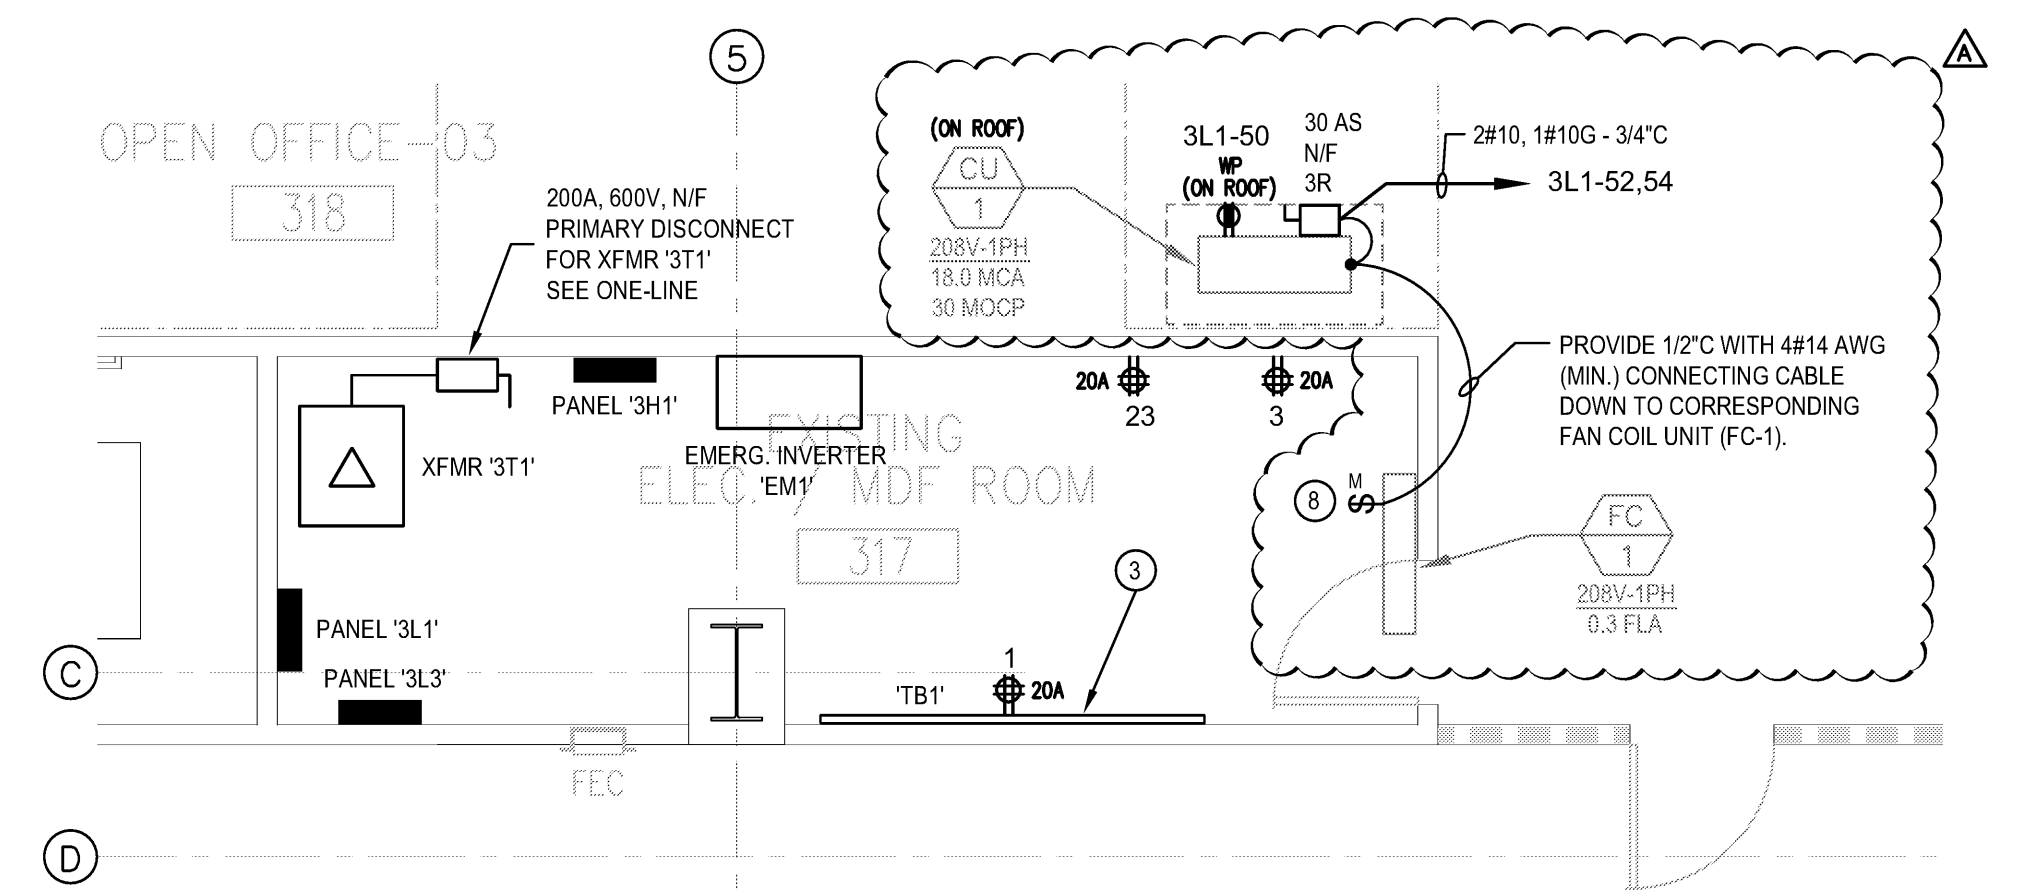

3 ENLARGED ELECTRICAL ROOM #317 NEW CONSTRUCTION PLAN  
E-2.1 1/4" = 1'-0"

KEY NOTES: #

- REMOVE EXISTING 3" CONDUIT STUBS AND PATCH FLOOR TO MATCH EXISTING.
- FIELD VERIFY FINAL LOCATION OF FLOOR BOXES WITH TENANT/ FURNITURE VENDOR PRIOR TO CORING.
- PROVIDE TELECOMMUNICATIONS BACKBOARD PER 2/E-0.1.
- NEW VAV BOX. SEE MECHANICAL.
- RESTROOM AND DRINKING FOUNTAIN RECEPTACLES ARE EXISTING. REPLACE WITH NEW AS INDICATED AND RE-CIRCUIT AS REQUIRED PER THE CONSTRUCTION DOCUMENTS.
- EXISTING VAV BOX TO REMAIN. RECONNECT AS INDICATED. SEE MECHANICAL.
- EXISTING VAV BOX TO BE RELOCATED. EXTEND OR PROVIDE NEW CONDUCTORS AND RE-CIRCUIT AS INDICATED. SEE MECHANICAL.
- FAN COIL UNIT (FC) POWERED FROM CORRESPONDING CONDENSING UNIT ON ROOF. PROVIDE 3-POLE MOTOR-RATED TOGGLE SWITCH ABOVE CEILING AND CONNECT FC.

GENERAL SHEET NOTES:

- ALL DEVICES ON THIS SHEET SHALL BE CIRCUITED TO PANEL "3L1", UNLESS INDICATED OTHERWISE.
- PROVIDE CONDUIT, J-BOXES, AND BACKBOXES AS REQUIRED TO ACCOMMODATE INSTALLATION OF THE HVAC LOW VOLTAGE CONTROLS AS INDICATED ON THE MECHANICAL PLANS.
- ALL ROOFTOP EQUIPMENT AND COMPONENTS SHALL BE INSTALLED IN ACCORDANCE WITH MANUFACTURER'S INSTRUCTIONS AND LOCAL CODE REQUIREMENTS.
- FIELD VERIFY FINAL LOCATIONS OF ROOFTOP EQUIPMENT WITH ARCHITECTURAL AND MECHANICAL PLANS PRIOR TO ROUGH-IN.
- ROOFTOP EQUIPMENT/ DEVICES SHALL BE WEATHERPROOF TYPE.
- CONDUITS FEEDING ROOFTOP EQUIPMENT/ DEVICES SHALL BE LESS THAN 5' SOLAR EXPOSED.
- PROVIDE FINAL CONNECTIONS PER EQUIPMENT LABEL.
- ALL ROOF PENETRATION SHALL BE SEALED BY A LICENSED ROOFER.
- ALL CONDUIT INSTALLED ON ROOF SHALL BE IMC OR RGC.
- FOR THE CONNECTION BETWEEN THE INDOOR AND OUTDOOR FAN COIL UNIT, PROVIDE OUTDOOR AND WATERPROOF CONNECTION CABLE RATED MINIMUM 300V AND CONFORMING TO 60245 IEC 57.

MOUNTING NOTES:

\* MOUNTING HEIGHT INDICATED ASSUMES A STANDARD 9' CEILING. OUTLET SHALL BE INSTALLED 20" BELOW THE FINISHED CEILING.






all drawings and written material appearing herein constitute the original and unaltered work of the architect and the same may not be duplicated used or disclosed without the written consent of the architect.

remarks	date
PLAN CHECK SUBMIT.	04/15/19
ISSUED FOR BID/ADD-R	04/30/19
P.C. CORRECT/ADD-B	05/30/19


sheet title

POWER FLOOR PLAN (SOUTH)


drawn by  
project no. 18-8760  
date  
scale

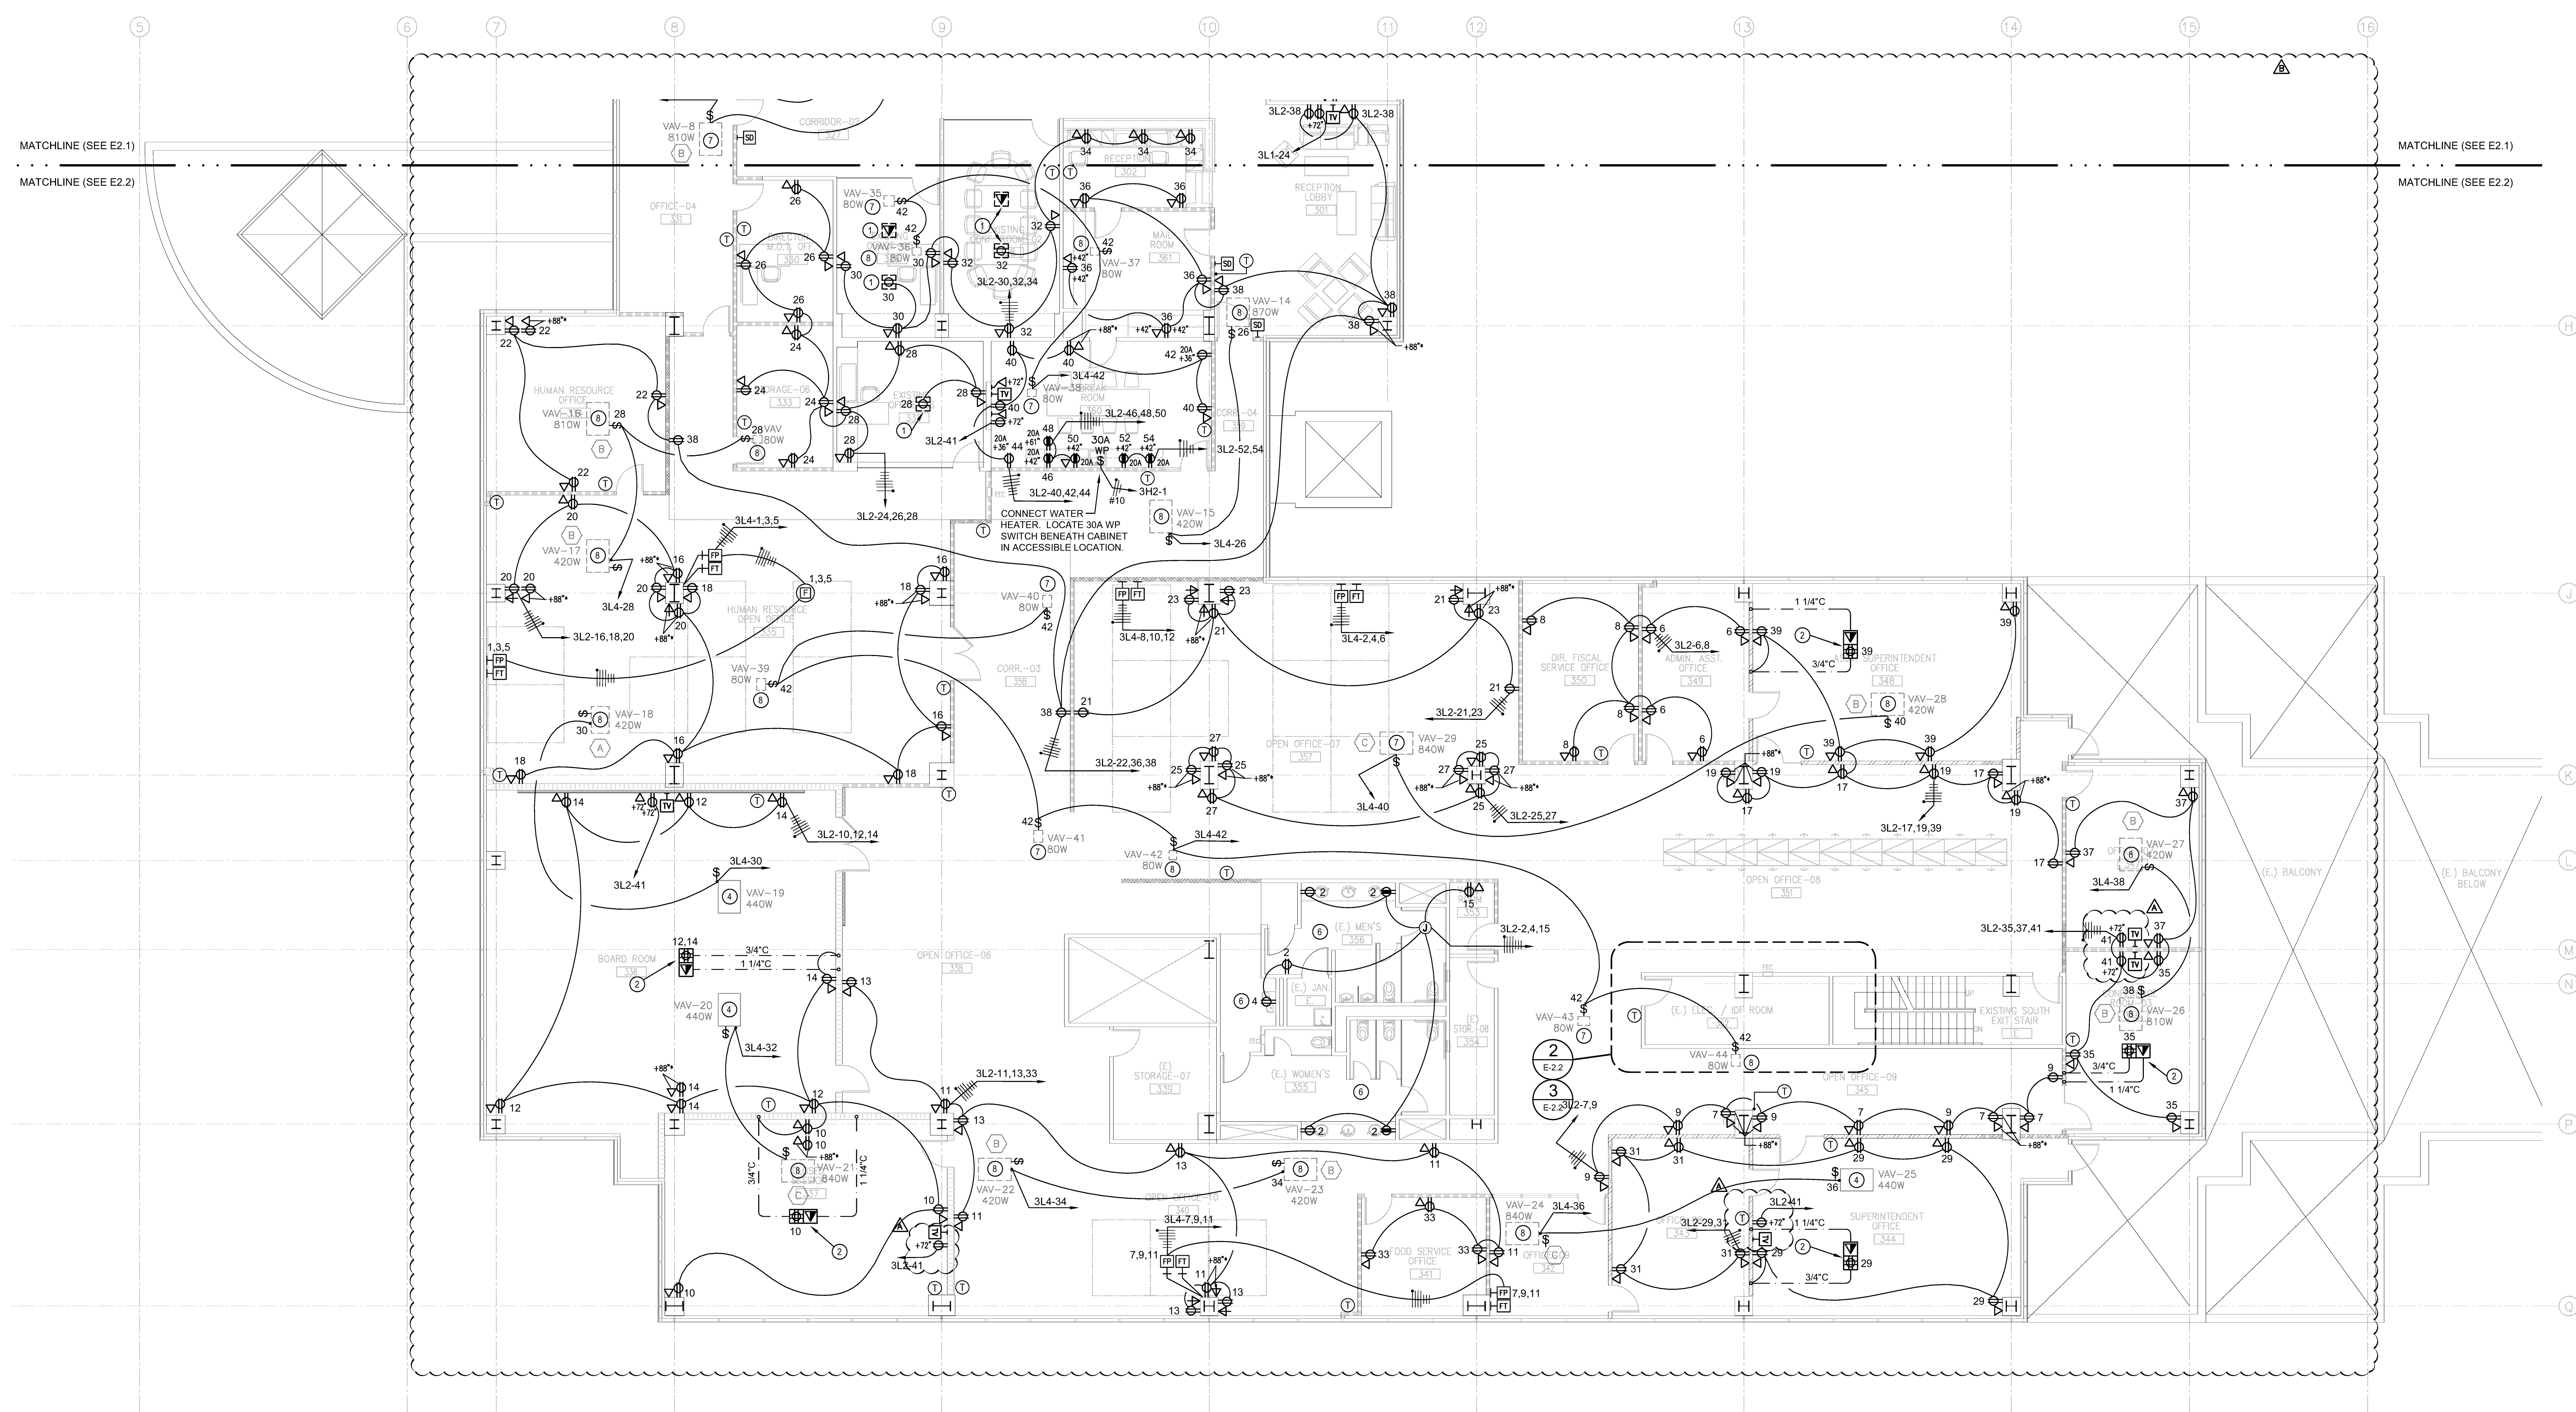

1 POWER FLOOR PLAN (SOUTH)  
E-2.2 1/8" = 1'-0"

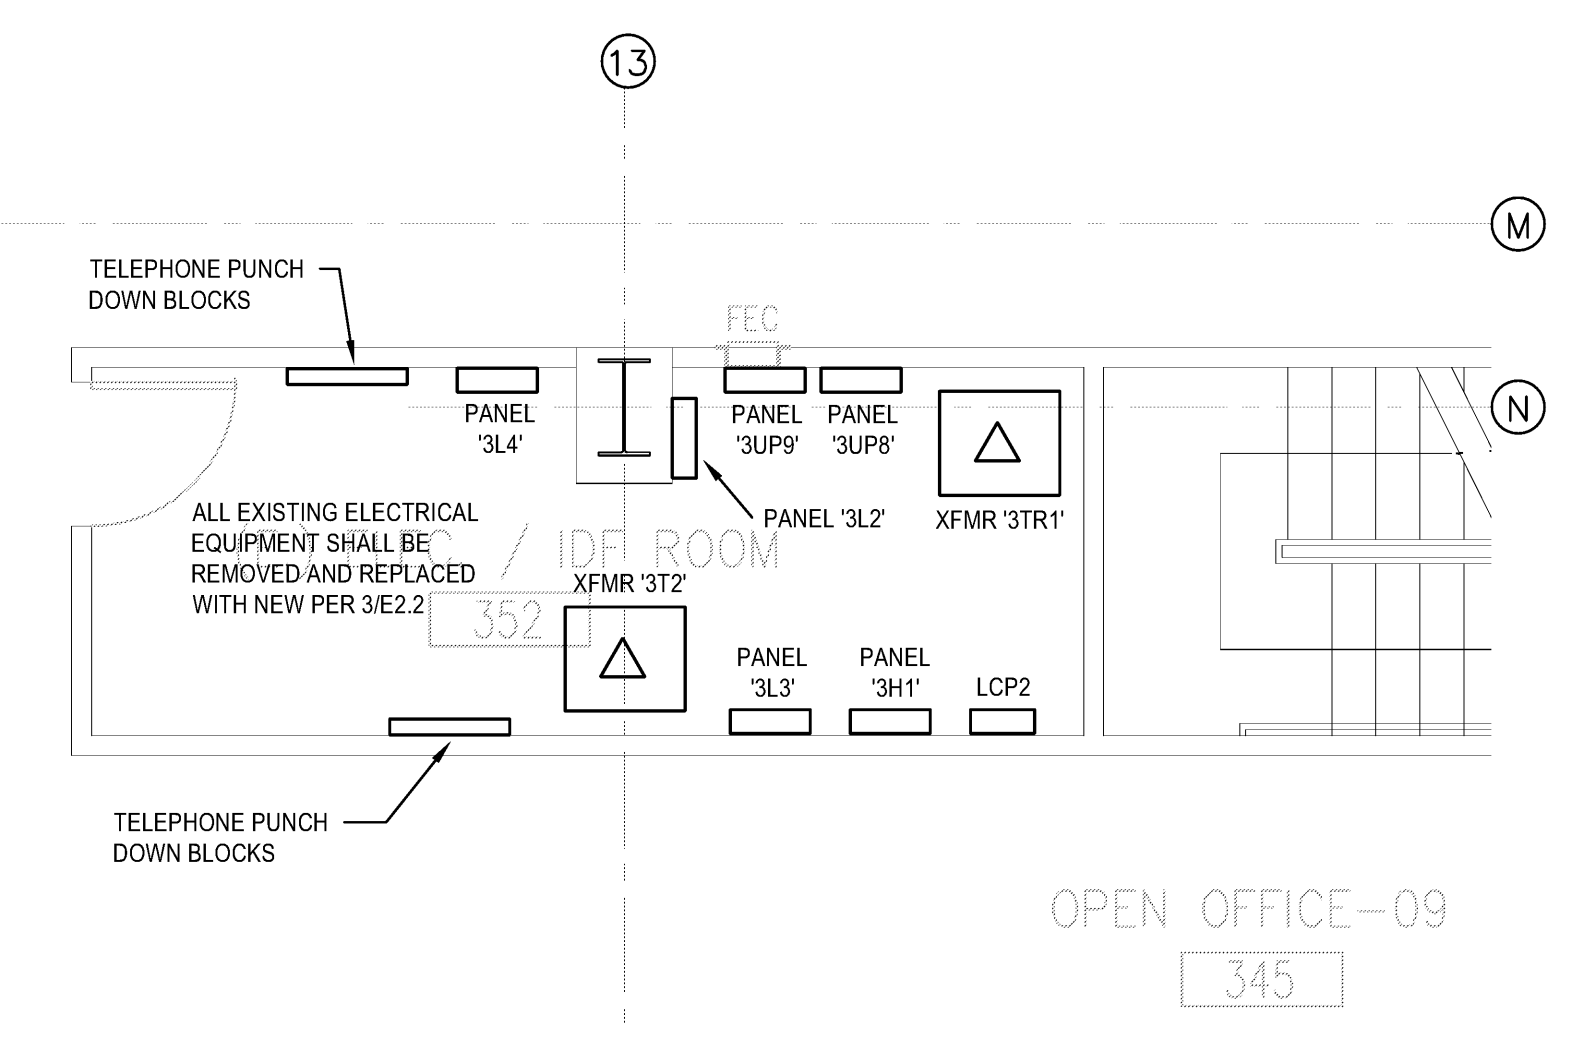

2 ENLARGED ELECTRICAL ROOM #352 DEMOLITION PLAN  
E-2.2 1/4" = 1'-0"

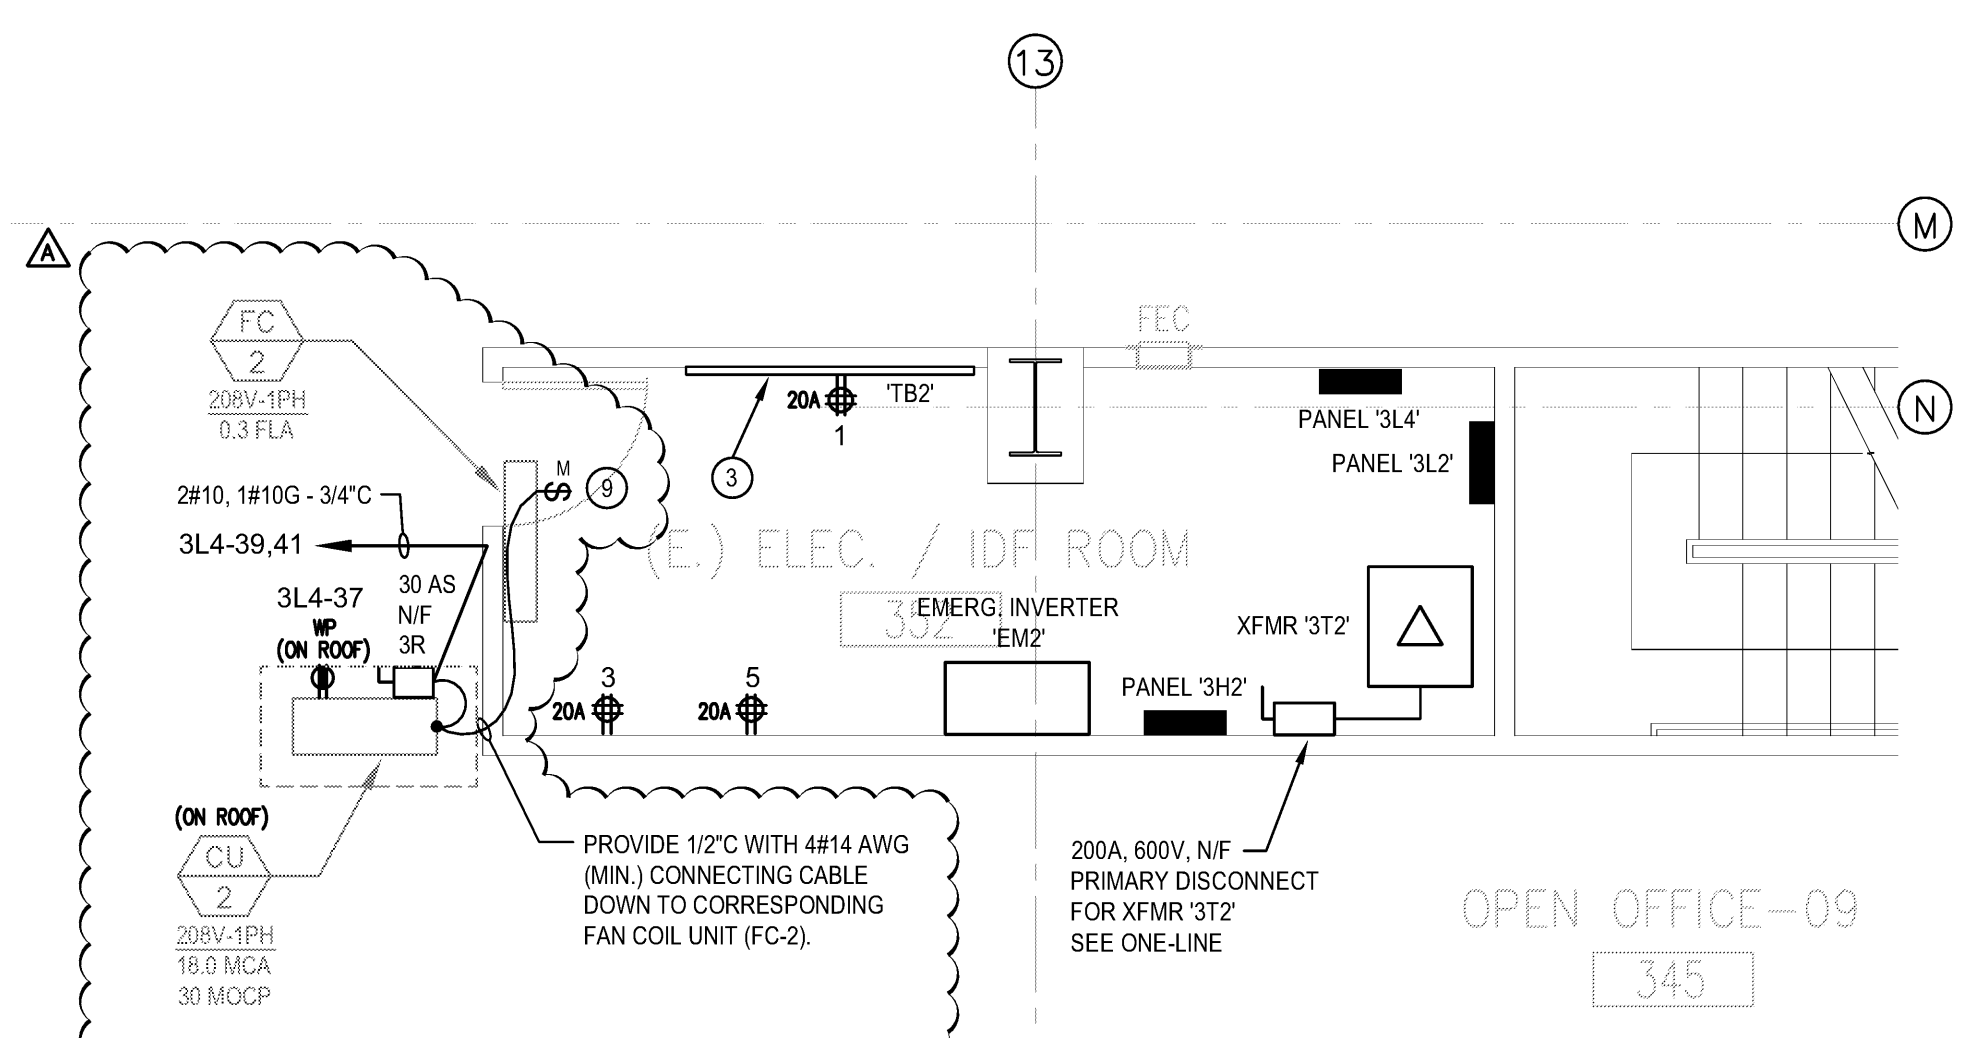

3 ENLARGED ELECTRICAL ROOM #352 NEW CONSTRUCTION PLAN  
E-2.2 1/4" = 1'-0"

KEY NOTES:

- EXISTING POKE-THRU FLOOR BOXES TO REMAIN. RE-CIRCUIT AS INDICATED.
- FIELD VERIFY FINAL LOCATION OF FLOOR BOXES WITH TENANT/ FURNITURE VENDOR PRIOR TO CORING.
- PROVIDE TELECOMMUNICATIONS BACKBOARD PER 2/E-0.1.
- NEW VAV BOX. SEE MECHANICAL.
- NOT USED.
- RESTROOM AND DRINKING FOUNTAIN RECEPTACLES ARE EXISTING. REPLACE WITH NEW AS INDICATED AND RE-CIRCUIT AS REQUIRED PER THE CONSTRUCTION DOCUMENTS.
- EXISTING VAV BOX TO REMAIN. RECONNECT AS INDICATED. SEE MECHANICAL.
- EXISTING VAV BOX TO BE RELOCATED. EXTEND OR PROVIDE NEW CONDUCTORS AND RE-CIRCUIT AS INDICATED. SEE MECHANICAL.
- FAN COIL UNIT (FC) POWERED FROM CORRESPONDING CONDENSING UNIT ON ROOF. PROVIDE 3-POLE MOTOR-RATED TOGGLE SWITCH ABOVE CEILING AND CONNECT FC.

GENERAL SHEET NOTES:

- ALL DEVICES ON THIS SHEET SHALL BE CIRCUITED TO PANEL "3L2", UNLESS INDICATED OTHERWISE.
- PROVIDE CONDUIT, J-BOXES, AND BACKBOXES AS REQUIRED TO ACCOMMODATE INSTALLATION OF THE HVAC LOW VOLTAGE CONTROLS AS INDICATED ON THE MECHANICAL PLANS.
- ALL ROOFTOP EQUIPMENT AND COMPONENTS SHALL BE INSTALLED IN ACCORDANCE WITH MANUFACTURER'S INSTRUCTIONS AND LOCAL CODE REQUIREMENTS.
- FIELD VERIFY FINAL LOCATIONS OF ROOFTOP EQUIPMENT WITH ARCHITECTURAL AND MECHANICAL PLANS PRIOR TO ROUGH-IN.
- ROOFTOP EQUIPMENT/ DEVICES SHALL BE WEATHERPROOF TYPE.
- CONDUITS FEEDING ROOFTOP EQUIPMENT/ DEVICES SHALL BE LESS THAN 5' SOLAR EXPOSED.
- PROVIDE FINAL CONNECTIONS PER EQUIPMENT LABEL.
- ALL ROOF PENETRATION SHALL BE SEALED BY A LICENSED ROOFER.
- ALL CONDUIT INSTALLED ON ROOF SHALL BE IMC OR RGC.
- FOR THE CONNECTION BETWEEN THE INDOOR AND OUTDOOR FAN COIL UNIT, PROVIDE OUTDOOR AND WATERPROOF CONNECTION CABLE RATED MINIMUM 300V AND CONFORMING TO 69245 IEC 57.







PANEL NAME		3H1		VOLT: 480Y277		BUS SIZE: 125 AMPS						AFC: 12,000 A			
LOCATION: ELEC 317		PH: 3		MAIN BRKR: 100 AMPS						AIC: 14,000 A					
NOTES	LOAD DESCRIPTION	TYPE	BRKR	CCT	V.A.	V.A.	V.A.	V.A.	V.A.	V.A.	CCT	BRKR	TYPE	LOAD DESCRIPTION	NOTES
	TOILET LITG	L	201	1	1290					1066	2	201	L	LIGHTING INVERTER EM1	
	LOBBY LITG	L	201	3		420				0	4	201	L	SPARE	
	OPEN OFFICE 309 LIGHTING	L	201	5			2987			0	6	201	L	SPARE	
	OPEN OFFICE 321 LIGHTING	L	201	7	2510					0	8	201	L	SPARE	
	OFFICE & LOBBY LIGHTING	L	201	9		1902				0	10	201	L	SPARE	
	SPACE ONLY			11						0	12	201	L	SPARE	
	SPACE ONLY			13	0					0	14	201	L	SPACE ONLY	
	SPACE ONLY			15		0				0	16	201	L	SPACE ONLY	
	SPACE ONLY			17						0	18	201	L	SPACE ONLY	
	SPACE ONLY			19	0					0	20	201	L	SPACE ONLY	
	SPACE ONLY			21		0				0	22	201	L	SPACE ONLY	
	SPACE ONLY			23			0			0	24	201	L	SPACE ONLY	
	SPACE ONLY			25	0					0	26	201	L	SPACE ONLY	
	SPACE ONLY			27		0				0	28	201	L	SPACE ONLY	
	SPACE ONLY			29			0			0	30	201	L	SPACE ONLY	
	SPACE ONLY			31	0					0	32	201	L	SPACE ONLY	
	SPACE ONLY			33		0				0	34	201	L	SPACE ONLY	
	SPACE ONLY			35			0			0	36	201	L	SPACE ONLY	
	SPACE ONLY			37	0					0	38	201	L	SPACE ONLY	
	SPACE ONLY			39		0				0	40	201	L	SPACE ONLY	
	SPACE ONLY			41			0			0	42	201	L	SPACE ONLY	

PER PHASE TOTAL VA	4666	2322	2687
TOTAL CONNECTED VA	10175 VA		
TOTAL CONNECTED AMPS	12 AMPS		
3x HIGHEST PHASE	14568 VA		
HIGHEST AMPS	18 AMPS		

LOAD TYPE	CONNECTED	MULTIPLIER	TOTAL
L = LIGHTING	10175	X 1.25 =	12719
C = CONTINUOUS	0	X 1.25 =	0
LM = LARGEST MOTOR	0	X 1.25 =	0
M = REMAINING MOTORS	0	X 1 =	0
N = NON-CONTINUOUS	0	X 1 =	0
R = RECEPTACLE	0	* =	0
TOTAL CALCULATED LOAD (VA)	= 12719		
TOTAL CALCULATED AMPS	= 15		

\* 1ST 10KVA + (-10KVA)/2

PANEL NAME		3H2		VOLT: 480Y277		BUS SIZE: 125 AMPS						AFC: 12,000 A			
LOCATION: ELEC 352		PH: 3		MAIN BRKR: 100 AMPS						AIC: 14,000 A					
NOTES	LOAD DESCRIPTION	TYPE	BRKR	CCT	V.A.	V.A.	V.A.	V.A.	V.A.	V.A.	CCT	BRKR	TYPE	LOAD DESCRIPTION	NOTES
	BREAK RM WTR HTR	N	301	1	6000					1093	2	201	L	LIGHTING INVERTER EM2	
	SPARE			3						0	4	201	L	SPACE ONLY	
	SPARE			5						0	6	201	L	SPACE ONLY	
	SPARE			7	0					0	8	201	L	SPACE ONLY	
	SPARE			9						0	10	201	L	SPACE ONLY	
	HUMAN RES. LIGHTING	L	201	11				2311		0	12	201	L	SPACE ONLY	
	OPEN OFFICE 357 LIGHTING	L	201	13	3159					0	14	201	L	SPACE ONLY	
	ADMIN OFFICE LIGHTING	L	201	15		2688				0	16	201	L	SPACE ONLY	
	SPACE ONLY			17						0	18	201	L	SPACE ONLY	
	SPACE ONLY			19	0					0	20	201	L	SPACE ONLY	
	SPACE ONLY			21		0				0	22	201	L	SPACE ONLY	
	SPACE ONLY			23			0			0	24	201	L	SPACE ONLY	
	SPACE ONLY			25	0					0	26	201	L	SPACE ONLY	
	SPACE ONLY			27		0				0	28	201	L	SPACE ONLY	
	SPACE ONLY			29			0			0	30	201	L	SPACE ONLY	
	SPACE ONLY			31	0					0	32	201	L	SPACE ONLY	
	SPACE ONLY			33		0				0	34	201	L	SPACE ONLY	
	SPACE ONLY			35			0			0	36	201	L	SPACE ONLY	
	SPACE ONLY			37	0					0	38	201	L	SPACE ONLY	
	SPACE ONLY			39		0				0	40	201	L	SPACE ONLY	
	SPACE ONLY			41			0			0	42	201	L	SPACE ONLY	

PER PHASE TOTAL VA	10252	2688	2311
TOTAL CONNECTED VA	15251 VA		
TOTAL CONNECTED AMPS	18 AMPS		
3x HIGHEST PHASE	30756 VA		
HIGHEST AMPS	37 AMPS		

LOAD TYPE	CONNECTED	MULTIPLIER	TOTAL
L = LIGHTING	9251	X 1.25 =	11564
C = CONTINUOUS	0	X 1.25 =	0
LM = LARGEST MOTOR	0	X 1.25 =	0
M = REMAINING MOTORS	0	X 1 =	0
N = NON-CONTINUOUS	6000	X 1 =	6000
R = RECEPTACLE	0	* =	0
TOTAL CALCULATED LOAD (VA)	= 17564		
TOTAL CALCULATED AMPS	= 21		

\* 1ST 10KVA + (-10KVA)/2

PANEL NAME		3L1		VOLT: 208Y120		BUS SIZE: 225 AMPS						AFC: 4,500 A			
LOCATION: ELEC 317		PH: 3		MAIN BRKR: 225 AMPS						AIC: 10,000 A					
NOTES	LOAD DESCRIPTION	TYPE	BRKR	CCT	V.A.	V.A.	V.A.	V.A.	V.A.	V.A.	CCT	BRKR	TYPE	LOAD DESCRIPTION	NOTES
	TELEPHONE BACKBRD	R	201	1	360					900	2	201	R	RESTROOM RECEPS	
	DATA RACK	N	201	3		1000				400	4	201	N	DRINKING FOUNTAIN	GF
	OPEN OFFICE 318 RECEPS	R	201	5				720			6	201	N	COPY MACHINE	
	OPEN OFFICE 318 RECEPS	R	201	7	900					800	8	201	N	COPY MACHINE	
	OPEN OFFICE 313 RECEPS	R	201	9		540				540	10	201	R	MAIL RM RECEPS	
	OPEN OFFICE 313 RECEPS	R	201	11			540			900	12	201	R	MAIL CORR. RECEPS	
	OPEN OFFICE 313 RECEPS	R	201	13	720					540	14	201	R	OFFICE 324 RECEPS	
	OPEN OFFICE 313 RECEPS	R	201	15		720				1080	16	201	R	OFFICE 306 RECEPS	
	OFFICE COMMON RECEPS	R	201	17				900		540	18	201	R	OFFICE 307 RECEPS	
	OPEN OFFICE 309 RECEPS	R	201	19	720			720			20	201	R	CONFERENCE 304 RECEPS	
	OPEN OFFICE 309 RECEPS	R	201	21		720				900	22	201	R	CONFERENCE 304 RECEPS	
	DATA RACK	N	201	23			1000			600	24	201	N	TV RECEPS	
	ASST. SUPERVISOR RECEPS	R	201	25	1260			900			26	201	R	OFFICE 308 RECEPS	
	OPEN OFFICE 320 RECEPS	R	201	27		360				0	28	201	R	SPARE	
	OPEN OFFICE 320 RECEPS	R	201	29			360			0	30	201	R	SPARE	
	OPEN OFFICE 320 RECEPS	R	201	31	1260					0	32	201	R	SPARE	
	OPEN OFFICE 321 RECEPS	R	201	33		540				0	34	201	R	SPARE	
	OPEN OFFICE 321 RECEPS	R	201	35			540			0	36	201	R	SPARE	
	OPEN OFFICE 321 RECEPS	R	201	37	720					0	38	201	R	SPACE ONLY	
	OPEN OFFICE 321 RECEPS	R	201	39			1080			0	40	201	R	SPACE ONLY	
	OPEN OFFICE 321 RECEPS	R	201	41				900		0	42	201	R	SPACE ONLY	
	OFFICE 322 RECEPS	R	201	43	900					0	44	201	R	SPACE ONLY	
	SPACE ONLY			45		0				0	46	201	R	SPACE ONLY	
	SPACE ONLY			47		0				0	48	201	R	SPACE ONLY	
	SUB-FEED TO PANEL 3L3*	N	125	49	11430					180	50	201	R	ROOF RECP	
		N	/	51		12280				1650	52	30	M		
		N	3	53						11900	54	/2	M	FC-11/ CU-1	

NOTES: GF1: PROVIDE GF1 TYPE BREAKER

PER PHASE TOTAL VA	22310	21810	21350
TOTAL CONNECTED VA	65470 VA		
TOTAL CONNECTED AMPS	182 AMPS		
3x HIGHEST PHASE	66930 VA		
HIGHEST AMPS	186 AMPS		

LOAD TYPE	CONNECTED	MULTIPLIER	TOTAL
L = LIGHTING	0	X 1.25 =	0
C = CONTINUOUS	0	X 1.25 =	0
LM = LARGEST MOTOR	0	X 1.25 =	0
M = REMAINING MOTORS	3300	X 1 =	3300
N = NON-CONTINUOUS	40210	X 1 =	40210
R = RECEPTACLE	21960	* =	15980
TOTAL CALCULATED LOAD (VA)	= 59490		
TOTAL CALCULATED AMPS	= 165		

\* 1ST 10KVA + (-10KVA)/2

PANEL NAME		3L2		VOLT: 208Y120		BUS SIZE: 225 AMPS						AFC: 4,500 A			
LOCATION: ELEC 352		PH: 3		MAIN BRKR: 225 AMPS						AIC: 10,000 A					
NOTES	LOAD DESCRIPTION	TYPE	BRKR	CCT	V.A.	V.A.	V.A.	V.A.	V.A.	V.A.	CCT	BRKR	TYPE	LOAD DESCRIPTION	NOTES
	TELEPHONE BACKBRD	R	201	1	360					900	2	201	R	RESTROOM RECEPS	
	DATA RACK	N	201	3		1000				400	4	201	N	DRINKING FOUNTAIN	GF
	DATA RACK	N	201	5				1000			6	201	R	ADMIN. ASST. 349 RECEPS	
	OPEN OFFICE 345 RECEPS	R	201	7	720					720	8	201	R	DIR. FISCAL SERVICE RECEPS	
	OPEN OFFICE 345 RECEPS	R	201	9		900				1080	10	201	R	CLOSED SESSION 337 RECEPS	
	OPEN OFFICE 340 RECEPS	R	201	11			900			720	12	201	R	BOARD RM 336 RECEPS	
	OPEN OFFICE 340 RECEPS	R	201	13	900					1080	14	201	R	BOARD RM 336 RECEPS	
</															



