
# SHOPS at MAIN STREET

exterior building improvements

541 N. MAIN STREET, CORONA, CA 92880

BUILDING 'B'



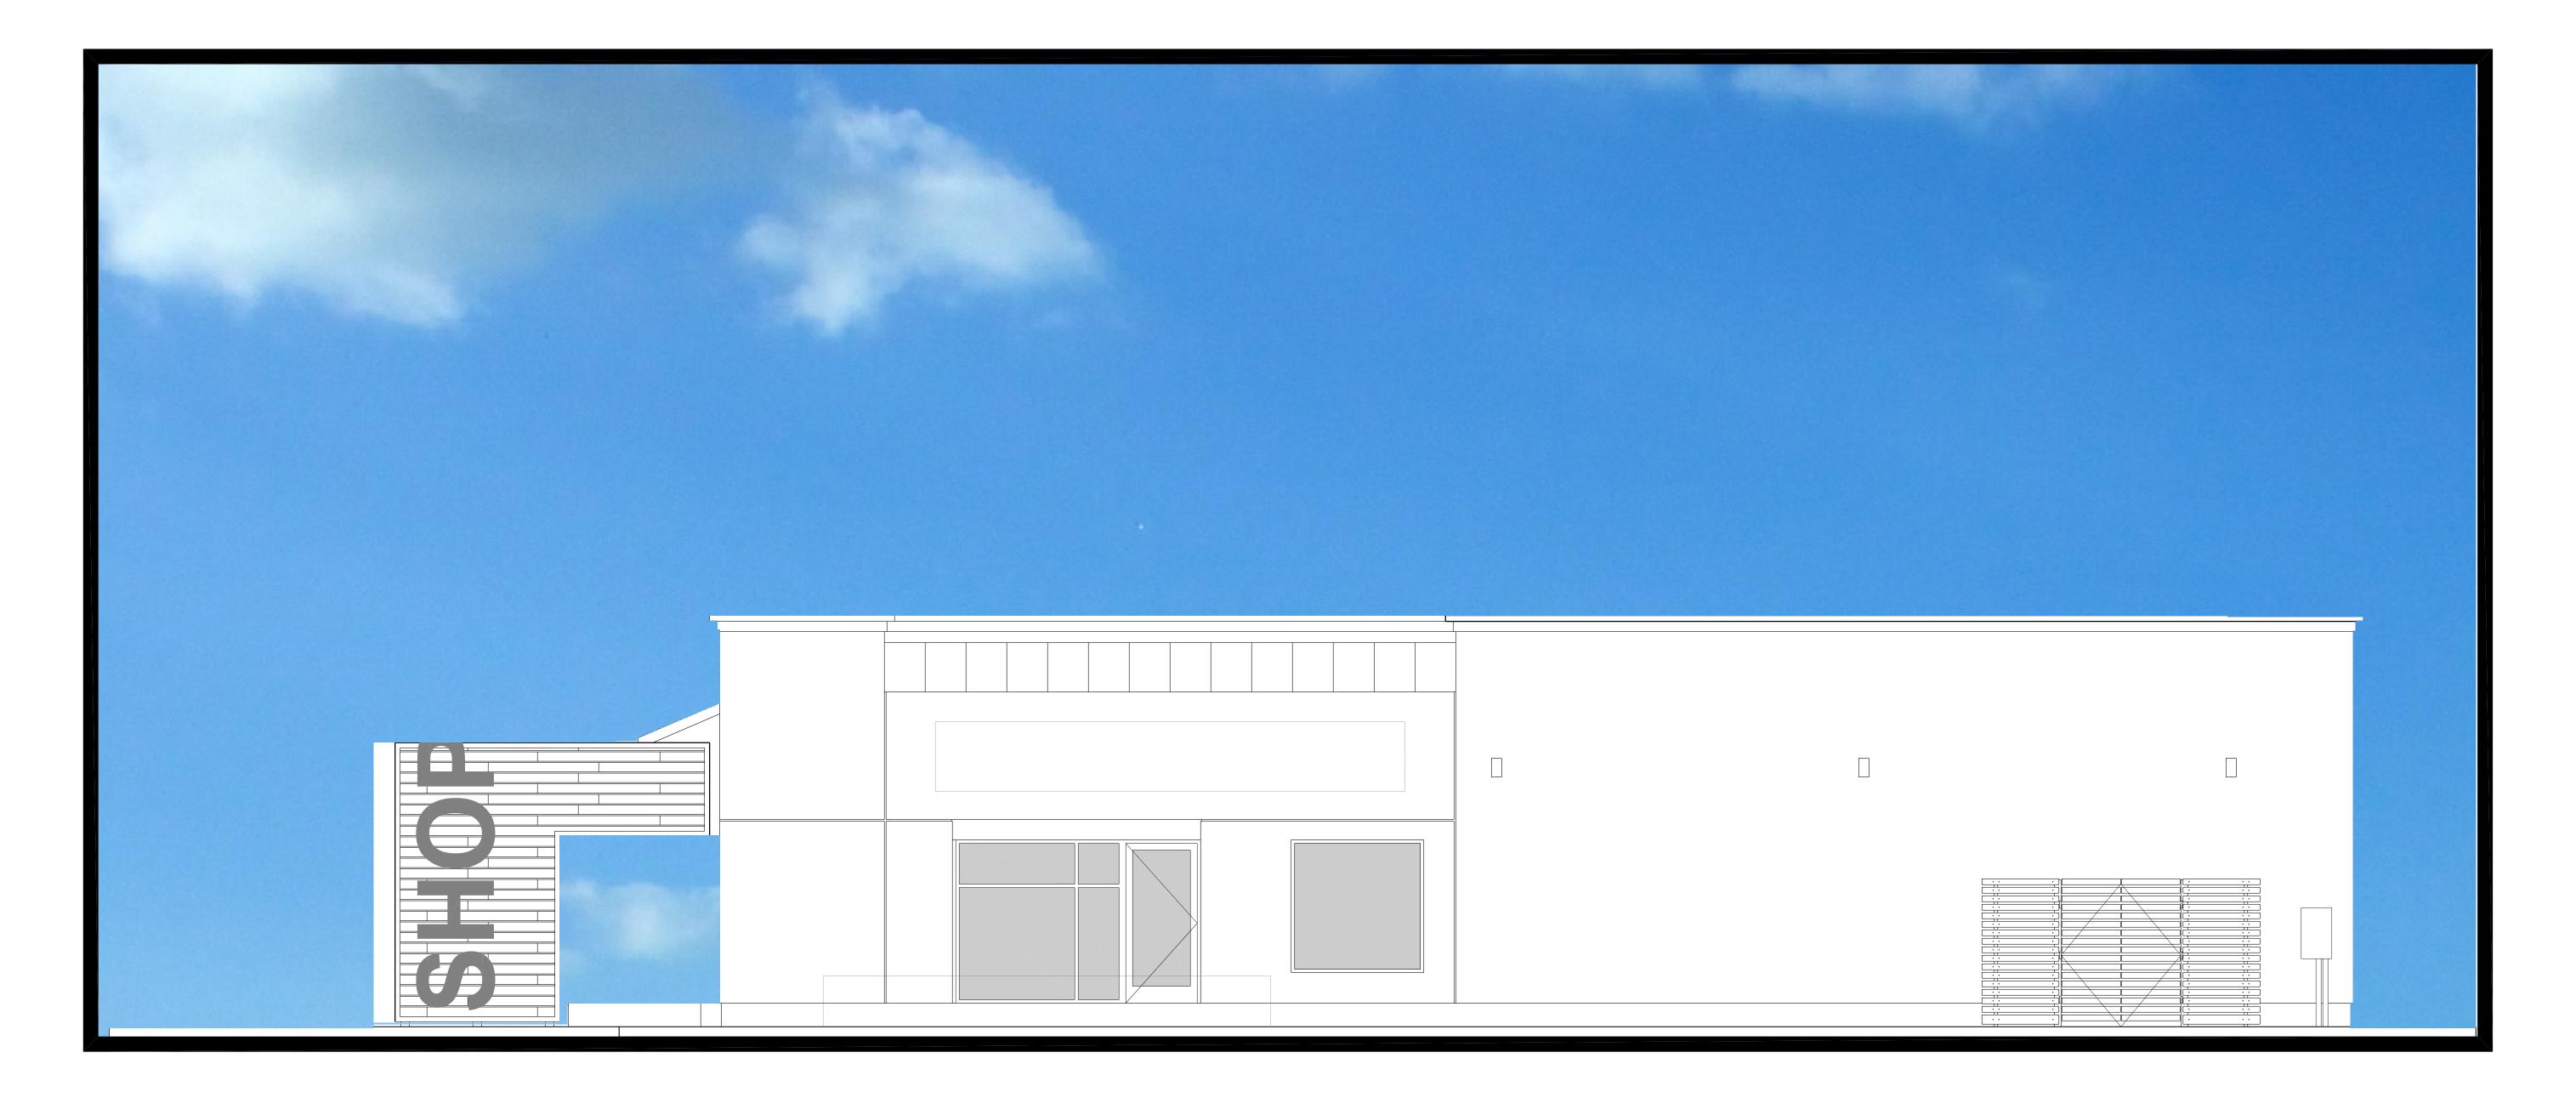





### 22. EXTERIOR FACADE PLASTER SPALL REPAIRS

### GENERAL

- F. ALL WASTE MATERIALS, e.g. SPALLED PLASTER AND REPAIR DEBRIS, AS WELL AS REMOVED FOLIAGE, ARE TO BE REMOVED FROM THE SITE BY THE CONTRACTOR AT THE CONTRACTOR'S EXPENSE.
- G. AS DETERMINED NECESSARY BY CONTRACTOR TO MEET PERFORMANCE REQUIREMENTS OF NEW WORK ON EXISTING SUBSTRATE, CONTRACTOR TO PERFORM PETROGRAPHIC EXAMINATION AND CHEMICAL ANALYSIS (ASTM C 1324) ON A SAMPLE OF THE EXISTING PLASTER TO DETERMINE ITS MIX COMPONENTS. MIX COMPONENTS SHALL BE VERIFIED TO MEET TYPE NECESSARY TO OBTAIN BONDING REQUIREMENTS AND PREVENT STAINING OF WORK.

### EXECUTION OF WORK:

- A. CONTRACTOR TO REPAIR ALL SPALLING AND DAMAGE OF EXTERIOR PLASTER FACADE. B. CONTRACTOR TO PERFORMWORK AS INDICATED IN PROJECT DOCUMENTATION INCLUDING
- SPECIFICATIONS AND DRAWINGS. C. REPAIR WORK SHALL BE IDENTIFIED BY CRACK REPAIR TYPE AND SIZE AS INDICATED IN SPECIFICATION 092400 "CEMENT PLASTERING".
- D. PRIOR TO COMMENCEMENT OF WORK, CONTRACTOR TO PREPARE SUBMITTAL DOCUMENTS TO ARCHITECT FOR REVIEW AND COMMENT. SUBMITTAL TO INCLUDE: 1. SURVEY OF EXTERIOR WALL INDICATING THE LOCATIONS OF EXISTING PLASTER SPALLING, CRACKS, AND DAMAGE OBSERVED AT THE SURFACE. SURVEY TO BE PREPARED IN NARRATIVE AND DRAWING FORMAT INCLUDING EXTERIOR ELEVATION DRAWINGS AND PLANS DESCRIBING THE EXISTING
- 2. REPAIR DOCUMENT SUBMITTAL OF EXTERIOR WALL INDICATING THE LOCATIONS AND TYPE OF REPAIR. SUBMITTAL TO INCLUDING ELEVATION, DRAWINGS, PLANS, DETAIL DRAWINGS AND PRODUCT
- REPAIR MATERIALS INDICATING WORK TO BE PREFORMED. TOOLS AND EQUIPMENT: A. ALL PLASTER REMOVAL SHALL BE DONE WITH SMALL, HAND-HELD PNEUMATIC CHIPPING TOOLS. TOOLS WHICH TYPICALLY REQUIRE THE USE OF BOTH HANDS TO HOLD THE WEIGHT OF THE EQUIPMENT SHALL NOT BE USED. CARE SHALL BE TAKEN TO PREVENT ANY OIL, LUBRICANTS OR OTHER MATERIALS DETRIMENTAL TO BONDING OF PATCHING MATERIALS TO PLASTER FROM CONTACTING THE SURFACE OF THE AREA BEING CHIPPED. IT MAY BE NECESSARY FOR THE USER TO HOLD A CLEAN RAG AROUND THE TOOL CHUCK AND FRONT END OF THE EQUIPMENT TO

PREVENT ANY SPRAY OR SPLATTER OF OIL, ETC. FROM CONTACTING THE CHIPPED SURFACE.

- B. THE TERM "WIRE BRUSH" IS USED IN THE DRAWINGS AND DETAILS TO DENOTE THE METHOD FOR CLEANING RUST AND CORROSION FROM REINFORCING STEEL OR OTHER EMBEDDED OR SURFACE-MOUNTED STEEL ITEMS. IN ALL CASES, THE TERM "WIRE BRUSH" MEANS THE USE OF A HAND-HELD ELECTRIC DRILL TYPE TOOL WITH A ROTARY WIRE BRUSH UNIT MOUNTED IN THE CHUCK. THE ROTARY WIRE BRUSH UNIT SHALL HAVE SHORT, STIFF WIRE BRISTLES IN ORDER TO ASSURE THAT FULL MANUAL PRESSURE CAN BE APPLIED FOR EFFECTIVE REMOVAL OF RUST AND CORROSION. CARE SHALL BE TAKEN TO WORK THE WIRE BRUSH ALL AROUND THE METAL, AND BEHIND EMBEDDED REINFORCING STEEL TO THE EXTENT POSSIBLE WHERE PLASTER MATERIAL BEHIND THE REINFORCING HAS BEEN REMOVED.
- C. LOW-PRESSURE WATER CLEANING OF EXISTING PLASTER SURFACES: EXCEPT AS MODIFIED OR SUPPLEMENTED IN THESE NOTES, THE PRIMARY REQUIREMENTS FOR THIS WORK ARE SPECIFIED IN ASTM C 926. NOTE THAT THE CONTRACTOR SHALL NOT USE EQUIPMENT WITH SPRAY PRESSURE CAPABILITIES IN EXCESS OF 3,600 PSI. THE SPRAY NOZZLE SHALL BE HELD NO CLOSER THAN 6" FROM THE SURFACE BEING SPRAYED. THE SPRAY NOZZLE SHALL EMIT A SPRAY WITH A DISPERSION ANGLE OF NO LESS THAN 20 DEGREES, AND NO GREATER THAN 40 DEGREES. NOTWITHSTANDING THE AFOREMENTIONED. THE CONTRACTOR SHALL BE RESPONSIBLE FOR ASSURING THAT THE MASONRY SURFACES BEING SPRAYED ARE ADEQUATELY CLEANED TO MEET ALL MANUFACTURER'S REQUIREMENTS FOR THE APPLICATION OF PATCHING MATERIALS AND SEALANTS AND THAT THE APPLICATION OF THE WATER SPRAY SHALL NOT REMOVE EXISTING MASONRY MATERIALS AND THEREBY CHANGE THE TEXTURE AND APPEARANCE OF THE SURFACE.
- BULK PLASTER REMOVAL AND SURFACE PREPARATION: A. LOOSE, DELAMINATED PLASTER SHALL BE REMOVED FROM THE AREAS INDICATED UNTIL THE

SUBSTRATE CONSISTS OF SOUND PLASTER.

- B. BULK PLASTER REMOVAL SHALL INCLUDE UNDERCUTTING OF CORRODED REINFORCING STEEL LATH BY APPROXIMATELY 3/4 IN.
- C. THE FINAL SURFACE TEXTURE SHALL MATCH THE (E) PLASTER AS CLOSELY AS POSSIBLE
- MAINTAIN SQUARE OR RECTANGULAR SHAPE OF THE PREPARED CAVITY WHERE POSSIBLE, BUT IN
- ALL INSTANCES KEEP THE SHAPE OF THE CAVITY AS SIMPLE AS POSSIBLE. E. THE EDGES OF THE CAVITY SHALL BE CUT PERPENDICULAR OR SLIGHTLY UNDERCUT TO AVOID FEATHER EDGING OF THE REPAIR MATERIAL.
- A. USE PRESSURE WASHING TO REMOVE RESIDUAL DUST, DEBRIS, FRACTURED PLASTER, AND CONTAMINANTS THAT PREVENT PROPER BONDING. DO NOT ALLOW WASH PARTICULATE SLURRY TO
- HARDEN ON PREPARED SURFACES. B. ALL HEAVY CORROSION AND SCALE SHALL BE REMOVED FROM EXPOSED CORRODED REINFORCING STEEL TO PROMOTE MAXIMUM BONDING OF REPAIR MATERIAL. TIGHTLY BONDED LIGHT RUST BUILD-UP ON THE SURFACE IS USUALLY NOT DETRIMENTAL TO BOND UNLESS A PROTECTIVE
- C. IF REINFORCING STEEL HAS LOST SIGNIFICANT CROSS SECTION, NOTIFY ENGINEER.
- D. ANY REINFORCING STEEL THAT IS LOOSE SHALL BE SECURED IN PLACE BY TYING TO OTHER SECURED BARS OR BY OTHER APPROVED METHODS.
- PLACEMENT OF REPAIR MATERIAL: A. REPAIR MATERIAL SHALL BE PREPARED ACCORDING TO MANUFACTURER'S RECOMMENDATIONS.

COATING WILL BE APPLIED TO THE LATH SURFACE.

- B. PRESOAK THE SUBSTRATE TO ACHIEVE A SATURATED SURFACE DRY (SSD) CONDITION PRIOR TO PLACEMENT OF REPAIR MATERIAL TO PREVENT A RAPID LOSS OF MOISTURE FROM THE REPAIR MATERIAL. AN SSD CONDITION IS ACHIEVED WHEN THE SUBSTRATE IS SATURATED BUT FREE OF SURFACE WATER AND PUDDLES.
- C. SCRUB A THIN BOND COAT OF THE REPAIR MATERIAL INTO THE SSD SUBSTRATE FILLING ALL PORES AND VOIDS.
- D. PLACE REPAIR MATERIAL USING ADEQUATE PRESSURE BEFORE THE BOND COAT DRIES. THOROUGHLY CONSOLIDATE THE REPAIR MATERIAL INTO THE CORNERS OF THE REPAIR AND AROUND ANY EXPOSED REINFORCING.
- E. IF MULTIPLE LIFTS ARE REQUIRED, THOROUGHLY ROUGHEN THE SURFACE OF THE PROCEEDING LIFT TO ACHIEVE AN AGGRESSIVE FINISH AND CURE THE LIFT ACCORDING TO MANUFACTURERS RECOMMENDATIONS PRIOR TO PLACING ADDITIONAL LIFTS.
- F. FINISH THE REPAIR MATERIAL TO PRODUCE A FINAL FINISHED APPEARANCE MATCHING THE ADJACENT MATERIALS.
- G. PROPERLY CURE THE REPAIR MATERIAL ACCORDING TO MANUFACTURER'S RECOMMENDATIONS.

### 23. SUSTAINABILITY NOTES

- CBC PART 11 GREEN BUILDING CODE (CGC)
- 1. APPLICABLE FOR NONRESIDENTIAL ALTERATIONS: EXTENT OF APPLICABLE PROVISIONS OF PART 11 IS SPECIFIC TO ONLY AREAS TO BE ALTERED. "THE PROVISIONS OF INDIVIDUAL SECTIONS OF CHAPTER 5 APPLY ...TO BUILDING ALTERATIONS WITH PERMIT VALUATION OF \$200,000 OR ABOVE. CODE SECTIONS RELEVANT TO ADDITIONS AND ALTERATIONS SHALL ONLY APPLY TO THE PORTIONS OF THE BUILDING BEING ADDED OR ALTERED WITHIN THE SCOPE OF THE PERMIT WORK." (CGC 301.3)
- 2. NOT APPLICABLE BICYCLE PARKING: EXISTING FACILITY CURRENTLY DOES CONTAIN MOTORIZED PARKING AND WILL PROVIDE MOTORIZED PARKING IN ALTERATIONS. PROVISIONS FOR BICYCLE PARKING ARE APPLICABLE AS MOTORIZED PARKING IS PRESENT AND CAN BE USED TO CALCULATE THE REQUIREMENT. ADDITIONALLY, "IF THE NEW PROJECT ALTERATION IS ANTICIPATED TO GENERATE VISITOR TRAFFIC." \* EXCEPTION, ALTERATIONS WHICH ADD NINE OR LESS VISITOR VEHICULAR PARKING" (CGC 5.106.4.1.1)
- 3. NOT APPLICABLE LOW-EMITTING VEHICLE PARKING STALLS: ADDITIONAL PARKING WILL BE ADDED TO THE EXISTING FACILITY. PROVISIONS FOR DESIGNATED LOW-EMITTING VEHICLE PARKING ARE NOT APPLICABLE. "IN PROJECT ALTERATIONS THAT ADD TEN OR MORE VEHICLE PARKING SPACES PROVIDE DESIGNATED PARKING.." (CGC 5.106.5.2)
- 4. APPLICABLE ENERGY EFFICIENCY STANDARDS: PROVISIONS FOR MANDATORY ENERGY EFFICIENCY STANDARDS WILL FOLLOW CALIFORNIA ENERGY CODE. (CGC 5.201.1)
- 5. APPLICABLE INDOOR WATER USE: EXISTING FACILITY WILL BE PROVIDING ADDITIONAL SPACE LESS THAN A 50,000 SQ, FT, AND SUB-METERING IS NOT REQUIRED. (CGC 5,303,1,1) PROVISIONS FOR INDOOR WATER EFFICIENCY IS APPLICABLE AND WATER FIXTURES TO MEET THE MAXIMUM FLOW RATE VALUES. THE BUILDING IS EXISTING AND DOES NOT NEED TO MEET THE WASTE WATER REDUCTION (CGC 5.303.4).
- 6. APPLICABLE CONSTRUCTION WASTE REDUCTION: "WHERE A LOCAL JURISDICTION DOES NOT HAVE A CONSTRUCTION AND DEMOLITION WASTE MANAGEMENT ORDINANCE." (CGC
- 7. NOT APPLICABLE BUILDING MAINTENANCE AND OPERATIONS: EXISTING FACILITY WILL HAVE NO ADDITIONAL INCREASE TO TOTAL SQUARE FOOTAGE. AND NO ONSITE RECYCLING AREA IS REQUIRED. (CGC 5.410.1.1)
- 8. APPLICABLE BUILDING MAINTENANCE AND OPERATIONS: EXISTING FACILITY IS BEING SUBSTANTIALLY REMODELED OR EXPANDED BUILDING REQUIRING THE PROVIDE FOR PROPER WASTE AND RECYCLABLE STORAGE OF 10 SQUARE FEET OF WASTE STORAGE AREA FOR EACH 1.000 SQUARE FEET OR PORTION THEREOF OF NET FLOOR AREA OF THE FACILITY FOR THE FIRST 20,000 SQUARE FEET AND 3 SQUARE FEET FOR EACH ADDITIONAL 1,000 SQUARE FEET OVER THAT, BUT NOT LESS THAN 4-1/2 FEET IN WIDTH NOR LESS THAN 6 FEET IN LENGTH, (LACBC TITLE 14)
- 9. APPLICABLE ENVIRONMENTAL QUALITY: ALTERATION WILL MEET ENVIRONMENTAL INDOOR QUALITY REQUIREMENTS, INCLUDING POLLUTANT CONTROL, FINISH MATERIAL VOC POLLUTANT CONTROL, ETS CONTROL, (CGC 5.501.1) NO DEMAND CONTROL VENTILATION IS PROVIDED AND NO CO2 MONITORING PROVIDED. PROJECT ACOUSTICAL CONTROL COMPLIANCE REQUIREMENTS TO BE DETERMINED APPLICABLE BY BUILDING DEPARTMENT OFFICIAL.

### 11. RATED ASSEMBLY PENETRATIONS

- A. MECHANICAL DUCTS, ETC. PENETRATING FIRE-RATED CEILINGS AND FIRE WALLS SHALL BE CORRESPONDINGLY RATED OR DAMPERED. CABINETS. ELECTRICAL PANELS. LIGHTS. ETC. RECESSED INTO FIRE RATED WALLS OR CEILINGS SHALL BE BACKED WITH CORRESPONDING FIRE-RESISTIVE CONSTRUCTION AS REQUIRED TO MAINTAIN THE INTEGRITY OF THE FIRE PROTECTION.
- B. FIRE RESISTIVE ASSEMBLIES FOR PROTECTION OF OPENINGS SHALL COMPLY WITH CBC CHAPTER 7.
- PENETRATION OF FIRE RATED ASSEMBLIES WHICH REQUIRE OPENING PROTECTION SHALL BE FIRE STOPPED. FIRE STOPPING SHALL BE IDENTICAL TO AN APPROVED UNDERWRITERS LABORATORIES (UL) LISTED ASSEMBLY WITH AN "F" OF "T" RATING. PENETRATIONS MUST ALSO CONSIST OF APPROVED MATERIALS FOR THROUGH WALL PENETRATIONS FIRE STOP SYSTMEMS AS PRESCRIBED IN CBC STANDARD 7-5 FIRE RATING FOR FIRE STOP SYSTEMS SHALL BE EQUAL TO THE ASSEMBLY PENETRATED. (709.6, CBC)
- D. SHAFT ENCLOSURES: OPENINGS EXTENDING VERTICALLY THROUGH FLOORS SHALL BE ENCLOSED IN A SHAFT OF 1-HOUR FIRE-RESISTIVE CONSTRUCTION. SHAFTS SHALL INCLUDE A GYPSUM BOARD HORIZONTAL TERMINATION AT BOTTOM, ENGINEERED BY GENERAL CONTRACTOR. PROTECTION FOR STAIRWAYS SHALL BE AS SPECIFIED IN CODE OF JURISDICTION.

### 12. DISSIMILAR METALS

A. ALL DISSIMILAR METALS SHALL BE EFFECTIVELY ISOLATED.

### 13. ELECTRICAL BACKBOARDS

A. REFER TO ELECTRICAL, TELEPHONE/DATA AND SECURITY ELECTRONICS DRAWINGS FOR LOCATION OF AND SPECIFICATIONS FOR THE INSTALLATION OF FIRE RETARDANT TREATED PLYWOOD BACKBOARDS REQUIRED IN ELECTRICAL AND COMMUNICATION ROOMS. THESE REQUIRED PLYWOOD BACKBOARDS HAVE NOT BEEN SHOWN ON THE ARCHITECTURAL DRAWINGS, BUT MUST BE FURNISHED AND INSTALLED AS A PART OF THE OVERALL CONTRACT. BACKBOARDS SHALL BE PAINTED WHITE.

### 14. SIGNAGE

BACKGROUND.

- A. FURNISH AND INSTALL SUPPORTS AND OTHER NECESSARY FINISH MATERIALS FOR A COMPLETE SIGNAGE INSTALLATION.
- B. HANDICAPPED SIGNAGE / IDENTIFICATION
  - 1. THE INTERNATIONAL SYMBOL OF ACCESSIBILITY SHALL BE THE STANDARD USED TO IDENTIFY FACILITIES THAT ARE ACCESSIBLE TO AND USEABLE BY PHYSICALLY HANDICAPPED PERSONS.
- 2. LETTERS AND NUMBERS ON SIGNS HAVE A WIDTH TO HEIGHT RATIO OF BETWEEN 3:5 AND 1:1 AND STROKE WIDTH TO HEIGHT RATIO OF BETWEEN 1:5 AND 1:10. 3. CHARACTERS AND SYMBOLS SHALL CONTRAST WITH THEIR BACKGROUND, EITHER LIGHT CHARACTERS ON A DARK BACKGROUND OR DARK CHARACTERS ON A LIGHT
- 4. ALL BUILDING ENTRANCES THAT ARE ACCESSIBLE TO AND USABLE BY PHYSICALLY HANDICAPPED PERSONS SHALL BE IDENTIFIED WITH AT LEAST ONE STANDARD SIGN AND WITH ADDITIONAL DIRECTIONAL SIGNS AS REQUIRED TO BE VISIBLE TO PERSONS ALONG APPROACHING PEDESTRIAN WAYS.
- 5. ALL SANITARY FACILITIES WILL BE PROVIDED WITH APPROPRIATE IDENTIFICATION SYMBOLS.
- AREA AND OCCUPANCY SIGNAGE REQUIREMENTS OCCUPANT LOAD SIGN SHALL BE POSTED IN EACH MEETING ROOM, ASSEMBLY ROOM OR SIMILAR PURPOSE ROOM HAVING AN OCCUPANT LOAD OF 50 OR MORE.

### 15. COORDINATION OF DEVICES

EXACT LOCATIONS AND HEIGHTS OF ELECTRICAL, LOW VOLTAGE, MECHANICAL AND PLUMBING DEVICES, INCLUDING BUT NOT LIMITED TO SMOKE DETECTORS, PULL STATIONS, SWITCHES, OUTLETS, PHONE JACKS, AND THERMOSTATS, SHALL BE COORDINATED BY THE CONTRACTOR PER THE APPLICABLE CODE FOR ALIGNMENT AND COORDINATION WITH EACH OTHER AND OTHER BUILDING FEATURES PRIOR TO

### 16. GUARDS

PROVIDE LIGHT FIXTURE GUARDS OR UNBREAKABLE LENSES IN STORAGE ROOMS. MACHINE AND MECHANICAL EQUIPMENT ROOMS, WORKSHOPS, ETC.

### 17. RE-KEYING

THE CONTRACTOR SHALL REPLACE CYLINDERS AND/OR REKEY LOCKS AT NO COST TO THE OWNER FOR ALL DOORS OF EACH LOCK TYPE WHERE A KEY HAS BEEN LOST DURING CONSTRUCTION AND UNTIL FINAL ACCEPTANCE IS NECESSARY IN THE OPINION OF THE OWNER TO MAINTAIN THE SECURITY OF THE FACILITY.

### 18. SKYLIGHT CONSTRUCTION

### 19. SPRINKLER NOTES

A. NOT USED

### 20. SECURITY NOTES

- A. AT ALL EXTERIOR DOORS, PROVIDE MINIMUM 16 GA. STEEL REINFORCEMENT WITHIN THE FRAME FOR THE WIDTH OF FRAME AND EXTENDING 6" ABOVE AND BELOW THE STRIKE PLATE AT ALL EXTERIOR DOORS.
- B. SECURE THE 16 GA. MINIMUM STRIKE PLATE WITH 2" MINIMUM SCREWS.
- C. ALL EXTERIOR HOLLOW METAL DOORS SHALL BE 16 GA. MIN.
- ALL MECHANICAL, ELECTRICAL, OR OTHER EQUIPMENT OVER ROOF OPENINGS EXCEEDING 96 SQUARE INCHES SHALL BE SECURED WITH NON-REMOVEABLE VANDAL RESISTANT SCREWS OR BOLTS TO PREVENT ENTRY OR SHALL HAVE 1/8" X 2" WELDED WIRE MESH WITH CONTINOUS FRAME ACROSS OPENING BELOW.
- EXTERIOR HATCHWAYS IN ROOFS OR WALLS SHALLHAVE NRP (NON-REMOVEABLE EXTERIOR PINS) AT HINGE AND LOCK.
- H. ALL EXTERIOR GROUND FLOOR DOORS MUST HAVE LIGHTING OF A MINIMUM OF 1.0 FOOTCANDLE AT GROUND PLANE. THESE MUST BE ON SEPARATE CIRCUITS TO REMAIN ON DURING ALL CONDITIONS WHEN NATURAL EXTERIOR LIGHT LEVEL DROPS BELOW 1.0 FOOT CANDLE
- ANYTIME A BUILDING OR PORTION OF A BUILDING IS OCCUPIED. THE MEANS OF EGRESS SERVING THE OCCUPIED PORTION SHALL BE ILLUMINATED AT AN INTENSITY OF NOT LESS THAN 1 FOOT-CANDLE (10.76 LX) AT THE FLOOR LEVEL.

### 21. THERMAL ENVELOPE NOTES

THERMAL INSULATION PERFORMANCE TO MEET LOCAL MINIMUM ENERGY CODES. INSULATION ASSEMBLY, AS TESTED IN ACCORDANCE WITH ASTMC 518, TO PROVIDE A CONTINUOUS THERMAL PERFORMANCE RATING AT EXTERIOR PERIMETER OF NEW WORK. PROVIDE ASSEMBLY THICKNESS TO MEET THERMAL RESISTANCE 'R' VALUE AS INDICATED BUT NO LESS THAN THE CODE. MINIMUM THERMAL RESISTANCE VALUES AS FOLLOWING: 1. R-30 AT CEILING AND ATTIC SPACES

- 2. R-19 AT EXTERIOR WALLS 3. R-11 AT INTERIOR WALLS WHERE INSULATION IS USED FOR SOUND CONTROL 4. R-13 AT FLOOR CRAWL SPACES
- 22. EXTERIOR FACADE PLASTER SPALL REPAIRS

- A. IN THESE NOTES. "PLASTER" REFERS TO "CEMENT PLASTER". SEE SPECIFICATION "CEMENT
- B. IN ALL CASES, THE EXACT RECOMMENDATIONS OF THE PRODUCT MANUFACTURER FOR PREPARATORY WORK AND ACTUAL PLACEMENT OF REPAIR MATERIALS SHALL BE STRICTLY ADHERED TO. IN THE EVENT OF A CONFLICT BETWEEN A MANUFACTURER'S RECOMMENDATION AND THESE DRAWINGS, THE CONFLICT SHALL BE BROUGHT TO THE ATTENTION OF THE ENGINEER FOR
- C. ALL PLASTER REPAIRS SHALL MATCH THE HEIGHT AND TEXTURE OF ADJACENT SURFACES. OVER POURS AND OTHER IRREGULARITIES SHALL BE GROUND DOWN TO AN ACCEPTABLE SURFACE.
- D. THESE GENERAL NOTES HIGHLIGHT CONTRACTOR REQUIREMENTS IN MANY IMPORTANT AREAS OF THE WORK. THEY ARE NOT STAND-ALONE REQUIREMENTS. THESE NOTES MUST BE COORDINATED WITH THE CONTRACT DRAWINGS. THE CONTRACTOR IS RESPONSIBLE FOR COORDINATING THESE GENERAL NOTES WITH THE CONTRACT DRAWINGS SO AS TO ASSURE THAT ALL PROJECT REQUIREMENTS ARE FULFILLED.
- THROUGHOUT THESE DRAWINGS, A PARTICULAR PRODUCT FOR REPAIR OF SPALLS, OR FOR COATING SURFACES, OR FOR OTHER USES, MAY BE SPECIFIED. IN EACH CASE, THE CONTRACTOR SHALL USE THE SPECIFIED PRODUCT. OR REQUEST THE USE OF AN ALTERNATIVE PRODUCT BY SUBMITTING FULL AND DETAILED EVIDENCE THAT THE ALTERNATIVE PRODUCT IS EQUIVALENT IN EVERY WAY. IT IS SOLELY INCUMBENT UPON THE CONTRACTOR TO DEMONSTRATE PRODUCT EQUIVALENCY WHERE ALTERNATIVE PRODUCTS ARE REQUESTED. NO SCHEDULE DELAYS OR COST CHANGES WILL BE ACCEPTED IN CONJUNCTION WITH CONTRACTOR REQUESTS FOR THE USE OF ALTERNATIVE PRODUCTS. ALL CHANGES TO BE SUBMITTED TO THE ENGINEER-OF-RECORD FOR

### I. GENERAL

- ALL WORK SHALL CONFORM TO CONTRACT DOCUMENTS. NO CHANGES THEREFROM SHALL BE MADE WITHOUT WRITTEN APPROVAL OF THE ARCHITECT. WHERE MORE INFORMATION OR WHEN AN INTERPRETATION OF THE CONTRACT DOCUMENTS IS NEEDED, THE CONTRACTOR BEFORE PROCEEDING WITH WORK, SHALL REFER THE MATTER TO THE ARCHITECT WHO WILL FURNISH INFORMATION OR INTERPRETATION IN
- THE FORM OF SUPPLEMENTAL INFORMATION OR OTHER WRITTEN FORM OR DRAWING. B. WHERE ONLY PART OF THE WORK IS INDICATED, SIMILAR PARTS SHALL BE CONSIDERED REPETITIONS. WHERE ANY DETAIL IS SHOWN AND THE COMPONENTS ARE DESCRIBED ELSEWHERE, SIMILAR DETAILS SHALL BE CONSTRUCTED AS DESCRIBED IN THE ORIGINAL
- DRAWINGS ARE GENERIC IN NATURE. CONTRACTOR SHALL FULLY COORDINATE ALL ASPECTS OF THE WORK TO BE PERFORMED. DETAILS ARE NOT INTENDED TO SHOW METHOD AND MANNER OF ACCOMPLISHING THE WORK.
- D. ALL DIMENSIONS ORIGINATING AT, CONNECTED TO, OR CONTINUING THROUGH EXISTING CONDITIONS, INCLUDING PREVIOUS PHASES, MUST BE COORDINATED AND FIELD VERIFIED BY THE CONTRACTOR PRIOR TO FABRICATION INSTALLATION, AND CONSTRUCTION OF BUILDING ELEMENTS OR SYSTEMS.
- VERIFY ALL DIMENSIONS, ELEVATIONS, AND ALL EXISTING CONDITIONS AT THE SITE BEFORE COMMENCING WORK AND REPORT ANY DISCREPANCIES TO THE ARCHITECT AND
- SHOULD A CONFLICT BE DISCOVERED WITHIN THE CONTRACT DOCUMENTS, THE CONTRACTOR SHALL BE DEEMED TO HAVE INCLUDED IN HIS WORK THE HIGHEST QUALITY WAY OF DOING THE WORK UNLESS HE SHALL HAVE ASKED FOR AND OBTAINED A DECISION IN WRITING FROM THE ARCHITECT AND OWNER.

- A. ALL CONSTRUCTION IS TO COMPLY WITH THE APPLICABLE CODES AS ADAPTED BY THE REGIONAL, STATE, AND NATIONAL AUTHORITIES HAVING JURISDICTION.
- B. FOR LIST OF CODES APPLICABLE TO THIS PROJECT, SEE 'CODES' SHEET GI.01.

### 3. PERMITS

PROCURE ALL NOTICES, PERMITS, AND LICENSES REQUIRED FOR THE COMPLETION OF THE WORK. THE COST OF THESE NOTICES. PERMITS. AND LICENSES IS INCIDENTAL TO OTHER ITEMS OF WORK AND NO ADDITIONAL PAYMENT WILL BE MADE FOR COSTS INCURRED IN OBTAINING NOTICES, PERMITS, AND LICENSES OR IN CONFORMING TO THE REQUIREMENTS THEREOF.

### COORDINATION & VERIFICATION

- A. THE DRAWINGS ARE DIVIDED INTO SEPARATE SHEETS AND THE PROJECT MANUAL INTO SEPARATE SECTIONS FOR GENERAL CONVENIENCE ONLY. SHEET DESIGNATION OR NUMBERS SHALL NOT BE CONSIDERED TO LIMIT AREAS OF THE WORK OR RESPONSIBILITY OF TRADES. COORDINATE THE WORK SHOWN ON THE DRAWINGS AND IN THE PROJECT MANUAL IN ORDER TO COMPLETE THE PROJECT AS DESIGNED.
- B. VERIFY ALL SIZES OF AND PREPARE WORK FOR EQUIPMENT OF OTHERS AND COORDINATE WORK ON THIS CONTRACT WITH ITEMS OF WORK NOT IN CONTRACT (N.I.C.) OR WORK FURNISHED BY OTHERS.
- LOCATIONS AND SIZES OF EQUIPMENT ARE BASED ON AVAILABLE INFORMATION. PROVIDE AND COORDINATE THE EXACT DIMENSIONS, SIZES, AND POSITIONS.
- D. PROVIDE AND COORDINATE THE EXACT DIMENSIONS, SIZES AND POSITIONS OF OPENINGS IN SLABS AND WALLS NECESSARY FOR THE INSTALLATION OF THE WORK.
- PROVIDE REINFORCING STEEL, MESH, AND DOWELS REQUIRED BY THE STRUCTURAL GENERAL NOTES AND DRAWINGS FOR ARCHITECTURAL DETAILS INDICATED ON THE
- ARCHITECTURAL DRAWINGS. QUANTITIES INDICATED ON THE DRAWINGS ARE APPROXIMATE. CONTRACTOR SHALL
- VERIFY QUANTITIES AND INCLUDE ACCURATE QUANTITIES AS PART OF THE WORK. NOTES AND DETAILS: SPECIFIC NOTES OR KEYNOTES ON DETAILS APPLY TO SIMILAR CONDITIONS ON OTHER DETAILS ON ALL DRAWINGS UNLESS SPECIFICALLY NOTED

### 5. UTILITIES AND DEMOLITION

A. THE DRAWINGS SHOW DIAGRAMMATICALLY THE APPROXIMATE LOCATION OF UNDERGROUND UTILITIES WHERE INFORMATION IS AVAILABLE, BUT THE DRAWINGS ARE NOT EXACT AS TO THE QUANTITY, EXTENT OR LOCATION.

PREPARE SURFACES OF FLOOR AREAS WHICH HAVE FINISHES DEMOLISHED TO RECIEVE

OVERALL DIMENSIONS ARE TO FACE OF FINISH, AND NOMINAL FACE OF MASONRY

THICKNESS OF ALL FLOOR FINISH MATERIAL MUST BE FULLY COORDINATED.

- UNLESS NOTED OTHERWISE. B. ELEVATIONS AND VERTICAL DIMENSIONS ARE TO TOP OF FINISH FLOOR MATERIAL.
- C. GRID LINE TO CENTER OF COLUMN.

NEW FINISH MATERIAL AS SPECIFIED.

- D. DIMENSION TO CENTER OF COLUMN & GRID LINE.
- E. EXTERIOR DIMENSIONS ARE FROM FACE TO FACE OF CONCRETE STEM WALLS. INTERIOR DIMENSIONS ARE FROM FINISH TO FINISH.
- G. DO NOT SCALE DRAWINGS.

### . FIRE PROTECTION

- A. THE CONTRACTOR SHALL PROVIDE PORTABLE FIRE EXTINGUISHERS AS REQUIRED BY CODE, AND AUTHORITY HAVING JURISDICTION, AT ALL PORTIONS OF THE BUILDING ON EACH FLOOR. THESE EXTINGUISHERS SHALL BE INSTALLED IN THE LOCATIONS APPROVED BY THE FIRE DEPARTMENT AND THE ARCHITECT.
- B. WHERE TESTING LABORATORY DESIGN NUMBERS ARE LISTED FOR FIRE RATED CONSTRUCTION, THE COMPONENTS AND INSTALLATION DETAILS MUST CONFORM WITH THE DESIGN NUMBER SPECIFIED.

### 8. EXITS

- A. EXIT DOORS SHALL BE OF THE PIVOTED OR SIDE-HINGEDSWINGING TYPE. EXIT DOORS SHALL SWING IN THE DIRECTION OF EXIT TRAVEL WHEN THE AREA SERVED HAS AN OCCUPANT LOAD OF 50 OR MORE.
- B. EVERY EXIT DOOR SHALL BE OPENABLE FROM THE INSIDE WITHOUT THE USE OF A KEY OR ANY SPECIAL KNOWLEDGE OR EFFORT. NOTE ALSO THAT FLUSH BOLTS OR SURFACE **BOLTS ARE PROHIBITED.**
- PANIC HARDWARE SHALL BE PROVIDED ON EXIT DOORS OF ROOMS, CORRIDORS, STAIRWAYS, HANDLING AN OCCUPANT CAPACITY OF 50 OR MORE PERSONS.
- THE CODE OF JURISDICTION. E. STAIRWAYS SHALL NOT BE LESS THAN 44 INCHES WIDE WITH RISERS NOT TO EXCEED 7 INCHES AND TREADS NOT LESS THAN 11 INCHES.

D. EXIT SIGNS SHALL BE INSTALLED AT REQUIRED EXIT DOORWAYS AND WHERE OTHERWISE

NECESSARY TO CLEARLY INDICATE THE DIRECTION OF EGRESS IN COMPLIANCE WITH

EGRESS DOORS SHALL BE SET IN MOTION WHEN SUBJECTED TO A 30LB. FORCE. THE

DOOR SHALL SWING TO THE FULLY OPEN POSITION WHEN AN OPENING FORCE NOT EXCEEDING 15 LBS IS APPLIED TO THE LATCH SIDE.

G. EACH DOOR IN A MEANS OF EGRESS FROM A GROUP 'A' OCCUPANCY SHALL NOT BE

- PROVIDED WITH A LATCH OR LOCK UNLESS IT IS PANIC HARDWARE OR FIRE EXIT HARDWARE (CBC 1008.1.9). H. DOOR HANDLES, LOCK AND OTHER OPERATING DEVICES SHALL BE INSTALLED AT A MIN.
- EXIT SIGNS SHALL BE CONNECTED TO AN EMERGENCY POWER SYSTEM THAT WILL PROVIDE AN ILLUMINATION OF NOT LESS THAT 90min. IN CASE OF PRIMARY POWER LOSS

TIMES THE BUILDING SPACE SERVED BY THE MEANS OF EGRESS IS OCCUPIED.

THE MEANS OF EGRESS. INCLUDING THE EXIT DISCHARGE. SHALL BE ILLUMINATED AT ALL

STEEL FIREPROOFING THICKNESS SHALL BE IN COMPLIANCE WITH THE CURRENT EDITION

FIREPROOFING TO THE REQUIREMENTS OF CBC CHAPTER 17A SPECIAL INSPECTIONS.

## 9. FIREPROOFING

OF THE CBC.

34" AND A MAX. 48" A.F.F.

A. FIRE PROTECTION OF STRUCTURAL MEMBERS SHALL BE IN COMPLIANCE WITH STATE

C. PERIODIC INSPECTIONS SHALL BE PROVIDED FOR ALL REQUIRED SPRAYED-ON

THE INSPECTOR SHALL SUBMIT A SIGNED AFFIDAVIT THAT ALL SPRAYED-ON

### FIREPROOFING, WHERE REQUIRED, IS APPLIED ACCORDING TO CODE AND MANUFACTURER'S SPECIFICATIONS. 10. SAFING INSULATION

A. THE SPACE BETWEEN THE EDGE OF THE FLOOR AND ROOF SLAB AND THE EXTERIOR WALL SHALL BE FILLED WITH SAFING INSULATION TO MAINTAIN RATING CONTINUITY OF FLOOR CONSTRUCTION.

## APPLICABLE CODES

- ALL WORK SHALL COMPLY WITH THE FOLLOWING CODES: - 2013 CALIFORNIA BUILDING CODE (REFERENCING 2012 INTERNATIONAL BUILDING CODE (ICC)
- 2013 CALIFORNIA FIRE CODE (REFERENCING 2012 INTERNATIONAL FIRE CODE (IFC)
- 2013 CALIFORNIA PLUMBING CODE (REFERENCING 2012 UNIFORM PLUMBING CODE (IAPMO)
- 2013 CALIFORNIA MECHANICAL CODE (REFERENCING 2012 UNIFORM MECHANICAL CODE (IAPMO)

PROJECT DATA

APN#:

LEGAL DESCRIPTION:

**BUILDING 'A' ADDRESS:** 

**BUILDING 'B' ADDRESS:** 

**BUILDING 'C' ADDRESS:** 

LAND/ BUILDING RATIO:

**EXISTING BUILDING SUMMARY:** 

PARKING REQUIRED:

PARKING PROVIDED:

**EXISTING SITE SUMMARY** 

TOTAL BUILT AREA (BLDG. 'A' & 'B' & 'C'):

(VACANT

( VACANT

(B/24 Occ.)

(B/12 Occ.)

(B/8Occ.)

(VACANT)

( VACANT

SITE ADDRESS:

SPECIFIC PLAN:

USE TYPE:

**ZONE CODE:** 

LAND USE:

LAND AREA:

BUILDING 'A'

**BUILDING 'B'** 

SQUARE FOOTAGE

TENANT 1

TENANT 2

TENANT 3

**TENANT 4** 

TENANT 5

**TENANT 6** 

TENANT

- 2013 CALIFORNIA ELECTRICAL CODE (REFERENCING 2011 NATIONAL ELECTRICAL CODE (NEC)
- 2013 CALIFORNIA EXISTING BUILDING CODE (REFERENCING 2012 INTERNATIONAL EXISTING BUILDING CODE (ICC)

COMMERCIAL

581 N. MAIN STREET, CORONA, CA 92879

541 N. MAIN STREET, CORONA, CA 92879

511 N. MAIN STREET, CORONA, CA 92879

COMMERCIAL

51,248 GSF

2,458 GSF

2,446 GSF

2,446 GSF

1,626 GSF

1,250 GSF

1,014 GSF

771 GSF

1.73/1

358

"CR" COMMERCIAL RETAIL

138,184 SF (3,17 ACERES)

22,493 GSF (NOT IN SCOPE)

(AREA INCREASE: SIDE YARDS)

2,378 GSF

2,446 GSF

2.446 GSF

1.626 GSF

1,250 GSF

1.014 GSF

771 GSF

### HIS PROJECT CONSISTS OF THE EXTERIOR REMODEL OF AN EXISTING RETAIL STRUCTURE. LOCATED IN THE CITY OF CORONA, CA. REVISIONS TO THE EXISTING MULTI - TENANT BUILDING 'B' (541 N. MAIN) SHELL: EXTERIOR SURFACE AREA REVISED - 1,420. SQ. FT. REDUCE AMOUNT OF EXITING STANDING SEAM ROOF FACING PUBLIC STREET BY REDUCING EXISTING BUILDING OVERHANG; REDUCE STREET FACING STOREFRONT BY PUSHING A PORTION OF THE BUILDING FACADE INWARD; CREATING A POTENTIAL COVERED/EXPOSED GATHERING SPACE. PATH OF TRAVEL IS ACCESSIBLE NOT A PART:

SCOPE OF WORK

EXISTING MULTI - TENANT BUILDING 'C' (511 N. MAIN ) - REFER TO BUILDING PERMIT #B1601363 REFER TO BUILDING PERMIT #B1601363 REVISIONS TO THE EXISTING SITE EXISTING SINGLE TENANT BUILDING 'A' ( 581 N. MAIN ): SIGNAGE (MALL MONUMENT SIGNS / TENANT SIGNS) - SEE PLANNING DEPT. APPROVAL #PP16-003M
PRIOR TO NEW TENANT OCCUPANCIES, A SEPARATE TENANT IMPROVEMENT PLAN SHALL BE SUBMITTED

### AND APPROVED.

## DRAWING INDEX

### **GENERAL** COVERSHEE 3.18 ACRES NET IN PAR 1 PM 120 / 062 PM 19 GA1.01 TITLE SHEET GA1.02 ABBREVIATIONS, LEGENDS, & SYMBOLS 511 N. MAIN STREET, CORONA, CA 92879 GA1.03 ACCESSIBILITY NOTES SP-99-1 - NORTH MAIN STREET DISTRICT SPECIFIC PLAN GA1.04 MEANS OF EGRESS & ACCESSIBILITY PLAN GA1.05 GENERAL NOTES

NO CHANGE

NO CHANGE

NO CHANGE

- GA1.10 EXISTING SITE PHOTOS GA1.11 SITE PLAN, DEMOLITION GA1.12 SITE PLAN, PROPOSED
- <u>(for reference only)</u> GA2.01 SITE DETAILS PART OF B1601363 GA2.02 SITE DETAILS GA2.03 SITE DETAILS GA2.04 SITE DETAILS

### **ARCHITECTURAL**

- BA1.01 EXISTING BUILDING PHOTOS BA2.01 BUILDING B - FLOOR PLAN, DEMOLITION & PROPOSED BA2.02 BUILDING B - ENLARGED FLOOR PLANS & DETAILS
- BA3.01 BUILDING B EXTERIOR ELEVATIONS, EXISTING BA3.02 BUILDING B - EXTERIOR ELEVATIONS, PROPOSED BA4.01 BUILDING B - WALL SECTIONS

### **STRUCTURAL GENERAL NOTES** S02 GENERAL NOTES

SUITE TENANT NAME

PARKING REQUIRED

E-2 VACANT

SQUARE USE

E-3 WESTERN DENTAL 4,200 DENTAL 1/200 21

1.200 RETAIL 1/375

3,600 RETAIL 1/375 10

1,360 RETAIL 1/375 4

BA8.01 BUILDING B - DETAILS

S2.10 DETAILS AND SECTIONS

### BUILDING 'C 16.744 GSF (NOT IN SCOPE) **BUILDING 'B' & 'C' TOTAL** 28,591 GSF BUILDING 'A' & 'B' & 'C' TOTAL 51,084 GSF


BUILDING OCCUPANCY CLASSIFICATION (BUILDING 'B' & 'C'): A\ NO CHANGE OCCUPANCY GROUP: CONSTRUCTION TYPE: (BUILDING CODE: 1985 U.B.C.) V-N (NON RATED) NO CHANGE NO CHANGE NUMBER OF STORIES:


**BUILDING HEIGHT: NO CHANGE** NO AUTOMATIC SPRINKLER (NOT REQUIRED) FIRE PROTECTION SYSTEM FIRE PROTECTION ALARM: NONE (NOT REQUIRED) NOT REQUIRED (HEIGHTS FLOOR BELOW 30FT.) FIRE STAND PIPE SYSTEM:

## DEFERRED APPROVALS

THE FOLLOWING ITEMS SHALL BE SUBJECT TO SEPARATE REVIEW AND APPROVAL: B MODULAR "GREEN SCREEN TRELLIS" FIRE ALARM SYSTEM (NO SCOPE) - EXT. SIGNAGE (PLANNING DEPT. APPVL. #PP16-003M) FIRE SPRINKLER SYSTEM (NO SCOPE) GRADING

### ZONE 10 TITLE 24 CLIMATE ZONE: LANDSCAPE SITE PARKING ANALYSIS ---- 617 N. MAIN STREET

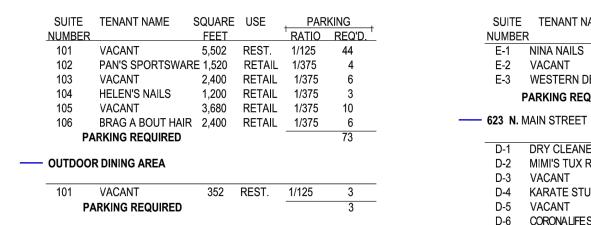

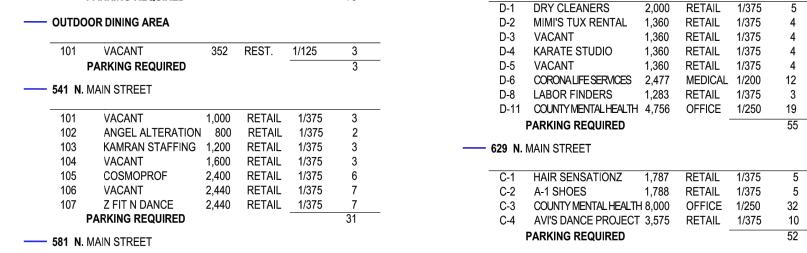

1,360 RETAIL 1/375 D-6 CORONALIFE SERVICES 2,477 MEDICAL 1/200 12 D-8 LABOR FINDERS 1,283 RETAIL 1/375 D-11 COUNTYMENTALHEALTH 4,756 OFFICE 1/250 19 PARKING REQUIRED 629 N. MAIN STREET PARKING REQUIRED ---- 635 N. MAIN STREET 22,193 RETAIL 1/375

C-1 HAIR SENSATIONZ 1,787 RETAIL 1/375 5 C-2 A-1 SHOES 1,788 RETAIL 1/375 C-3 COUNTY MENTAL HEALTH 8,000 OFFICE 1/250 32 C-4 AVI'S DANCE PROJECT 3,575 RETAIL 1/375 10 PEP BOYS PARKING REQUIRED B-1 REDWING SHOES 2,000 RETAIL 1/375 5 B-1a H. SALT SEA FOOD 1,200 REST. 1/125 10 TOTAL PARKING REQUIRED B-2 MAKI YAKI 1,200 REST. 1/125 10 PARKING PROVIDED (ON-SITE) B-3 SUBWAY 1,200 REST. 1/125 10 B-4 VACANT 2,000 RETAIL 1/375 PARKING REQUIRED — 641 N. MAIN STREET COMBINED PARKING REQUIRED

## PARKING PROVIDED (ON-SITE VICINITY MAP

COMBINED PARKING PROVIDED

## PROJECT TEAM

2,208 RETAIL 1/375 6

1900 MAIN STREET, STE. 375 **IRVINE, CA 92614** TEL: (949) 612-2742 FAX: (323) 848-6564 CONTACT: ASH BARAGHOUSH abaraghoush@irarealtycapital.com

A-2 SUPREME POOL SUPPLY 1,632 RETAIL 1/375 4

PARKING REQUIRED

**OWNER** 

IRA REALTY CAPITAL

TOTAL PARKING REQUIRED

### **STRUCTURAL** IDS GROUP I PETERS CANYON ROAD, SUITE 130 IRVINE, CALIFORNIA 92606 TEL: (949) 387-8500

I PETERS CANYON ROAD, SUITE 130

CONTACT: PETER GAMBINO, P.E.

IRVINE, CALIFORNIA 92606

TEL: (949) 387-8500

FAX: (949) 387-0800

TEL: (949) 387-8500 FAX: (949) 387-0800 FAX: (949) 387-0800 CONTACT: HUSSEIN BOUDIAB, P.E. CONTACT: RAMI ELHASSAN, S.E. LANDSCAPE **IDS GROUP** 

### COASTAL SAGE 936 BLUEJACK ROAD ENCINITAS, CALIFORNIA 92024 TEL: (760) 456-7907 FAX: -CONTACT: JOY LYNDES

**ARCHITECTURAL** 

IRVINE, CALIFORNIA 92606

CONTACT: JOHN SILBER, AIA

TEL: (949) 387-8500

FAX: (949) 387-0800

**ELECTRICAL** 

IDS GROUP

I PETERS CANYON ROAD, SUITE 130

GENE DIEP

I PETERS CANYON ROAD, SUITE 130

IRVINE, CALIFORNIA 92606

john.silber@idsgi.com

gene.diep@idsgi.com



IRA REALTY CAPITAL 1900 Main Street, Suite 375 Irvine, California 92614


SHOPS at **MAIN STREET -Exterior Building Improvements** 

511-581 North Main Street Corona, California 92880



1 PETERS CANYON ROAD, SUITE 130 IRVINE. CA. 92606 TEL: 949-387-8500, FAX: 949-387-0800

**IDS GROUP** 

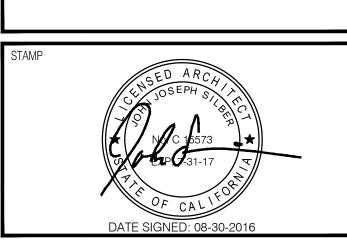


DATE REV. DESCRIPTION

05.31.16 PLAN CHECK SUBMITTAL PLAN CHECK RE-SUBMITTAL 07.06.16 PLAN CHECK RE-SUBMITTAL

PROJECT NO. 15X047.00 DRAWN BY

CHECKED BY

SHEET NUMBER

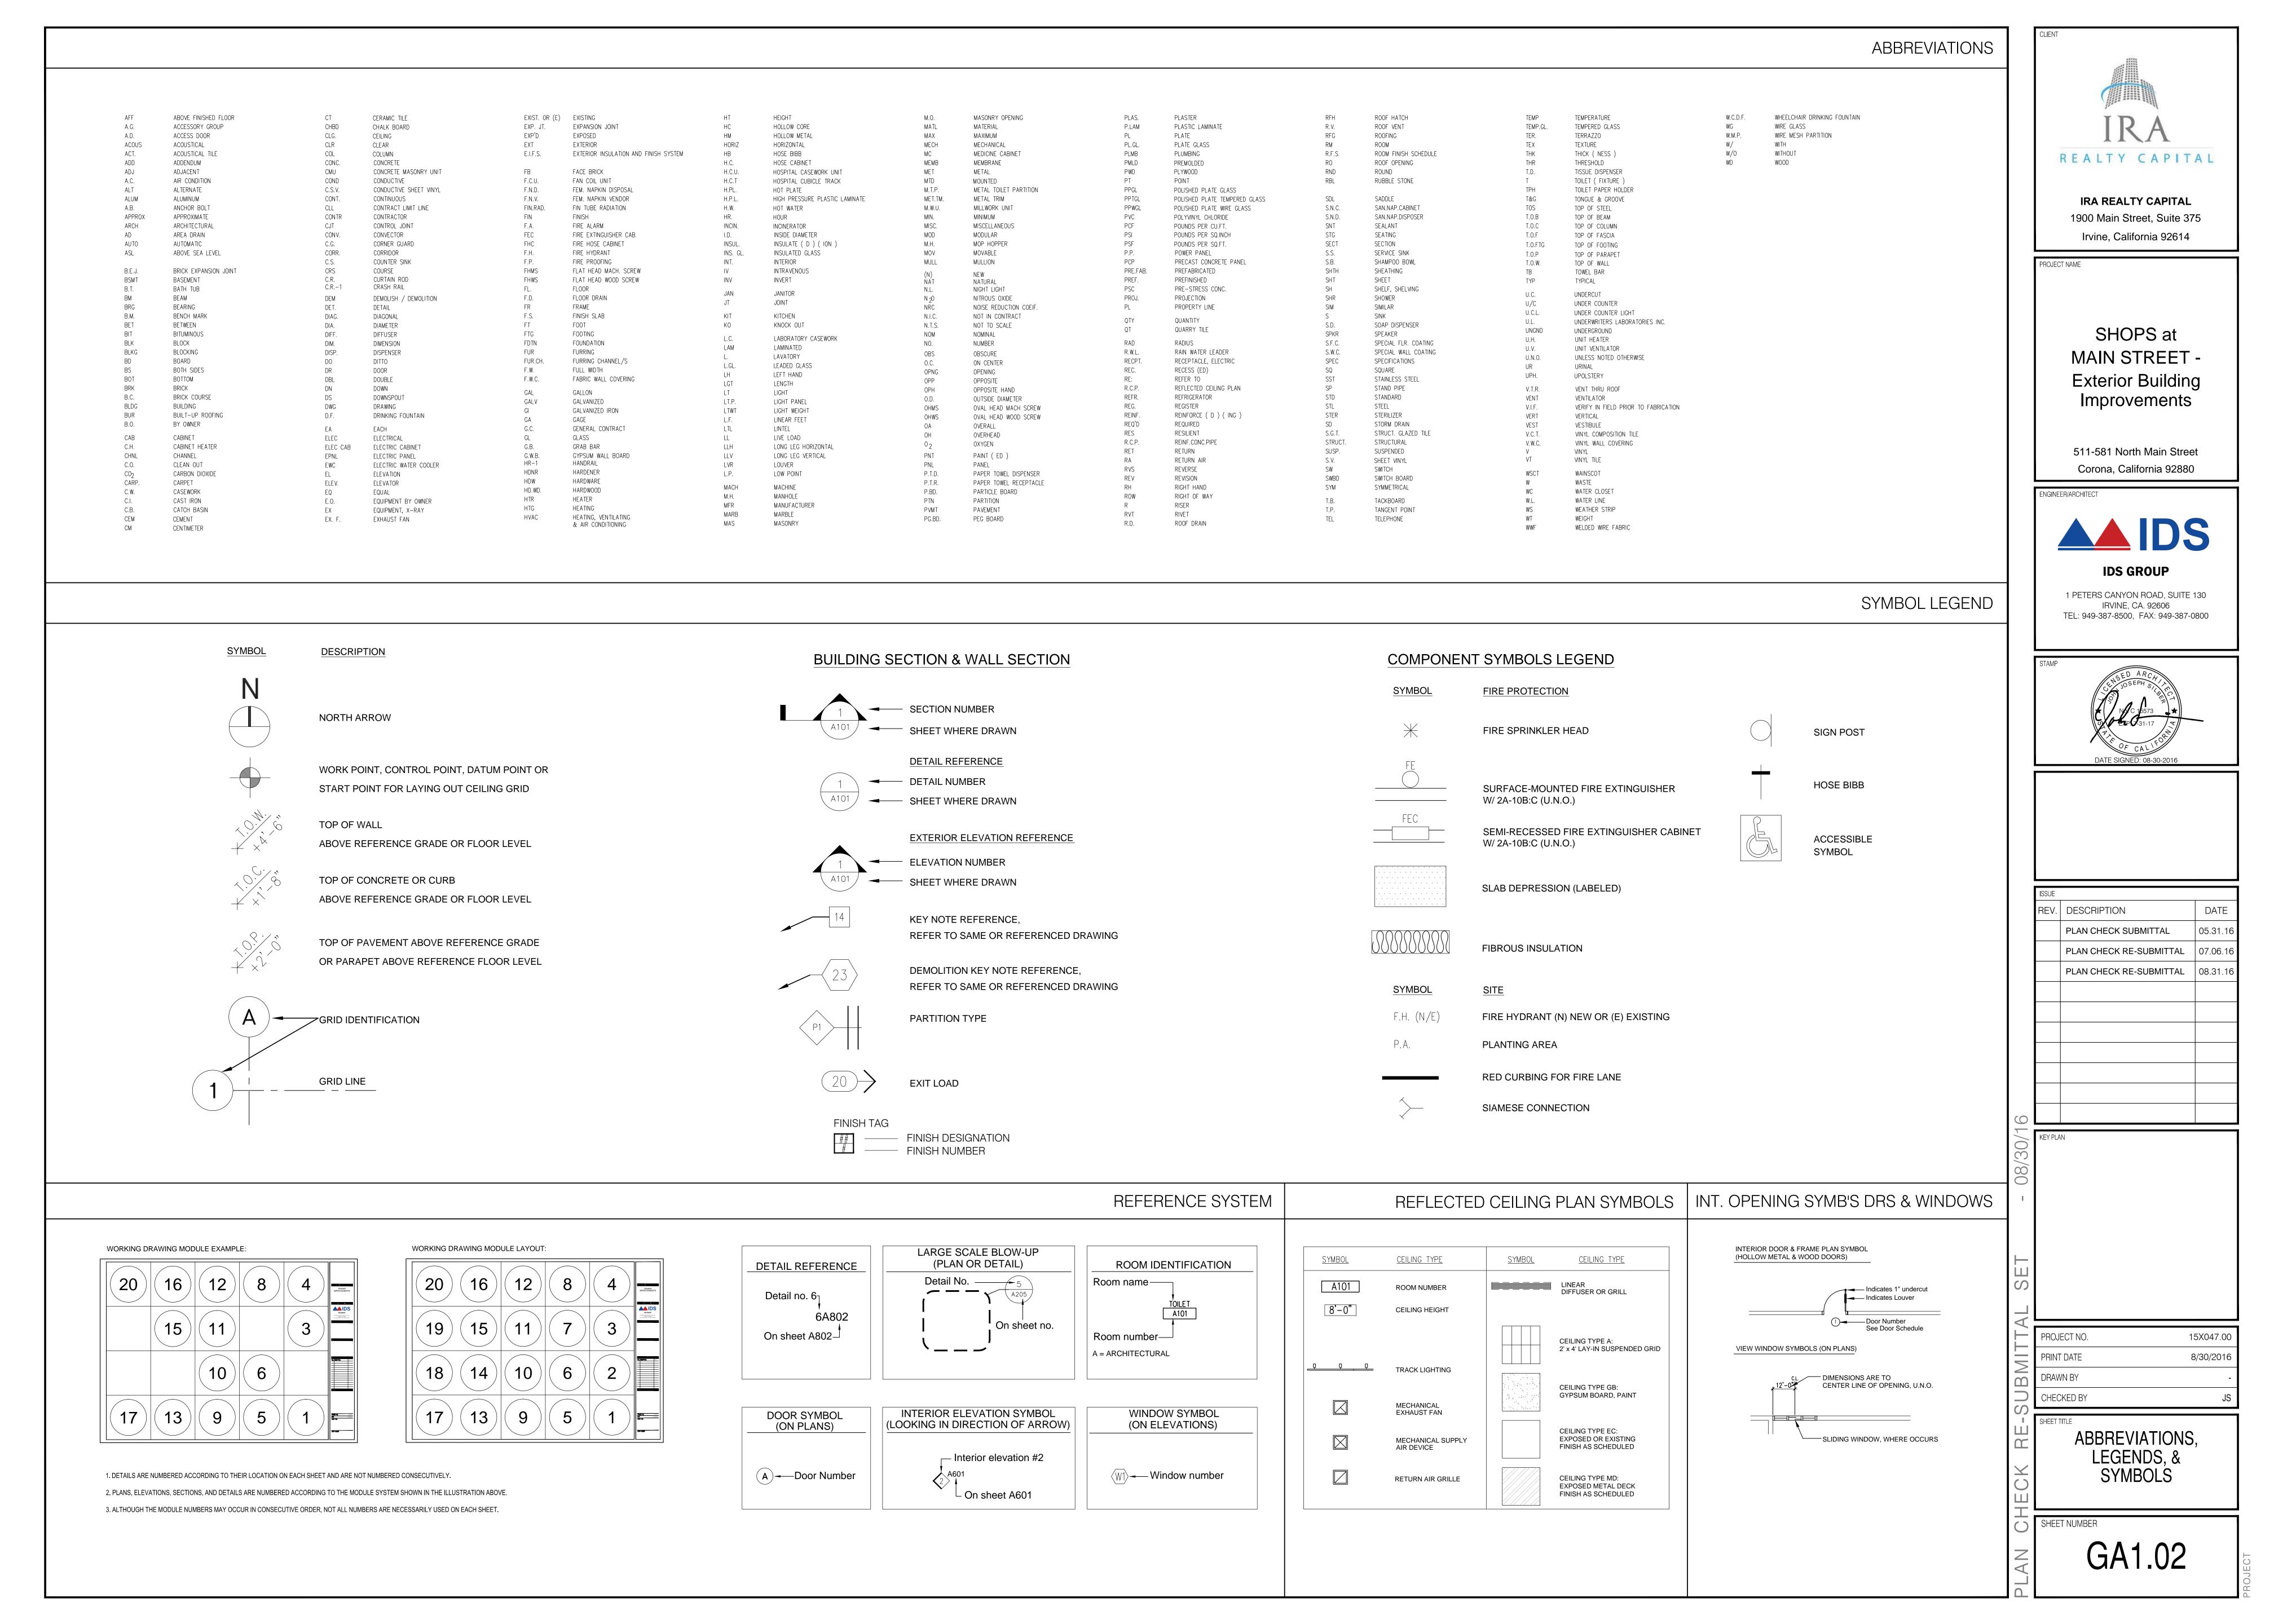

### DISABLE ACCESS PARKING SIGN REQUIREMENT AND ACCESSIBILITY SIGNAGE SIGNS AND IDENTIFICATIONS:

- 1. THE INTERNATIONAL SYMBOL OF ACCESSIBILITY SHALL BE THE STANDARD USED TO IDENTIFY FACILITIES THAT ARE ACCESSIBLE TO AND USABLE BY PHYSICALLY DISABLED PERSONS AS SET FORTH IN TITLE 24 AND AS SPECIFICALLY REQUIRED IN THIS SECTION.
- 2. THE INTERNATIONAL SYMBOL OF ACCESSIBILITY SHALL CONSIST OF A WHITE FIGURE ON A BLUE BACKGROUND. THE BLUE SHALL BE EQUAL TO COLOR NO. 15090 IN FEDERAL STANDARD 595B.
- 3. CHARACTER SPACING SHALL COMPLY WITH CBC 11B-703.2.7. CHARACTERS SHALL BE SEPERATED FROM RAISED BORDERS AND DECORATIVE ELEMENTS  $\frac{3}{8}$  INCH MINIMUM (CBC 11B-703.2.7).
- 4. CHARACTERS SAHLL BE SELECTED FROM FONTS WHERE THE WIDTH OF THE UPPERCASE LETTER "O" IS 60 PERCENT MINIMUM 110 PERCENT MAXIMUM OF THE HEIGHT OF THE UPPERCASE LETTER "I". STROKE THICKNESS OF THE UPPERCASE LETTER"I" SHALL BE 15 PERCENT MAXIMUM OF THE HEIGHT OF THE CHARACTER. (CBC 11B-703.2.4 & CBC 11B-703.2.6)
- 5. CHARACTERS AND SYMBOLS SHALL CONTRAST WITH THEIR BACKGROUND, EITHER LIGHT CHARACTERS ON A DARK BACKGROUND OR DARK CHARACTERS ON A LIGHT BACKGROUND.
- WHEN RAISED CHARACTERS OR SYMBOLS ARE USED, THEY SHALL CONFORM TO THE FOLLOWING:

  A. LETTERS AND NUMBERS ON SIGNS SHALL BE RAISED 1/32" MINIMUM (CBC 11B-703.2.1) AND SHALL BE SAN-SERIF UPPERCASE CHARACTERS ACCOMPANIED BY GRADE 2 BRAILLE COMPLYING WITH (CBC 11B-702.2.3)
- B. RAISED CHARACTERS OR SYMBOLS SHALL BE A MINIMUM OF 5/8" HIGH & MAX OF 2". (CBC 11B-703.2.5)
- C. PICTORIAL SYMBOL SIGNS (PICTOGRAMS) SHALL BE ACCOMPANIED BY THE EQUIVALENT VERBAL DESCRIPTION PLACED DIRECTLY BELOW THE PICTOGRAM. THE BORDER DIMENSION OF THE PICTOGRAM SHALL BE A MINIMUM OF 6" IN HEIGHT. (CBC 11B-703.6)
- 7. CONTRACTED (GRADE 2) BRAILLE SHALL BE USED WHEREVER BRAILLE IS REQUIRED IN OTHER PORTIONS OF THESE STANDARDS. DOTS SHALL BE 2.50 MM) ON CENTER IN EACH CELL WITH (7.6 MM) SPACE BETWEEN CELLS, MEASURED FROM THE FIRST COLUMN OF DOTS IN THE FIRST CELL TO THE FIRST COLUMN OF DOTS IN THE SECOND CELL. DOTS SHALL BE RAISED A MINIMUM OF (0.60 MM) ABOVE THE BACKGROUND. BRAILLE DOTS SHALL BE DOMED OR ROUNDED.
- 8. ENTRANCES TO BUILDINGS AND FACILITIES THAT ARE ACCESSIBLE TO AND USABLE BY PERSONS WITH DISABILITIES SHALL BE IDENTIFIED WITH A MINIMUM OF ONE INTERNATIONAL SYMBOL OF ACCESSIBILITY AND WITH ADDITIONAL DIRECTIONAL SIGNS, UTILIZING THE SYMBOL, AT JUNCTIONS WHERE THE ACCESSIBLE ROUTE OF TRAVEL DIVERGES FROM THE REGULAR CIRCULATION PATH, TO BE VISIBLE TO PERSONS ALONG APPROACHING CIRCULATION PATHS. EXISTING BUILDINGS AND FACILITIES, ENTRANCES WHICH ARE NOT ACCESSIBLE SHALL HAVE DIRECTIONAL SIGNAGE COMPLYING, WHICH INDICATES THE LOCATION OF AND ROUTE TO THE NEAREST ACCESSIBLE ENTRANCE.
- EACH PARKING SPACE RESERVED FOR PERSONS WITH DISABILITIES SHALL BE IDENTIFIED BY REFLECTORIZED SIGN PERMANENTLY POSTED IMMEDIATELY ADJACENT TO AND VISIBLE FROM EACH STALL OR SPACE, CONSISTING OF A PROFILE VIEW OF A WHEELCHAIR WITH OCCUPANT IN WHITE ON DARK BLUE BACKGROUND. PARKING IDENTIFICATION SIGNS SHALL BE REFLECTORIZED WITH A MINIMUM AREA OF 70 SQUARE INCHES AND, WHEN IN A PATH OF TRAVEL, SHALL BE POSTED AT A MINIMUM HEIGHT OF 80" FROM ABOVE THE FINISH GROUND SURFACE MEASURED TO THE BOTTOM OF THE SIGN. SIGNS MAY ALSO BE CENTERED ON THE WALL AT THE INTERIOR END OF THE PARKING SPACE. AN ADDITIONAL SIGN OR ADDITIONAL LANGUAGE BELOW THE SYMBOL OF ACCESSIBILITY SHALL STATE "MINIMUM FINE \$250." (CBC 2013 11B 502.6)
- 10. SIGNS TO IDENTIFY ACCESSIBLE PARKING SPACES MAY BE CENTERED ON THE WALL AND AT THE INTERIOR OF THE PARKING SPACE AT 80" MINIMUM ABOVE FINISH GROUND SURFACE MEASURE TO THE BOTTOM OF THE SIGN. (CBC 2013 11B 502.6)
- 11. VAN ACCESSIBLE PARKING SPACES SHALL HAVE AN ADDITIONAL SIGN STATE "VAN-ACCESSIBLE" MOUNTED BELOW THE SYMBOL OF ACCESSIBILITY. AND SIGN SHALL BE 80" ABOVE FINISH FLOOR (CBC 11B-502.6)
- 13. ADDITIONAL SIGN SHALL ALSO BE POSTED, IN A CONSPICUOUS PLACE, AT EACH ENTRANCE TO OFF-STREET PARKING FACILITIES, OR IMMEDIATELY ADJACENT TO AND VISIBLE FROM EACH STALL OR SPACE. THE SIGN SHALL BE NOT LESS THAN 17" BY 22" IN SIZE WITH LETTERING NOT LESS THAN 1" IN HEIGHT. (CBC 2013 11B-502.8)
- 14. EACH ACCESSIBLE CAR AND VAN SPACE SHALL HAVE SURFACE IDENTIFICATION COMPLYING WITH EITHER OF THE FOLLOWING SCHEMES:
- A. THE PARKING SPACE SHALL BE MARKED WITH AN INTERNATIONAL SYMBOL OF ACCESSIBILITY IN WHITE ON A BLUE BACKGROUND A MINIMUM 36 INCHES WIDE BY 36 INCHES HIGH. THE CENTERLINE OF THE INTERNATIONAL SYMBOL OF ACCESSIBILITY SHALL BE A MAXIMUM OF 6 INCHES FROM THE CENTERLINE OF THE PARKING SPACE, ITS SIDES PARALLEL TO THE LENGTH OF THE PARKING SPACE AND ITS LOWER CORNER AT, OR LOWER SIDE ALIGNED WITH, THE END OF THE PARKING SPACE LENGTH;
- B. THE PARKING SPACE SHALL BE OUTLINED OR PAINTED BLUE AND SHALL BE MARKED WITH AN INTERNATIONAL SYMBOL OF ACCESSIBILITY A MINIMUM 36 INCHES WIDE BY 36 INCHES HIGH IN WHITE OR A SUITABLE CONTRACTING COLOR. THE CENTERLINE OF THE INTERNATIONAL SYMBOL OF ACCESSIBILITY SHALL BE A MAXIMUM OF 6 INCHES FROM THE CENTERLINE OF THE PARKING SPACE, ITS SIDES PARALLEL TO THE LENGTH OF THE PARKING SPACE AND ITS LOWER CORNER AT, OR LOWER SIDE ALIGNED WITH, THE END OF THE PARKING SPACE (CBC 11B 502.6.4).
- 15. ALL PARKING FACILITIES SHALL COMPLY WITH THE REQUIREMENTS OF THE CALIFORNIA CODE OF REGULATIONS (TITLE 24, PART 2, CHAPTER 2-71) AND WITH THE SIGN REQUIREMENTS OF THE CALIFORNIA VEHICLE CODE. SECTION 22507.8 AND SECTION 22511.8.

### ACCESSIBLE SIGNAGE NOTES:

- 1. GENERAL CONTRACTOR TO VERIFY EXISTING SIGNAGE IN FIELD AND PROVIDE NEW AS REQUIRED TO COMPLY WITH APPLICABLE BUILDING CODES.
- 2. ALL SIGNAGE SHALL CONFORM WITH ADA ACCESSIBILITY GUIDELINES AND 2013 CBC CHAPTER 11B SEC. 11B-216 AND 11B-703. INCLUDING BUT NOT LIMITED TO PROPORTION. COLOR CONTRAST AND RELIEF.
- 3. GENERAL CONTRACTOR TO VERIFY EXISTING SIGNAGE INSTALLATIONS AND PROVIDE NEW AS REQUIRED.
- 4. CHARACTERS, SYMBOLS AND BACKGROUND SHALL HAVE A NON-GLARE FINISH.
- 5. CHARACTERS AND SYMBOLS SHALL CONTRAST WITH THE BACKGROUND, EITHER LIGHT ON DARK BACKGROUND OR DARK ON LIGHT BACKGROUND.
- 6. MOUNTING LOCATION SHALL BE SO THAT A PERSON APPROACHING WITHIN 3" OF SIGN DOES NOT ENCOUNTER PROTRUDING OBJECTS OR WITHIN THE SWING OF A DOOR. (CBC 11B-703.4.1)
- 7. SIGN SHALL COMPLY WITH CBC 11B-216.
- 8. REFER TO SHEET A006 FOR ADDITIONAL SIGNAGE AND GRAPHIC INFORMATION.

### ACCESSIBLE SANITARY FACILITIES (GENERAL):

- 1. SANITARY FACILITIES THAT SERVE BUILDINGS, FACILITIES OR PORTIONS OF BUILDINGS OR FACILITIES THAT ARE REQUIRED TO BE ACCESSIBLE TO PERSONS WITH DISABILITIES ARE REQUIRED TO BE ACCESSIBLE. (CBC 11B-601)
- 2. WHERE SEPARATE FACILITIES ARE PROVIDED FOR NON-DISABLE PERSONS FOR EACH SEX, SEPARATE FACILITIES SHALL BE PROVIDED FOR PERSONS WITH DISABILITIES OF EACH SEX ALSO. WHERE UNISEX FACILITIES ARE PROVIDED FOR NON-HANDICAPPED/NON-DISABLED PERSONS, SUCH UNISEX FACILITIES CAN BE PROVIDED FOR PERSONS WITH DISABILITIES.
- 3. DOORWAYS LEADING TO MEN'S SANITARY FACILITIES SHALL BE IDENTIFIED BY AN EQUILATERAL TRIANGLE 1/4" THICK WITH EDGES 12" LONG AND A VERTEX POINTING UPWARD. WOMEN'S SANITARY FACILITIES SHALL BE IDENTIFIED BY A CIRCLE 1/4" THICK AND 12" IN DIAMETER. (CBC 11B-703.7.2.6 AND 11B-703.7.2.6.2).
- 4. UNISEX SANITARY FACILITIES SHALL BE IDENTIFIED BY A CIRCLE 1/4" THICK, 12" IN DIAMETER, WITH A 1/4" THICK TRIANGLE SUPERIMPOSED ON THE CIRCLE AND WITHIN THE 12" DIAMETER. (CBC 11B-703.7.2.6.3)
- ON THE DOOR AT A HEIGHT OF 58" MIN TO 60" MAX ABOVE FINISH FLOOR AND THEIR COLOR AND CONTRAST SHALL BE DISTINCTLY DIFFERENT FROM THE COLOR AND CONTRAST OF THE DOOR. (CBC 11B-703.7.2.6)

### **GRAB BARS**

- 1. GRAB BARS SHALL BE LOCATED ON EACH SIDE, OR AN ONE SIDE AND THE BACK OF THE ACCESSIBLE TOILET STALL OR COMPARTMENT. (CBC 11B-604.5)
- 2. GRAB BARS AT THE SIDE SHALL BE AT LEAST 42" LONG WITH THE FRONT END POSITIONED 24" IN FRONT OF THE WATER CLOSET STOOL AND WITH THE BACK END POSITIONED NO MORE THAN 12" FROM THE REAR WALL, GRAB BARS AT THE BACK SHALL BE NOT LESS THAN 36" LONG. (CBC 11B-604.5.1)
- 3. GRAB BARS SHALL BE SECURELY ATTACHED 33" MIN AND 36" MAX ABOVE AND PARALLEL TO THE FLOOR MEASURED TO TOP OF GRIPPING SURFACE. (CBC 11B-609.4)
- 4. THE DIAMETER OR WIDTH OF THE GRIPPING SURFACES OF A GRAB BAR SHALL BE 1-1/4" TO 1-1/2" OR THE SHAPE SHALL PROVIDE AN EQUIVALENT GRIPPING SURFACE. IF GRAB BARS ARE MOUNTED ADJACENT TO A WALL, THE SPACE BETWEEN THE WALL AND THE GRAB BARS SHALL BE 1-1/2". (CBC 11B-609.2)
- 5. THE STRUCTURAL STRENGTH OF GRAB BARS, TUB AND SHOWER SEATS, FASTENERS, AND MOUNTING DEVICES SHALL MEET THE FOLLOWING SPECIFICATIONS: (CBC 11B-609.8)
- A. BENDING STRESS IN A GRAB BAR OR SEAT INDUCED BY THE MAXIMUM BENDING MOMENT FROM THE APPLICATION OF A 250-LB. POINT LOAD SHALL BE LESS THAN THE ALLOWABLE STRESS FOR THE MATERIAL OF THE GRAB BAR OR SEAT.
- B. SHEAR STRESS INDUCED IN A GRAB BAR OR SEAT BY THE APPLICATION OF A 250-LB. POINT LOAD SHALL BE LESS THAT THE ALLOWABLE SHEAR STRESS FOR THE MATERIAL OF HE GRAB BAR OR SEAT, AND ITS MOUNTING BRACKET OR OTHER SUPPORT IS CONSIDERED TO FULLY RESTRAINED, THEN DIRECT AND TORSIONAL SHEAR STRESSES SHALL NOT EXCEED THE ALLOWABLE SHEAR STRESS.
- C. SHEAR FORCE INDUCED IN FASTENER OR MOUNTING DEVICES FROM THE APPLICATION OF A 250-LB. POINT LOAD SHALL BE LESS THAN THE ALLOWABLE LATERAL LOAD OF EITHER THE FASTENER OR MOUNTING DEVICE OR HE SUPPORTING STRUCTURE, WHICHEVER HAS THE SMALLER ALLOWABLE LOAD.
- D. TENSILE FORCE INDUCED IN A FASTENER BY A DIRECT TENSION FORCE OF A 250-LB. POINT LOAD, PLUS THE MAXIMUM MOMENT FORM THE APPLICATION OF A 250-LB. POINT LOAD, SHALL BE LESS THAN THE ALLOWABLE WITHDRAWAL LOAD BETWEEN THE FASTENER AND
- SUPPORTING STRUCTURE.

  E. GRAB BARS SHALL NOT ROTATE WITHIN THEIR FITTINGS.
- 6. THE GRAB BAR AND ANY WALL OR OTHER SURFACE ADJACENT TO IT SHALL BE FREE OF ANY SHARP OR ABRASIVE ELEMENTS AND SHALL BE ROUNDED EDGES (CBC 11B-609.5)

### SANITARY FACILITIES FIXTURES & ACCESSORIES:

- 1. THE HEIGHT OF ACCESSIBLE WATER CLOSETS SHALL BE A MINIMUM OF 17" AND A MAXIMUM OF 19" MEASURED TO THE TOP OF A MAXIMUM 2" HIGH TOILET SEAT, EXCEPT THAT 3" SEATS SHALL BE PERMITTED ONLY IN ALTERATIONS WHERE THE EXISTING FIXTURE IS LESS THAN 15" HIGH. (CBC 11B-604.4)
- 2. A CLEAR FLOOR SPACE 30" BY 48" SHALL BE PROVIDED IN FRONT OF A LAVATORY TO ALLOW A FORWARD APPROACH. SUCH CLEAR FLOOR SPACE SHALL ADJOIN OR OVERLAP AN ACCESSIBLE ROUTE AND SHALL EXTEND INTO KNEE AND TOE SPACE UNDERNEATH THE LAVATORY. (CBC 11B-305)
- 3. LAVATORIES ADJACENT TO A WALL SHALL BE MOUNTED WITH A MINIMUM DISTANCE OF 18" TO THE CENTERLINE OF THE FIXTURE. (CBC 11B-606.6)
- 4. LAVATORIES SHALL BE MOUNTED WITH THE RIM OR COUNTER SURFACE NO HIGHER THAN 34" ABOVE THE FINISHED FLOOR AND WITH A CLEARANCE OF AT LEAST 29" FROM THE FLOOR TO THE BOTTOM OF THE APRON WITH KNEE CLEARANCE UNDER THE FRONT LIP EXTENDING A MINIMUM OF 30" IN WIDTH AND 8" MINIMUM DEPTH AT THE TOP. TOE CLEARANCE SHALL BE THE SAME WIDTH AND SHALL BE A MINIMUM OF 9" HIGH FROM THE FLOOR AND A MINIMUM OF 17" DEEP FROM THE FRONT OF THE LAVATORY. (CBC 11B-606.2 AND 11B-606.3)
- 5. HOT WATER AND DRAIN PIPES ACCESSIBLE UNDER LAVATORIES SHALL BE INSULATED OR OTHERWISE COVERED. THERE SHALL BE NO SHARP OR ABRASIVE SURFACES UNDER
- LAVATORIES. (CBC 11B-606.5)
  6. WHERE URINALS ARE PROVIDED, AT LEAST ONE SHALL HAVE A CLEAR FLOOR SPACE 30" BY 48" IN
- FRONT OF THE URINAL TO ALLOW FORWARD APPROACH. (CBC 11B-605.3)
  7. CONTROLS FOR WATER CLOSET FLUSH VALVES SHALL BE MOUNTED ON THE WIDE SIDE OF
- TOILET AREAS. (CBC 11B-604.6)

  8. WATER CLOSET AND URINAL FLUSH VALVE CONTROLS, AND FAUCET AND OPERATING MECHANISM CONTROLS, SHALL BE OPERABLE WITH ONE HAND, SHALL NOT REQUIRE TIGHT GRASPING, PINCHING, OR TWISTING OF THE WRIST, AND SHALL BE MOUNTED NO MORE THAN 44" ABOVE THE
- FLOOR. (CBC 11B-606.4)

  9. THE FORCE REQUIRED TO ACTIVATE WATER CLOSET AND URINAL FLUSH VALVE CONTROLS, AND FAUCET AND OPERATING MECHANISM CONTROLS, SHALL BE NO GREATER THAN 5 LBF. (CBC
- 11B-309.4)
  10. SELF-CLOSING FAUCET CONTROL VALVES ARE ALLOWED IF THE FAUCET REMAINS OPEN FOR AT
- LEAST 10 SECOND.

  11. MIRRORS SHALL BE MOUNTED WITH THE BOTTOM EDGE NO HIGHER THAN 40" FROM THE FLOOR.
- (CBC 11B-603.3)

  12. ALL LAVATORIES THAT ARE DESIGNATED TO BE ACCESSIBLE SHALL BE MOUNTED WITH THE RIM OR COUNTER EDGE NO HIGHER THAN 34" ABOVE THE FINISHED FLOOR AND WITH A VERTICAL CLEARANCE MEASURED FROM THE BOTTOM OF THE APRON OR OUTSIDE BOTTOM EDGE OF THE LAVATORY OF 29", REDUCING TO 27" AT A POINT LOCATED 8" BACK FROM THE FRONT EDGE. KNEE CLEARANCE BELOW THE LAVATORY SHALL EXTEND A MINIMUM OF 30" IN WIDTH BY 17" IN DEPTH.
- FLOOR AND A MINIMUM OF 17" DEEP FROM THE FRONT OF THE LAVATORY.

  13. WHERE TOWEL, SANITARY NAPKINS, WASTE RECEPTACLES, AND OTHER SIMILAR DISPENSING AND DISPOSAL FIXTURES ARE PROVIDED, AT LEAST ONE OF EACH TYPE SHALL BE LOCATED WITH ALL OPERABLE PARTS. INCLUDING COIN SLOTS. WITHIN 40" FROM THE FINISHED FLOOR. (CBC

TOE CLEARANCE SHALL BE THE SAME WIDTH AND SHALL BE A MINIMUM OF 9" HIGH FROM THE

- 14. TOILET TISSUES DISPENSERS SHALL BE 7" MIN AND 9" MAX IN FRONT OF WATER CLOSET. THE OUTLET OF THE DISPENSER SHALL BE BELOW THE GRAB BAR AND 19" MIN ABOVE FINISH FLOOR. DISPENSERS THAT CONTROL DELIVERY OR THAT DO NOT PERMIT CONTINUOUS PAPER FLOW SHALL NOT BE USED. (CBC 11B-604.7)
- 15. TOILET ROOM FLOORS SHALL HAVE A SMOOTH, HARD, NON-ABSORBENT SURFACE SUCH AS PORTLAND CEMENT, CONCRETE, CERAMIC TILE OR OTHER APPROVED MATERIAL WHICH EXTENDS UPWARD ONTO THE WALLS AT LEAST 5". WALLS WITHIN WATER CLOSET COMPARTMENT AND WALLS WITHIN 24" OF THE FRONT AND SIDES IF URINALS SHALL BE SIMILARLY FINISHED TO A HEIGHT OR 48" AND, EXCEPT FOR STRUCTURAL ELEMENTS, THE MATERIALS USED IN SUCH WALLS
- SHALL BE A TYPE WHICH IS NOT ADVERSELY AFFECTED BY MOISTURE.

  16. WATER CLOSET SEATS, FOR PUBLIC USE, SHALL BE ELONGATED TYPE AND EITHER OF THE OPEN FRONT TYPE OR HAVE AN AUTOMATIC SEAT COVER DISPENSER (CPC 411.2.1)

### ACCESSIBLE PATH OF TRAVEL NOTES:

- ACCESSIBLE ROUTE OF TRAVEL IS DEFINED AS "A CONTINUOUS UNOBSTRUCTED PATH CONNECTING ACCESSIBLE ELEMENTS AND SPACES OF AN ACCESSIBLE SITE, BUILDING OR FACILITY THAT CAN BE NEGOTIATED BY A PERSON WITH A DISABILITY USING A WHEELCHAIR, AND THAT IS ALSO SAFE FOR AND USABLE BY PERSONS WITH OTHER DISABILITIES. INTERIOR ACCESSIBLE ROUTES MAY INCLUDE CORRIDORS, HALLWAYS, FLOORS, RAMPS, ELEVATORS AND LIFTS. EXTERIOR ACCESSIBLE ROUTES MAY INCLUDE PARKING ACCESS AISLES, CURB RAMPS, CROSSWALKS AT VEHICULAR WAYS, WALKS, RAMPS AND LIFTS."
- 2. THE ACCESSIBLE ROUTE OF TRAVEL SHALL BE THE MOST PRACTICAL DIRECT ROUTE BETWEEN ACCESSIBLE BUILDING ENTRANCES, ACCESSIBLE SITE FACILITIES AND THE ACCESSIBLE ENTRANCE TO THE SITE. WHERE PARKING LOTS SERVE ACCESSIBLE ENTRANCES OF SEVERAL BUILDINGS OR DIFFERENT AREAS ON SITE, ACCESSIBLE PARKING SPACES MUST BE DISPERSED AND LOCATED CLOSEST TO THE ACCESSIBLE ROUTE OF TRAVEL. STALLS MAY BE PROVIDED IN A DIFFERENT LOCATION OR BE CLUSTERED IN ONE OR MORE LOTS IF EQUIVALENT OR GREATER ACCESSIBILITY IS ENSURED, IN TERMS OF DISTANCE FROM AN ACCESSIBLE ENTRANCE, USER COST AND CONVENIENCE
- 3. EACH REQUIRED ACCESSIBLE MEANS OF EGRESS SHALL CONSIST OF ONE OR MORE OF THE COMPONENTS LISTED IN CBC 1007.2.
- 4. ANY PATH OF TRAVEL SHALL BE CONSIDERED A RAMP IF ITS SLOPE IS GREATER THAN 1' RISE IN 20' OF HORIZONTAL RUN. (CBC CHAPTER 2)
- 5. PATH OF TRAVEL SHALL HAVE A CROSS SLOPE OF EQUAL OR LESS THAN  $\leq 2\%$ .
- 6. ACCESSIBLE PATH OF TRAVEL AS INDICATED ON PLAN IS A BARRIERFREE ACCESS ROUTE WITHOUT ANY ABRUPT LEVEL CHANGES EXCEEDING 1/2" IF BEVELED AT 1:2 MAX SLOPE, OR VERTICAL LEVEL CHANGES NOT EXCEEDING 1/4" MAX, AND AT LEAST 48" IN SURFACE IS STABLE, FIRM, AND SLIP RESISTANT. CROSS SLOPE DOES NOT EXCEED 2% AND SLOPE IN THE DIRECTION OF TRAVEL IS LESS THAN 5%, UNLESS OTHERWISE INDICATED. ACCESSIBLE PATH OF TRAVEL SHALL BE MAINTAINED FREE OF OVERHANGING OBSTRUCTIONS TO 80" INCH MINIMUM, AND PROTRUDING OBJECTS GREATER THAN 4" INCH PROJECTION FROM WALL AND ABOVE 27" AND LESS THAN 80". ARCHITECT SHALL VERIFY THAT THERE ARE NO BARRIERS IN THE PATH OF TRAVEL.

7. ACCESSIBLE ROUTE WIDTH SHALL BE MAINTAINED AT 48 INCHES MINIMUM.

- 9. ACCESSIBLE ROUTE SHALL BE SLIP RESISTANT, SURFACES WITH SLOPES UP TO 6% SHALL BE
  - 10. VERTICAL CHANGE IN ACCESSIBLE ROUTE SHALL NOT EXCEED \( \frac{1}{4} \) INCH. LEVEL CHANGE IN ACCESSIBLE ROUTE BETWEEN \( \frac{1}{4} \) INCH AND 1/2 INCH MUST BE BEVELED AT 1:2 MAX SLOPE. TRANSITIONS FROM BAMBS TO WALKS CUTTERS OF STREETS TO BE FILED AND EDGE OF ARBUIDT CHANGES.
  - RAMPS TO WALKS, GUTTERS, OR STREETS TO BE FLUSH AND FREE OF ABRUPT CHANGES.

    1. PARKING STALLS AND ACCESS AISLE GRADE SHALL BE LIMITED TO A 2% MAX SLOPE IN ANY
  - 12. MINIMUM VERTICAL CLEARANCE OF 98 INCHES AT ACCESSIBLE PARKING SPACES AND ALONG VEHICLE ACCESS ROUTE TO SITE ENTRANCES AND EXITS SHALL BE PROVIDED.
- 13. DETECTABLE WARNINGS AT THE FOLLOWING LOCATIONS SHALL COMPLY WITH 11B-705.1.1. REQUIRED
- LOCATIONS SHALL INCLUDE:
- PLATFORM EDGES DETECTABLE WARNING SURFACES AT PLATFORM BOARDING EDGES SHALL BE 24
  INCHES WIDE AND SHALL EXTEND THE FULL LENGTH OF THE PUBLIC USE AREAS OF THE PLATFORM.

   CHERRY OF THE PLATFORM.
- CURB RAMPS- DETECTABLE WARNINGS SHALL EXTEND THE FULL WIDTH OF THE RAMP RUN EXCLUDING ANY FLARED SIDES.
   PEDESTRIAN ISLANDS- DETECTABLE WARNINGS AT PEDESTRIAN DETECTABLE WARNINGS AT
- PEDESTRIAN ISLANDS- DETECTABLE WARNINGS AT PEDESTRIAN DETECTABLE WARNING WARNING WARNING WARNING WARNING WAR
- IN WIDTH.
   HAZARDOUS VEHICLE AREAS- DETECTABLE WARNINGS AT HAZARDOUS VEHICULAR AREAS SHALL BE 36

BUS STOPS- WHEN DETECTABLE WARNINGS ARE PROVIDED AT BUS STOP PADS, IT SHALL BE 36 INCHES

INCHES IN WIDTH.

• REFLECTING POOLS- WHEN DETECTABLE WARNINGS ARE PROVIDED AT REFLECTING POOLS, IT SHALL

THE DIRECTION OF PEDESTRIAN TRAVEL AND EXTEND THE FULL WIDTH OF THE CIRCULATION PATH.

BE 24 INCHES (610 MM) MINIMUM AND 36 INCHES MAXIMUM IN WIDTH.

• RAILROAD TRACK CROSSING- DETECTABLE WARNINGS AT TRACK CROSSINGS SHALL BE 36 INCHES IN

- SPACE ALLOWANCE AND VERTICAL CHANGE
- 1. THE MINIMUM CLEAR FLOOR OR GROUND SPACE REQUIRED TO ACCOMMODATE A SINGLE, STATIONARY WHEELCHAIR AND OCCUPANT IS 30" BY 48". THE MINIMUM FLOOR OR GROUND SPACE SHALL BE INCREASED TO 42" BY 48" WHEN SUCH SPACE IS PERPENDICULAR TO AN ADJACENT SEATING SPACE. THE MINIMUM CLEAR FLOOR OR GROUND SPACE FOR WHEELCHAIRS MAY BE POSITIONED FOR FORWARD OR PARALLEL APPROACH TO AN OBJECT. CLEAR FLOOR OR GROUND SPACE FOR WHEELCHAIRS MAY BE PART OF THE KNEE SPACE REQUIRED UNDER SOME OBJECTS. CBC 11B-305 AND 11B-306
- 2. ONE FULL UNOBSTRUCTED SIDE OF THE CLEAR FLOOR OR GROUND SPACE FOR A WHEELCHAIR SHALL ADJOIN OR OVERLAP AN ACCESSIBLE ROUTE OR ADJOIN ANOTHER WHEELCHAIR CLEAR FLOOR SPACE. IF A CLEAR FLOOR OR GROUND SPACE FOR A WHEELCHAIR IS LOCATED IN AN ALCOVE OR OTHERWISE CONFINED ON ALL OR PART OF THREE SIDES, ADDITIONAL MANEUVERING CLEARANCES SHALL BE PROVIDED. CBC 11B-304 AND 11B-305 7
- 3. THE SPACE REQUIRED FOR A WHEELCHAIR TO MAKE A 180 DEGREE TURN IS A CLEAR SPACE OF 60" DIAMETER OR A T-SHAPED SPACE. (CBC 11B-304.3)
- 4. THE MINIMUM CLEAR WIDTH REQUIRED FOR A WHEELCHAIR TO TURN AROUND AN OBSTRUCTION SHALL BE 36" WHERE THE OBSTRUCTION IS 48" OR MORE IN LENGTH AND 42" AND 48" WHERE THE OBSTRUCTION IS LESS THAN 48" IN LENGTH.
- THE MINIMUM CLEAR WIDTH FOR SINGLE WHEELCHAIR PASSAGE SHALL BE 32" AT A POINT (24" MAXIMUM LENGTH) AND 36" CONTINUOUSLY.
- 6. IF THE CLEAR FLOOR SPACE ONLY ALLOWS FORWARD APPROACH TO AN OBJECT, THE MAXIMUM HIGH FORWARD REACH ALLOWED SHALL BE 48". THE MINIMUM LOW FORWARD REACH IS 15". (CBC 11B-308.2.1) IF THE HIGH FORWARD REACH IS OVER AN OBSTRUCTION, REACH AND CLEARANCES SHALL BE AS SHOWN IN FIGURE 11B-308.2.2
- 7. IF THE CLEAR FLOOR SPACE ALLOWS PARALLEL APPROACH BY A PERSON IN A WHEELCHAIR, THE MAXIMUM HIGH SIDE REACH ALLOWED SHALL BE 48" AND THE LOW SIDE REACH SHALL BE NO LESS THAN 15" ABOVE THE FLOOR AS SHOWN IN FIGURE 11B-308.3.1. IF THE SIDE REACH IS OVER AN OBSTRUCTION, THE REACH AND CLEARANCES SHALL BE A SHOWN IN FIGURE 11B-308.2.2



FIG. 11B-308.5.5


BEVELED CHANGE IN LEVEL

### FLOORS AND LEVELS

(CBC 11B-308.3.2)

- POSITION OF CLEAR FLOOR OR GROUND SPACE

  1. LEVEL AREA IS DEFINED AS "A SPECIFIED SURFACE THAT DOES NOT HAVE A SLOPE IN ANY DIRECTION EXCEEDIN 1/4 INCH IN ONE FOOT FROM THE HORIZONTAL (2.083 % GRADIENT)". (CBC CHAPTER 2)
- 2. GROUND AND FLOOR SURFACES ALONG ACCESSIBLE ROUTES AND IN ACCESSIBLE ROOMS AND SPACES, INCLUDING FLOORS, WALKS, RAMPS, STAIRS, AND CURB RAMPS, SHALL BE STABLE, FIRM, AND SLIP-RESISTANT
- 3. CHANGES IN LEVEL UP TO 1/4" MAY BE VERTICAL AND WITHOUT EDGE TREATMENT.
- 4. CHANGES IN LEVEL BETWEEN 1/4" AND 1/2" SHALL BE BEVELED WITH SLOPE NOT STEEPER THAN 1:2

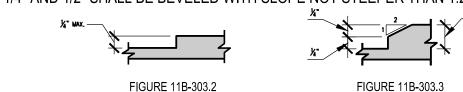

### ENTRANCE AND EXITS:


1. EXIT AS DEFINED IS "A CONTINUOUS AND UNOBSTRUCTED MEANS OF EGRESS TO A PUBLIC WAY AND SHALL INCLUDE INTERVENING AISLES, DOORS, DOORWAYS, GATES, CORRIDORS, EXTERIOR EXIT BALCONIES, RAMPS, STAIRWAYS, SMOKE PROOF ENCLOSURES, HORIZONTAL EXITS, EXIT PASSAGEWAY, EXIT COURTS, AND YARDS".

VERTICAL CHANGE IN LEVEL

2. FOR THE PURPOSES OF TITLE 24, THE USE OF THE TERM "EXIT DOOR" IN SECTION 1008 APPLIES TO ALL DOORS THAT PROVIDE ACCESS, THAT IS, ENTRANCES, PASSAGE DOORS, ETC.

3. ALL ENTRANCES AND ALL EXTERIOR GROUND FLOOR EXIT DOORS TO BUILDING AND FACILITIES SHALL BE

- MADE ACCESSIBLE TO PERSONS WITH DISABILITIES.
- 4. EXIT DOORS SHALL BE OPENABLE FROM THE INSIDE WITHOUT THE USE OF A KEY OR ANY SPECIAL KNOWLEDGE OR EFFORT.
- 5. LATCHING AND LOCKING DOORS THAT ARE HAND ACTIVATED AND WHICH ARE IN A PATH OF TRAVEL SHALL BE OPERABLE WITH A SINGLE EFFORT BY LEVER TYPE HARDWARE, PANIC BARS, PUSH-PULL ACTIVATING BARS, OR OTHER HARDWARE DESIGNED TO PROVIDE PASSAGE WITHOUT REQUIRING THE ABILITY TO GRASP THE OPENING HARDWARE. LOCKED EXIT DOORS SHALL OPERATE AS ABOVE IN EGRESS DIRECTION.
- 6. HAND-ACTIVATED DOOR OPENING HARDWARE SHALL BE CENTERED BETWEEN 30" AND 44" ABOVE THE FLOOR. (CBC 11B-404.2.7)
- 7. EVERY DOORWAY WHICH IS LOCATED WITHIN AN ACCESSIBLE PATH OF TRAVEL SHALL BE OF A SIZE AS TO PERMIT THE INSTALLATION OF A DOOR NOT LESS THAN 3' IN WIDTH AND NOT LESS THAN 6'-8" IN HEIGHT. WHEN INSTALLED, EXIT DOORS SHALL BE CAPABLE OF OPENING SO THAT THE CLEAR WIDTH OF THE EXIT IS NOT LESS THAN 32".
- 8. FOR HINGED DOORS, THE OPENING WIDTH SHALL BE MEASURED WITH THE DOOR POSITIONED AT AN ANGLE OF 90 DEGREES FROM ITS CLOSED POSITION.
- 9. WHERE A PAIR OF DOORS IS UTILIZED, AT LEAST ONE OF THE DOORS SHALL PROVIDE A CLEAR, UNOBSTRUCTED OPENING WIDTH OF 32" WITH THE LEAF POSITIONED AT AN ANGLE OF 90 DEGREES FROM ITS CLOSED POSITION.
- 10. MINIMUM MANEUVERING CLEARANCES AT DOORS SHALL BE AS SHOWN IN FIGURES. THE FLOOR OR GROUND AREA WITHIN THE REQUIRED CLEARANCES SHALL BE LEVEL AND CLEAR.
- 11. THERE SHALL BE A LEVEL AND CLEAR FLOOR OR LANDING ON EACH SIDE OF A DOOR. THE LEVEL AREA SHALL DOOR SWING OF 48" AS MEASURED AT RIGHT ANGLES TO THE PLANE OF THE DOOR IN THE HE
- 12. THE WIDTH OF THE LEVEL AREA ON THE SIDE TO WHICH THE DOOR SWINGS SHALL EXTEND A MINIMUM OF 24" PAST THE STRIKE EDGE OF THE DOOR FOR EXTERIOR DOORS AND A MINIMUM OF 18" PAST THE STRIKE EDGE FOR INTERIOR DOORS.
- 13. THE BOTTOM 10" OF ALL DOORS EXCEPT AUTOMATIC AND SLIDING SHALL HAVE A SMOOTH, UNINTERRUPTED SURFACE TO ALLOW THE DOOR TO BE OPENED BY A WHEELCHAIR FOOTREST WITHOUT CREATING A RAP OR HAZARDOUS CONDITION. WHERE NARROW FRAME DOORS ARE USED, A 10" HIGH SMOOTH PANEL SHALL BE INSTALLED ON THE PUSH SIDE OF THE DOOR, WHICH WILL ALLOW THE DOOR TO BE OPENED BY A WHEEL CHAIR FOOTREST WITHOUT CREATING A TRAP OR HAZARDOUS CONDITION.
- 14. MAXIMUM, EFFORT TO OPERATE DOORS SHALL NOT EXCEED 5 POUNDS FOR EXTERIOR DOORS AND INTERIOR DOORS, SUCH PULL OR PUSH EFFORT BEING APPLIED AT RIGHT ANGLES TO HINGED DOORS AND OF THE CENTER PLANE OF SLIDING OR FOLDING DOORS. COMPENSATING DEVICES OR AUTOMATIC DOOR OPERATORS MAY BE UTILIZED TO MEET THE ABOVE STANDARDS. WHEN FIRE DOORS ARE REQUIRED, THE MAXIMUM EFFORT TO OPERATE THE DOOR MAY BE INCREASED TO THE MAXIMUM ALLOWABLE BY THE APPROPRIATE ADMINISTRATIVE AUTHORITY. NOT TO EXCEED 15 POUNDS. (CBC

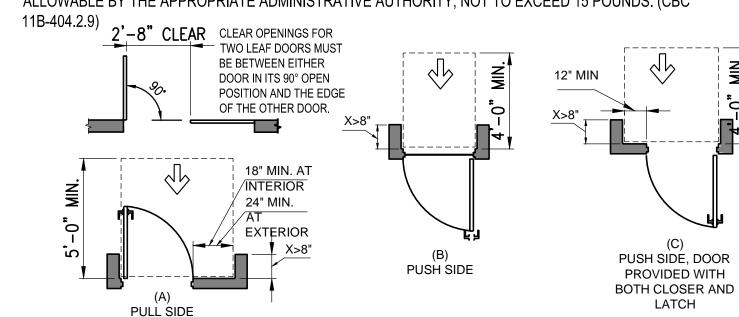

IRA
REALTY CAPITAL

IRA REALTY CAPITAL

1900 Main Street, Suite 375

Irvine, California 92614

JECT NAME


SHOPS at
MAIN STREET Exterior Building
Improvements

511-581 North Main Street Corona, California 92880



1 PETERS CANYON ROAD, SUITE 130 IRVINE, CA. 92606 TEL: 949-387-8500, FAX: 949-387-0800

IDS GROUP

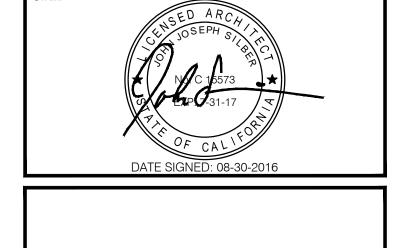

ISSUE

REV. DESCRIPTION DATE

PLAN CHECK SUBMITTAL 05.31.16

PLAN CHECK RE-SUBMITTAL 07.06.16

PLAN CHECK RE-SUBMITTAL 08.31.16

ŒY PLAN

 PROJECT NO.
 15X047.00

 PRINT DATE
 8/30/2016


 DRAWN BY
 MO

ACCESSIBILITY NOTES

SHEET NUMBER

GA1.03

ACCESSIBILITY NOTES NONE 5 SPACE ALLOWANCE NONE

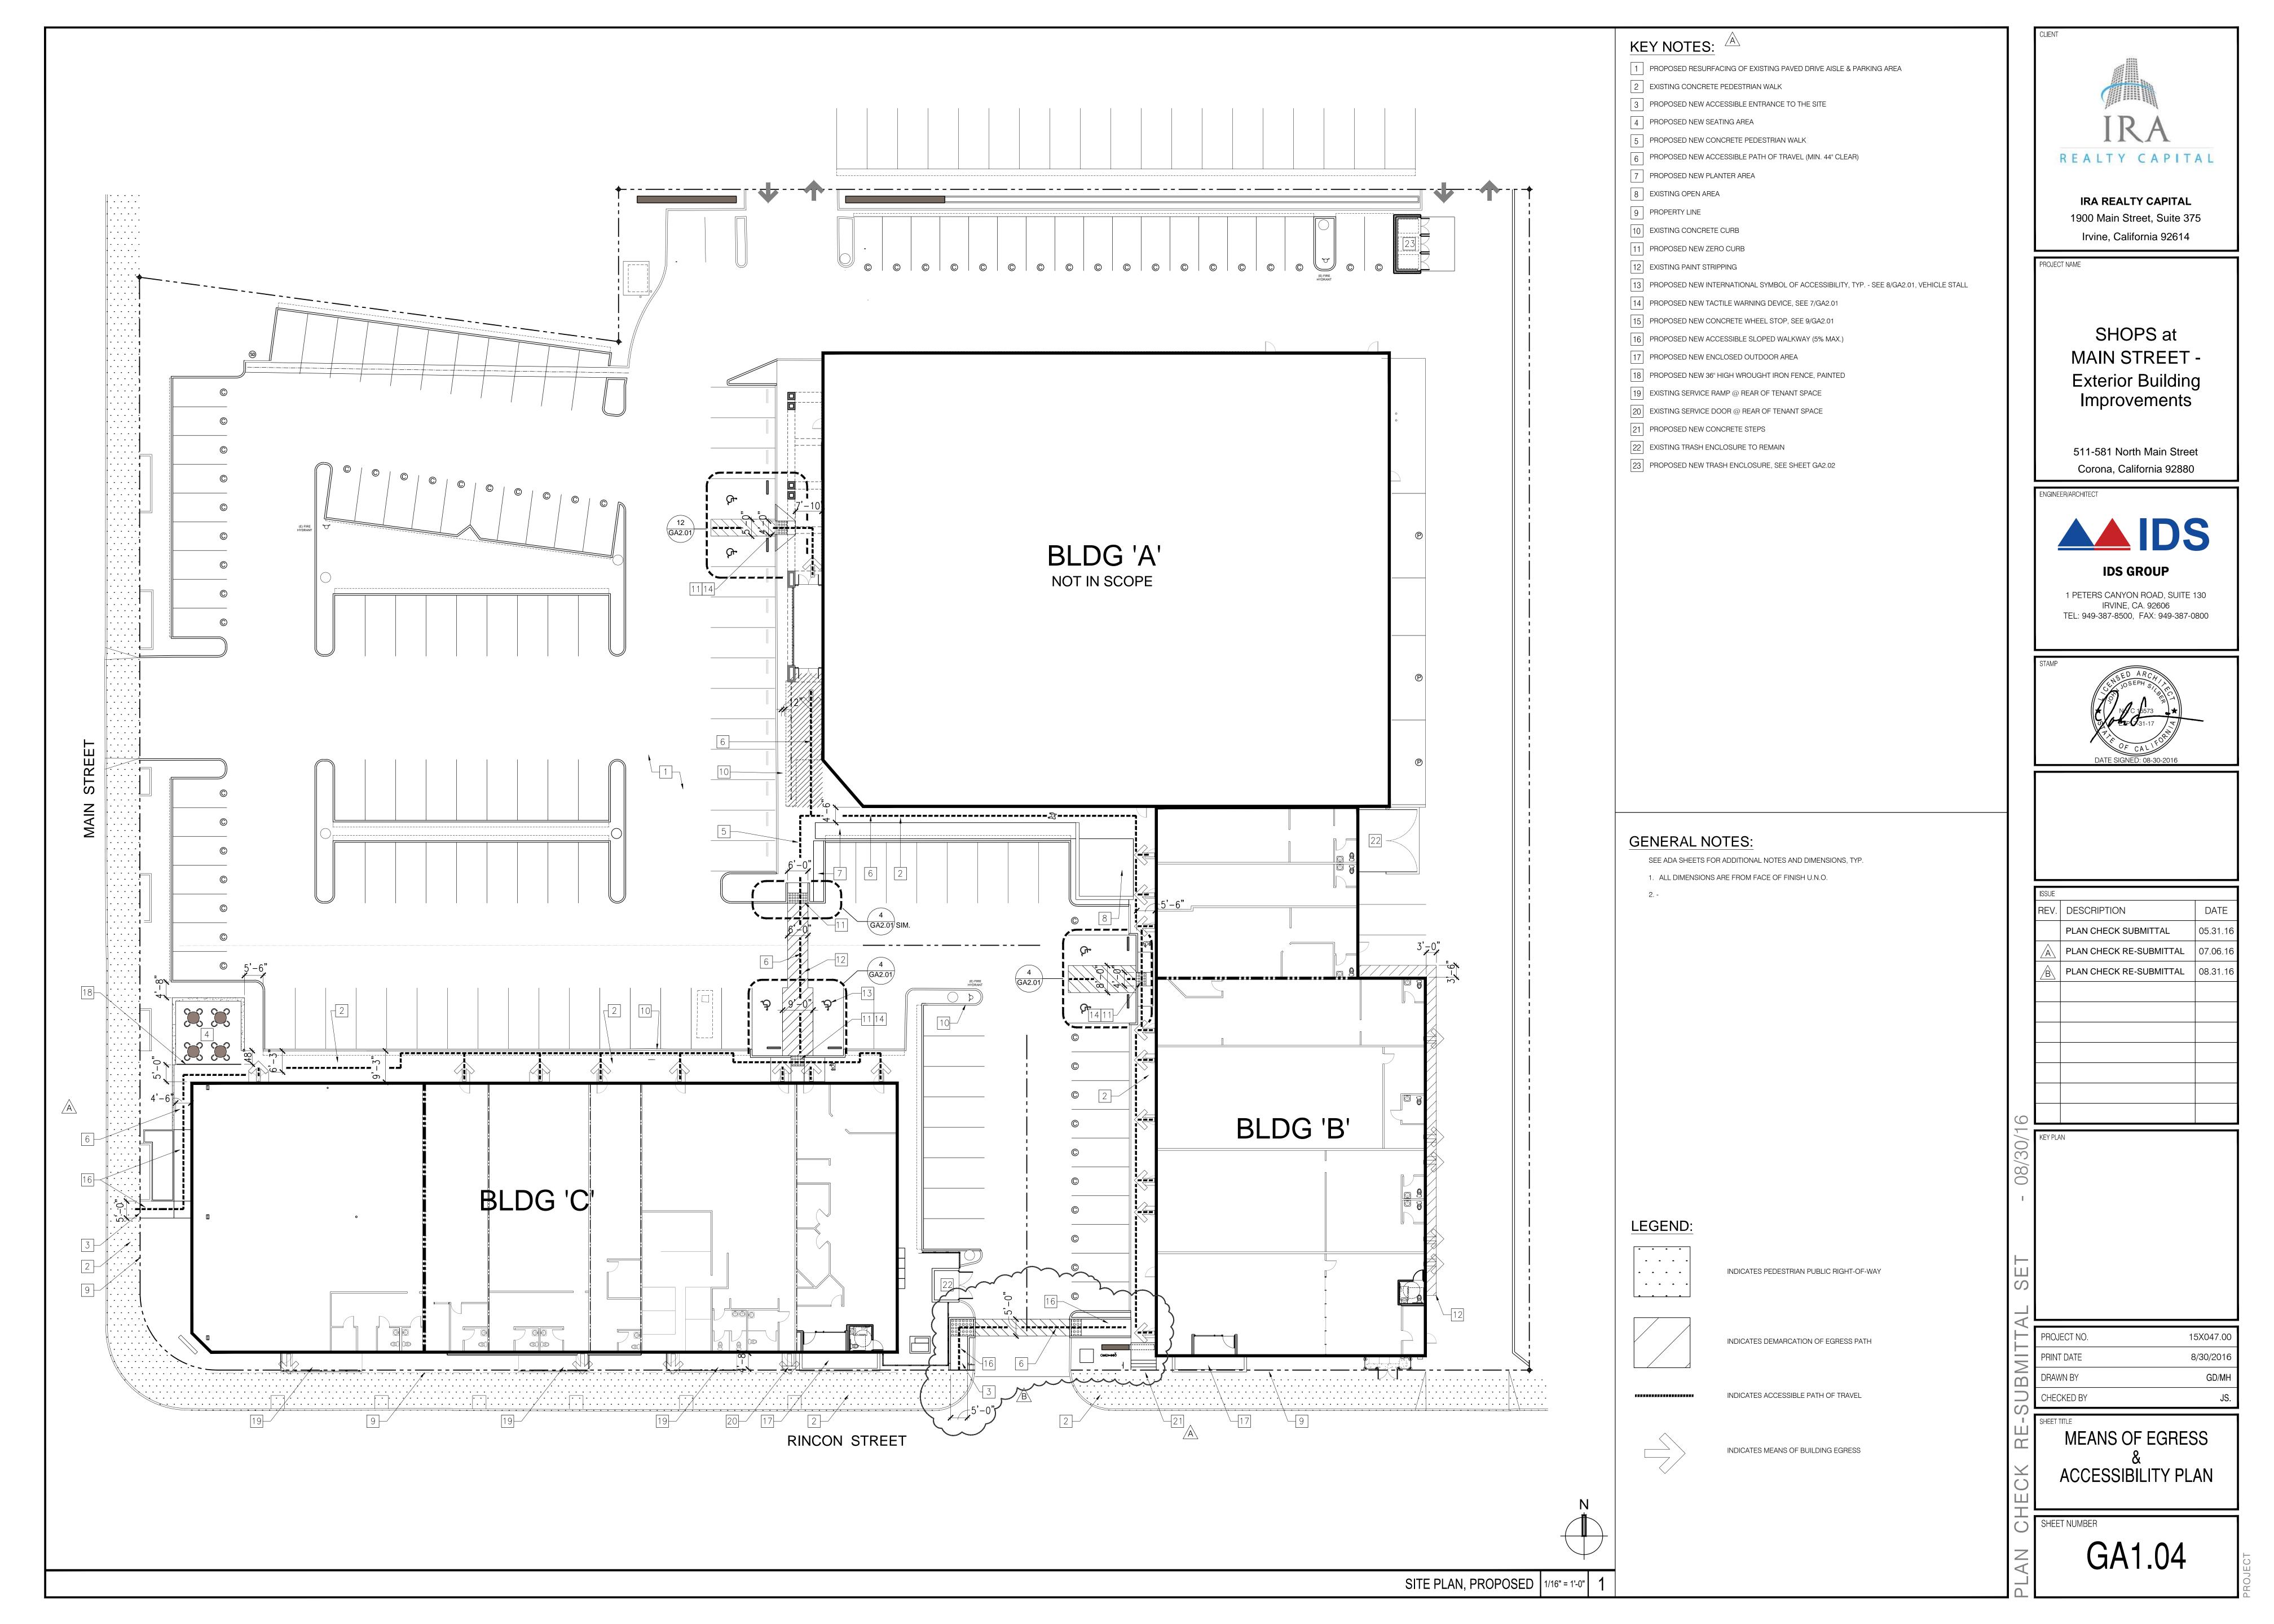

## GENERAL NOTES

### INSTRUMENTS OF SERVICE

- THE SCOPE OF THIS PROJECT IS AS GENERALLY DEPICTED IN THESE INSTRUMENTS OF SERVICE AS PART OF THE CONTRACT DOCUMENTS. WORK INCLUDING: POINTS OF CONNECTION, NOT SPECIFICALLY DEPICTED, THAT NEED TO BE MADE ARE THE RESPONSIBILITY OF THE GENERAL CONTRACTOR. ALL WORK PERFORMED EVEN IN REMOTE AREAS OF THE BUILDING OR SITE. PERTAINING TO THIS PROJECT SHALL COMPLY WITH THE INTENT OF CONTRACT DOCUMENTS.
- THESE CONTRACT DOCUMENTS COVER THE FURNISHING AND INSTALLATION OF MATERIALS AND WORK AS CALLED FOR ON THE DRAWINGS OR IN THE SPECIFICATIONS (OR IN BOTH) WHICH ARE BOUND SEPARATELY AND ARE A PART OF THE CONTRACT. I SHALL BE THE RESPONSIBILITY OF EACH CONTRACTOR TO CHECK WITH THE ARCHITECTURAL DRAWINGS BEFORE FINALIZING THEIR BID AND BEFORE THE INSTALLATION OF THEIR WORK. ANY DISCREPANCY BETWEEN THE ARCHITECTURAL AND THE CONSULTING ENGINEER(S) DRAWINGS SHALL BE BROUGHT TO THE ARCHITECTS ATTENTION BY WRITTEN REQUEST FOR CLARIFICATION. ANY WORK INSTALLED IN CONFLICT WITH THE ARCHITECTURAL DRAWINGS SHALL BE CORRECTED BY THE CONTRACTOR AT HIS OWN EXPENSE AND AT NO EXPENSE TO THE OWNER OR ARCHITECT.
- GENERAL REQUIREMENTS, DESCRIBING THE PROJECT'S ADMINISTRATIVE REQUIREMENTS AND THE PHYSICAL ASPECTS OF CONSTRUCTION, ARE PROVIDED WITHIN EACH PROFESSIONAL DISCIPLINE'S PROJECT SPECIFICATION AND GENERAL NOTATION. GENERAL REQUIREMENTS ARE NOT LIMITED TO THE INSTRUMENT OF SERVICES AND MAY EXTEND TO THE CONTRACT DOCUMENTS AND OWNER REQUIREMENTS.
- THE PROJECT SPECIFICATIONS CONSISTING OF THE WRITTEN REQUIREMENTS FOR MATERIAL, EQUIPMENT, SYSTEMS, STANDARDS AND WORKMANSHIP FOR THE WORK, AND PERFORMANCE OF RELATED SERVICES ARE CONTAINED WITHIN EACH OF THE ARCHITECT AND THE ARCHITECHT'S INSTRUMENT OF SERVICES. REFER TO GENERAL NOTES FOR ADDITIONAL PROJECT STANDARDS INFORMATION. DOCUMENTS INDICATED AS 'REFERENCE DOCUMENT' ARE NOT CONSIDERED INSTRUMENTS OF SERVICES AND ARE BEING ISSUED TO PROVIDE ASSISTANCE DURING THE REGULATORY AGENCY CONTRACT DOCUMENT REVIEW.
- OVERALL AND BUILDING SCOPE DIAGRAMS PROVIDE GUIDLINE TO IDENTIFY THE LIMIT OF SCOPE.
- REFER TO LIFESAFETY AND ACCESSIBILITY DIAGRAMS THAT INDICATE PROVISIONS WITHIN EXISTING CONDITIONS.
- THESE DRAWINGS ARE BASED ON FIELD OBSERVATION AND DOCUMENTS FURNISHED BY THE OWNER. THE ARCHITECT SHALL BE NOTIFIED IMMEDIATELY BY THE CONTRACTOR OF ANY DISCREPANCIES OR OTHER QUESTIONS PERTAINING TO THE CONTRACT DOCUMENTS.. IF OBVIOUS OMISSIONS OR CONTRADICTORY SITUATIONS IN THE CONTRACT DOCUMENTS ARE DISCOVERED TO EXIST, THEY SHOULD BE IMMEDIATELY CALLED TO THE ATTENTION OF ARCHITECT FOR CLARIFICATION.
- ALL DIMENSIONS TAKE PRECEDENCE OVER SCALE UNLESS OTHERWISE NOTED BY A PLUS/MINUS DIMENSION. DETAILED DRAWINGS HAVE PRECEDENCE OVER SMALL SCALE DRAWINGS. CONTRACTOR SHALL CHECK ACCURACY OF DIMENSIONS ON PLANS WITH ACTUAL FIELD DIMENSIONS. THE CONTRACTOR SHALL REPORT TO THE ARCHITECT ALL CONDITIONS WHICH PREVENT THE PROPER EXECUTION OF ITS WORK. CONTRACTOR SHALL NOT START ANY CONSTRUCTION OR ANY OFF-SITE FABRICATION OF MATERIALS UNTIL THE DRAWINGS DIMENSIONS ARE VERIFIED WITH ACTUAL FIELD CONDITIONS. DO NOT SCALE DRAWINGS.
- THE CONTRACTOR SHALL BE HELD RESPONSIBLE FOR THE RESULTS OF ANY ERRORS. DISCREPANCIES OR OMISSIONS THAT THE CONTRACTOR FAILED TO NOTIFY THE ARCHITECT OF BEFORE CONSTRUCTION AND/OR FABRICATION OF THE WORK.
- 10. WORK INCLUDES DEMOLITION, REMOVAL AND REINSTALLATION WHERE REQUIRED. REMOVE, REVISE, RELOCATE AND REINSTALL AS REQUIRED.
- 11. IT IS NOT THE RESPONSIBILITY OF THE ARCHITECT OR GENERAL CONTRACTOR TO INSURE THAT AREAS OF THE BUILDING, NOT DESCRIBED WITHIN THE SCOPE OF THIS PROJECT COMPLY WITH CURRENT BUILDING CODES. IT IS THE RESPONSIBILITY OF THE OWNER TO MAINTAIN THE BUILDING, SO AS TO PROVIDE FOR THE SAFETY AND COMFORT OF THE OCCUPANTS. THIS INCLUDES ALL LIFE SAFETY FEATURES SUCH AS FIRE ALARM, FIRE-SPRINKLERS, NURSE CALL, EXIT ENCLOSURE, HANDICAP ACCESSIBILITY, ETC.. THIS ALSO INCLUDES MAINTAINING THE BUILDING FREE OF HAZARDOUS MATERIALS I.E., CHEMICALS AS DESCRIBED BY STATE OR FEDERAL AGENCIES AS "HAZARDOUS", INCLUDING ASBESTOS.

### RETAINING FACILITY OPERATIONS DURING WORK

- IT SHALL BE UNDERSTOOD THAT THE FACILITY OUTSIDE THE RENOVATION AREA SHALL CONTINUE NORMAL OPERATIONS THROUGHOUT THE RENOVATION PERIOD. IT SHALL BE THE CONTRACTORS RESPONSIBILITY TO PLAN, COORDINATE, AND INSTALL ITS WORK SO AS TO ASSURE THE FACILITY WILL RUN NORMALLY. THE CONTRACTOR SHALL ALSO ASSURE THAT THE FACILITY LIFE SAFETY, MECHANICAL, AND ELECTRICAL SYSTEMS ARE NOT TO BE DISTURBED OR INTERRUPTED IN ANY WAY. THE CONTRACTOR SHALL BE HELD LIABLE FOR ANY SUCH INTERRUPTIONS OR DISTURBANCES.
- IT SHALL BE UNDERSTOOD THAT THE PRESENT TENANTS (OUTSIDE THE CONSTRUCTION LIMITS) SHALL REMAIN IN NORMAL OPERATION THROUGHOUT THE CONSTRUCTION AND RENOVATION PERIOD. IT SHALL BE THE CONTRACTOR'S RESPONSIBILITY TO PLAN, COORDINATE AND INSTALL HIS WORK SO AS TO ASSURE THAT THE PRESENT HOSPITAL'S NORMAL OPERATIONS AND ITS MECHANICAL/ELECTRICAL SYSTEMS AND UTILITIES ARE NOT DISTURBED OR INTERRUPTED IN ANY WAY. THE CONTRACTOR SHALL BE HELD LIABLE FOR ANY SUCH INTERRUPTION OR DISTURBANCE.
- THE CONTRACTOR SHALL AT NO TIME DO ANY WORK OR PLACE ANY OBSTRUCTION THAT MAY AFFECT THE OPERATIONS OF THE OTHER TENANTS, INCLUDING ANY INTERRUPTIONS IN THE SUPPLY OF POWER OR OTHER UTILITIES. WITHOUT FIRST NOTIFYING AND OBTAINING PERMISSION FROM THE BUILDING OWNER TO PROCEED. THE CONTRACTOR SHALL SCHEDULE ANY WORK THAT MAY AFFECT THE OPERATIONS OF THE OTHER TENANTS TO OCCUR DURING THOSE HOURS WHEN THE EFFECT IS LEAST, INCLUDING EVENINGS AND WEEKENDS.

### CONTRACTOR OBLIGATIONS

- CONTRACTOR FOR THE PROJECT SHALL BE RESPONSIBLE FOR OBTAINING ALL REQUIRED BUILDING PERMITS PRIOR TO COMMENCING WORK.
- 2. THE CONTRACTOR SHALL INSURE THAT ALL WORK IS DONE IN A PROFESSIONAL WORK-MAN-LIKE MANNER BY SKILLED MECHANICS AND SHALL REPLACE ANY NEW AND/OR EXISTING MATERIALS OR ITEMS INDICATED TO REMAIN DAMAGED BY ANY CAUSE DURING CONSTRUCTION.
- THE CONTRACTOR AND/OR SUBCONTRACTOR SHALL, PRIOR TO THE SUBMISSION OF HIS BID OR PERFORMANCE OF WORK, NOTIFY THE OWNER OF ANY WORK CALLED OUT ON THE DRAWINGS OR IN THE SPECIFICATIONS IN HIS TRADE THAT CANNOT BE FULLY GUARANTEED OR WARRANTED FROM DEFECTIVE WORKMANSHIP OR MATERIAL
- 4. THE CONTRACTOR SHALL NOTIFY THE ARCHITECT IF DETAILS ARE CONSIDERED UNSOUND, UNSAFE, NOT WATERPROOF, OR NOT WITHIN CUSTOMARY TRADE PRACTICE. IF WORK IS PERFORMED, IT WILL BE ASSUMED THAT THERE IS NO OBJECTIONS TO THE DETAIL. DETAILS ARE INTENDED TO SHOW END RESULT OF DESIGN. MINOR MODIFICATIONS MAY BE REQUIRED TO SUIT JOB CONDITIONS AND CURRENT TRADE PRACTICE AND SHALL BE INCLUDED AS PART OF THIS PROJECT.
- CONTRACTOR SHALL BE RESPONSIBLE FOR ALL FINISHES AT POINT OF CONNECTIONS FOR ALL WORK (ARCHITECTURAL, STRUCTURAL, MECHANICAL AND ELECTRICAL) FINISHES WILL MATCH THOSE SPECIFIED OR EXISTING IN LINE, TEXTURE AND FINISH. SPOT PAINTING IS NOT ACCEPTABLE. NEW FINISHES SHALL BE FROM CORNER TO CORNER, FLOOR TO CEILING, ETC.
- 6. UNLESS OTHERWISE NOTED, ALL MATERIALS SHALL BE NEW AND OF GOOD QUALITY, WHERE EXISTING MATERIALS ARE INDICATED TO BE SALVAGED, CONTRACTOR SHALL INVENTORY, CLEAN, BOX PROTECT, AND STORE ITEMS FOR REUSE ON THE PROJECT. ITEMS NOT REUSED SHALL BE RETURNED TO OWNER.
- 7. COORDINATION: THE GENERAL AND EACH SUB CONTRACTOR SHALL BE RESPONSIBLE FOR VERIFICATION AND COORDINATION WITH OTHER SUB CONTRACTORS TO ASSURE COMPLIANCE WITH DRAWINGS AND SPECIFICATIONS, AND THE ACCURATE LOCATION OF ARCHITECTURAL, STRUCTURAL, MECHANICAL AND ELECTRICAL BUILDING ELEMENTS. THEIR REQUIRED OPENINGS CLEARANCES SUPPORT SYSTEMS ARE ALL INTERCONNECTED AND COORDINATED.
- 8. CONTRACTOR SHALL BE RESPONSIBLE FOR COORDINATING THE WORK OF ALL TRADES AND FOR BEING AWARE OF ALL CONDITIONS THAT AFFECT THEIR WORK.NOTIFY OWNER, IN WRITING, WITHIN 3 WORKING DAYS OF AWARD OF CONTRACT, OF THE PROPOSED DELIVERY SCHEDULE, OF ANY EQUIPMENT, FINISHES OR MATERIAL, FOR WHICH THAT SCHEDULE WILL PREVENT THE INSTALLATION FROM BEING COMPLETED AT THE TIME OF THE SCHEDULED PROJECT COMPLETION.
- COORDINATION OF WORK:
- THE CONTRACTORS SHALL PROVIDE AND COORDINATE THE EXACT DIMENSIONS SIZES AND POSITIONS OF ALL SYSTEMS, EQUIPMENT, MOUNTING, AND ATTACHMENTS RELATING TO THE WORK.
- THE CONTRACTOR SHALL PROVIDE AND COORDINATE ALL DIMENSIONS SIZES AND POSITIONS OF OPENINGS IN SLABS AND WALLS NECESSARY TO THE INSTALLATION OF THE WORK.
- ALL EQUIPMENT, CONTROLS AND TERMINATIONS SHALL BE POSITIONS FOR SAFE, DIRECT AND FASY ACCESS.
- 10. THE CONTRACTOR SHALL VERIFY ALL DIMENSIONS AND CONDITIONS OF EXISTING SITE. THE CONTRACTOR SHALL REPORT TO THE ARCHITECT ALL CONDITIONS WHICH PREVENT THE PROPER EXECUTION OF ITS WORK. THE DRAWINGS SHALL NOT BE SCALED.
- 11. CONSTRUCTION SHALL COMPLY WITH APPLICABLE EDITION OF CALIFORNIA BUILDING CODE, ALL APPLICABLE LOCAL, STATE AND FEDERAL CODES, ORDINANCES, LAWS, REGULATIONS AND PROTECTIVE COVENANTS GOVERNING THE WORK. IN CASE OF CONFLICTS, THE MORE STRINGENT REQUIREMENT SHALL GOVERN.
- 12. GENERAL CONTRACTOR TO ARRANGE INSPECTIONS AS NECESSARY.
- 13. ALL CONTRACTOR'S WORK SHALL BE OF THE QUALITY TO PASS INSPECTIONS BY LOCAL AND STATE AUTHORITIES, LENDING INSTITUTIONS, THE ARCHITECT AND HIS ENGINEERS. INSPECTOR OF RECORD, AND OWNER. ANY ONE OR ALL OF THE ABOVE MENTIONED INSPECTORS MAY INSPECT TRADE(S) AT ANY TIME. AND ANY CORRECTIONS NEEDED TO MEET THE REQUIRED QUALITY OF CONSTRUCTION SHALL BE DONE IMMEDIATELY AFTER NOTIFYING THE ARCHITECT AND THE OWNER FOR APPROVAL.
- 14. THE CONTRACTOR/SUB CONTRACTORS SHALL INSPECT THE SITE PRIOR TO START OF CONSTRUCTION AND NOTIFY OWNER AND THE ARCHITECT OF ANY EXISTING CONDITIONS THAT MAY AFFECT THE WORK INCLUDING ELEMENTS THAT MAY BE SUBJECT TO DAMAGE DURING DEMOLITION AND RENOVATION. THE CONTRACTOR SHALL FIELD VERIFY EXISTING DIMENSIONS, PRIOR TO START OF CONSTRUCTION AND NOTIFY OWNER AND ARCHITECT OF ANY DISCREPANCIES BETWEEN THE EXISTING DIMENSIONS AND THE DRAWING DIMENSIONS THAT MAY AFFECT THE WORK. THE CONTRACTOR SHALL OBTAIN DIRECTION FROM OWNER ON RESOLUTION OF THE DISCREPANCIES BETWEEN THE EXISTING CONDITIONS AND DIMENSIONS AND DRAWINGS PRIOR TO STARTING ANY WORK THAT MAY BE AFFECTED BY SUCH DISCREPANCIES.
- 15. CLEANUP: TYPICALLY EACH SUBCONTRACTOR IS HELD RESPONSIBLE FOR CLEANUP OF THE WORK OF HIS TRADE BY THE GENERAL CONTRACTOR. HOWEVER, THE GENERAL CONTRACTOR SHALL BE HELD SOLELY RESPONSIBLE FOR CONTINUOUS CLEANUP AS THE JOB PROGRESSES, AND FINAL CLEANUP UPON SUBSTANTIAL COMPLETION. THE CONTRACTOR SHALL BE RESPONSIBLE FOR CLEANING UP AND REMOVING FROM THE JOB SITE ALL TRASH AND DEBRIS. IMMEDIATELY UPON COMPLETION OF HIS DAILY WORK. CONTINUOUS CLEANUP SHALL KEEP THE JOB FREE AT ALL TIMES FROM UNREASONABLE BUILDUP OF DEBRIS, WRAPPERS, CONTAINERS, WASTE MATERIALS, ETC., WHICH MAY CAUSE ACCIDENTS, UNDUE HARDSHIP ON THE TRADESMAN, AND WORK PROGRESS. FINAL CLEANUP INCLUDES CLEANING OF ALL SURFACES TO A "LIKE NEW" CONDITION AND PREPARING THE BUILDING FOR ITS INTENDED USE.
- 16. THE CONTRACTOR SHALL AT ALL TIMES MAINTAIN THE SITE AND ADJACENT AREAS IN A CLEAN, NEAT, AND ORDERLY MANNER. THE CONTRACTOR SHALL BE RESPONSIBLE ONLY FOR DEBRIS THAT IS A RESULT OF THE WORK, INCLUDING ANY THAT MAY RESULT FROM THE WORKERS. THE CONTRACTOR SHALL BE RESPONSIBLE FOR PROVIDING HIS OWN REFUSE CONTAINERS AND SHALL AT NO TIME USE THE BUILDING REFUSE CONTAINERS.
- 17. THE CONTRACTOR SHALL BE RESPONSIBLE FOR THE COMPLETE SECURITY OF THE SITE WHILE THE JOB IS IN PROGRESS AND UNTIL THE JOB IS COMPLETED.
- 18. CONTRACTOR SHALL PROVIDE A PORTABLE FIRE EXTINGUISHER WITH A RATING OF NOT LESS THAN 2-A OR 2-10BC WITHIN 75 FEET OF TRAVEL DISTANCE TO ALL PORTIONS OF THE BUILD OUT AREA DURING CONSTRUCTION.
- 19. OBTAIN CAL / OSHA CONSTRUCTION PERMITS PRIOR TO OBTAINING THE BUILDING PERMIT IF NECESSARY AND IN ACCORDANCE BY CCR TITLE 8, SECTION 341
- DEMARCATE AND NOTIFY THE REGIONAL NOTIFICATION CENTER (DIG ALERT, 811) AT LEAST TWO WORKING DAYS PRIOR TO MAKING ANY EXCAVATIONS.

### REMOVAL OF ASBESTOS NOTES

1. ASBESTOS ABATEMENT IS NOT A SCOPE OF THESE IMPROVEMENT DOCUMENTS.

### FIELD APPLICATION OF PEDESTRIAN PROTECTION

CONSTRUCTION ACTIVITIES INCLUDING ADDITIONS. ALTERATIONS. AND DEMOLITIONS SHALL PROVIDE PEDESTRIAN PROTECTION PURSUANT TO SECTION 3306 OF THE CALIFORNIA BUILDING CODE. TO DETERMINE THE TYPE OF PROTECTION REQUIRED FOR PEDESTRIANS MEASURE THE ULTIMATE HEIGHT OF CONSTRUCTION WITH CONSIDERATION FOR BUILDING SETBACKS AND PROJECTIONS FROM THE BUILDING, FOR SLOPING SITES, MEASURE THE HEIGHT OF THE BUILDING FROM CONSTRUCTION EDGE OF THE WALKWAY AND THE SETBACK DISTANCE BETWEEN THE WALKWAY AND THE BUILDING LINE.

### BELOW ARE REQUIREMENTS TO BE ADDRESSED IN THE DESIGN OF PEDESTRIAN PROTECTIONS:

- WALKWAYS SHALL PROVIDE SUFFICIENT WIDTH WITH THE MINIMUM OF 4 FT. CLEAR.
- DIRECTIONAL BARRICADES SHELL BE PROVIDED AS NEEDED WHERE THE WALKWAY EXTENDS INTO THE STREET.
- CONSTRUCTION RAILINGS SHALL BE AT LEAST 42 INCHES IN HEIGHT.
- BARRIERS SHALL BE A MINIMUM OF 8 FT. IN HEIGHT AND BE DESIGNED TO RESIST LOADS REQUIRED.
- SUCH PROTECTION SHALL BE MAINTAINED IN PLACE AND KEPT IN GOOD ORDER. UNTIL WORK IS COMPLETED.
- WHENEVER A WALKWAY MUST EXTEND INTO THE ROADWAY, A RAILING IS REQUIRED ON THE STREET SIDE.

### PROTECTION OF WORK

- THE CONTRACTOR SHALL BE RESPONSIBLE TO PROVIDE BARRICADES, PROTECTIVE COVERINGS, WARNING SIGNS, ETC., TO PREVENT ANY HARM TO WORKERS, EMPLOYEES AND/OR THE GENERAL PUBLIC. THE CONTRACTOR SHALL PROVIDE TEMPORARY CONSTRUCTION BARRIERS TO SEPARATE CONSTRUCTION FROM THE GENERAL PUBLIC, TEMPORARY BARRIERS SHALL MEET THE SAME FIRE RATING AS WOULD THE PERMANENT PARTITION. WHERE A TEMPORARY PARTITION IS PLACED ACROSS A CORRIDOR OR IN ANY WAY BLOCKS AN EXIT OR CREATES A DEAD END, CONTRACTOR SHALL PROVIDE PLANS SHOWING THESE CONDITIONS AND SHALL OBTAIN APPROVAL BY [THE O.S.H.P.D. AND/OR THE FIRE DEPARTMENT] AUTHORITIES RESPONSIBLE ON THIS PROJECTS. WHERE A TEMPORARY PARTITION IS PLACED WITHIN A CORRIDOR AND STILL ALLOWS A PATH OF TRAVEL. THE TEMPORARY PARTITION SHALL BE MIN. 1 HR. CONSTRUCTION AND SHALL ENCLOSE EXTENT OF DEMOLISHED AREA. THE CONTRACTOR SHALL MAINTAIN A 6'-0" MINIMUM CLEAR WIDTH WITHIN THE CORRIDOR. THE USE OF VISQUEEN OR SIMILAR TYPE OF MATERIAL AS A TEMPORARY BARRIER WHERE A FIRE SEPARATION IS REQUIRED SHALL NOT BE PERMITTED.
- PROTECTION OF EXISTING FINISHES: DURING CONSTRUCTION CONTRACTOR SHALL PROTECT ALL EXISTING CONSTRUCTION AND FINISHES (NOT SCHEDULED FOR DEMOLITION). CONTRACTOR SHALL PROVIDE PROTECTIVE COVERING FOR FLOOR, WALL AND CEILING SURFACES IN CORRIDORS AND AREAS ADJACENT TO THE CONSTRUCTION AREA. WHERE DAMAGE OCCURS, REPAIR OR REPLACE LIKE NEW TO THE OWNER'S APPROVAL AT NO ADDITIONAL COST.

### **CUTTING AND PATCHING**

- THE CONTRACTOR SHALL IN THE WORK OF ALL TRADES. PERFORM ALL CUTTING. PATCHING, REPAIRING, RESTORING AND THE LIKE NECESSARY TO COMPLETE THE WORK AND TO RESTORE ANY DAMAGED OR AFFECTED SURFACES RESULTING FROM THE WORK OF THIS CONTRACT TO THEIR ORIGINAL CONDITION TO THE SATISFACTION OF THE OWNERS AND THE ARCHITECT.
- CONTRACTOR SHALL BE RESPONSIBLE FOR ALL CUTTING. FITTING. PATCHING. AND FIRE SAFING METHODS REQUIRED TO COMPLETE THE WORK INCLUDING BUT NOT LIMITED TO THE FOLLOWING:
- A. UNCOVERED PORTIONS OF THE WORK USED TO PROVIDE FOR INSTALLATION OF
- UNSCHEDULED WORK. B. REMOVE AND REPLACE DEFECTIVE WORK.
- C. REMOVE AND REPLACE WORK NOT CONFORMING TO REQUIREMENTS OF CONTRACT DOCUMENTS.
- D. PROVIDE ROUTINE PENETRATIONS OF NON-STRUCTURAL SURFACES FOR
- INSTALLATION OF PIPING AND ELECTRICAL CONDUIT. E. REMOVE EXISTING WORK INDICATED IN THE DOCUMENTS AND AS MAY BE REQUIRED TO PERMIT THE PROPER INSTALLATION OF NEW WORK THAT FORMS PART OF HIS
- CONTRACT. ALL CUTTING, REPAIRING AND/OR PATCHING NECESSARY IN CONNECTION WITH SUCH REMOVALS SHALL BE DONE WITHOUT EXTRA CHARGE, WHETHER OR NOT EVERY ITEM MAY BE SPECIFICALLY DESCRIBED.
- PROCEDURES FOR NON-STRUCTURAL CUTTING AND PATCHING:
- A. PROVIDE ADEQUATE TEMPORARY SUPPORT AS NECESSARY TO ASSURE THE STRUCTURAL VALUE INTEGRITY OF THE AFFECTED PORTION OF THE WORK.
- B. PROVIDE DEVICES AND METHODS TO PROTECT OTHER PORTIONS OF THE PROJECT FROM DAMAGE.
- C. PROVIDE PROTECTION FROM THE ELEMENTS FOR THAT PORTION OF THE PROJECT
- WHICH MAY BE EXPOSED BY CUTTING AND PATCHING WORK.
- D. EXECUTE CUTTING BY METHODS WHICH WILL PREVENT DAMAGE TO OTHER WORK, AND WILL PROVIDE PROPER SURFACES TO RECEIVE INSTALLATION OR REPAIRS. E. EXECUTE FITTING AND ADJUSTMENT OF PRODUCTS TO PROVIDE A FINISHED INSTALLATION TO COMPLY WITH SPECIFIED PRODUCTS, FUNCTIONS, TOLERANCES
- AND FINISHES, AND MANUFACTURER'S CRITERIA. RESTORE WORK WHICH HAS BEEN CUT OR REMOVED. INSTALL NEW PRODUCTS TO PROVIDE COMPLETE WORK IN ACCORDANCE WITH REQUIREMENTS OF CONTRACT
- DOCUMENTS. G. REFINISH ENTIRE SURFACE AS NECESSARY TO PROVIDE AN EVEN FINISH TO MATCH ADJACENT FINISHES.
- WHERE NEW WORK TIES INTO EXISTING CONTRACTOR SHALL PATCH AND REPAIR EXISTING CONSTRUCTION AS REQUIRED TO RESTORE IT TO ITS ORIGINAL FINISH. TIE THE NEW WORK INTO EXISTING IN A NEAT AND CRAFTSMAN LIKE MANNER SO THAT NEW BLENDS WITH A SMOOTH AND LEVEL SURFACE INTO ADJACENT WORK.

### **DEMOLITION**

- CONTRACTOR SHALL PROVIDE A "DISCOVERY PROCESS" TO IDENTIFY POTENTIAL COMPLICATIONS WITHIN THE SCOPE OF WORK, PRIOR TO ANY DEMOLITION.
- INTEGRITY OF EXISTING CONCRETE FLOOR (ABOVE AND BELOW) SHALL REMAIN INTACT
- CONTRACTOR SHALL VERIFY ALL EXISTING CONDITIONS ESPECIALLY PIPES, DUCTS.
- 1. ALL DEMOLITION WORK SHALL BE IN ACCORDANCE WITH CHAPTER 33 OF THE
- CALIFORNIA BUILDING CODE, 2013 EDITION.
- 5. ALL DEMOLITION WORK SHALL BE IN ACCORDANCE WITH THE CALIFORNIA FIRE CODE, 2013 EDITION, SECTION 103.3.3 (INCLUDING ARTICLE 87).
- 6. THE CONTRACTOR SHALL FIELD SURVEY / AND VERIFY EXISTING CONDITIONS PRIOR TO STARTING ANY WORK.
- DURING THE DEMOLITION, THE CONTRACTOR SHOULD ALWAYS BE AWARE OF THE INTENDED FINAL RENOVATION CONDITIONS OF THE STRUCTURE AND THE REASON THE DEMOLITION WORK IS BEING DONE.
- . THE CONTRACTOR MUST ALLOW FOR ADDITIONAL DEMOLITION THAT MAY NOT BE SHOWN, BUT IS REQUIRED TO ACHIEVE THE FINISHED RESULT, AS SHOWN ON THE DRAWING.
- ). DO NOT DISTURB OR DAMAGE IN ANY WAY EXISTING STRUCTURAL ELEMENTS. THE BUILDING HAS TO COMPLY WITH ALL SAFETY REGULATIONS AT ALL TIMES.
- 10. THE CONTRACTOR SHALL RESTORE TO ITS ORIGINAL CONDITION ANY EXISTING WORK DAMAGED DURING DEMOLITION BUT INDICATED TO REMAIN.

### MECHANICAL DEMOLITION NOTES:

- BEFORE STARTING DEMOLITION, PROVIDE NECESSARY PROTECTIVE DEVICES WHERE REQUIRED AND IN STRICT ACCORDANCE WITH CAL, BUILDING CODE REGULATIONS.
- 2. ALL EQUIPMENT THAT IS REMOVED AND NOT REUSED SHALL BE RETURNED TO THE OWNER.
- TAKE NECESSARY PRECAUTIONS TO PREVENT DUST AND DIRT MIGRATING TO OCCUPIED AREAS OF THE BUILDING. THIS INCLUDES PROVIDING CONSTRUCTION FILTERS AT OPEN/RESTRICTED SUPPLY OR EXHAUST AIR GRILLES/DUCTS IN THE AREA.
- REMOVE THERMOSTATS, CONTROL WIRE, CONDUIT, SUPPLY/RETURN PIPING, ETC. THAT ARE NO LONGER NEEDED WITHIN THE DEMO AREA.
- 5. PROVIDE TEMPORARY CONTROL AND/OR PIPING IF REQUIRED TO MAINTAIN THE SYSTEM FUNCTION OUTSIDE THE DEMO AREA.

### PLUMBING DEMOLITION NOTES:

- REMOVE & EXPOSE OF ALL PLUMBING FIXTURES, TRIM, PIPING BRACKETS, AND HANGERS IN THEIR ENTIRETY AND IN ACCORDANCE WITH ALL APPLICABLE CODES AND REGULATIONS. WASTE PIPING SHALL BE REMOVED TO POINT OF PENETRATION OF THE FLOOR SLAB - PROVIDE A CLOSURE AND SEAL THE PIPE AT THAT POINT. ALL WASTE/SOIL PIPES SHALL BE CAPPED GAS TIGHT.
- REMOVE EXISTING INTERIOR WATER PIPING AND APPURTENANCES COMPLETE. CUT AND CAP INSIDE WALL AND/OR ENTRY INTO DEMO / REMODEL SPACE.
- REMOVE VENT PIPING COMPLETELY. CLOSE AND SEAL BELOW CEILING SLAB, UNLESS NEEDED TO MAINTAIN PROPER VENTING FROM BASEMENT SEWAGE PIPING.

### **ELECTRICAL DEMOLITION NOTES:**

- 9. PRIOR TO DEMOLITION OF ANY CONDUIT, CIRCUIT, EQUIPMENT, ETC., IDENTIFY IN THE FIELD THE LOAD SERVED TO VERIFY THAT REMOVAL WILL NOT INTERFERE WITH EXISTING OPERATIONS. WHERE IT IS DETERMINED THAT AN IMPACT WILL OCCUR, NOTIFY THE FACILITY ENGINEER.
- 10. EXISTING ELECTRICAL OUTLETS LOCATED ON PARTITIONS TO BE DEMOLISHED ARE TO BE REMOVED, INCLUDING ALL CONDUIT AND WIRING BACK TO THEIR RESPECTIVE ELECTRICAL PANELS. PATCH AND REPAIR (AS REQUIRED) IN FIRE-RATED ASSEMBLIES
- 11. REMOVE ALL CABLE IN CEILING BACK TO SOURCE OF DATA COMMUNICATION CLOSETS, AS REQUIRED.
- 12. WHERE IT IS IMPOSSIBLE TO REMOVE CONDUITS (SUCH AS BELOW OR EMBEDDED IN CONCRETE SLABS OR CONCEALED IN ACCESSIBLE LOCATION), REMOVE CONDUCTORS, CUT, CAP AND ABANDON CONDUIT AT ENTRY INTO INACCESSIBLE LOCATIONS.
- 13. ALL CONDUIT AND CONDUCTORS THAT ARE REMOVED UNDER DEMOLITION WORK SHALL NOT BE REUSED.
- 14. ALL ELECTRICAL OUTAGES TO OTHER EXISTING SPACES OR EQUIPMENT NECESSARY TO COMPLETE THE WORK UNDER THIS PROJECT SHALL BE SCHEDULED IN WRITING (IN ADVANCE) WITH THE OWNER'S REPRESENTATIVE.




IRA REALTY CAPITAL 1900 Main Street, Suite 375 Irvine, California 92614

PROJECT NAME


SHOPS at MAIN STREET -**Exterior Building Improvements** 

511-581 North Main Street Corona, California 92880

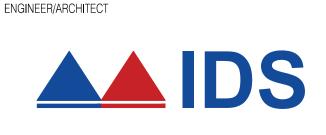

**IDS GROUP** 

1 PETERS CANYON ROAD, SUITE 130 IRVINE, CA. 92606 TEL: 949-387-8500. FAX: 949-387-0800

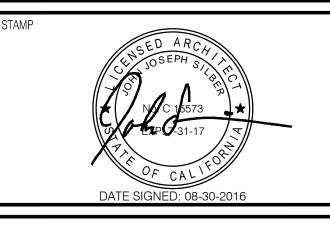

BEV DESCRIPTION

	• .	BEGGI   11014	D, (1 L
		PLAN CHECK SUBMITTAL	05.31.16
	Â	PLAN CHECK RE-SUBMITTAL	07.06.16
		PLAN CHECK RE-SUBMITTAL	08.31.16
$\bigcirc$			
)			


PROJECT NO. 15X047.00 8/30/20 CHECKED BY


GENERAL NOTES


SHEET NUMBER


G1.05




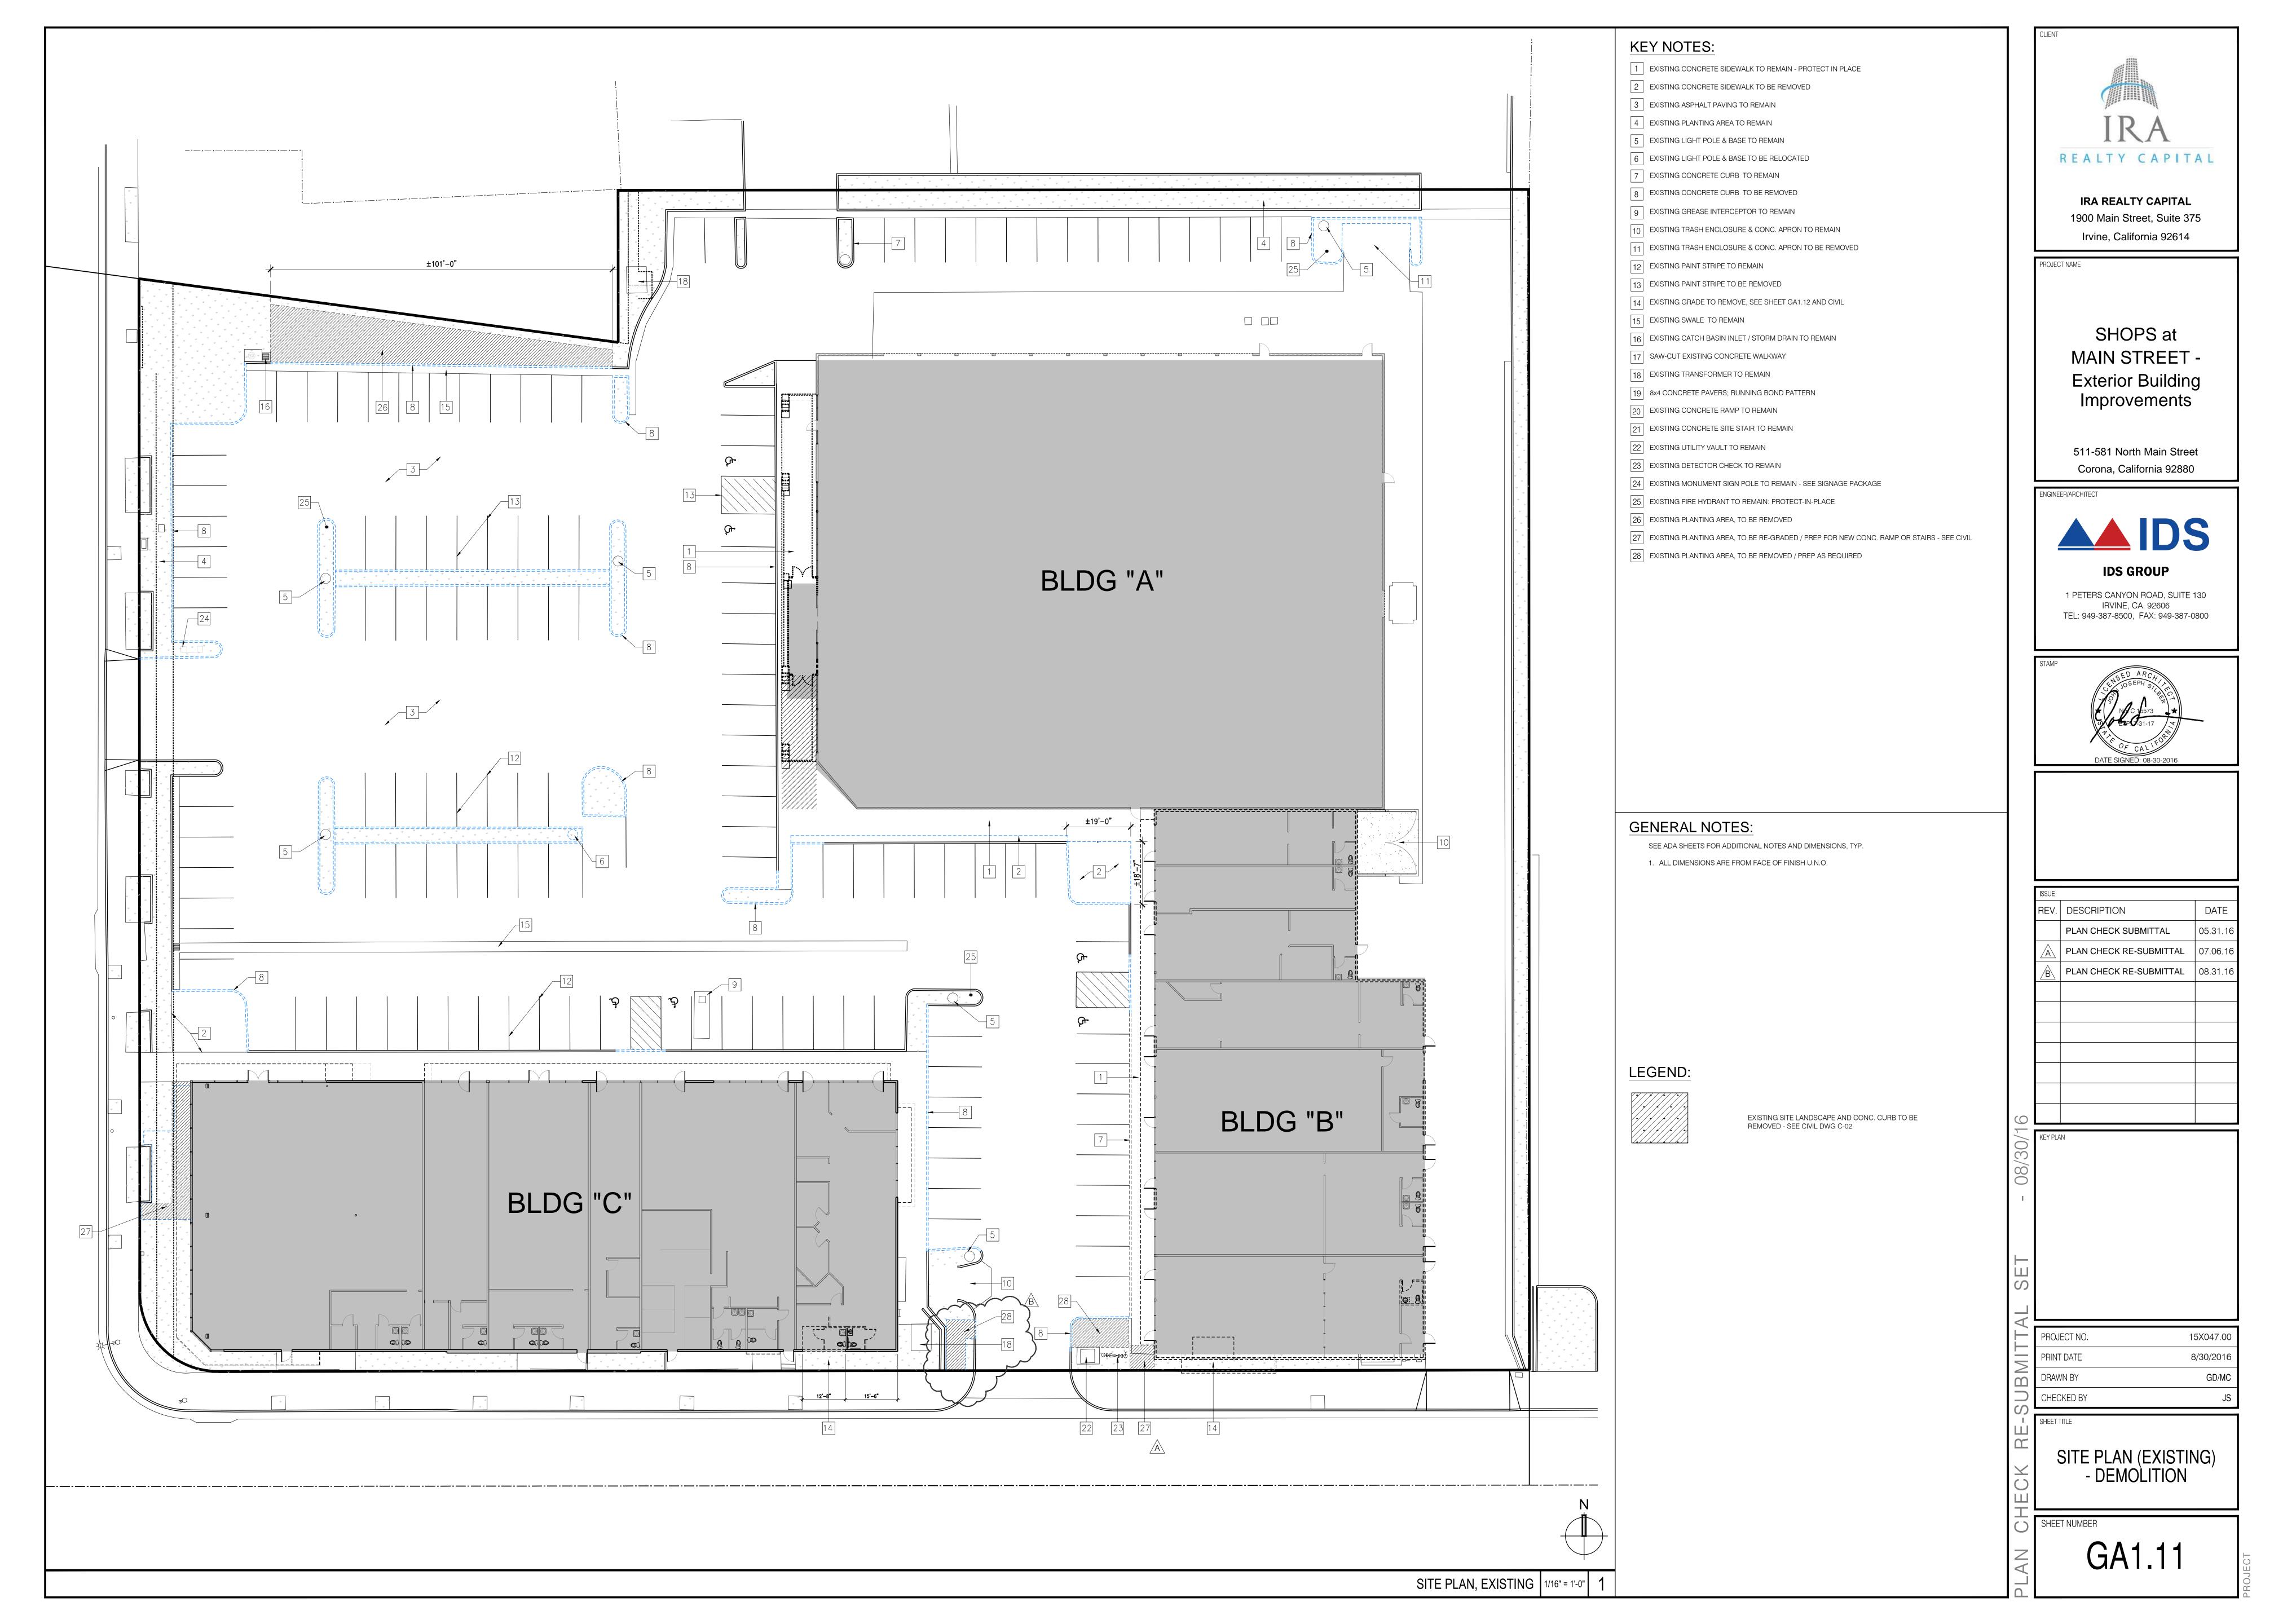


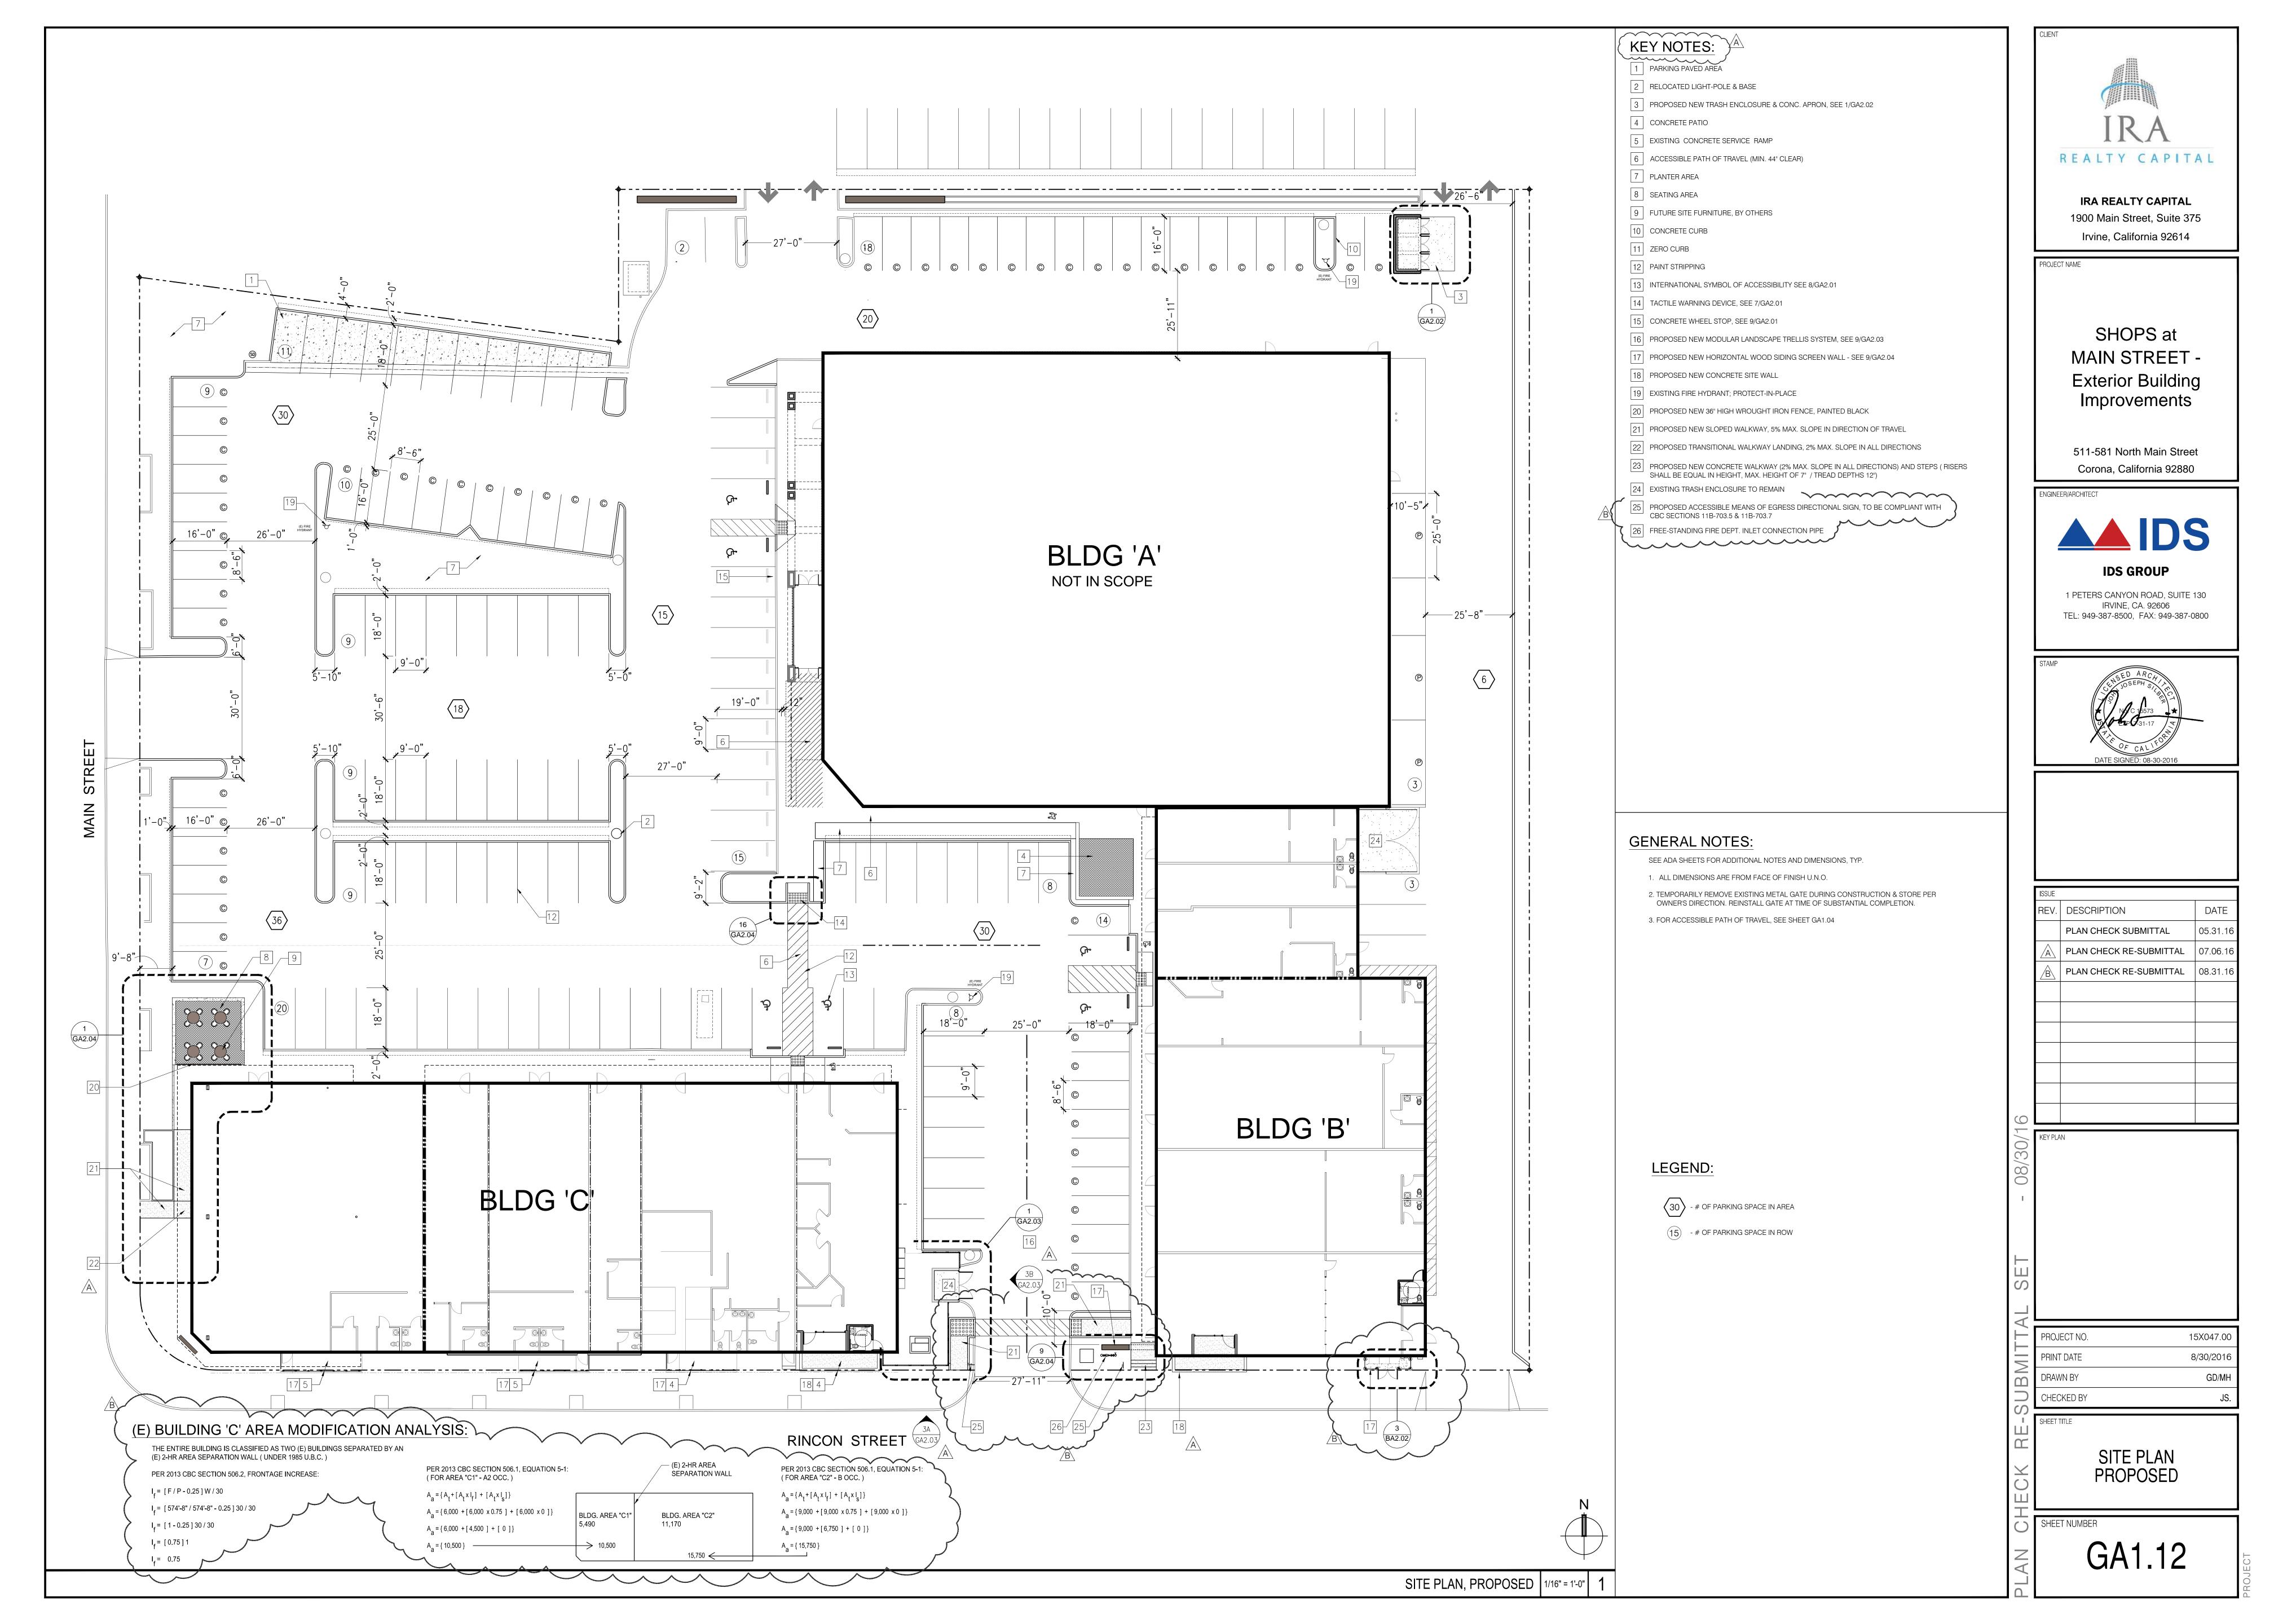


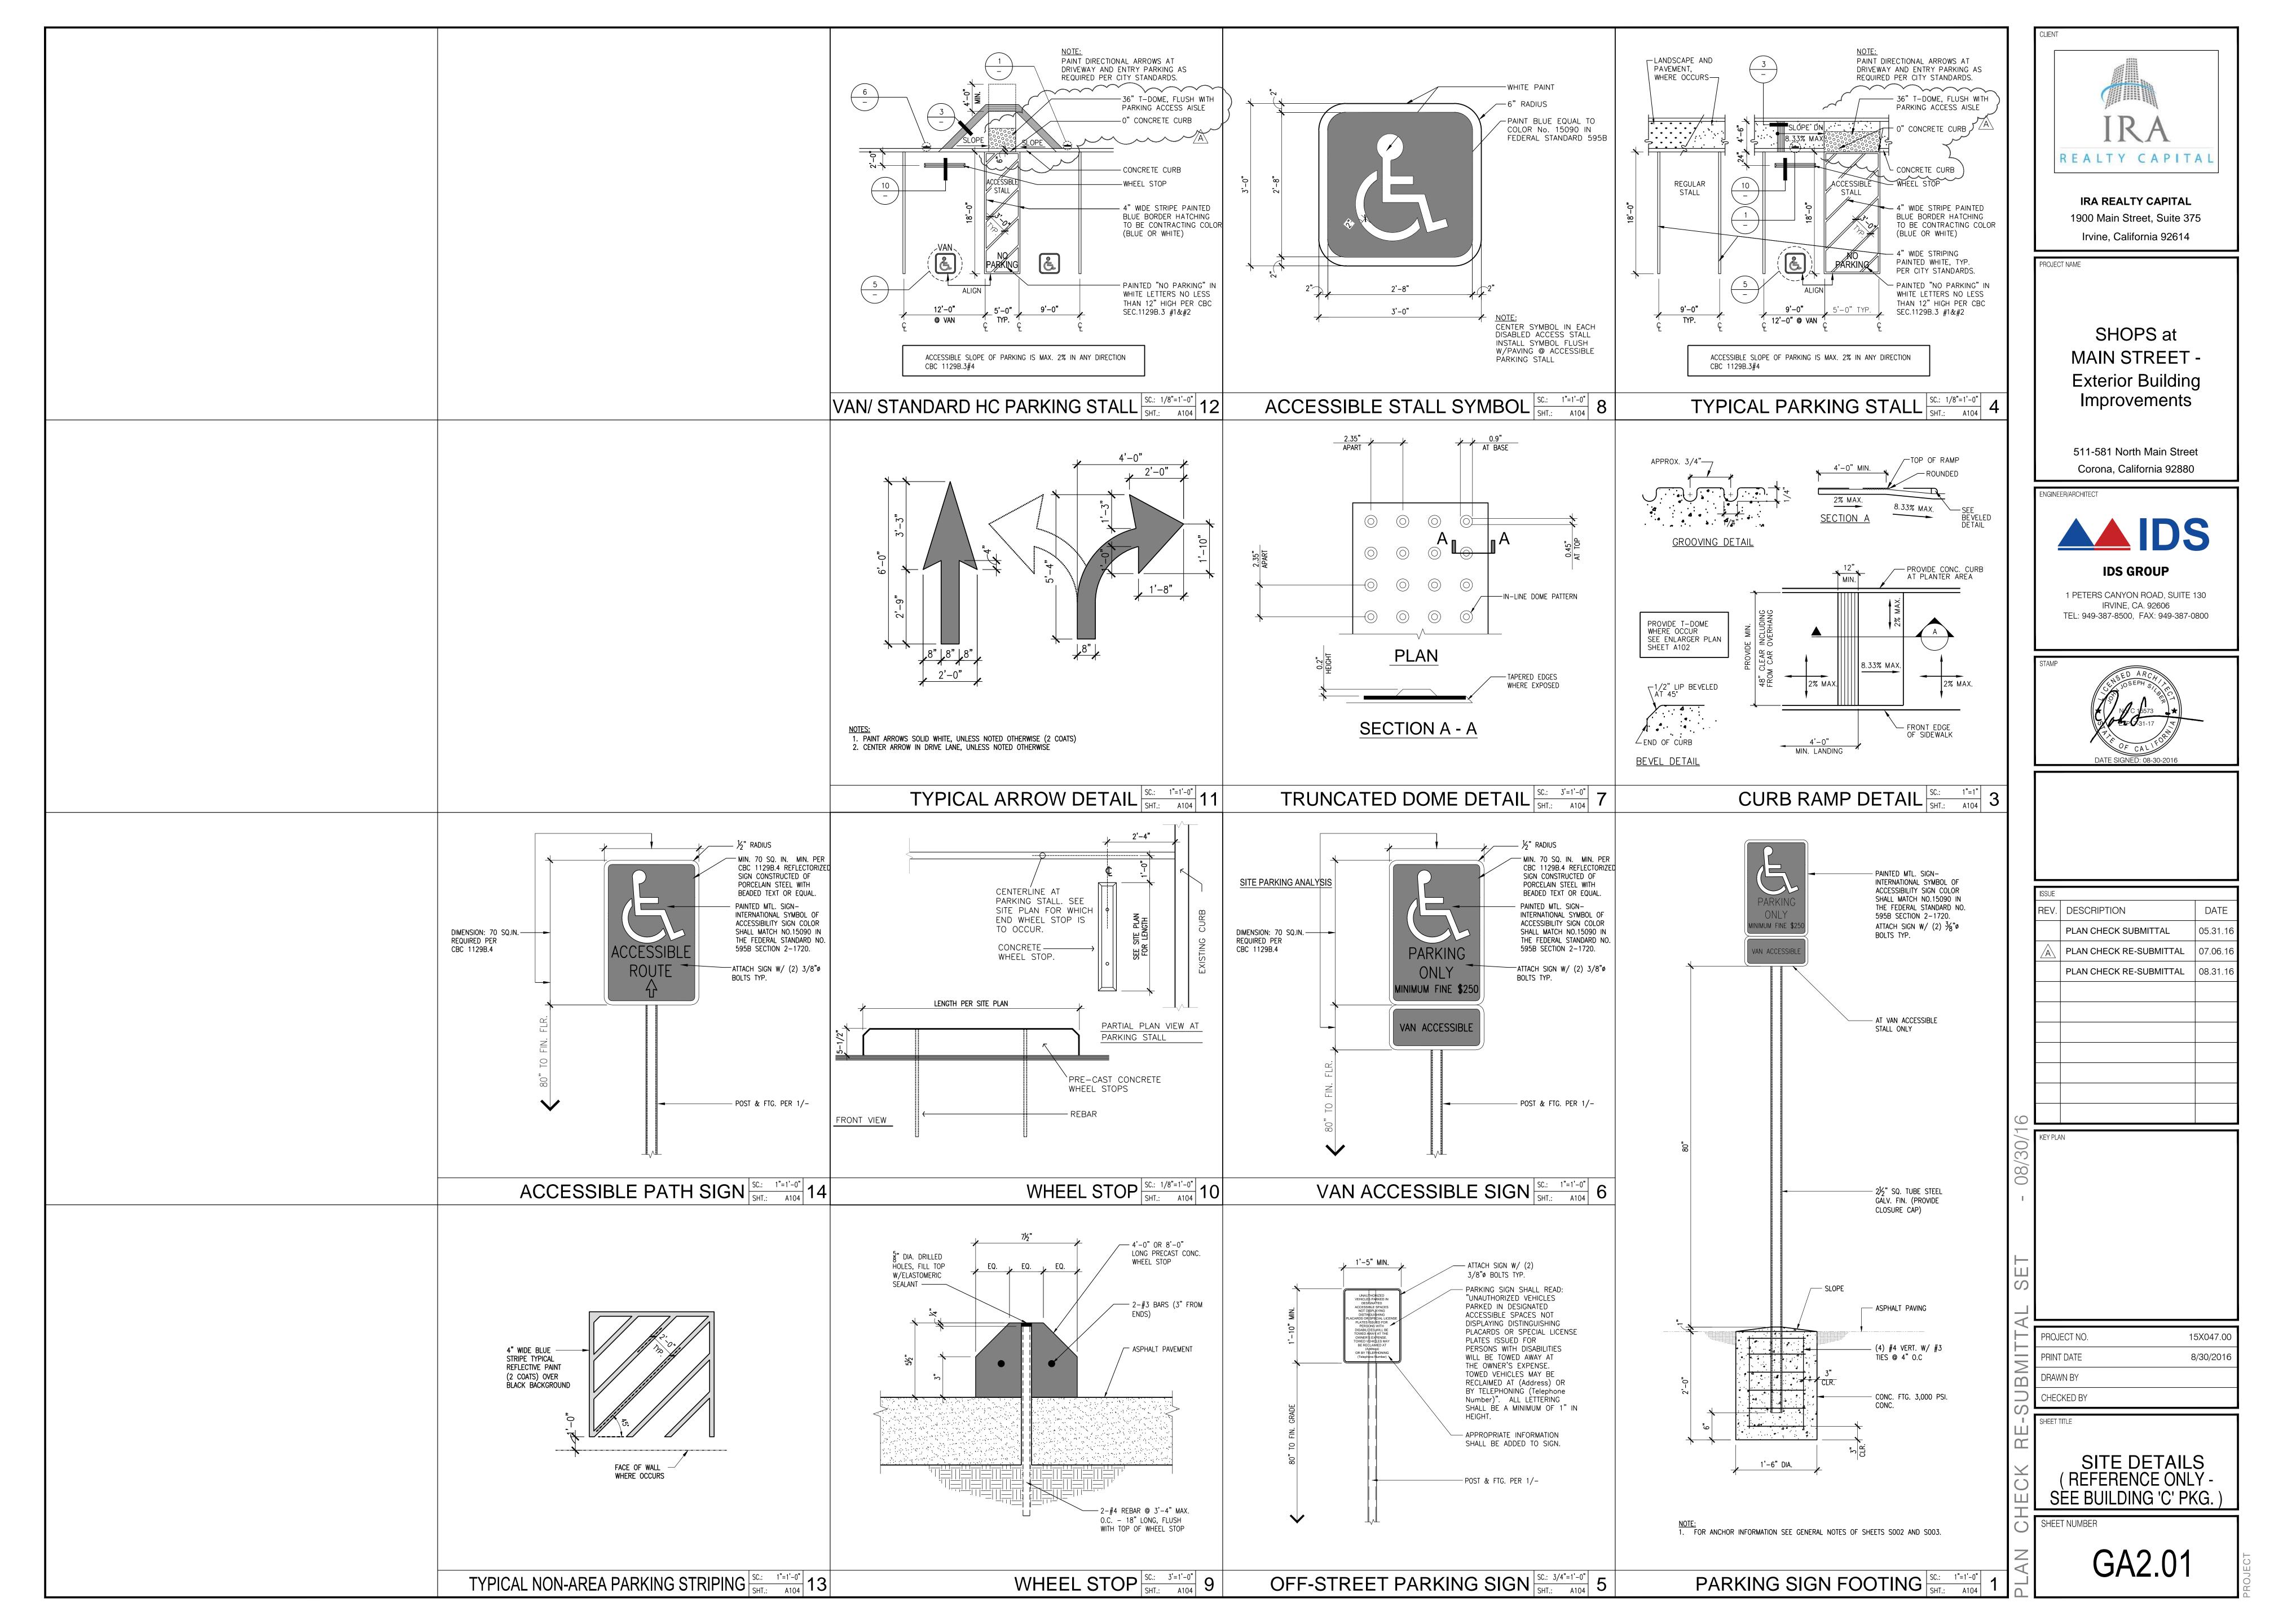


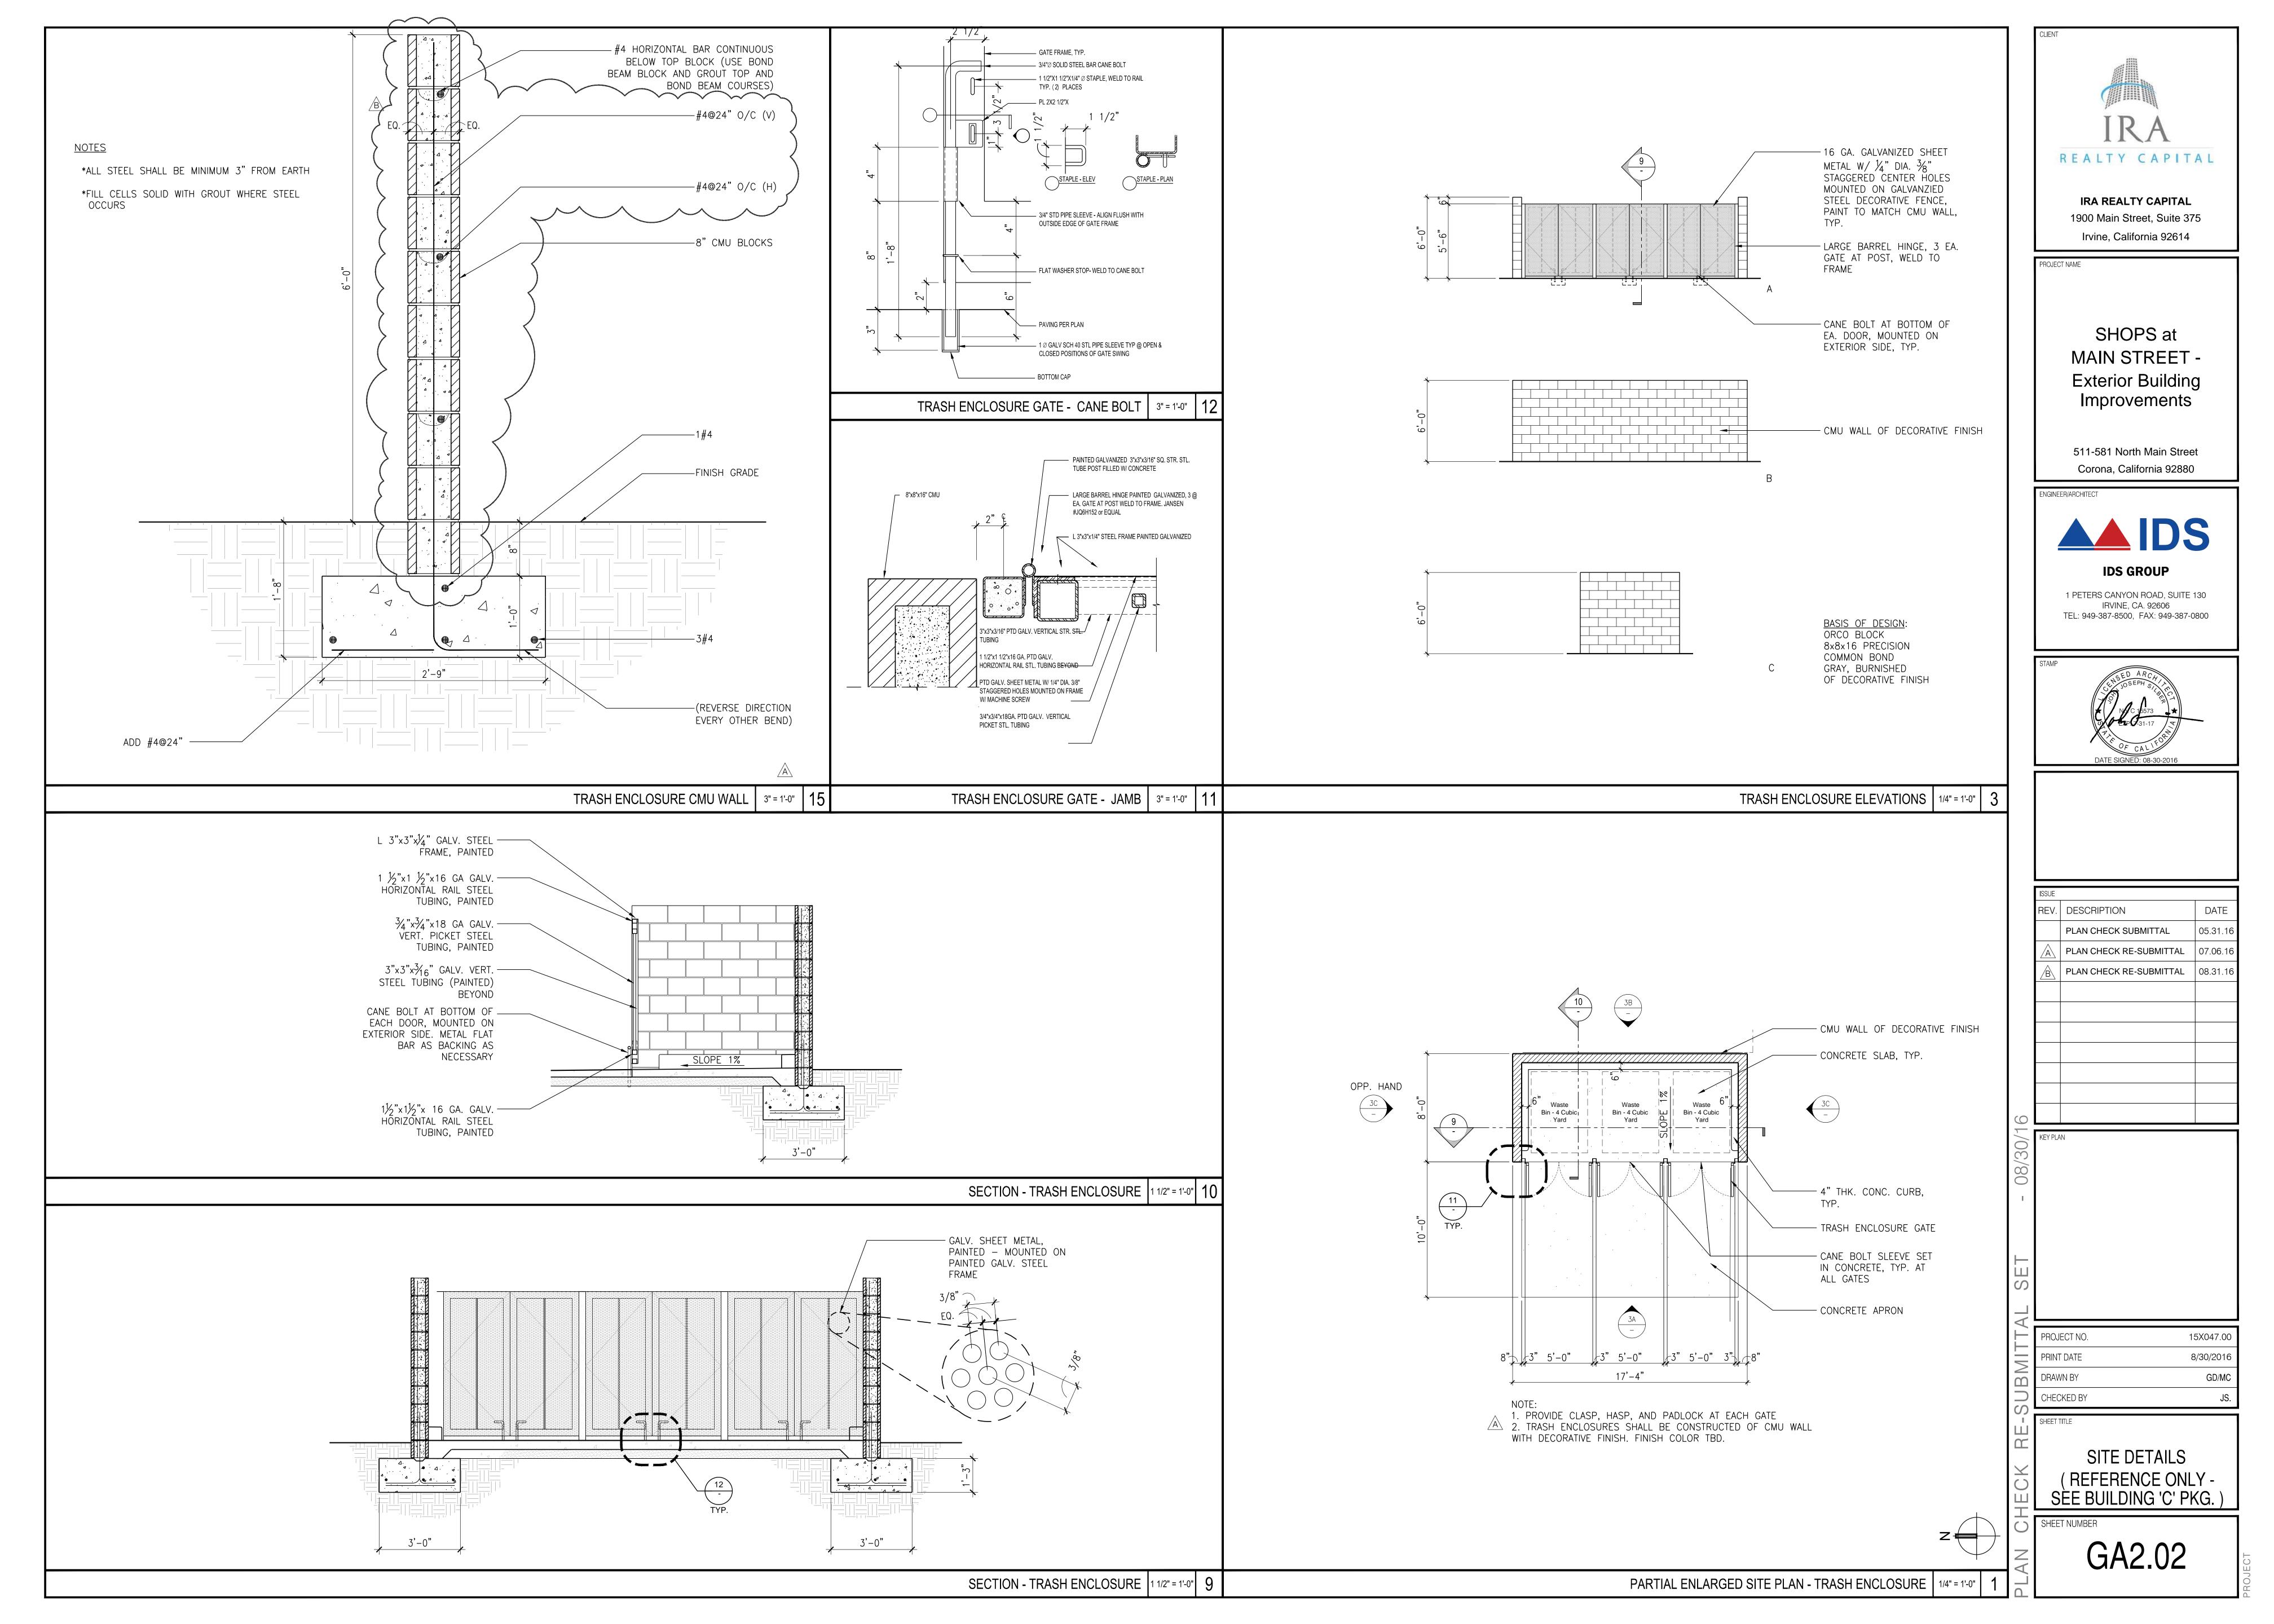


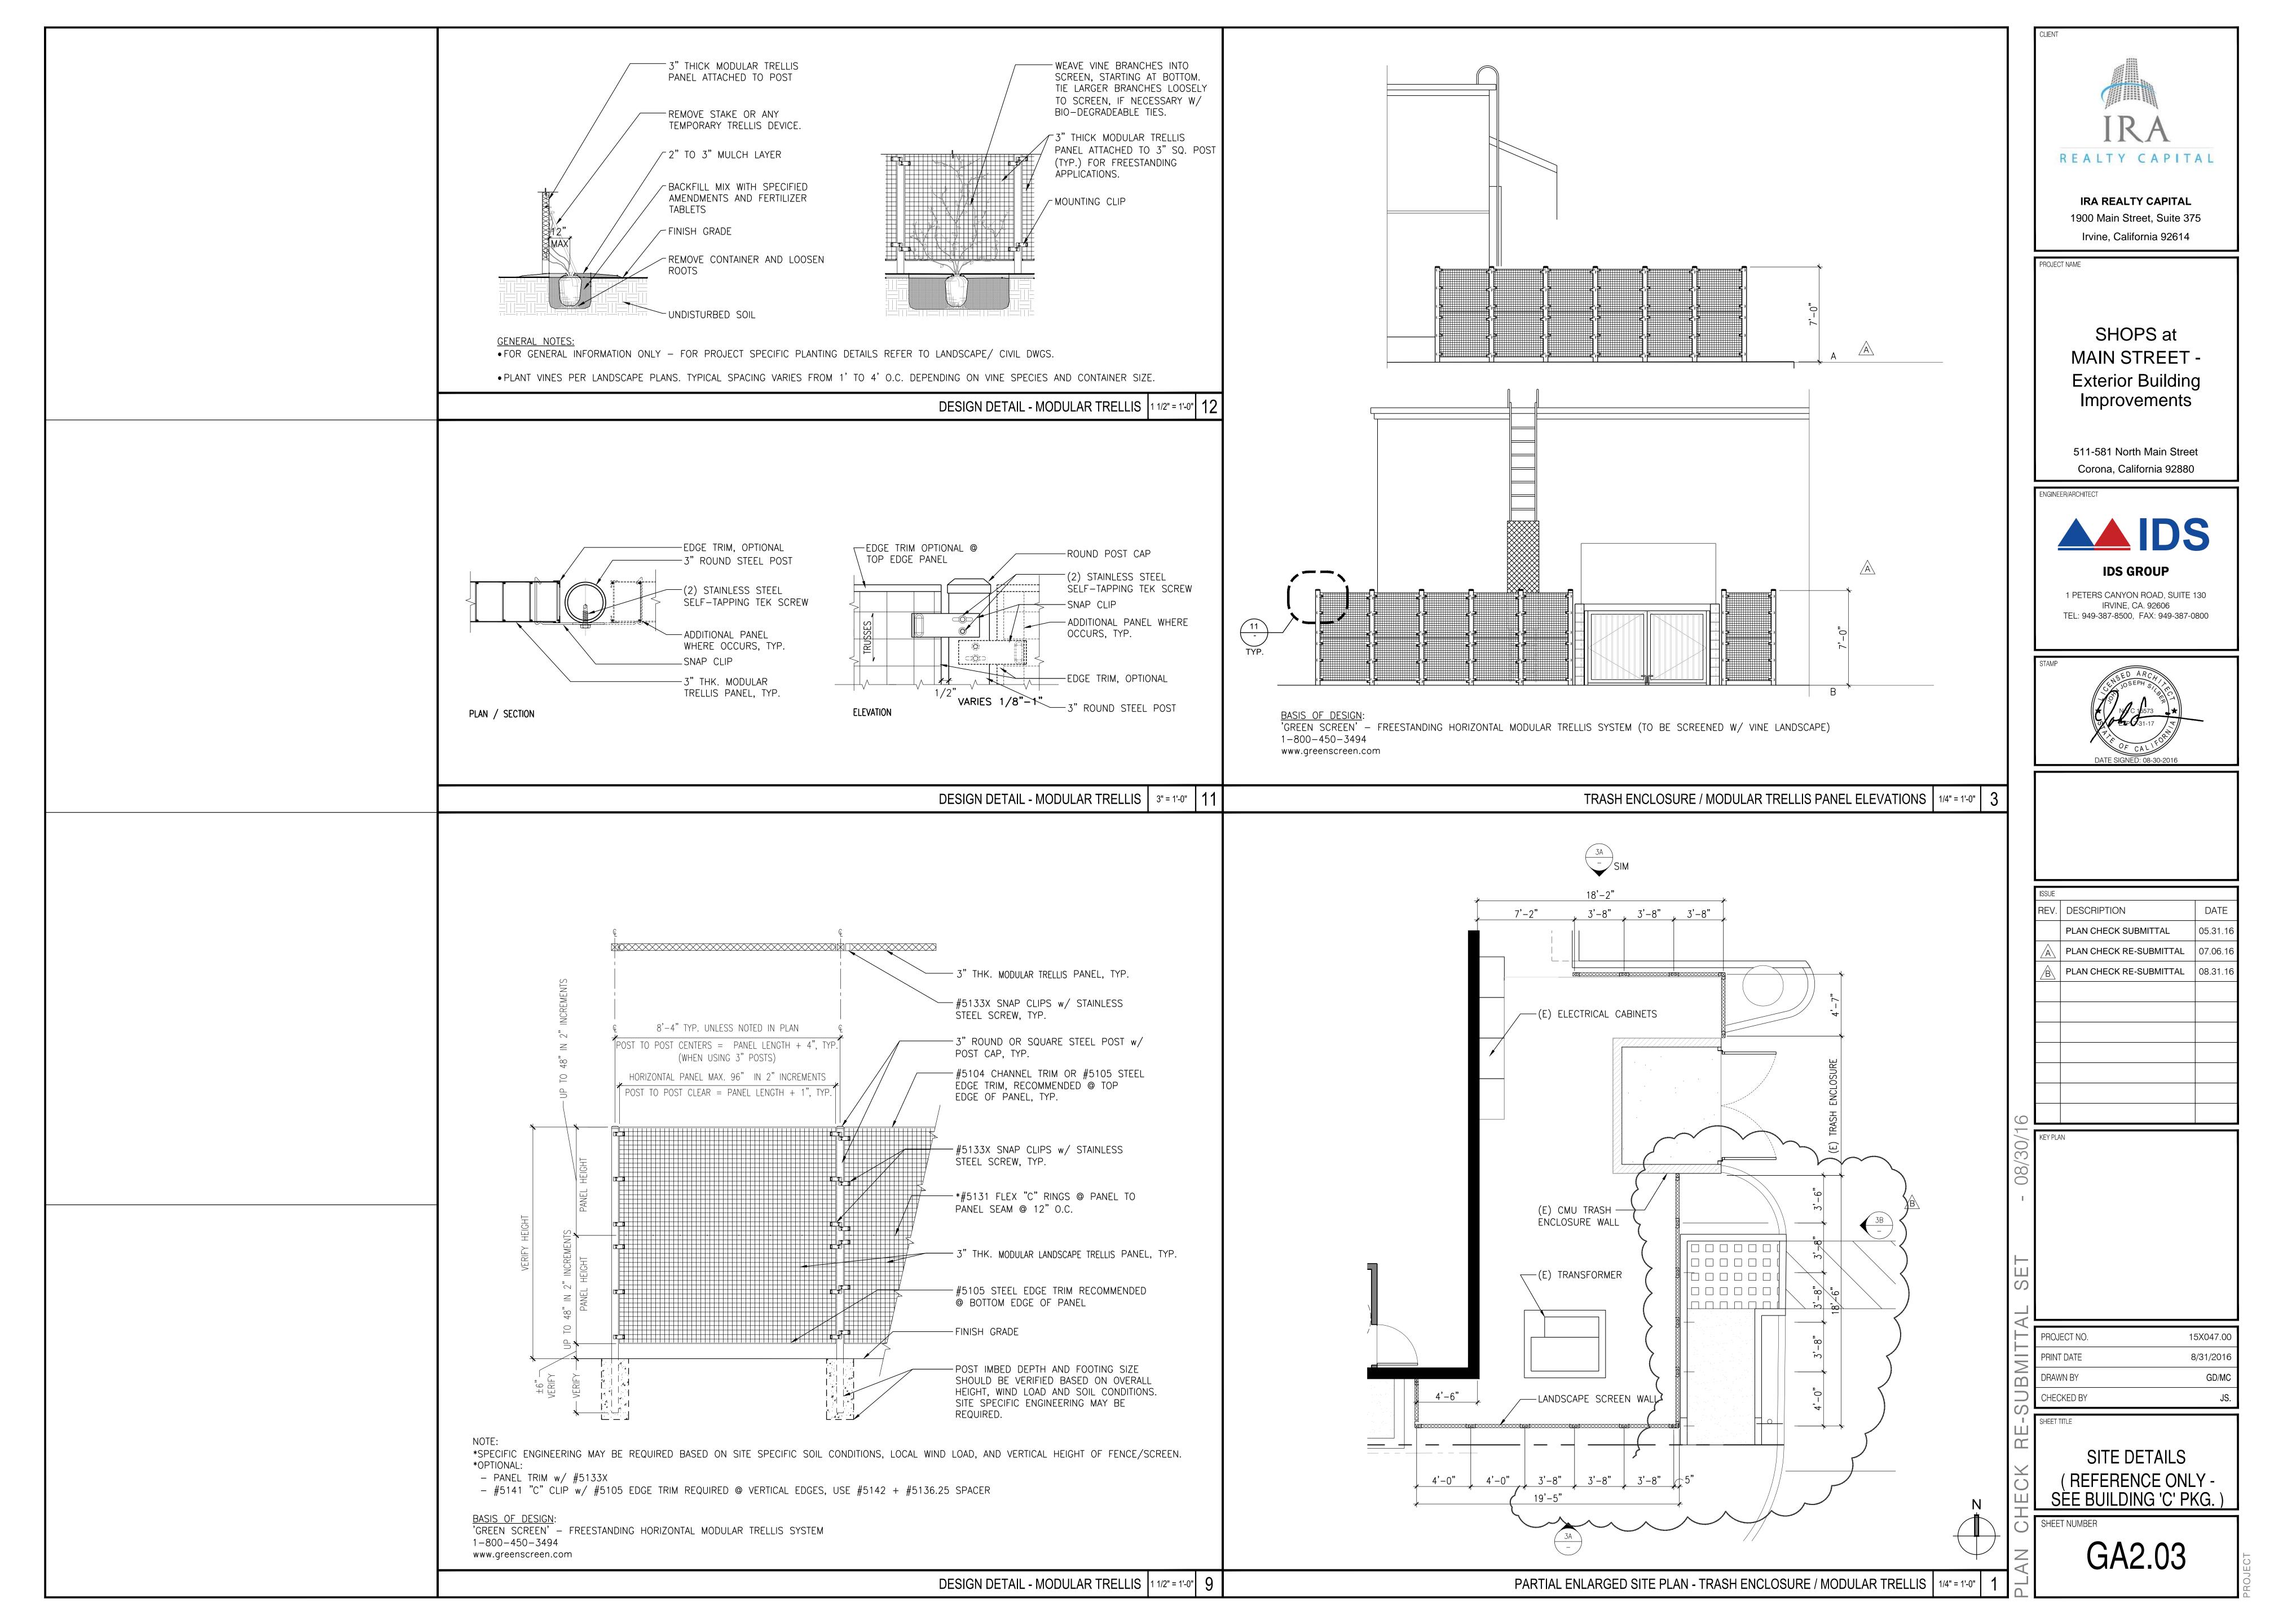


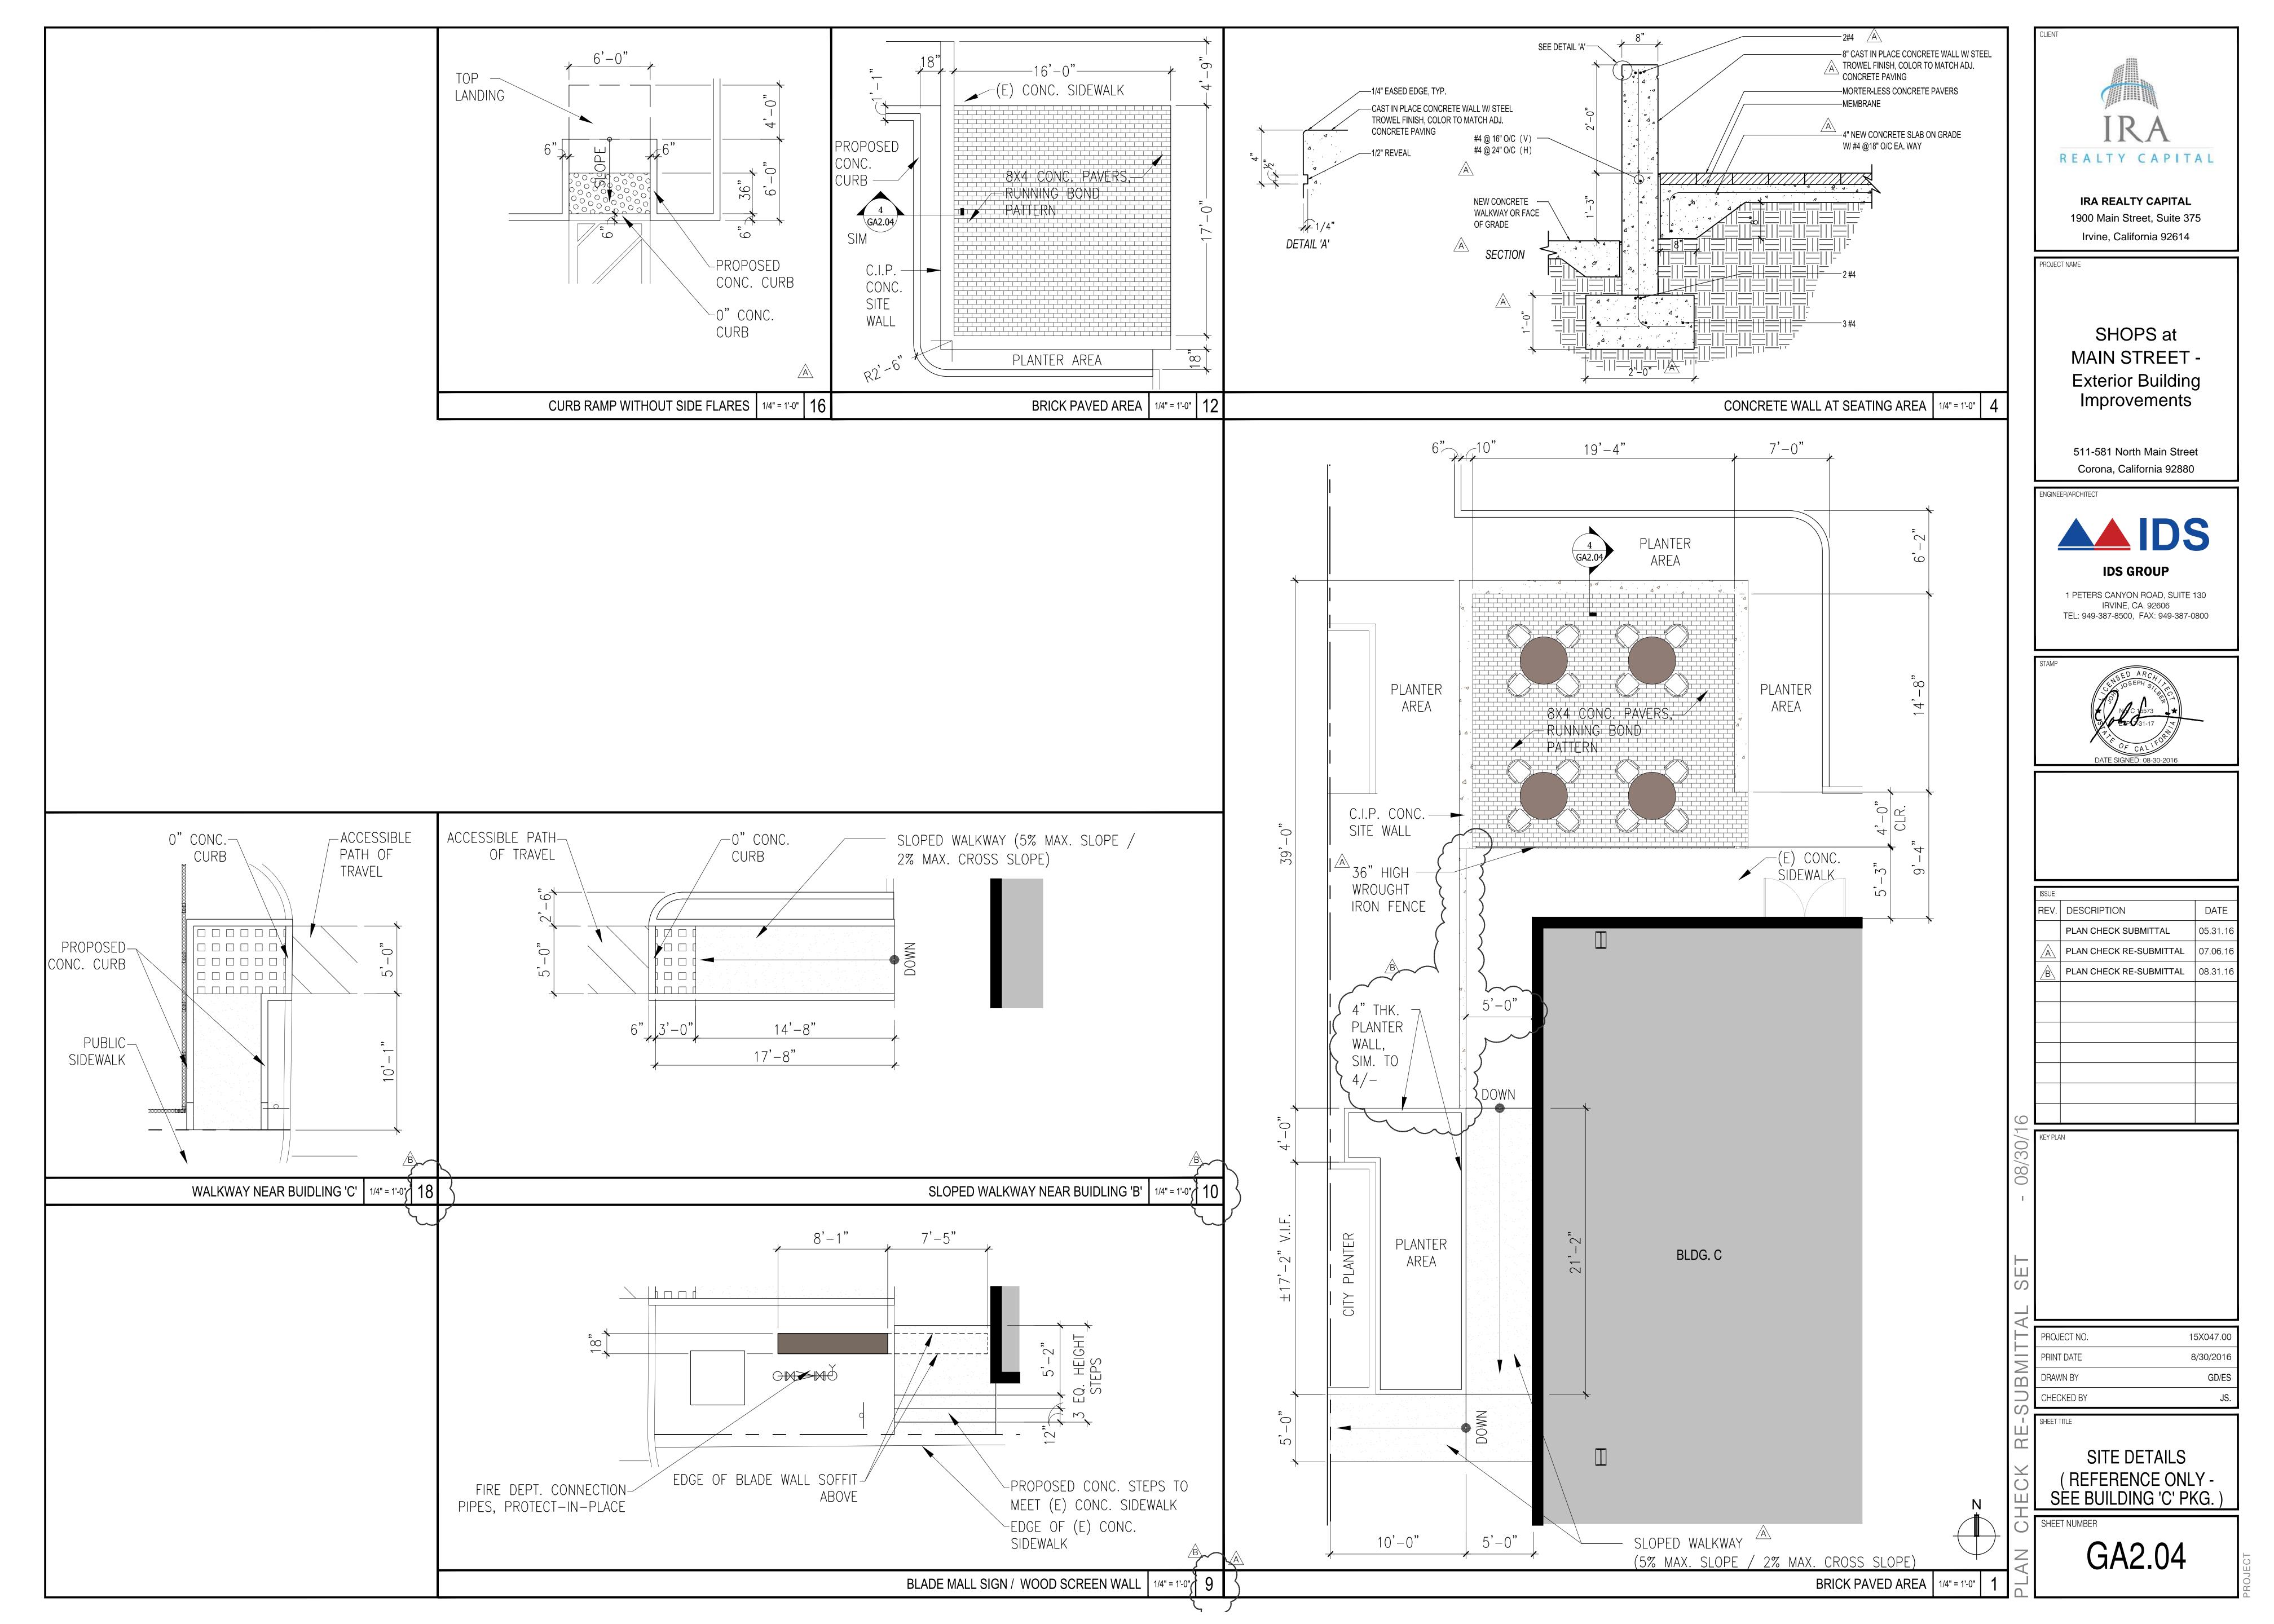


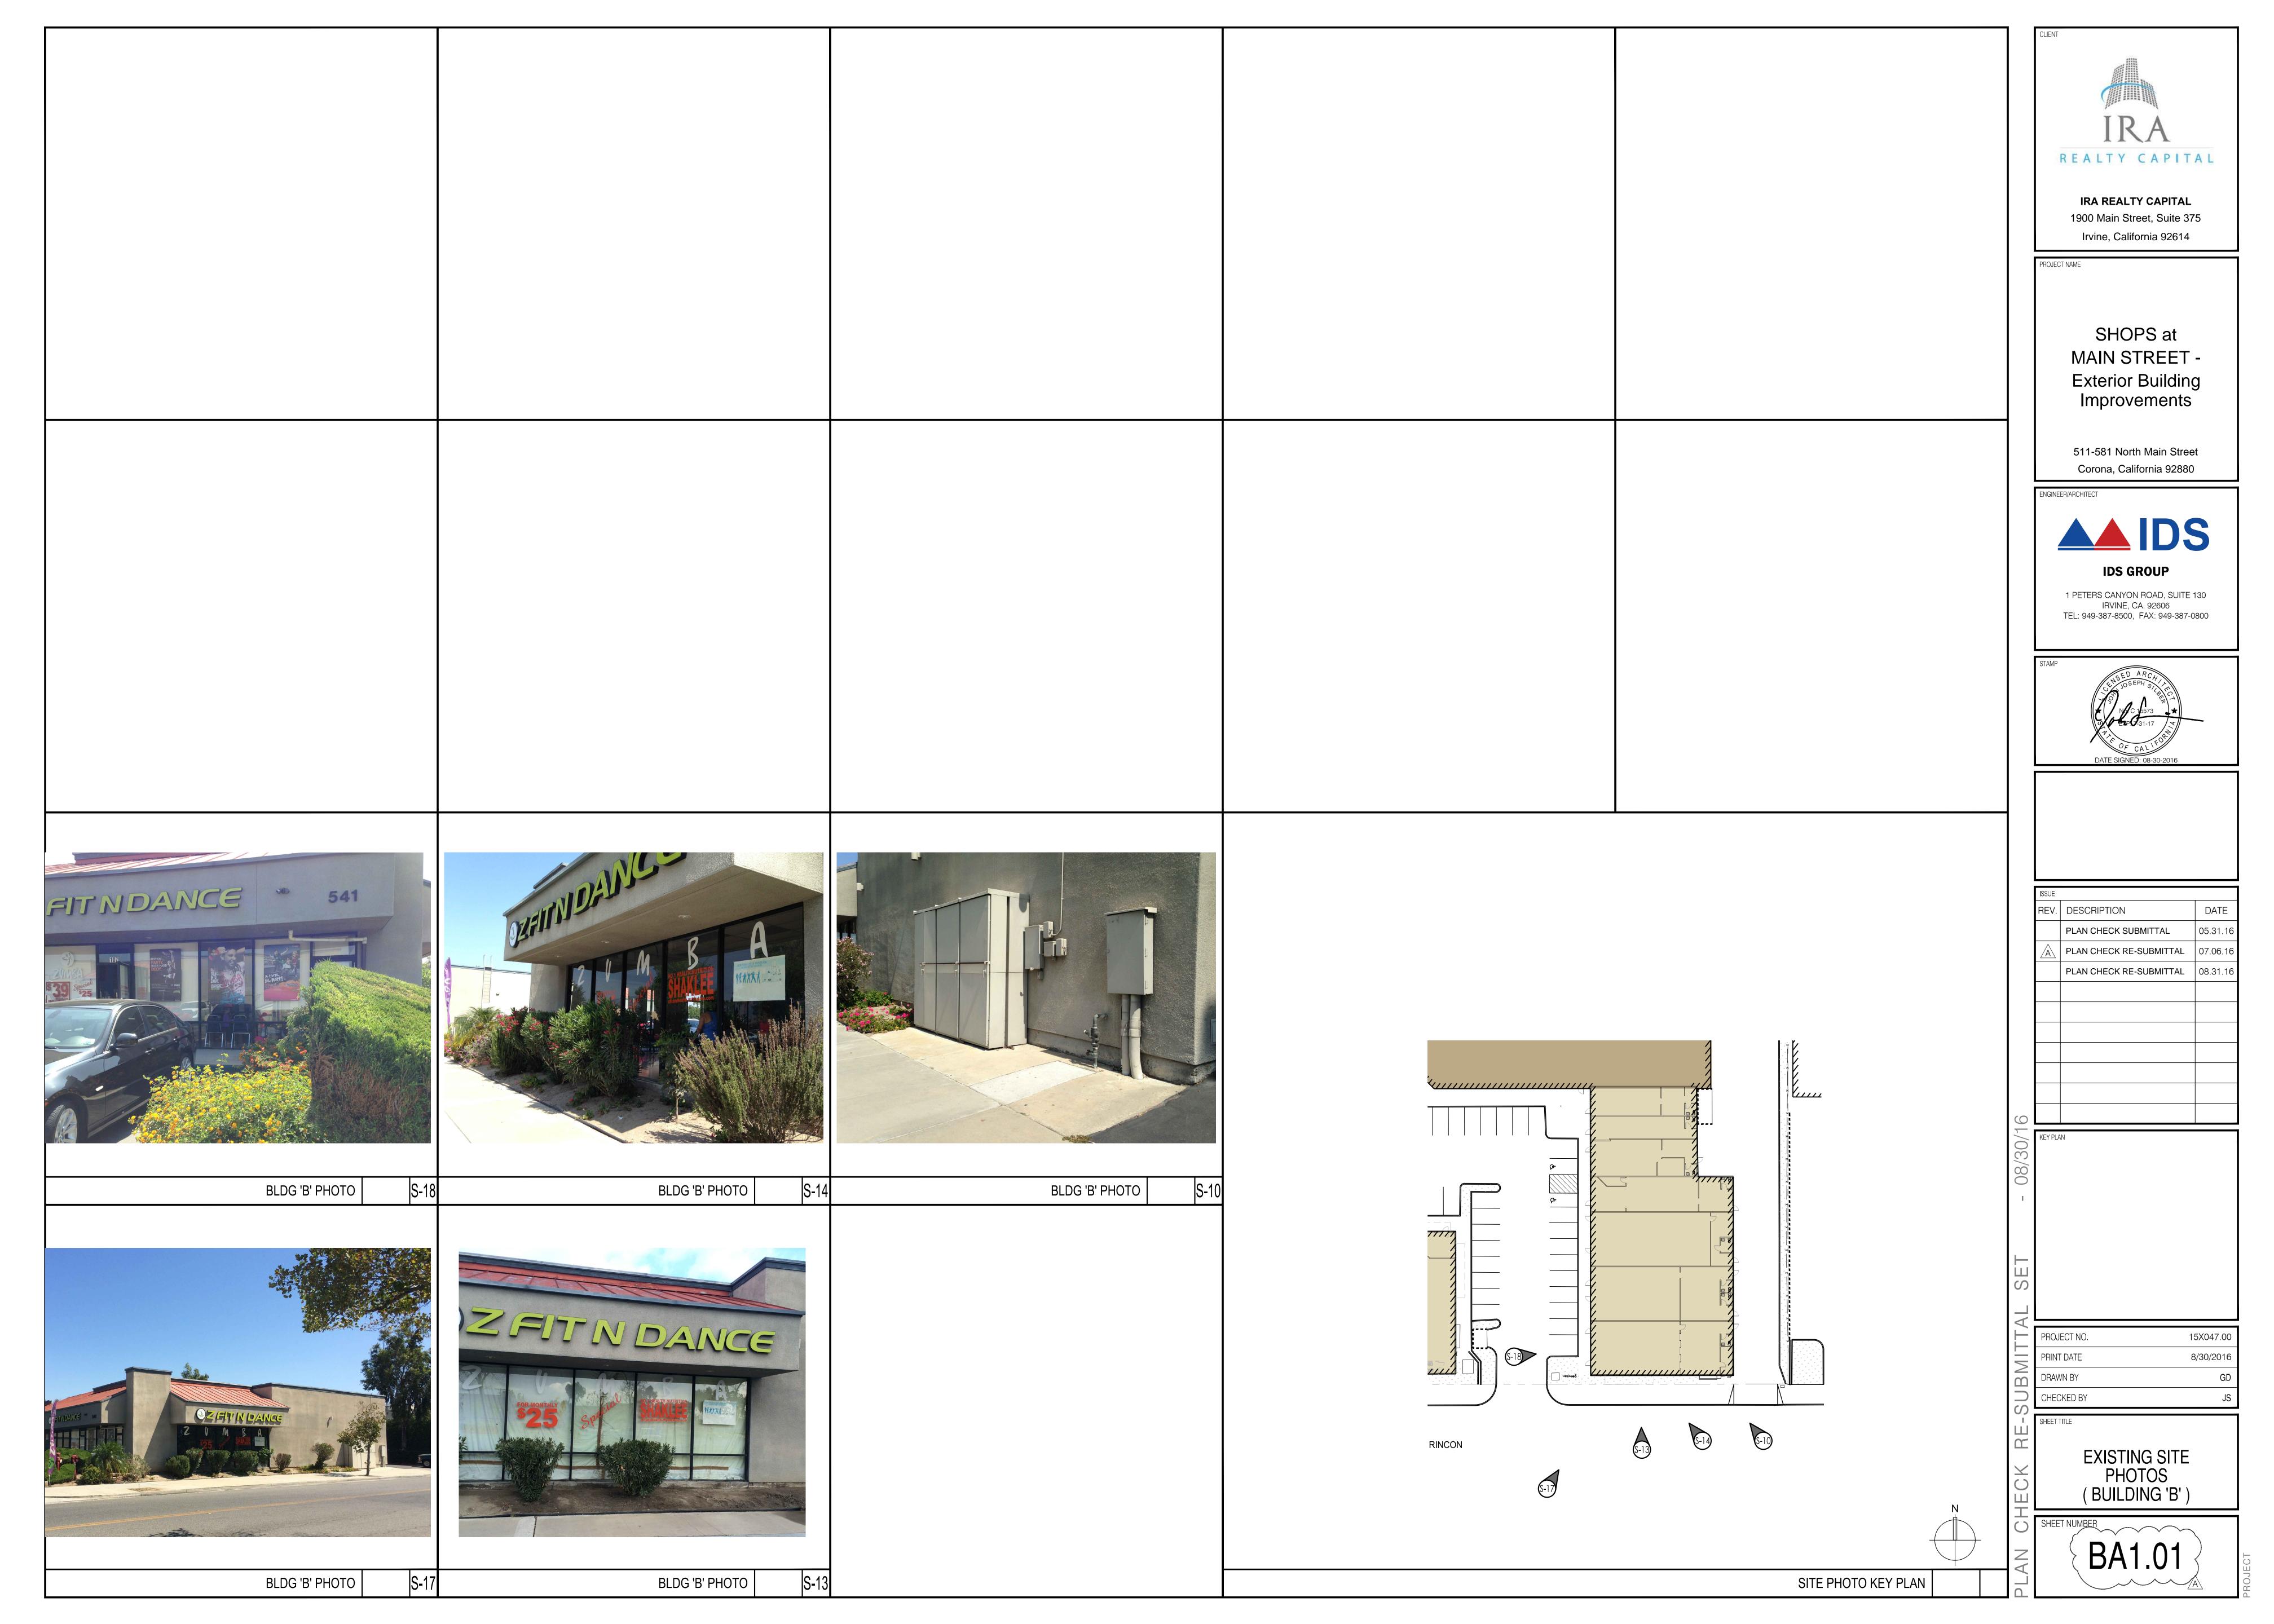


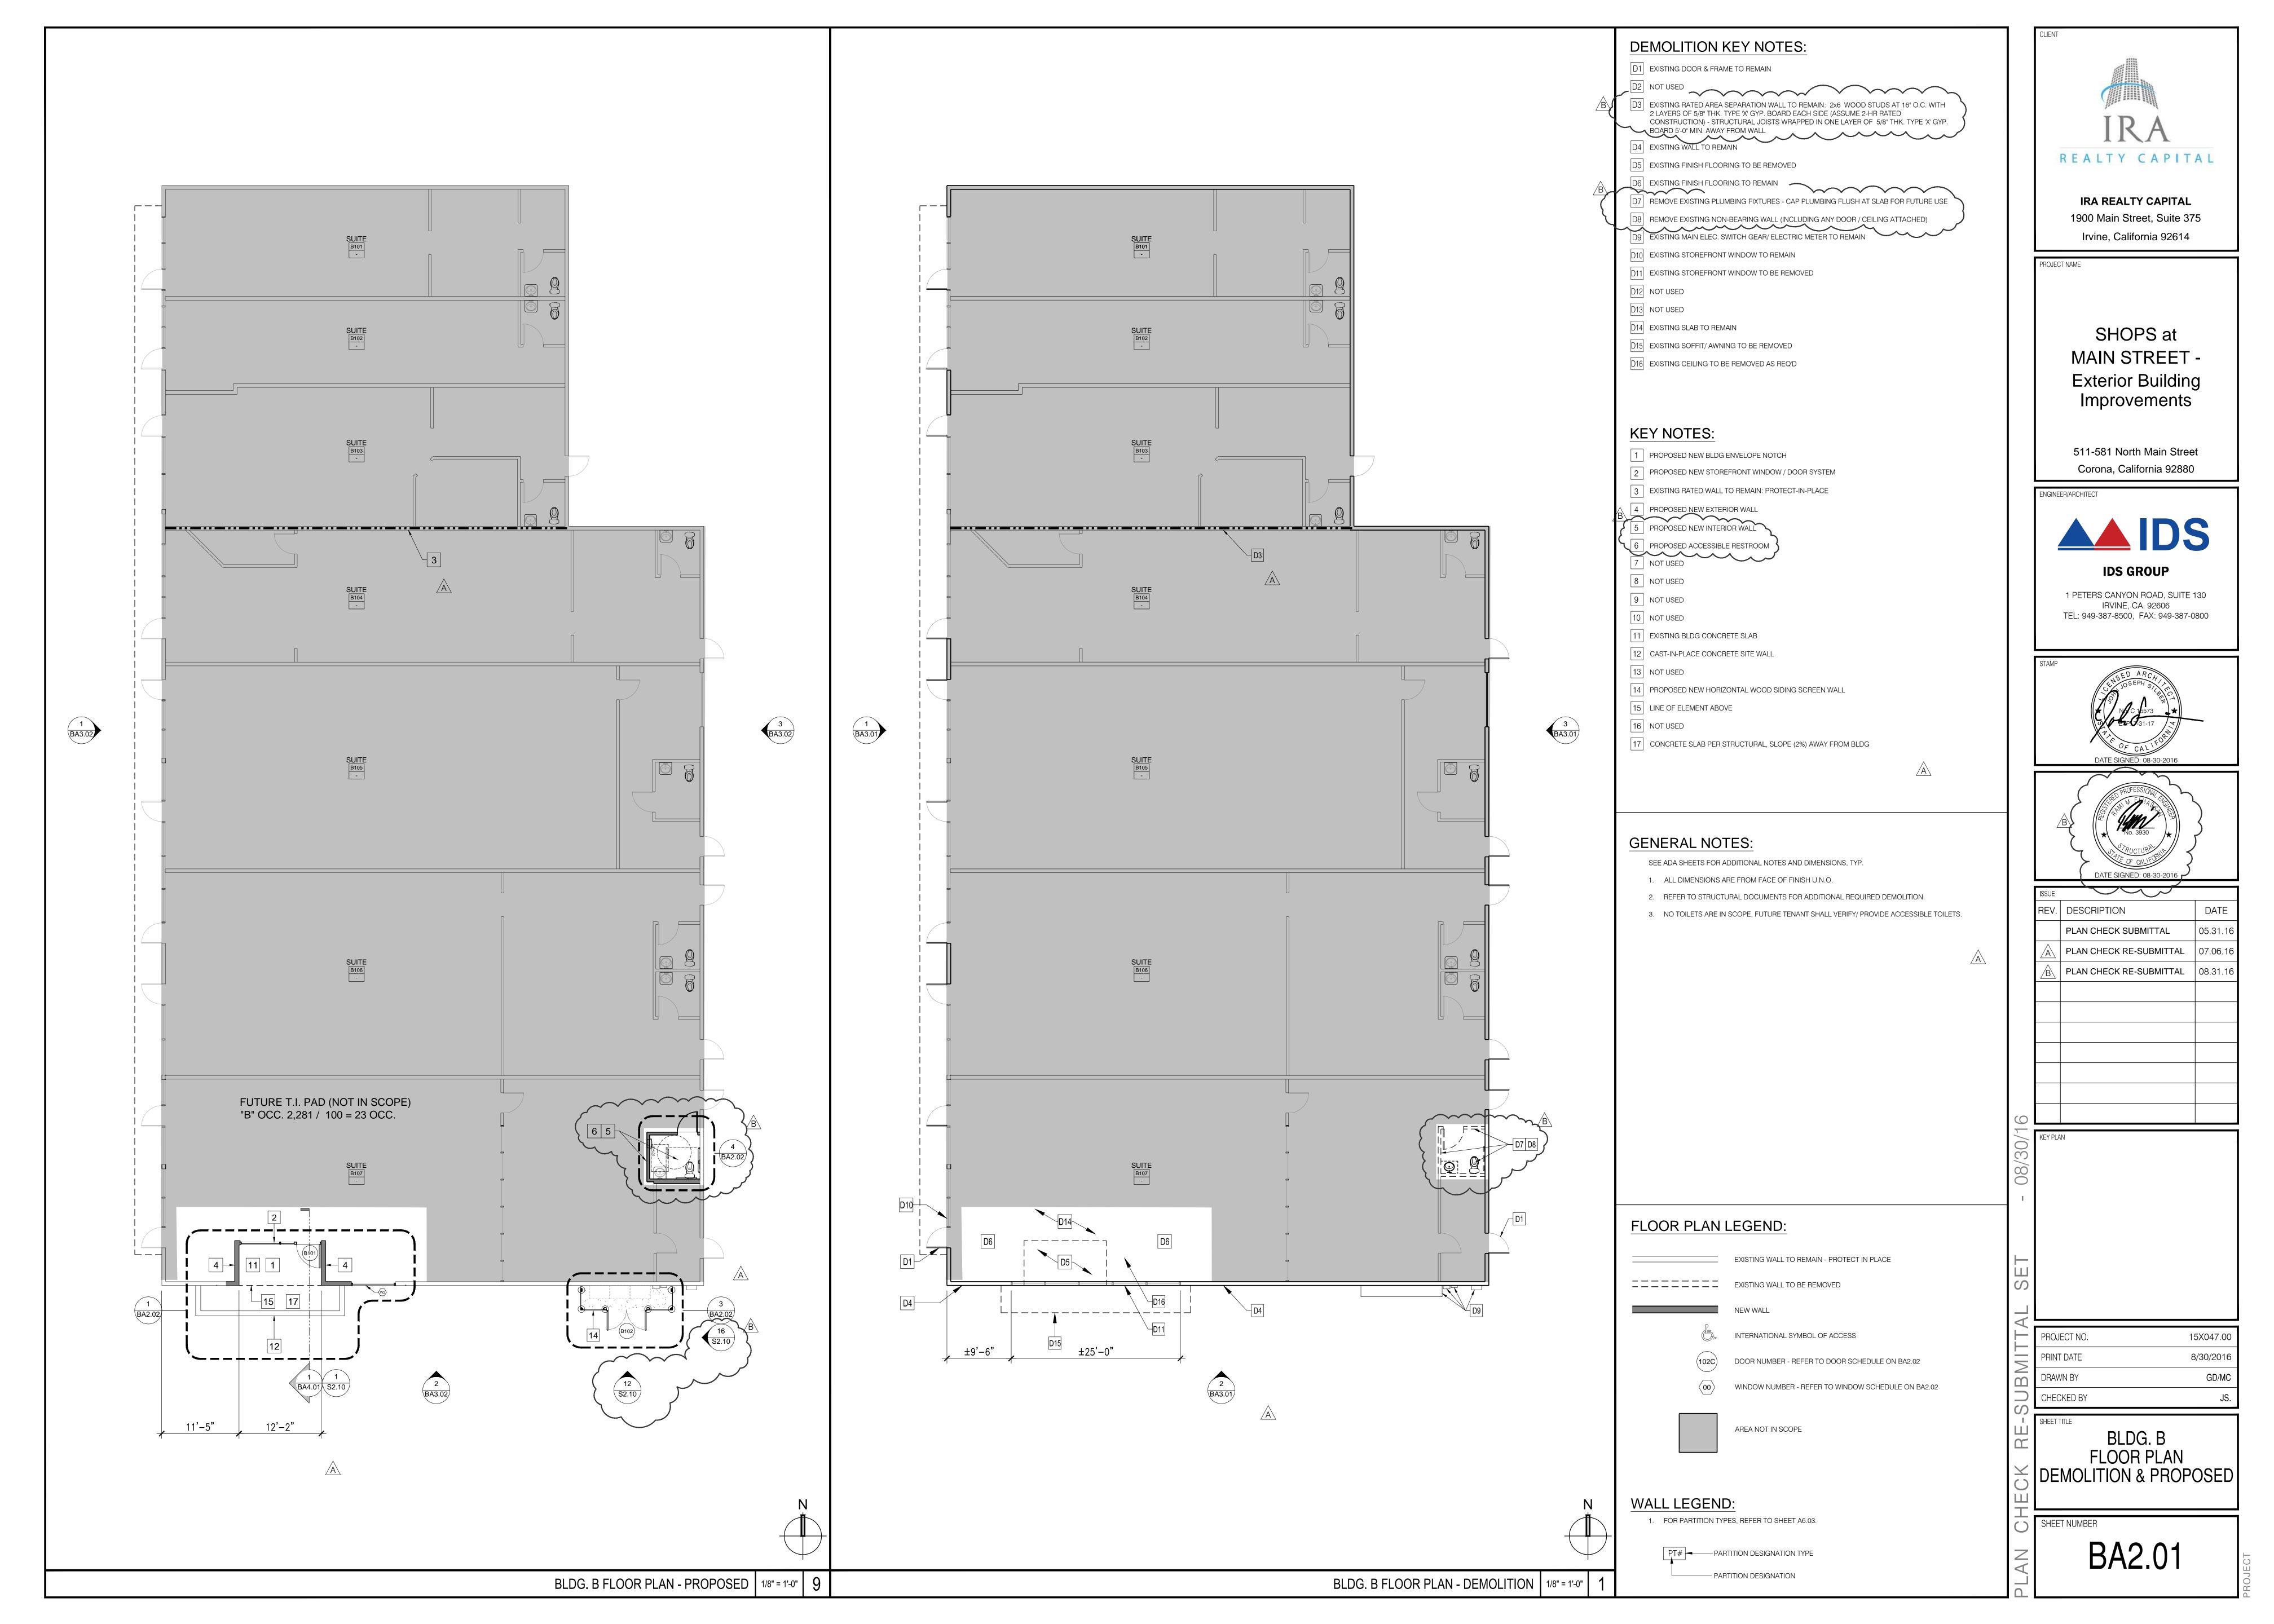


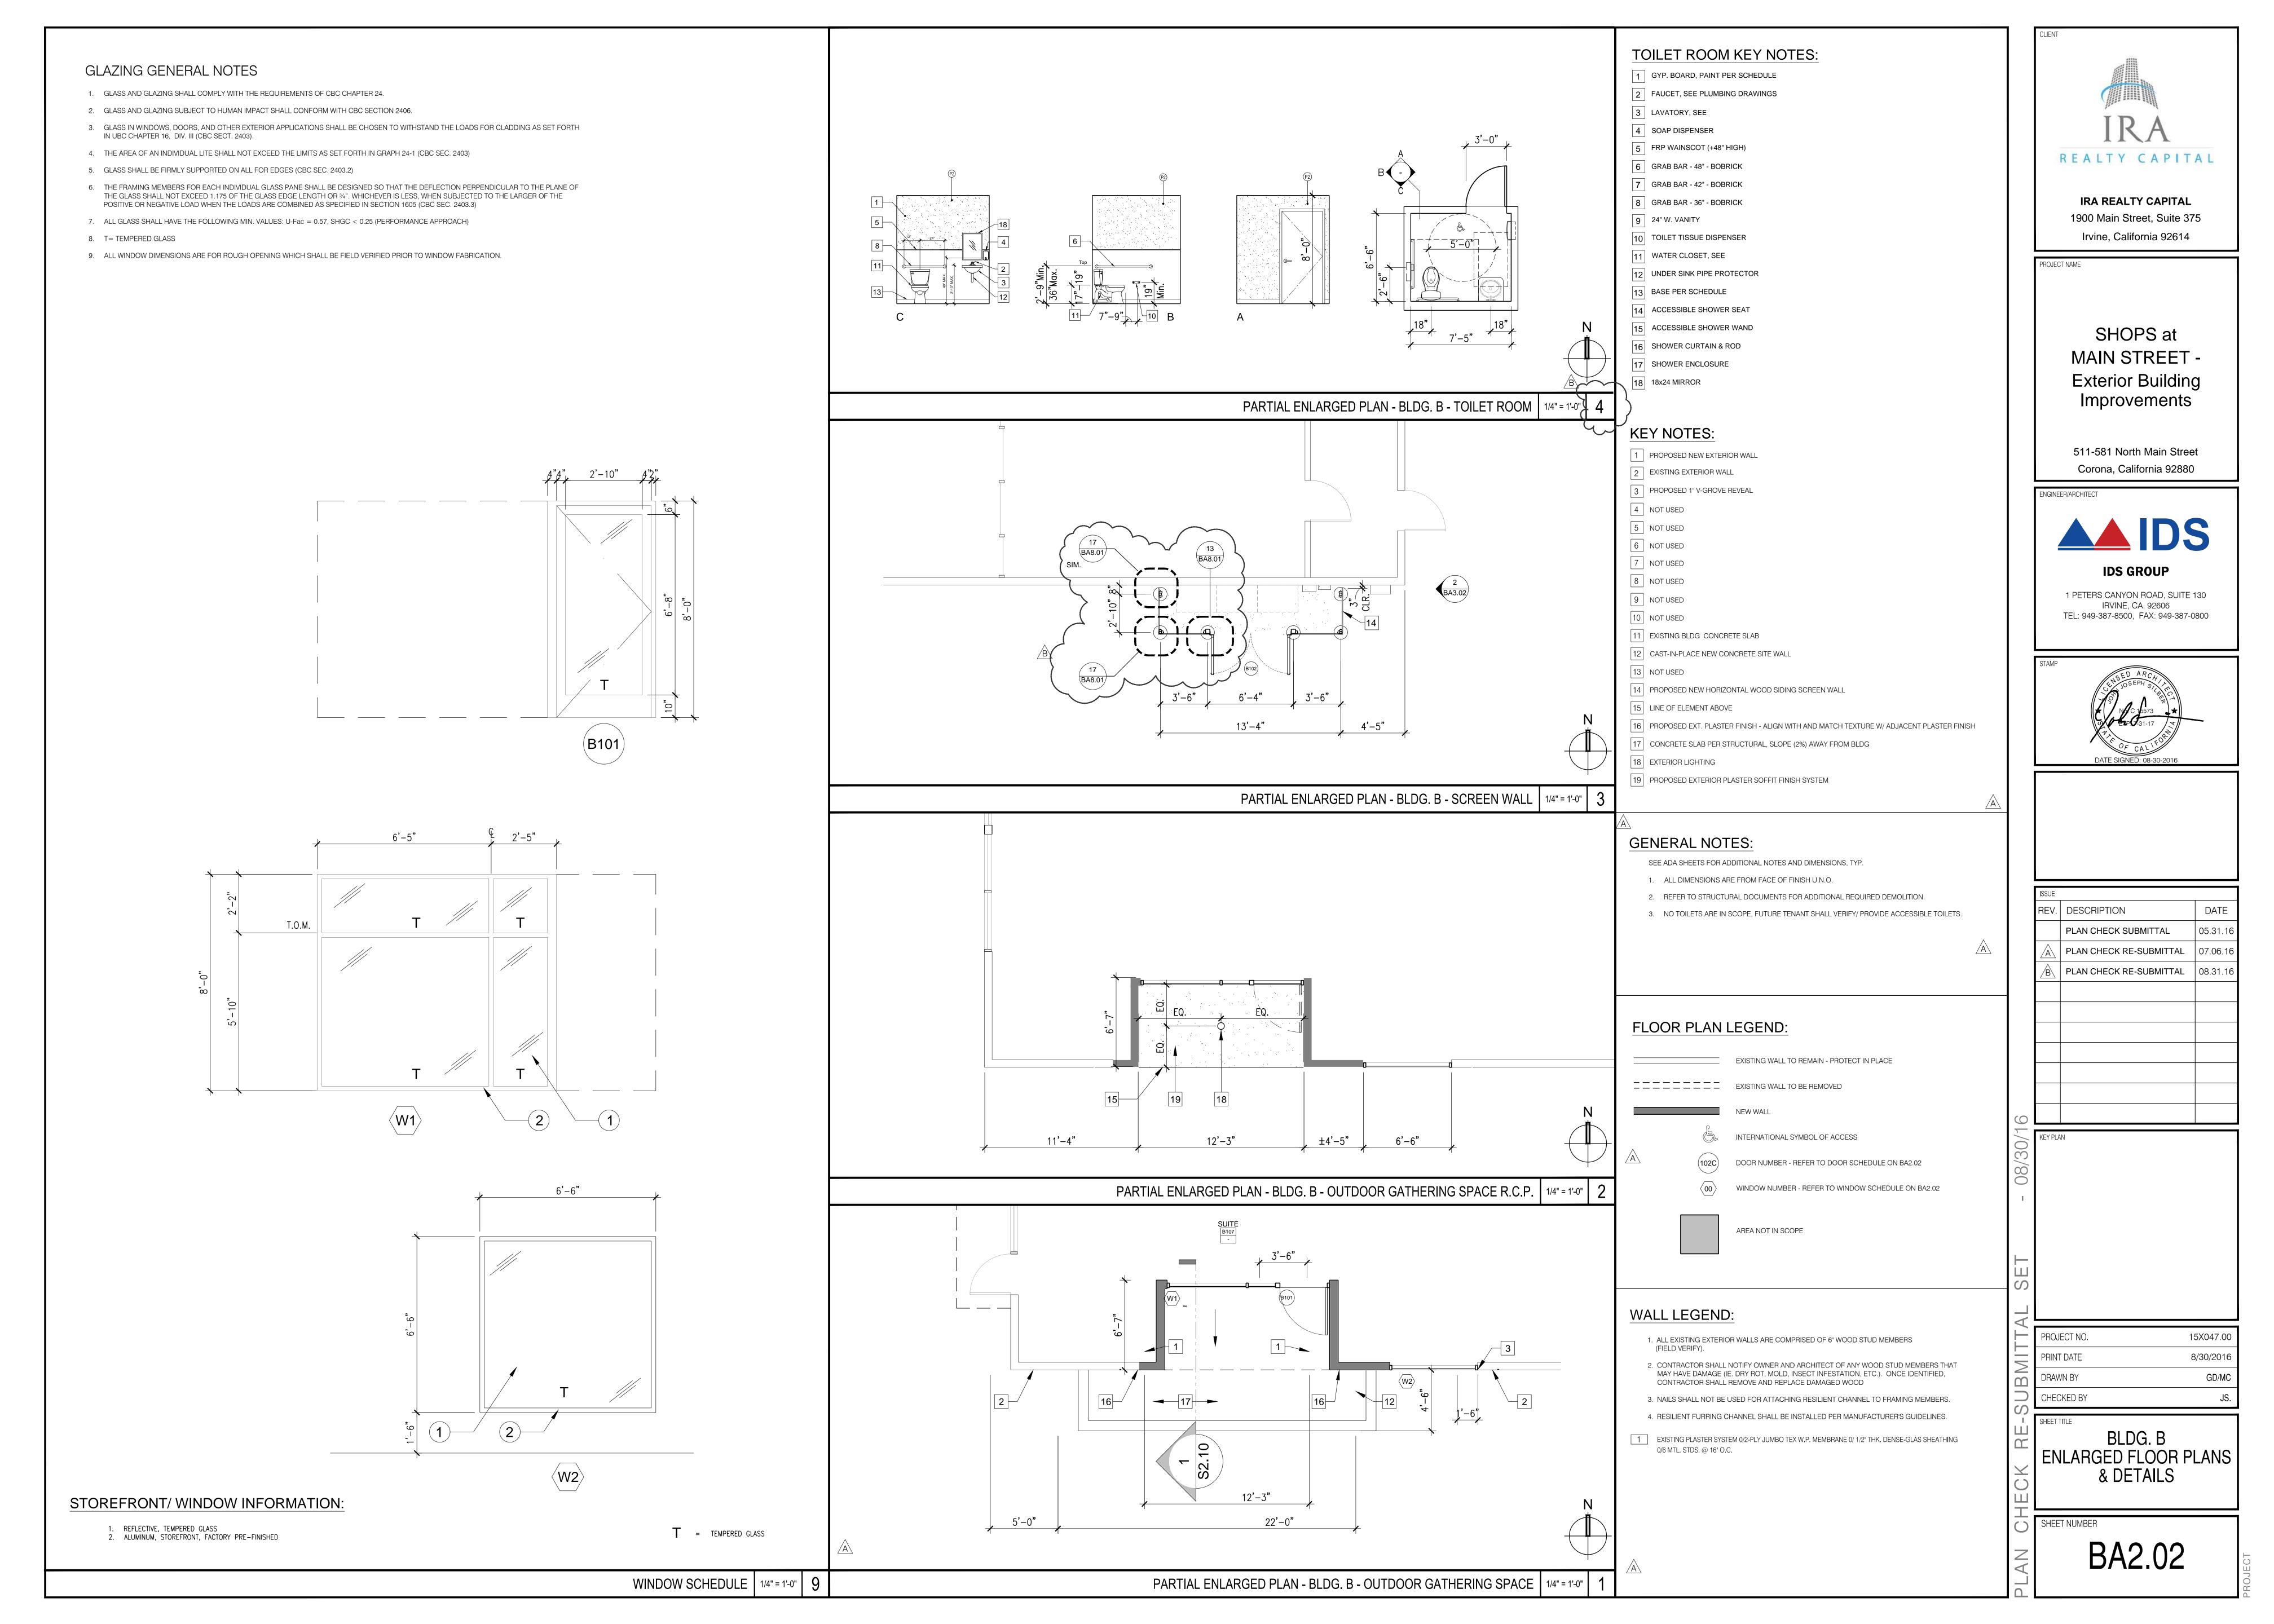

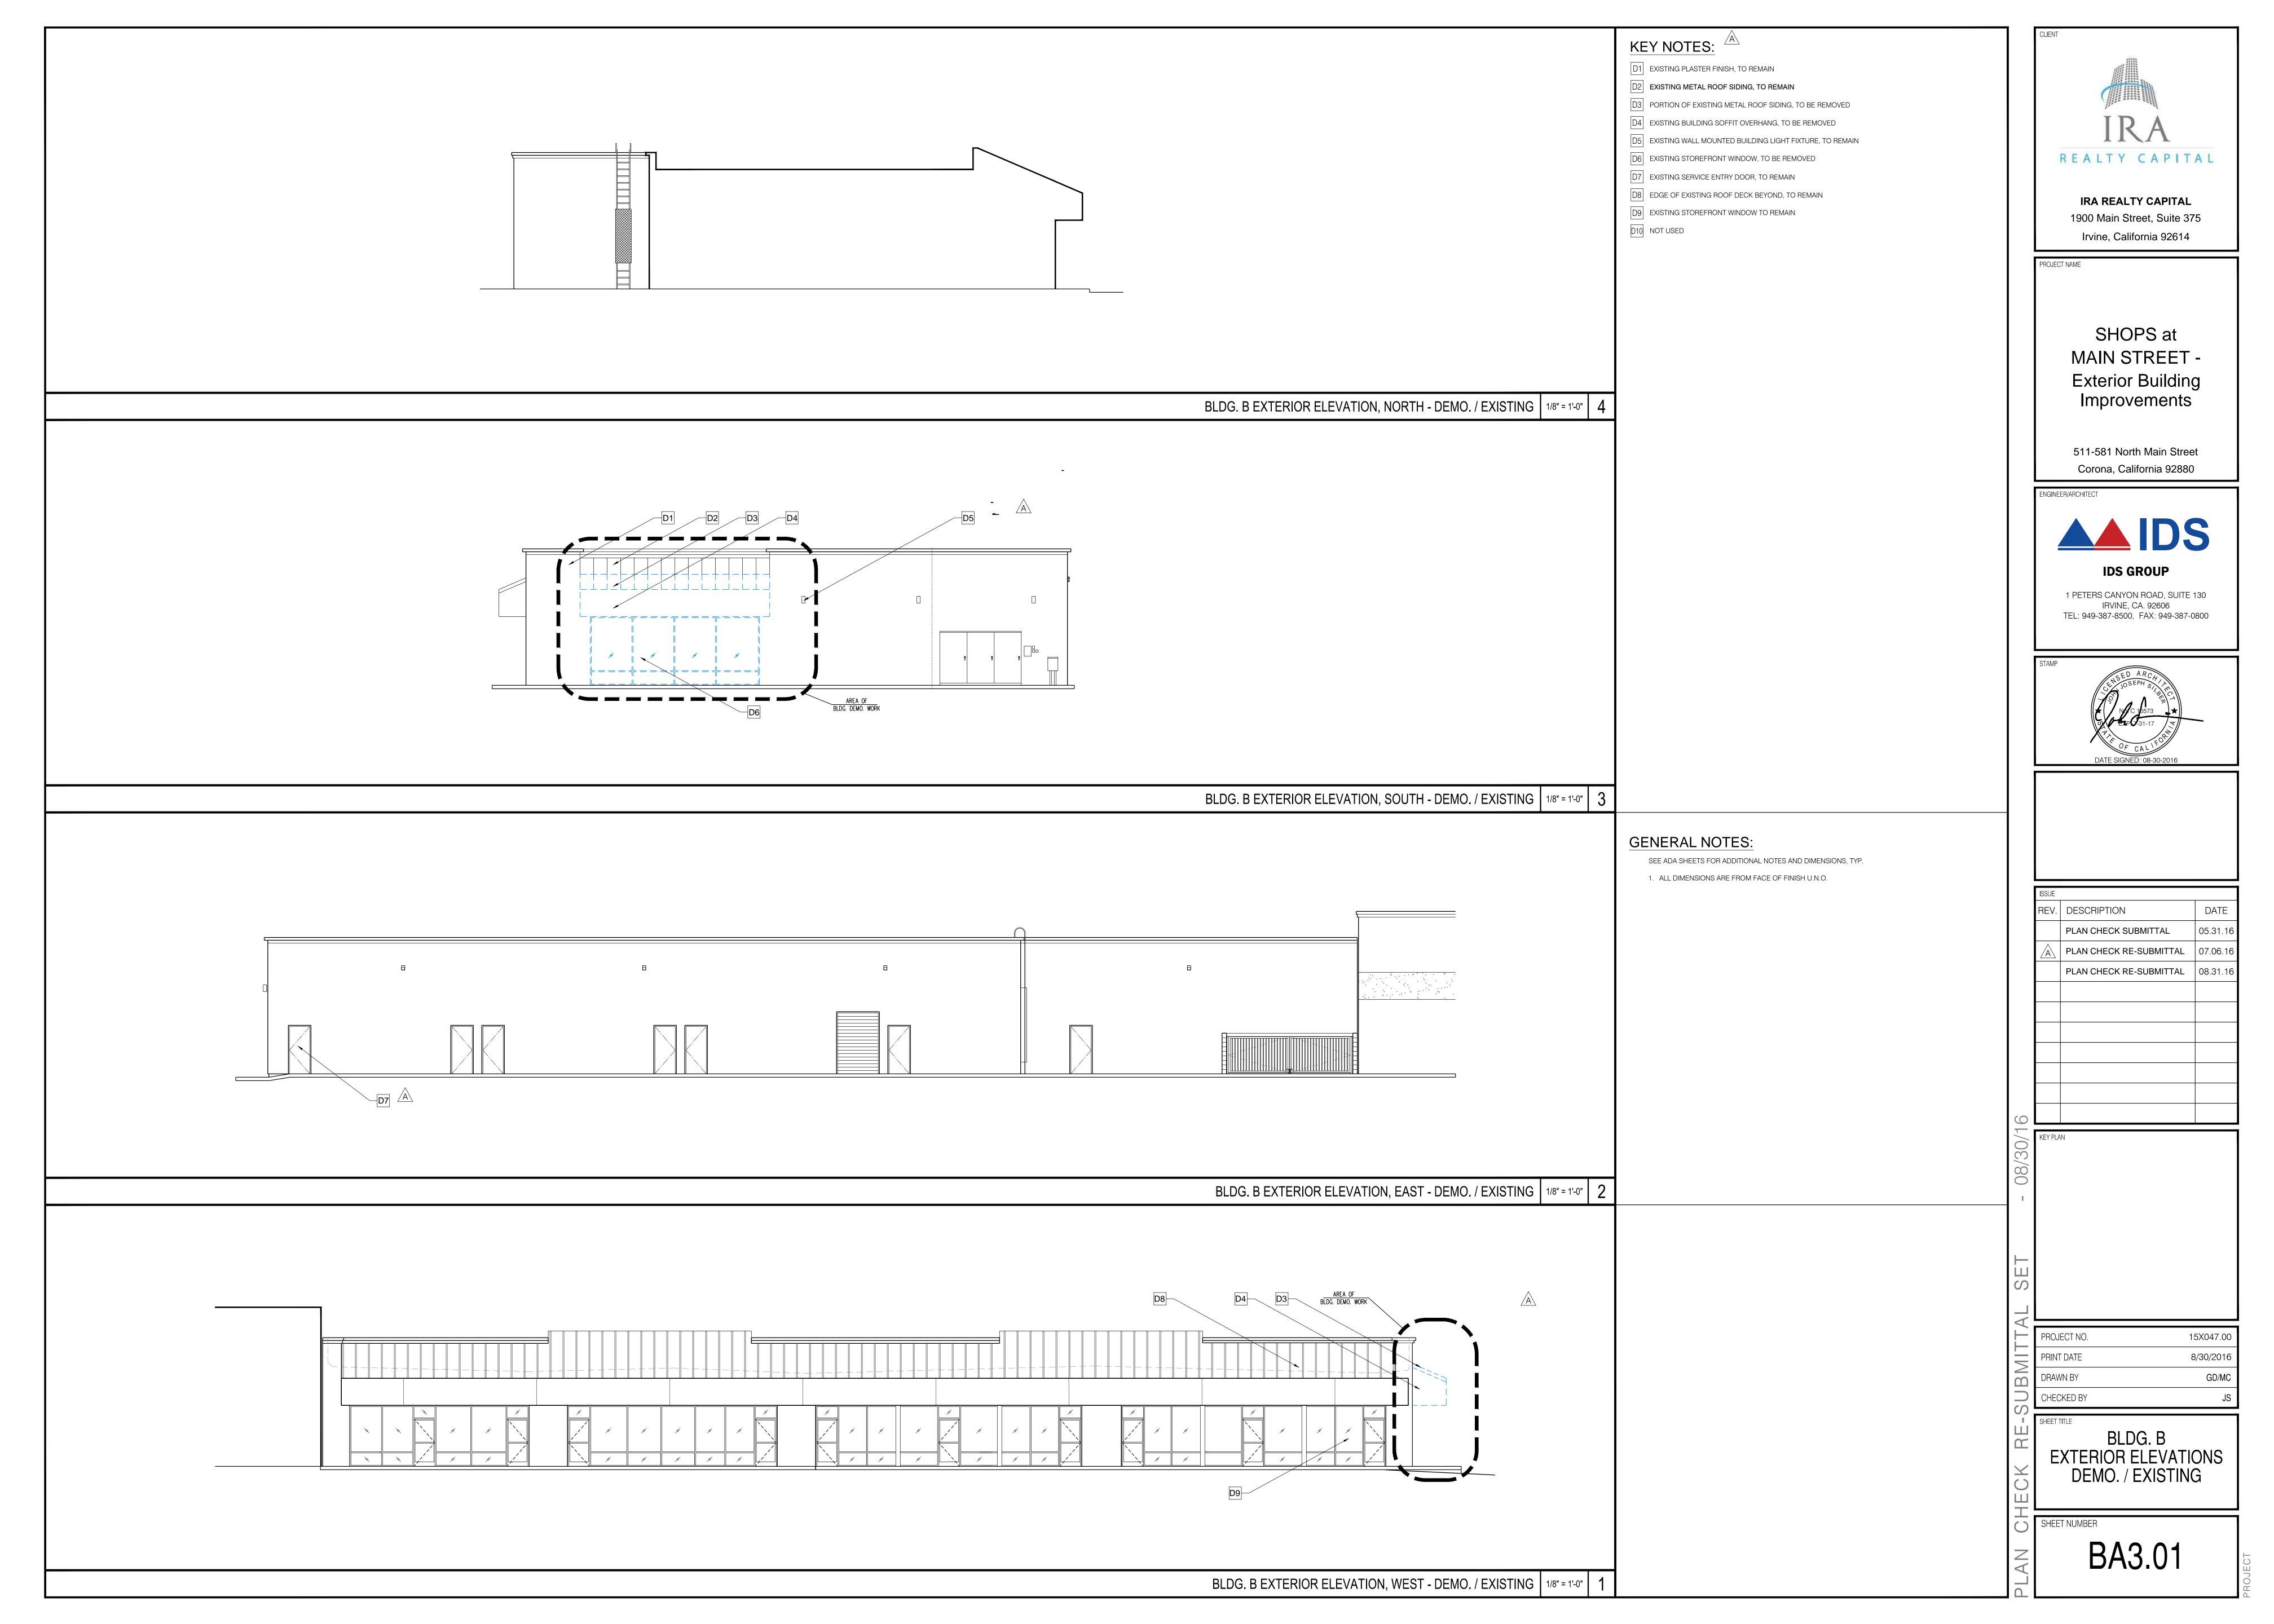

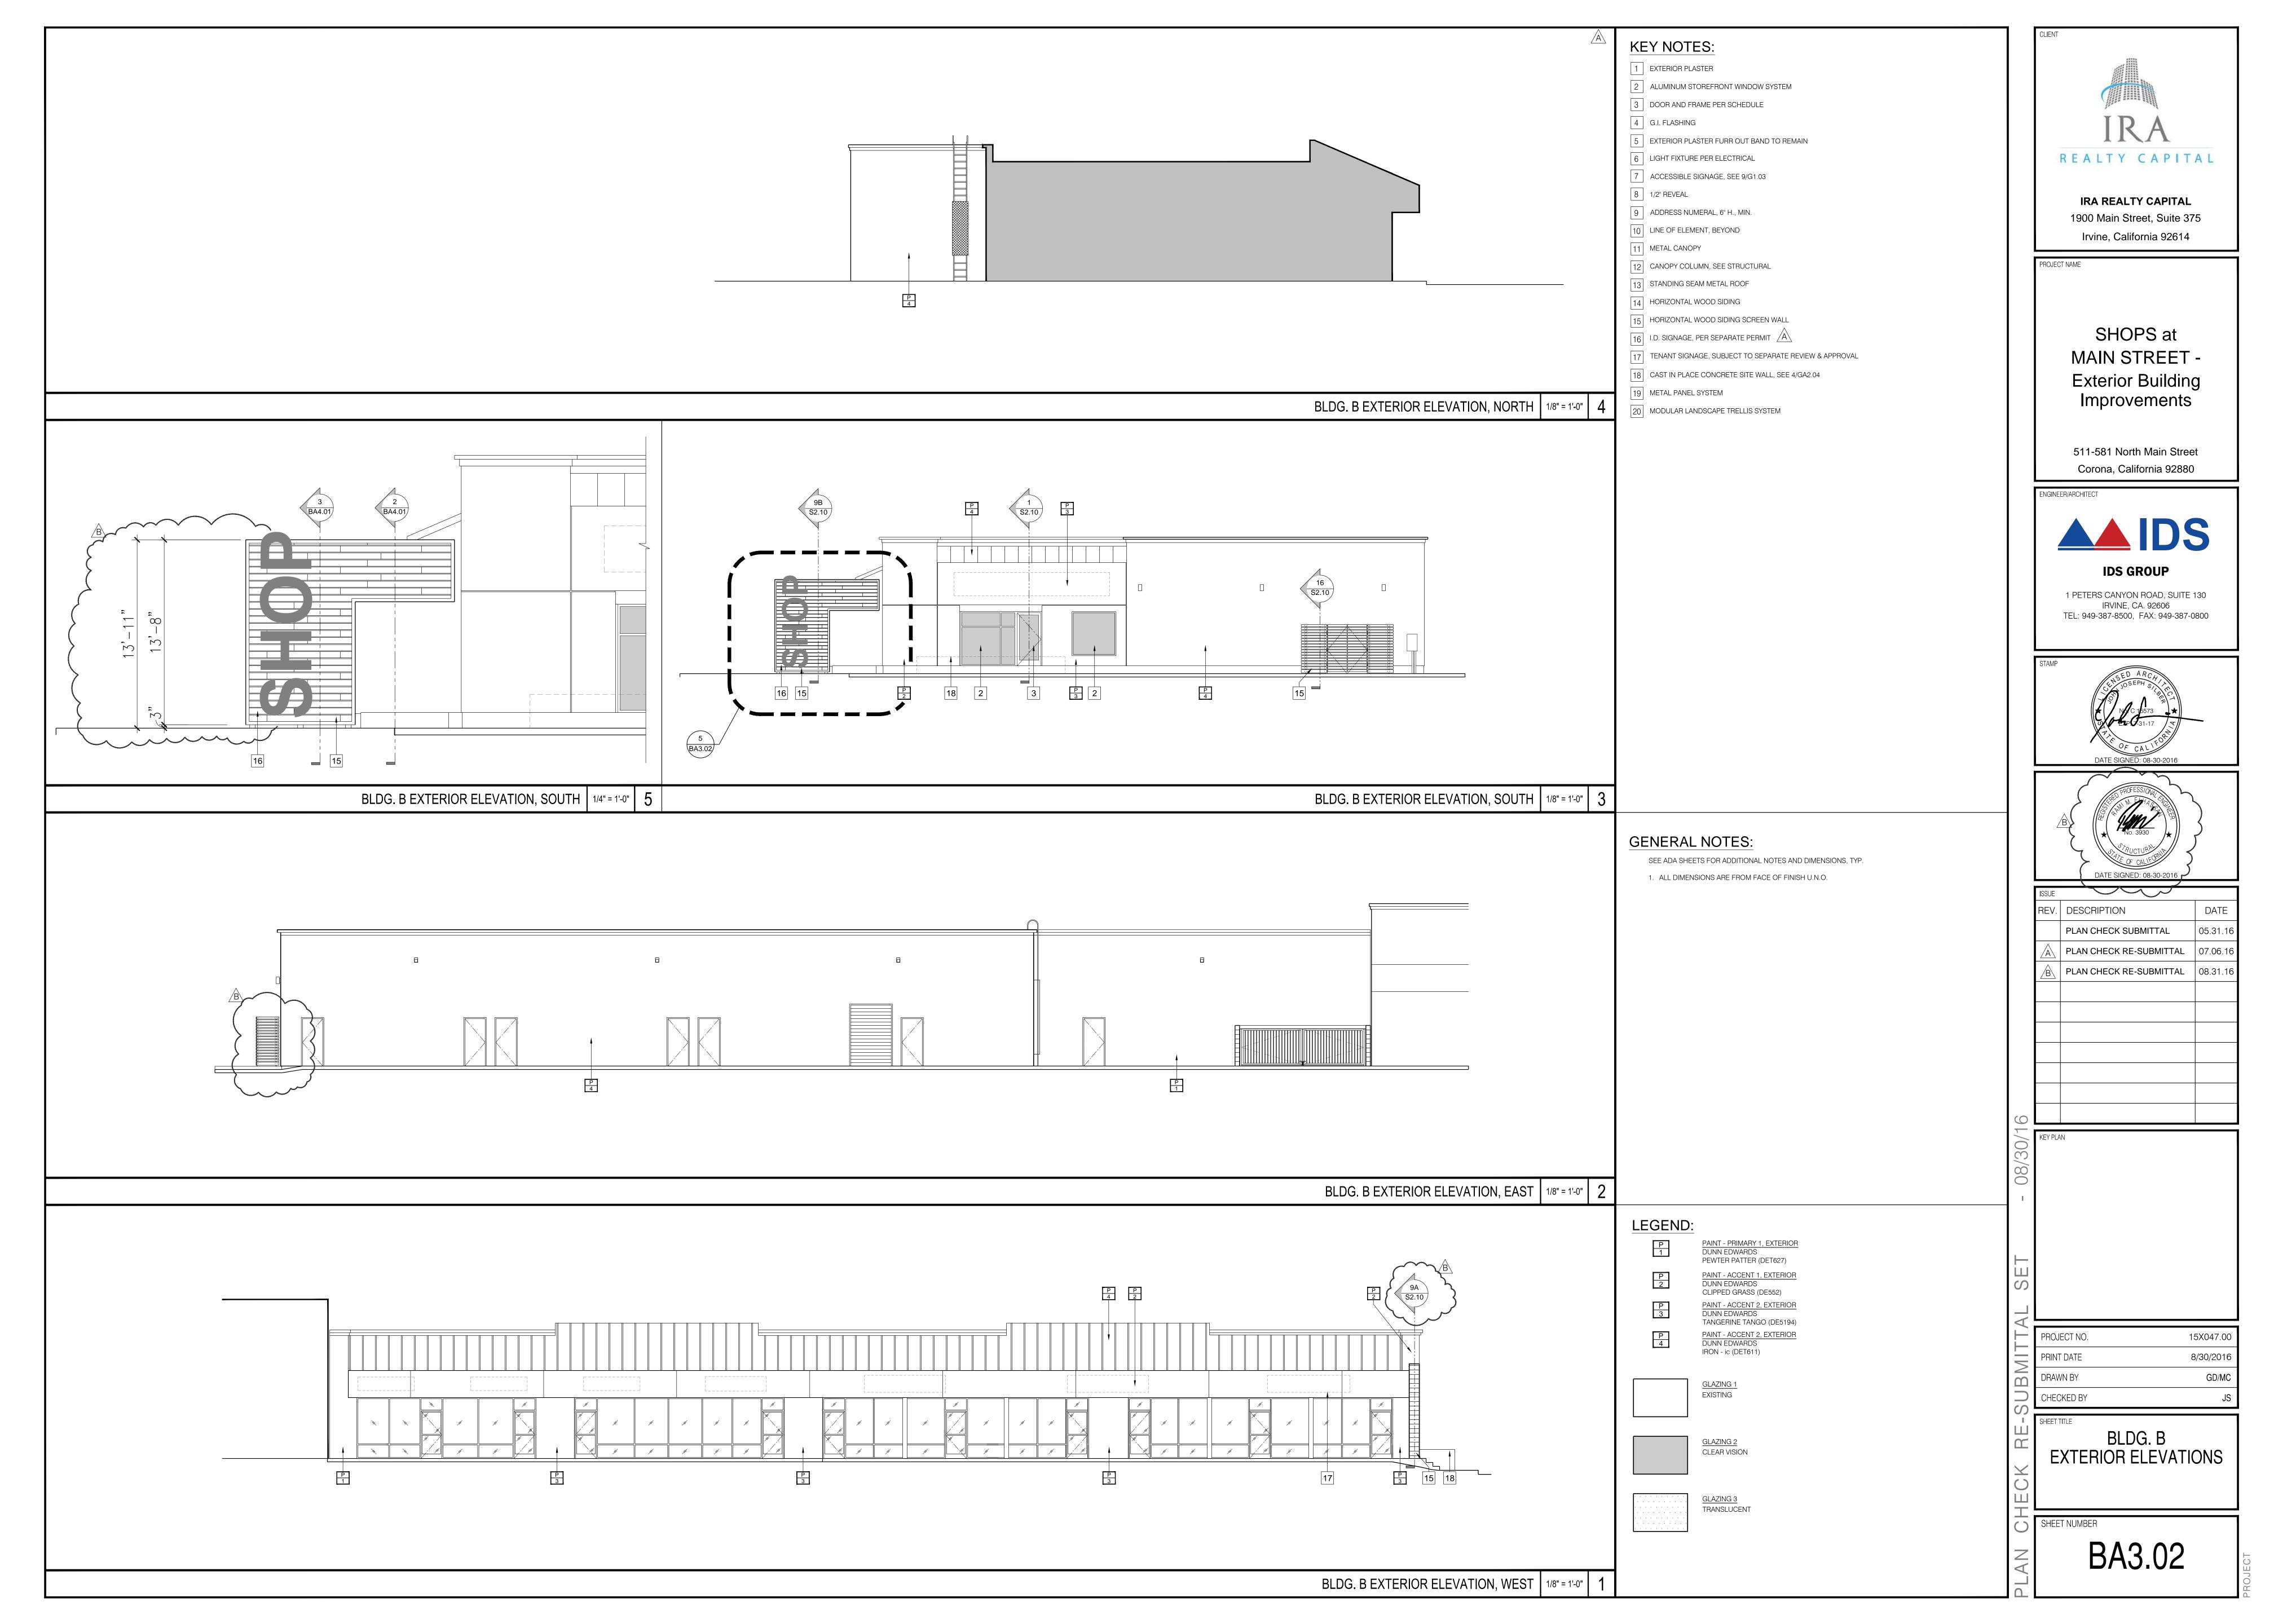

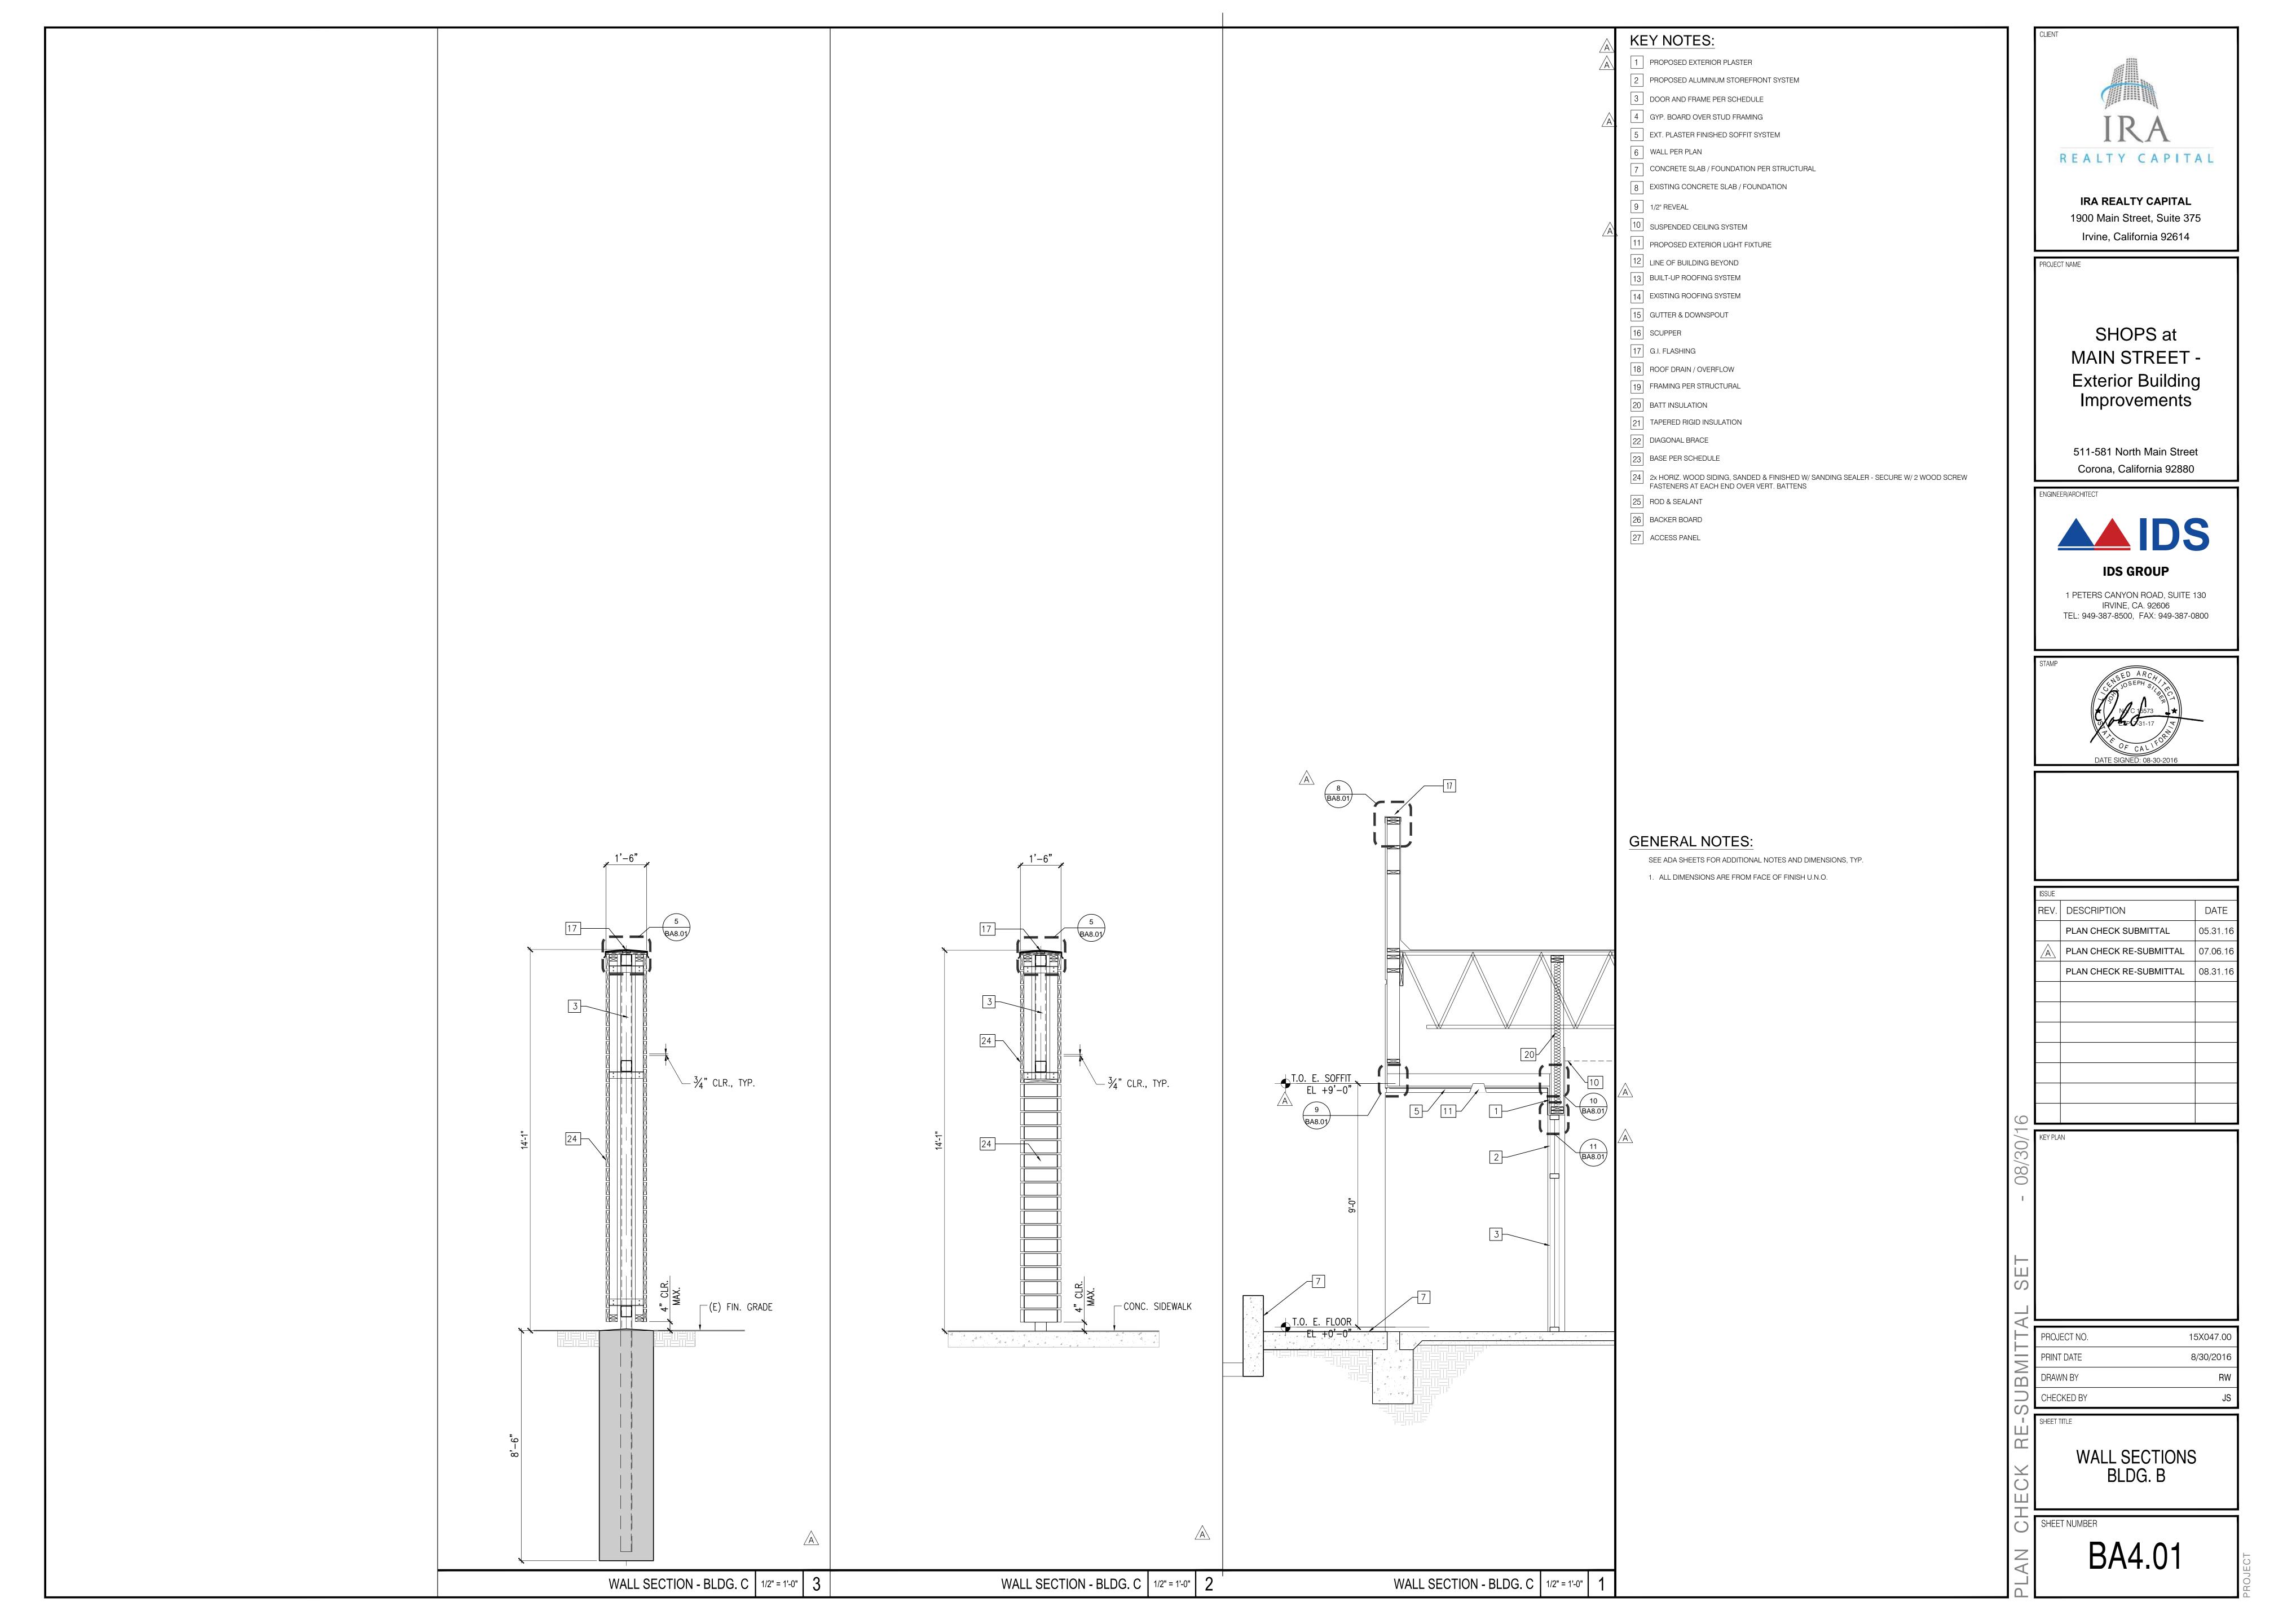

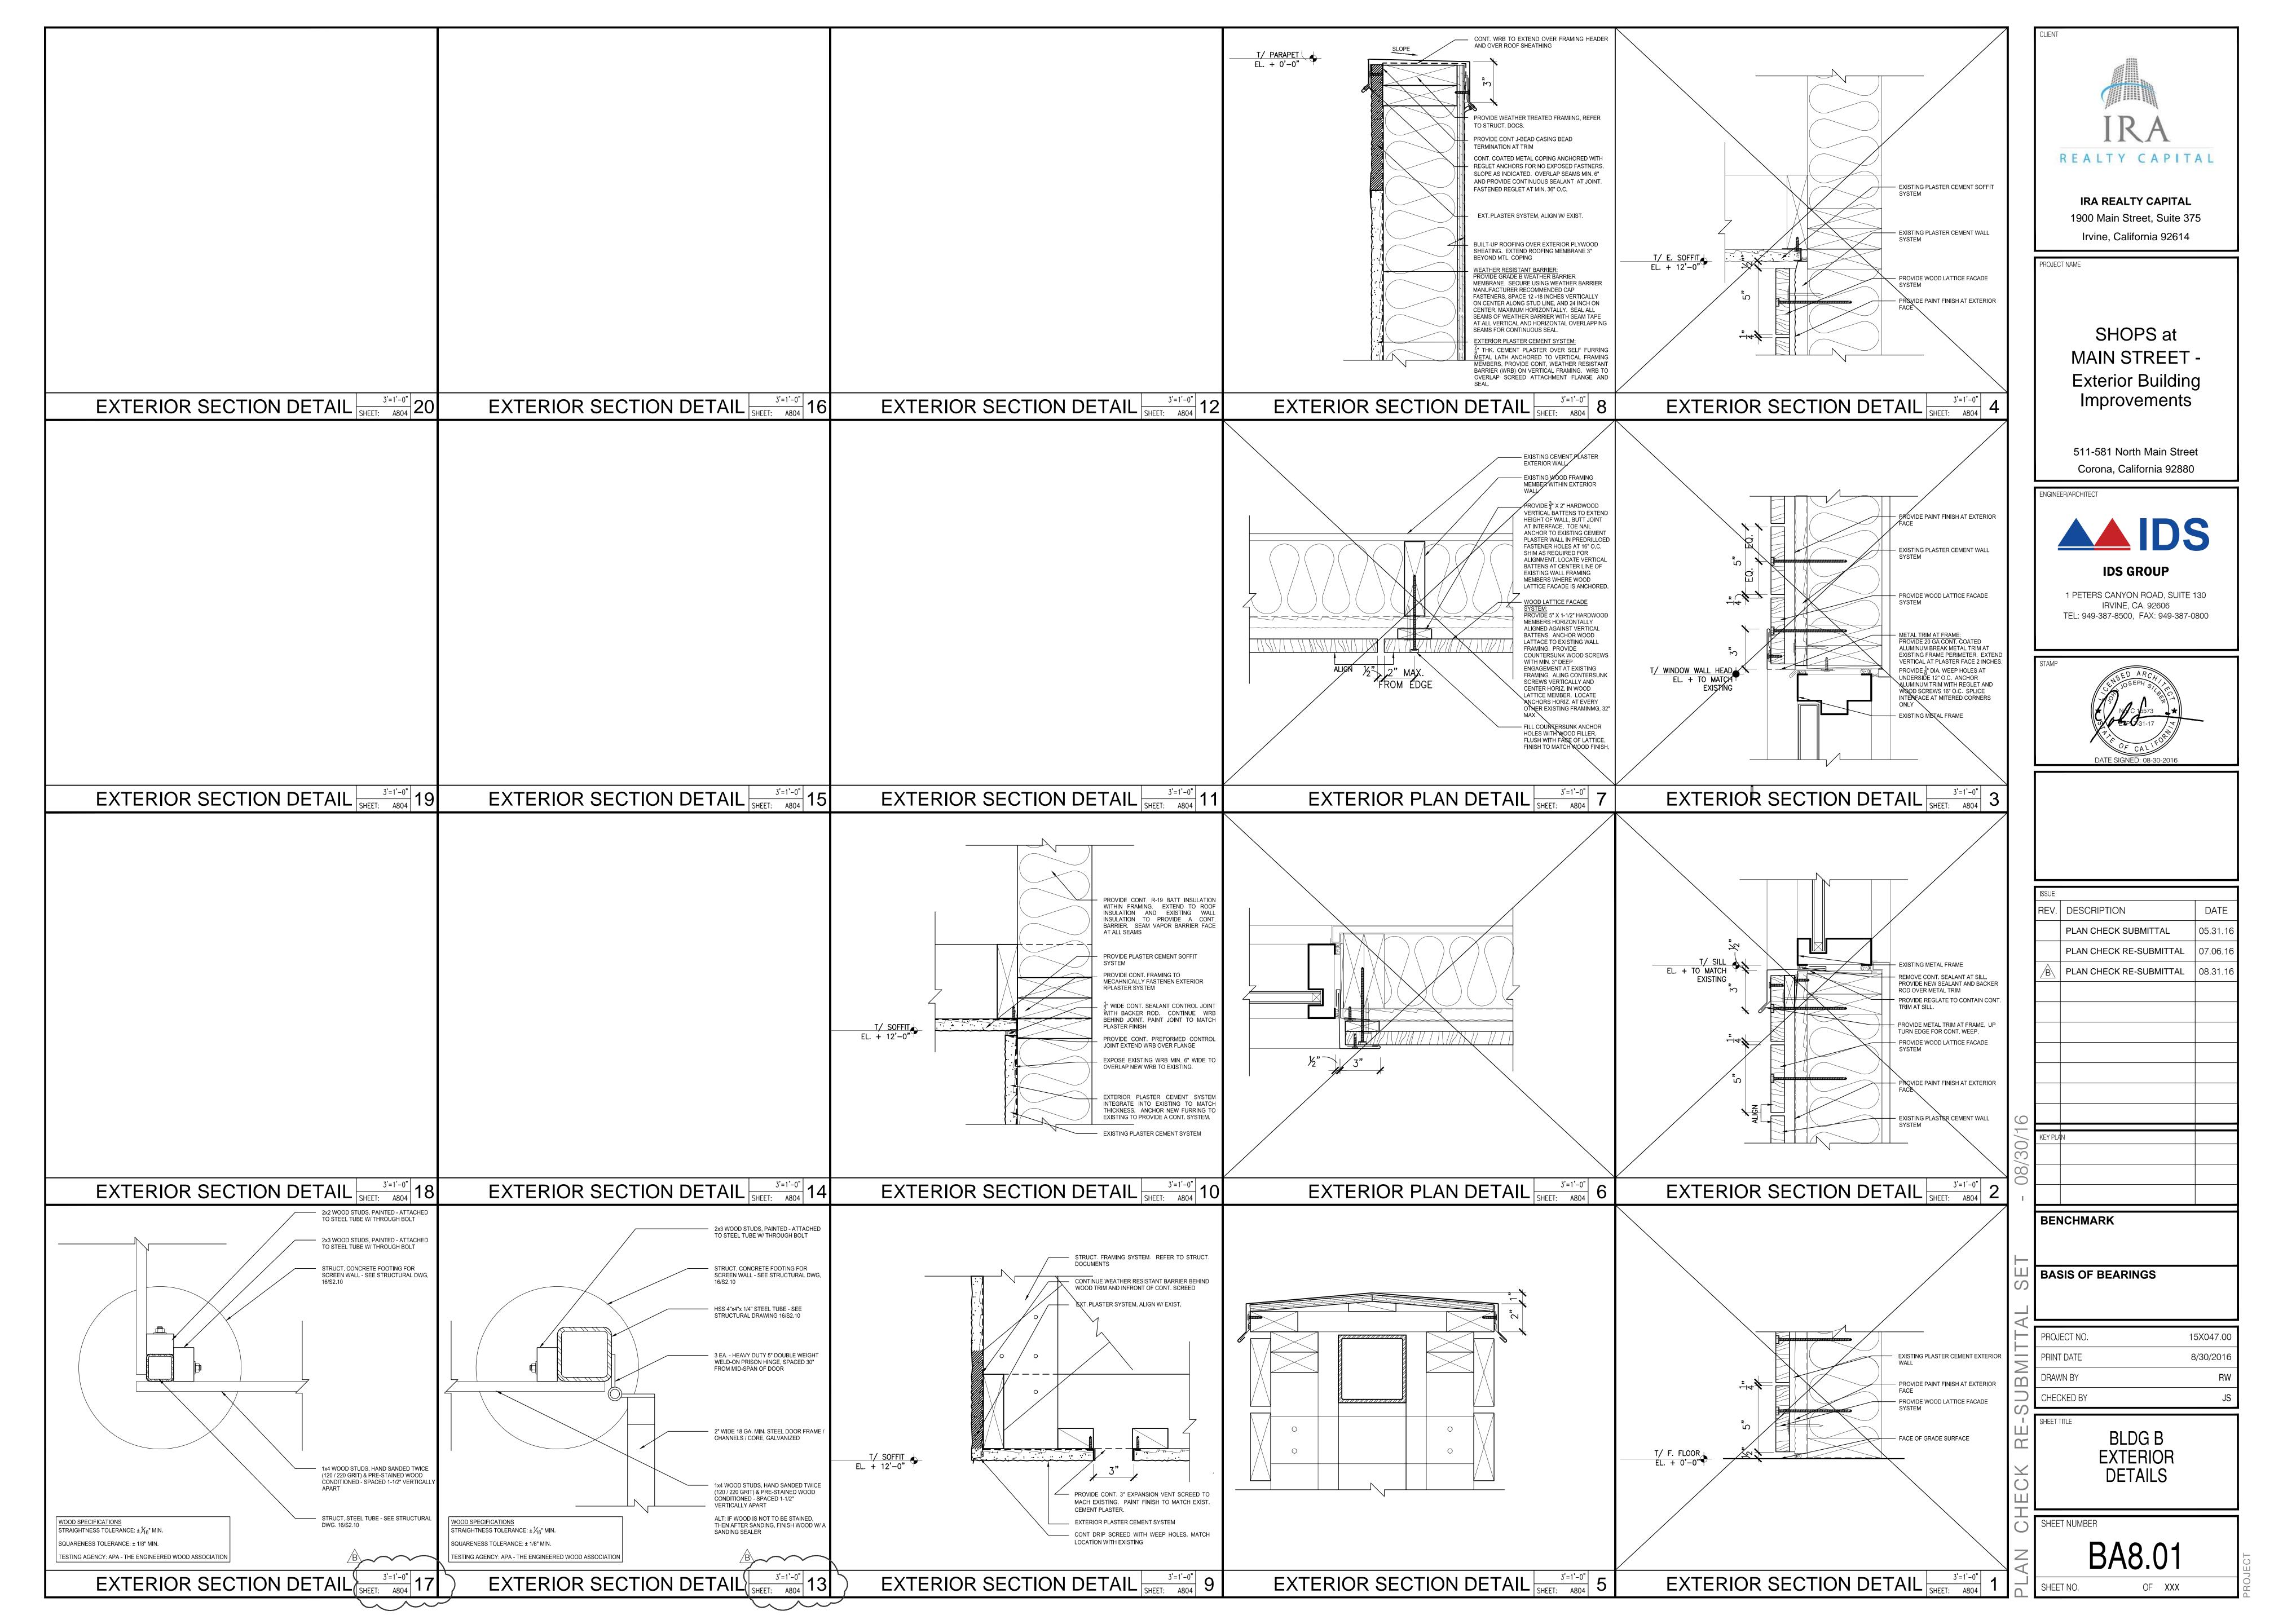

### SHORING REQUIREMENTS

- PROVIDE SHORING THAT WILL PROTECT THE EXISTING BUILDING FRAMING AND MAINTAIN THE LOCATION OF EXISTING FRAMING MEMBERS TO ALLOW THE REPAIR AND RECONSTRUCTION OF DAMAGED AND DETERIORATED
- SHORING DESIGN SHALL BE PREPARED AND STAMPED BY A CALIFORNIA LICENSED ENGINEER.
- SHORING SHALL BE COMPATIBLE WITH THE EXISTING STRUCTURAL SYSTEM.
- 4. SHORING SHALL CARRY DEAD, LIVE, AND CONSTRUCTION LOADS FROM SUPPORTED ELEMENTS DOWN TO ADEQUATE SUPPORT ON GRADE. BEARING PRESSURE AT GRADE NOT TO EXCEED 1,000 PSF. DO NOT USE EXISTING STRUCTURE TO TRANSFER SHORING LOADS.
- THE SHORING SHALL BE SOUND, RIGID AND CAPABLE OF CARRYING THE MAXIMUM INTENDED LOAD WITHOUT SETTLEMENT OR DISPLACEMENT.
- CONTRACTOR IS RESPONSIBLE FOR MONITORING ACCESS TO SHORED FRAMING TO ENSURE THAT THE LOAD LIMITS (INCLUDING WEIGHT OF PERSONNEL, AND THEIR EQUIPMENT, MATERIALS AND CONTENTS) IDENTIFIED BY THE SHORING DESIGN ARE ADHERED TO.
- WHEN TEMPORARY STORAGE OF MATERIAL, OR EQUIPMENT ON SHORED AREAS BECOMES NECESSARY SPECIAL CONSIDERATION SHALL BE GIVEN TO THESE AREAS AND THEY SHALL BE STRENGTHENED TO MEET THESE LOADS.
- PRIOR TO DEMOLITION, THE METHOD OF REPAIR SHALL BE EVALUATED TO INSURE THAT ADDITIONAL LOADS DUE TO EQUIPMENT, CUTTING, ETC., WILL NOT ADVERSELY AFFECT THE SHORING OR STRUCTURE.
- 9. SHORING DESIGN INCLUDING DRAWINGS AND CALCULATIONS SHALL BE SUBMITTED TO THE ENGINEER FOR REVIEW PRIOR TO INSTALLATION.
- 10. A COPY OF THE SHORING LAYOUT SHALL BE AVAILABLE AND USED ON THE JOB SITE AT ALL TIMES.
- 11. SHORING EQUIPMENT SHALL BE ADEQUATELY ERECTED, BRACED AND MAINTAINED SO THAT IT WILL SAFELY SUPPORT ALL VERTICAL AND LATERAL LOADS THAT MIGHT BE APPLIED, UNTIL SUCH LOADS CAN BE SUPPORTED BY THE PRIMARY STRUCTURE.
- 12. THE SHORING SETUP SHALL BE CHECKED BY THE CONTRACTOR WHO ERECTS THE SHORING EQUIPMENT TO DETERMINE THAT ALL DETAILS OF THE SHORING DESIGN INCLUDING LATERAL BRACING HAVE BEEN MET.
- 13. ERECTED SHORING EQUIPMENT AND/OR ELEMENTS SHALL BE INSPECTED BY THE CONTRACTOR IMMEDIATELY PRIOR TO ANY DEMOLITION, DURING REPAIRS, AND UNTIL STRUCTURAL FRAMING IS COMPLETE.
- 14. ANY ERECTED SHORING EQUIPMENT AND/OR ELEMENTS THAT IS DAMAGED OR WEAKENED SHALL BE IMMEDIATELY REMOVED AND REPLACED BY ADEQUATE SHORING.
- 15. SHORING AS REQUIRED ARE CONSIDERED MEANS AND METHODS OF CONSTRUCTION. SHORING DESIGN AND INSTALLATION ARE THE RESPONSIBILITY OF THE CONTRACTOR TO COMPLY WITH ALL APPLICABLE RULES AND REGULATIONS.

### REINFORCING STEEL

OTHERWISE NOTED:

- ALL CONCRETE SHALL BE REINFORCED. REINFORCING STEEL SHALL BE NEW DEFORMED STEEL BARS CONFORMING TO ASTM A615, GRADE 60 UNLESS OTHERWISE NOTED
- 2. ALL REINFORCING STEEL SHALL MEET THE FOLLOWING SPECIAL DUCTILITY REQUIREMENTS UNLESS
- A. THE ACTUAL YIELD STRENGTH SHALL NOT EXCEED THE SPECIFIED YIELD STRENGTH BY MORE THAN 18,000 PSI.
- B. THE RATIO OF THE ACTUAL ULTIMATE TENSILE STRESS TO THE ACTUAL YIELD STRENGTH SHALL NOT BE LESS THAN 1.25.
- REINFORCING STEEL CERTIFIED AS ASTM A706 MAY BE ASSUMED TO COMPLY WITH THESE REQUIREMENTS.
- D. SUBJECT TO THE ENGINEER'S WRITTEN APPROVAL, REINFORCING STEEL NOT MEETING THE SPECIAL DUCTILITY REQUIREMENTS SPECIFIED ABOVE MAY BE PERMITTED IN LOCATIONS NOT SUBJECT TO
- YIELDING UNDER SEISMIC LOAD. E. FOR BIDDING PURPOSES, ASSUME ALL ASTM-A615 STEEL MUST COMPLY WITH NOTES 2A AND 2B
- 3. REINFORCING STEEL SHALL BE FIRMLY SUPPORTED AND ACCURATELY PLACED.
- COMPLETE REINFORCING STEEL PLACEMENT DRAWINGS SHALL BE PREPARED IN ACCORDANCE WITH ACI BY THE CONTRACTOR AND REVIEWED BY THE ENGINEER AND SHALL BE AVAILABLE ON THE JOB SITE PRIOR TO PLACING OF CONCRETE.
- ANCHOR BOLTS, DOWELS AND OTHER EMBEDDED ITEMS SHALL BE SECURELY TIED IN PLACE BEFORE CONCRETE IS PLACED.
- ALL REINFORCING STEEL TO BE WELDED SHALL CONFORM TO ASTM A706, GRADE 60. DEFORMATIONS SHALL BE IN ACCORDANCE WITH ASTM A305.
- 7. ALL WELDING OF REINFORCING STEEL SHALL CONFORM TO AWS D1.4 AND SHALL BE PERFORMED BY CERTIFIED WELDERS USING AWS A5.5 E-90XX (TABLE 5.1, AWS D1.4) LOW HYDROGEN MOISTURE RESISTING ELECTRODES UNLESS OTHERWISE NOTED.
- 8. NO HEATING SHALL BE ALLOWED FOR BENDING OF REINFORCING STEEL
- 9. TYPE 2 MECHANICAL COUPLERS WITH CURRENT ICC-ES EVALUATION REPORTS MAY BE USED AT THE CONTRACTOR'S DISCRETION IN LIEU OF LAP SPLICES, WELDING OR OTHER ACCEPTABLE MEANS FOR JOINING REINFORCING STEEL PROVIDING SUCH USE DOES NOT ADVERSELY AFFECT DESIGN INTENT, CODE REQUIREMENTS OR CONSTRUCTABILITY.
- 10. ALL MECHANICAL COUPLERS SHALL BE REVIEWED BY THE ENGINEER AND INSPECTED DURING CONSTRUCTION.
- 11. ALL REINFORCING STEEL INTERRUPTED BY STRUCTURAL STEEL SHALL TERMINATE WITHIN 1" OF THE STEEL SURFACE WITH A 90° STANDARD HOOK UNLESS OTHERWISE NOTED.
- 12. ACCEPTABLE REBAR COUPLER AND ANCHORAGE DEVICES:

### WOOD

WOOD MEMBERS SHALL BE DOUGLAS FIR-LARCH PER WCLIB OR WWPA, VISUALLY GRADED DIMENSION LUMBER AND SHALL BE SURFACED DRY (19% MOISTURE CONTENT MAXIMUM). ALL LUMBER SHALL BEAR THE GRADE STAMP OF AN APPROVED TESTING AGENCY. EXCEPT EXPOSAL LUMBER AT VISIBLE AREAS. STRUCTURAL FRAMING MEMBERS SHALL BE S4S AND GRADE MARKED AS No.1.

PLYWOOD SHEATHING SHALL MEET THE REQUIREMENTS OF THE LATEST EDITION OF U.S. PRODUCT

- STANDARDS PS 1-95. STRUCTURAL USE PANELS SHALL CONFORM TO NER-108 (APA-PRP-108). EACH PANEL SHALL BE IDENTIFIED WITH THE APPROPRIATE A.P.A. GRADE STAMP.
- 3. ROOF SHEATHING SHALL BE FIVE PLY WITH THICKNESS AND PANEL INDEX AS INDICATED ON DRAWINGS. STAGGER SHEETS PER PLAN. ROOF NAILING SHALL BE PER SCHEDULE ON DRAWINGS. OR AS INDICATED ON NOTES. INSTALL SHEETS WITH FACE GRAIN ACROSS SUPPORTS EXCEPT WHERE NOTED OTHERWISE.
- 4. ROOF SHEATHING, NAILING AND INSTALLATION SHALL BE INSPECTED AND APPROVED PRIOR TO COVERING.
- 5. BOLTS SHALL CONFORM TO ASTM A307. ALL BOLTS THROUGH WOOD SHALL HAVE STANDARD WASHERS. BOLT HOLES SHALL BE BORED  $rac{1}{32}$ " TO  $rac{1}{16}$ " LARGER THAN THE BOLT DIAMETER UNLESS NOTED OTHERWISE ALL BOLTS SHALL BE TIGHTENED PRIOR TO BEING COVERED. WHERE PLATE WASHERS ARE SHOWN ON THE DRAWINGS THEY SHALL BE AS FOLLOWS:

MINIMUM SIZE FOR SQUARE PLATE WASHERS		
BOLT SIZE	PLATE SIZE	
1/2"	<sup>3</sup> ∕ <sub>16</sub> " × 2" × 2"	
5% "	1/4" × 21/2" × 21/2"	
3/4"	5/16" × 2 <sup>3</sup> /4" × 2 <sup>3</sup> /4"	
7/8"	5∕16" × 3" × 3"	
1"	3%" × 3½" × 3½"	

- NAILS SHALL BE COMMON WIRE NAILS (0.131" Øx 2 1/2" FOR 8d; 0.148" Øx 3" FOR 10d; 0.148" Øx 3 1/4"FOR 12d; 0.162"øx3-1/2" FOR 16d) OR ACCESSORIES OF HARDWARE CONNECTORS. SEE CBC FOR MINIMUM NAILING SCHEDULE AT CONNECTIONS.
- 7. HARDWARE CONNECTORS AND ACCESSORIES SHALL BE SIMPSON STRONG-TIE CONNECTORS OR APPROVED
- 8. PLYWOOD NAILING SHALL HAVE A MINIMUM EDGE DISTANCE OF 3/8". NAIL HEADS SHALL BE FLUSH WITH TOP SURFACE OF PLYWOOD; SINKING NAIL HEADS IS PROHIBITED.

9. LAG SCREWS SHALL BE SCREWED, NOT DRIVEN, INTO WOOD MEMBER WITH PRE-DRILLED HOLES. PILOT

- HOLES: MATCH DIAMETER AND DEPTH PF SHANK; 75% OF THREADED PORTION. 10. ALL LUMDER IN DIRECT CONTACT WITH CONCRETE, MASONRY, OR EARTH, SHALL BE PRESSURE TREATED WOOD OR APPROVED EQUAL. PRESSURE TREATED WOOD SHALL BE TREATED WITH ALKALINE COPPER QUAT
- 11. ALL LUMBER EXPOSED TO WEATHER SHALL BE PRESSURE TREATED LUMBER..

(ACQ-C AND ACQ-D), CARBONATE AZOLE (CBA-A), OR COPPER AZOLE (CA-B).

- 12. SOLID BLOCKING SHALL BE PLACED BETWEEN JOISTS AT POINTS OF SUPPORT AND POINTS WHERE SHEATHING IS DISCONTINUOUS.
- 13. WOOD MEMBER WITH WANE SHALL NOT BE LOCATED AT PLYWOOD JOINT.
- 14. NO STRUCTURAL MEMBER SHALL BE CUT WITHOUT THE APPROVAL OF THE STRUCTURAL ENGINEER.
- 15. HARDWARE CONNECTING WOOD MEMBERS SHALL BE RECESSED WHEN REQUIRED BY ARCHITECTURAL FINISH. VERIFY WITH ARCHITECTURAL DRAWINGS.
- 16. 0.229"x2"x2" STEEL PLATE WASHERS (OR SIMPSON BP) SHALL BE USED FOR ALL SILL PLATE ANCHOR BOLTS AND HOLDOWN CONNECTOR BOLTS UNLESS OTHERWISE NOTED. SIMPSON BP SHALL BE PROTECTED WITH ZMAX (G185) COATING.
- 17. ALL BOLTS SHALL BE RE-TIGHTENED JUST PRIOR TO BEING COVERED.
- 18. BOLT HOLES AT WOOD MEMBERS SHALL NOT BE MORE THAN 1/16" LARGER THAN THE BOLT DIAMETER.
- 19. ALL HARDWARE AND FASTENERS SHALL BE ZINC- COATED. ALL NAILS INTO TREATED SILL PLATES SHALL BE HOT-DIPPED ZINC-COATED GALVANIZED OR SIMPSON ZMAX (G185) COATED NAILS.
- 20. SOLID BLOCKING OR EQUIVALENT CROSS-BRIDGING SHALL BE INSTALLED BETWEEN ALL ROOF JOISTS AT THE SPACING PER CODE.
- 21. FIRE BLOCKING SHALL BE INSTALLED BETWEEN ALL WALL STUDS IF REQUIRED BY CODE.

### **MISCELLANEOUS STEEL**

- 1. THE CONTRACTOR SHALL SUBMIT ALL STRUCTURAL STEEL AND MISCELLANEOUS STEEL SHOP DRAWINGS TO THE ENGINEER FOR REVIEW PRIOR TO FABRICATION.
- . MATERIAL TEST OR REPORTS FOR HOT-ROLLED STRUCTURAL SHAPES, PLATES, AND BARS SHALL BE MADE IN ACCORDANCE WITH ASTM A6. FOR SHEET MATERIAL, TEST SHALL BE MADE IN ACCORDANCE WITH ASTM A568. FOR TUBING AND PIPE, SUCH TEST SHALL BE MADE IN ACCORDANCE WITH REQUIREMENTS OF THE APPLICABLE ASTM STANDARDS.
- . STEEL MATERIALS SHALL CONFORM TO THE FOLLOWING, UNLESS OTHERWISE NOTED:
- A. ANGLES, PLATES AND BARS: ASTM A36 (Fy=36ksi, Fu=58ksi) B. RECTANGULAR AND SQUARE HSS: ASTM A1085 (Fy=50ksi, Fu=65ksi)
- C. ROUND HSS: ASTM A1085 (Fy=50ksi, Fu=65ksi)
- D. PIPES: ASTM A53, GRADE B (Fy=35ksi, Fu=60ksi)
- BOLTS AT OTHER APPLICATIONS: ASTM A307 ANCHOR RODS: ASTM F1554, GRADE 36, U.N.O.
- G. THREADED RODS: ASTM A36
- H. NUTS: ASTM A563 I. WASHERS: ASTM F436
- ALL WELDING OF STEEL SHALL CONFORM TO AWS D1.1 AND SHALL BE PERFORMED BY AWS CERTIFIED WELDERS USING E-70XX LOW HYDROGEN MOISTURE RESISTING ELECTRODES UNLESS OTHERWISE NOTED.
- 4. USE THE MINIMUM SIZE OF WELDS IN ACCORDANCE WITH AISC MANUAL OF STEEL CONSTRUCTION AT STEEL TO STEEL JOINTS UNLESS A LARGER WELDING SIZE IS SPECIFIED ON THE PLANS
- 6. ALL STEEL (EXCEPT STAINLESS STEEL) SHALL BE SHOP PRIMED WITH ZINC OXIDE PRIMER UNLESS OTHERWISE NOTED.
- 7. PAINT ALL STRUCTURAL STEEL WITH WEATHER/RUST RESISTANT PAINT UNLESS OTHERWISE NOTED.
- 8. DIAMETER OF BOLT HOLE SHALL BE 1/16" LARGER THAN THE BOLT'S DIAMETER UNLESS OTHERWISE
- 9. IF DRILLING HOLES AT STEEL MEMBERS TO ACCOMMODATE THE CONCRETE OR MASONRY ANCHORS IS REQUIRED, THE DRILLING MUST BE DONE AFTER THE ANCHORS HAVE BEEN INSTALLED. THE HOLES AT STEEL MEMBERS SHALL MATCH THE LOCATION OF INSTALLED ANCHORS
- 10. PROVIDE BEVELED WASHERS ON SLOPING SURFACE OF CONNECTIONS FOR FULL BEARING.
- 11. WHERE LENGTH OF WELDING IS NOT SHOWN, IT SHALL BE FULL LENGTH OF JOINT. ALL BUTT WELDS SHALL BE COMPLETE PENETRATION WELDS UNLESS OTHERWISE NOTED.
- 12. MINIMUM BOLT SPACING FROM CENTER OF STANDARD AISC HOLE AS FOLLOWS, U.N.O.: CENTER-TO-CENTER = 3 BOLT DIAMETER CENTER-TO-ROLLED EDGE = 1.5 BOLT DIAMETER CENTER-TO-SHEARED EDGE = 1.75 BOLT DIAMETER
- 13. GALVANIZE ALL STEEL EXPOSED TO WEATHER, UNLESS OTHERWISE NOTED.
- 14. UNDER NO CIRCUMSTANCES SHALL DRAWINGS BE SCALED OR REFERENCE ELECTRONIC BUILDING INFORMATION BE USED TO DETERMINE ELEVATIONS OR DIMENSIONS.

### CAST-IN-PLACE CONCRETE

- PORTLAND CEMENT SHALL BE TYPE II UNLESS OTHERWISE NOTED
- 2. ALL CONCRETE SHALL BE NORMAL WEIGHT (145 PCF) HARD ROCK TYPE UNLESS OTHERWISE NOTED AS LIGHTWEIGHT CONCRETE (115 PCF MAX.)
- CONCRETE SHALL HAVE A MINIMUM COMPRESSIVE STRENGTH (f'c) AT 28 DAYS AS FOLLOWS, UNLESS OTHERWISE NOTED: A. ALL CONCRETE: 4,000 PSI
- CONCRETE MIXES SHALL BE DESIGNED BY A QUALIFIED TESTING LABORATORY, BEARING A REGISTERED CIVIL ENGINEER'S STAMP, AND REVIEWED BY THE ENGINEER PRIOR TO USE.
- MAXIMUM RATIO OF WATER TO CEMENTITIOUS MATERIALS, BY WEIGHT, SHALL BE 0.45 UNLESS OTHERWISE NOTED. USE MINIMUM 6 SACKS OF CEMENT PER CUBIC YARD OF CONCRETE.
- CONCRETE COVERAGE OF REINFORCING STEEL SHALL BE AS FOLLOWS, UNLESS OTHERWISE NOTED: A. CONCRETE CAST AGAINST AND PERMANENTLY EXPOSED TO EARTH: 3"
- B. CONCRETE EXPOSED TO EARTH OR WEATHER:
- \* #6 THROUGH #18 REBAR: 2"
- \* #5 REBAR, W31 OR D31 WIRE, AND SMALLER: 1.5" C. CONCRETE NOT EXPOSED TO WEATHER OR IN CONTACT WITH GROUND:
- \* SLABS: 3/4"
- 7. ALL EXPOSED CONCRETE EDGES SHALL BE FORMED WITH A 3/4" CHAMFER UNLESS OTHERWISE NOTED.
- ALL NEW CONCRETE PLACED AGAINST HARDENED CONCRETE SHALL BE PREPARED PER THE FOLLOWING PROCEDURE:
- A. ROUGHEN HARDENED SURFACE TO AN AMPLITUDE OF 1/4" WITH BUSH HAMMER, SAND BLASTING, OR OTHER APPROVED METHOD.
- B. CLEAN SURFACES OF DUST AND DEBRIS USING CLEAN COMPRESSED AIR AND WATER.
- C. SURFACE SHALL BE WETTED AND STANDING WATER REMOVED.
- D. REFER TO OTHER NOTES FOR DUST CONTROL DURING CONSTRUCTION.
- 9. CURING COMPOUND USED ON CONCRETE SHALL BE REVIEWED BY THE ENGINEER.
- 10. BONDING AGENT SHALL BE CHEMREX CONCRESIVE LIQUID LPL, OR SIKA ARMATEC 110 EPOCEM, OR APPROVED EQUAL AND SHALL BE APPLIED FOLLOWING THE MANUFACTURER'S RECOMMENDATIONS.
- 11. THE NOMINAL MAXIMUM SIZE OF COARSE AGGREGATES SHALL BE 1" UNLESS OTHERWISE NOTED.
- 12. ALL CRACKS WIDER THAN 1/64" IN NEW CONCRETE APPEARING WITHIN 6 MONTHS OF CONCRETE PLACEMENT SHALL BE REPAIRED USING EPOXY ADHESIVE INJECTION BY THE CONTRACTOR AT NO COST TO

### **GENERAL**

- 1. THE SCOPE OF WORK FOR THIS PROJECT CONSISTS OF:
- A. EXTERIOR MODIFICATIONS TO THREE COMMERCIAL ONE STORY TYPE V STRUCTURES.

LATERAL ANALYSIS DUE TO SEISMIC AND/OR WIND LOADS ON THE OVERALL STRUCTURE IS EXCLUDED FROM

- 2. THE CONTRACTOR SHALL BE RESPONSIBLE FOR THE SAFETY OF WORK AREA DURING CONSTRUCTION PERIOD. THE CONTRACTOR SHALL PROTECT ADJACENT PROPERTY AND UTILITIES IN ACCORDANCE WITH ALL NATIONAL, STATE, AND LOCAL SAFETY ORDINANCES
- 3. DRAWINGS INDICATE GENERAL AND TYPICAL DETAILS OF CONSTRUCTION. WHERE CONDITIONS ARE NOT SPECIFICALLY INDICATED BUT ARE OF SIMILAR CHARACTER TO DETAILS SHOWN, SIMILAR DETAILS OF CONSTRUCTION SHALL BE USED SUBJECT TO PRIOR REVIEW BY THE ENGINEER
- 4. THE CONTRACTOR SHALL SUPERVISE AND DIRECT THE WORK, AND SHALL BE SOLELY RESPONSIBLE FOR ALL CONSTRUCTION MEANS, METHODS, TECHNIQUES, SEQUENCES AND PROCEDURES. THE SUPPORTING SERVICES BY THE ENGINEER, WHETHER PERFORMED PRIOR TO, DURING, OR AFTER CONSTRUCTION, ARE PERFORMED SOLELY FOR THE PURPOSE OF ASSISTING IN QUALITY CONTROL AND IN ACHIEVING CONFORMANCE WITH CONTRACT DRAWINGS AND PROJECT SPECIFICATIONS; BUT THEY DO NOT GUARANTEE THE CONTRACTOR'S PERFORMANCE AND SHALL NOT BE CONSIDERED AS SUPERVISION OF CONSTRUCTION.
- SHOP DRAWINGS REQUIRED SHALL BE SUBMITTED TO THE ENGINEER FOR REVIEW PRIOR TO FABRICATION. DRAWINGS ARE REVIEWED BY THE ENGINEER FOR GENERAL CONFORMANCE TO THE DESIGN. REGARDLESS OF THE ENGINEER'S REVIEW, THE CONTRACTOR IS FULLY AND SOLELY RESPONSIBLE FOR COMPLETE AND SATISFACTORY SUBMITTAL AND CONFORMANCE TO THE CONTRACT DOCUMENTS. SHOP DRAWINGS WILL BE REJECTED FOR INCOMPLETENESS, LACK OF CALCULATIONS (IF REQUIRED) OR CHANGES WITHOUT PRE-APPROVAL. ALL STRUCTURAL CALCULATIONS AND DRAWINGS AS PART OF THE SHOP DRAWINGS SUBMITTAL SHALL BE SIGNED AND STAMPED BY A CALIFORNIA REGISTERED ENGINEER.
- 6. ANY PARTS OF WORK ARFA WHICH ARF TO BE BARRICADED OR SEALED TO NON-CONSTRUCTION. INDIVIDUALS MUST BE COORDINATED WITH AND APPROVED BY THE OWNER BEFORE PROCEEDING WITH THE WORK.
- THE CONTRACTOR SHALL EXERT EVERY EFFORT TO PREVENT DUST AND CONSTRUCTION DEBRIS FROM CONTAMINATING THE WORK AREA. THESE EFFORTS SHALL INCLUDE BUT NOT BE LIMITED TO PROVIDING A DAILY CLEANUP OF THE CONSTRUCTION AREA. THE CONTRACTOR SHALL REFER TO THE PROJECT SPECIFICATIONS FOR ADDITIONAL REQUIREMENTS.
- 8. THE CONTRACTOR SHALL EXERT EVERY EFFORT TO MINIMIZE THE CONSTRUCTION NOISE AND DISTURBANCE DURING CONSTRUCTION.
- 9. THE CONTRACTOR SHALL BE RESPONSIBLE TO SECURE THE CONSTRUCTION SITE.
- 10. CUTTING, BORING, SAW-CUTTING OR DRILLING THROUGH STRUCTURAL MEMBERS OTHER THAN THOSE DETAILED ON STRUCTURAL DRAWINGS SHALL NOT BE DONE WITHOUT THE ENGINEER'S APPROVAL.
- 11. THE CONTRACTOR SHALL:
- A. CHECK ALL DIMENSIONS
- B. BE RESPONSIBLE FOR COORDINATING THE WORK OF ALL TRADES. ALL DISCREPANCIES SHALL BE CALLED TO THE ATTENTION OF THE ENGINEER AND SHALL BE RESOLVED BEFORE PROCEEDING WITH THE WORK.
- 12. ALL MATERIALS, FEATURES OR CONDITIONS NOT IDENTIFIED AS (E) WHICH MEANS "EXISTING," SHALL BE CONSIDERED AS NEW AND PART OF THE PROJECT SCOPE OF WORK.
- 13. THE CONTRACTOR IS FULLY AND SOLELY RESPONSIBLE FOR ALL SHORING REQUIRED IN ORDER TO SAFELY ACHIEVE THE FINAL CONSTRUCTION SHOWN ON THE DRAWINGS. THIS INCLUDES, BUT IS NOT LIMITED TO. ANY TYPES OF SHORING REQUIRED FOR SOILS EXCAVATION AND BACKFILL WORK; SUPPORT OF STRUCTURAL ELEMENTS UNTIL THEY HAVE ACHIEVED THE NECESSARY STRENGTH TO PERFORM IN THE FINAL POSITION AND MANNER SHOWN ON THE DRAWINGS; AND SUPPORT OF STRUCTURAL ELEMENTS THAT ARE MODIFIED AND THEREBY REDUCED IN STRENGTH IN ANY WAY DURING CONSTRUCTION AS REQUIRED TO ACHIEVE THE FINAL CONSTRUCTION AS SHOWN ON THE DRAWINGS. ALL SHORING CALCULATIONS AND DRAWINGS SHALL BE STAMPED BY A CALIFORNIA REGISTERED ENGINEER AND SUBMITTED FOR REVIEW PRIOR TO PERFORMING THE
- 14. WHERE NOT INDICATED OTHERWISE, THE LATEST EDITION OF ALL CITED DOCUMENTS SHALL GOVERN.
- 15. THE TERM CBC IN THESE DRAWINGS MEANS 2013 CALIFORNIA BUILDING CODE, CALIFORNIA CODE OF REGULATIONS, TITLE 24, ALL PARTS AND VOLUMES.
- 16. ALL CONSTRUCTION AND WORKMANSHIP, INCLUDING MATERIALS, SHALL CONFORM TO THESE DRAWINGS, PROJECT SPECIFICATIONS, AND THE CBC.
- 17. PROVIDE ALL MEASURES NECESSARY TO PROTECT THE STRUCTURE AND ADJACENT STRUCTURE, AND THEIR FINISHES AND UTILITIES. DURING CONSTRUCTION.
- 18. THE CONTRACTOR SHALL COORDINATE ALL UTILITY LOCATIONS WITH OTHER DRAWINGS AND SHALL CONDUCT A DETAILED SURVEY OF EXISTING UTILITIES TO IDENTIFY INTERFERENCES WITH THE NEW CONSTRUCTION. PROMPTLY NOTIFY THE ARCHITECT OF ANY INTERFERENCES PRIOR TO PERFORMING THE WORK.
- 19. PROVIDE TWO COATS OF PAINT, COLOR AS DIRECTED BY OWNER,

20 PSF

## **DESIGN CRITERIA**

DESIGN CONFORMS TO CBC.

1. LIVE LOADS:

A. ROOF: 2. DEAD LOADS:

- A. SELF WEIGHT 3. WIND ANALYSIS: WIND LOADS ARE BASED ON ASCE 7-10 SECTION 29.4 WITH THE FOLLOWING
- V = 110 MPH (85 MPH ASD)
- Kz = 0.85
- Kzt = 1.0Kd = 0.85

G = 0.85

Cf = 1.42

DESIGN WIND PRESSURE AND FORCES ON COMPONENTS AND CLADDING SHALL BE DETERMINED IN ACCORDANCE WITH CBC SECTION 1609A BY THE CALIFORNIA STATE

REGISTERED PROFESSIONAL ENGINEER WHO IS RESPONSIBLE FOR THE DESIGN OF SUCH

ELEMENTS, UNLESS NOTED OTHERWISE ON THE DRAWINGS. 4. SEISMIC ANALYSIS: EQUIVALENT LATERAL FORCE PROCEDURE

SITE CLASS D SEISMIC DESIGN CATEGORY D

 $S_s = 1.871 \text{ g}$  $S_1 = 0.725 q$ 

 $F_0 = 1.0$  $F_{V} = 1.5$  $S_{DS} = 1.247 \text{ q}$ 

 $S_{D1} = 0.725 g$ 

EXTERIOR NON-STRUCTURAL ELEMENT

I = 1.0R = 2.5

 $a_{\rm D} = 1.0$ 

**TOLERANCE** 

1. PERMITTED TOLERANCE SHALL BE ACCORDING TO THE CBC.

REALTY CAPITA

IRA REALTY CAPITAL 1900 Main Street, Suite 375 Irvine, California 92614

PROJECT NAME

SHOPS at MAIN STREET -**Exterior Building Improvements** 


511-581 North Main Street Corona, California 92880

ENGINEER/ARCHITECT



**IDS GROUP** 1 PETERS CANYON ROAD, SUITE 130 IRVINE, CA 92606

TEL: 949-387-8500, FAX: 949-387-0800

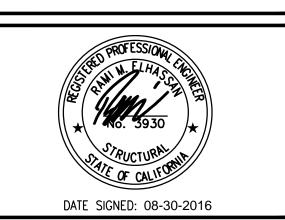

REV. DESCRIPTION DATE 05.31.16 PLAN CHECK SUBMITTAL

07.06.1

PLAN CHECK RE-SUBMITTAL

PLAN CHECK RE-SUBMITTAL

PROJECT NO. 15X047.00 PRINT DATE 8/30/2016 DRAWN BY CHECKED BY

> SHEET TITLE **GENERAL NOTES** (BLDGS 'B' & 'C')

SHEET NUMBER

S0.

ABBREVIATIONS			
@ & A.B. ABV. ADD'L. (ADDL.) ADJ.	AT AND ANCHOR BOLT ABOVE ADDITIONAL ADJACENT	LAT. L.B. LB (#) L.F. LLH LLV	LATERAL LAG BOLT POUND LINEAL FEET (FOOT) LONG LEG HORIZONTAL LONG LEG VERTICAL
ALT. APPRX. (APPROX.) ARCH. BLDG. BLKG. BLW.	ALTERNATE	MAX. M.B. MFR. MIN. MISC.	MAXIMUM MACHINE BOLT MANUFACTURER MINIMUM MISCELLANEOUS
BM. B.N. BNDRY. BOT. (B) BRCG. BRDG. BRG.	BEAM BOUNDARY NAILING BOUNDARY BOTTOM BRACING BRIDGE (ING) BEARING	MTL. (N) NO. (#) N.T.S. O/C (O.C.)	METAL  NEW  NUMBER  NOT TO SCALE  ON CENTER
BTWN.  CBC C.I.P.	CALIFORNIA BUILDING CODE CAST—IN—PLACE	O.H. OPNG. OPP. PCF	OPPOSITE HAND OPENING OPPOSITE  POUNDS PER CU.FT.
C.J.  C.L. (©)  CLG.  CLR.  COL.	CONTROL JOINT; CONSTRUCTION JOINT CENTER LINE CEILING CLEAR COLUMN	PL. PLYWD. P.P. P.S.F. P.S.I. P.T.	PLATE PLYWOOD PARTIAL—PENETRATION POUNDS PER SQUARE FOOT POUNDS PER SQUARE INCH PRESSURE TREATED
CONC. CONN. CONST. CONT. C.P. CTSK. CTR.	CONCRETE CONNECTION CONSTRUCTION CONTINUOUS COMPLETE - PENETRATION COUNTERSINK CENTER(ED)	QTY.  RAD. (R) REF. REINF. REQ'D. (REQD.) RF.	QUANTITY  RADIUS REFERENCE REINFORCEMENT (ING) REQUIRED ROOF
d DBL. DEPT. D.F. DIA. (Ø) DIAG. DIAPH. DIM. DN. DSA  DWG. (DWGS.) DWL.	d PENNY NAIL DOUBLE DEPARTMENT DOUGLAS FIR DIAMETER DIAGONAL DIAPHRAGM DIMENSION DOWN DIVISION OF THE STATE ARCHITECT DRAWING(S) DOWEL	S.A.D. SCH. SEP. SHT. SIM. S.O.G. SQ. ST STD. STAGG. STL. STRUC(T).	SEE ARCHITECTURAL DRAWINGS SCHEDULE SEPARATION SHEET SIMILAR SLAB-ON-GRADE SQUARE SNUG-TIGHTENED STANDARD STAGGER(ED) STEEL STRUCTURAL
EA. E.F. E.J. EL. EMB. E.N. ENG. EQ. EQPT. EXP. EXIST. (E) EXT.	EACH EACH FACE EXPANSION JOINT ELEVATION EMBED(MENT) EDGE NAIL ENGINEER EQUAL EQUIPMENT EXPANSION EXISTING EXTERIOR	T&B T&G THK. T.N. T.O. T.O.C. T.O.S. T.O.W. T.S.G. TYP.	TOP AND BOTTOM TONGUE AND GROOVE THICK(NESS) TOE NAIL TOP OF TOP OF CONCRETE TOP OF STEEL; TOP OF SHEATHING TOP OF WALL TAPERED STEEL GIRDER TYPICAL
FDN. FIN. FLR. F.N. F.O.C. F.O.M. F.O.S. F.O.W. F.P. FT. (') FTG. F.V.	FOUNDATION FINISH(ED) FLOOR FIELD NAIL; FACE NAIL FACE OF CONCRETE FACE OF MASONRY FACE OF STUD FACE OF WALL FULL (COMPLETE) PENETRATION FOOT (FEET) FOOTING FIELD VERIFY	U.O.N. (U.N.O.)	UNLESS OTHERWISE NOTED
GA. GALV. GLB.	GAUGE GALVANIZE(D) GLU-LAM/GLULAM GLUED LAMINATED BEAM		

GLUED LÁMINATED BEAM

GRADE

### **NAILING**

	CONNECTION	FASTENING <sup>a, m</sup>	LOCATION
1.	JOIST TO SILL OR GIRDER	$3 - 8d COMMON (2\frac{1}{2}" \times 0.131")$	TOENAIL
2.	BRIDGING TO JOIST	2 - 8d COMMON (2½" x 0.131")	TOENAIL EACH END
3.	BLOCKING BETWEEN JOISTS OR RAFTERS TO TOP PLATE	$3 - 8d$ COMMON $(2\frac{1}{2}$ " x 0.131")	TOENAIL
4.	CEILING JOISTS TO PLATE	3 − 8d COMMON (2½" x 0.131")	TOENAIL
5.	WIDER THAN 1" x 8" SHEATHING TO EACH BEARING	$3 - 8d$ COMMON ( $2\frac{1}{2}$ " x 0.131")	FACE NAIL
6.	2" PLANKS	16d COMMON (3½" x 0.162")	AT EACH BEARING
7.	ROOF RAFTER TO 2-BY RIDGE BEAM	$2 - 16d$ COMMON $(3\frac{1}{2}" \times 0.162")$ $2 - 16d$ COMMON $(3\frac{1}{2}" \times 0.162")$	TOENAIL FACE NAIL
8.	LEDGER STRIP	$3 - 16d COMMON (3\frac{1}{2}^{"} \times 0.162")$	FACE NAIL AT EACH JOIST
9.	WOOD STRUCTURAL PANELS AND PARTICILEBOARD <sup>b</sup> SUBFLOOR, ROOF AND WALL SHEATHING (TO FRAMING)	$\frac{1}{2}$ " AND LESS $6d^{c,1}$ $\frac{19}{32}$ " TO $\frac{3}{4}$ " $8d^d$ OR $6d^e$ $\frac{7}{8}$ " TO $1$ " $10d^d$ OR $8d^e$ $\frac{1}{8}$ " TO $\frac{1}{4}$ " $10d^d$ OR $8d^e$	
10.	PANEL SIDING (TO FRAMING)	½" AND LESS 6d <sup>f</sup> 5%" 8d <sup>f</sup>	
11.	INTERIOR PANELING	1/4" 4d <sup>j</sup> 3/8" 6d <sup>k</sup>	

a. COMMON OR BOX NAILS ARE PERMITTED TO BE USED EXCEPT WHERE OTHERWISE STATED.

b. NAILS SPACED AT 6 INCHES ON CENTER AT EDGES, 12 INCHES AT INTERMEDIATE SUPPORTS EXCEPT 6 INCHES AT SUPPORTS WHERE SPANS ARE 48 INCHES OR MORE. FOR NAILING OF WOOD STRUCTURAL PANEL AND PARTICLEBOARD DIAPHRAGMS AND SHEAR WALLS, REFER TO SECTION 2305. NAILS FOR WALL SHEATHING ARE PERMITTED TO BE COMMON, BOX OR CASING.

- c. COMMON OR DEFORMED SHANK (6d 2" x 0.113"; 8d  $2\frac{1}{2}$ " x 0.131"; 10d 3" x 0.148").
- d. COMMON (6d 2" x 0.113"; 8d  $2\frac{1}{2}$ " x 0.131"; 10d 3 x 0.148").
- e. DEFORMED SHANK (6d -2" x 0.113"; 8d  $-2\frac{1}{2}$ " x 0.131"; 10d -3" x 0.148").

  f. CORROSION-RESISTANT SIDING (6d  $-1\frac{7}{8}$ " x 0.106"; 8d  $-2\frac{3}{8}$ " x 0.128") OR CASING (6d -2" x 0.099"; 8d  $-2\frac{1}{2}$ " x 0.113") NAIL.
- g. FASTENERS SPACED 3 INCHES ON CENTER AT EXTERIOR EDGES AND 6 INCHES ON CENTER AT INTERMEDIATE SUPPORTS, WHEN USED AS STRUCTURAL SHEATHING. SPACING SHALL BE 6 INCHES ON CENTER ON THE EDGES AND 12 INCHES ON CENTER AT INTERMEDIATE SUPPORTS FOR NON-STRUCTURAL APPLICATIONS.
- h. CORROSION-RESISTANT ROOFING NAILS WITH  $\frac{7}{16}$ -INCH-DIAMETER HEAD AND 1 $\frac{1}{2}$ -INCH LENGTH FOR  $\frac{1}{2}$ -INCH SHEATHING AND  $1\frac{3}{4}$ -INCH LENGTH FOR  $2\frac{5}{32}$ -INCH SHEATHING.
- i. CORROSION-RESISTANT STAPLES WITH NOMINAL  $\frac{7}{16}$ -INCH CROWN OR 1-INCH CROWN AND  $1\frac{1}{4}$ -INCH LENGTH FOR  $\frac{1}{2}$ -INCH SHEATHING AND  $1\frac{1}{2}$ -INCH LENGTH FOR  $2\frac{5}{32}$ -INCH SHEATHING. PANEL SUPPORTS AT 16 INCHES (20 INCHES IF STRENGTH AXIS IN THE LONG DIRECTION OF THE PANEL, UNLESS OTHERWISE MARKED).
- j. CASING ( $1\frac{1}{2}$ " x 0.080") OR FINISH ( $1\frac{1}{2}$ " X 0.072") NAILS SPACED 6 INCHES ON PANEL EDGES, 12 INCHES AT INTEREDIATE
- k. PANEL SUPPORTS AT 24 INCHES. CASING OR FINISH NAILS SPACED 6 INCHES ON PANEL EDGES, 12 INCHES AT INTERMEDIATE
- I. FOR ROOF SHEATHING APPLICATIONS, 8d NAILS ( $2\frac{1}{2}$ " x 0.113") ARE THE MINIMUM REQUIRED FOR WOOD STRUCTURAL PANELS.
- m. STAPLES SHALL HAVE A MINIMUM CROWN WIDTH OF  $\frac{7}{16}$  INCH. n. FOR ROOF SHEATHING APPLICATIONS, FASTENERS SPACED 4 INCHES ON CENTER AT EDGES, 8 INCHES AT INTERMEDIATE
- o. FASTENERS SPACED 4 INCHES ON CENTER AT EDGES, 8 INCHES AT INTERMEDIATE SUPPORTS FOR SUB-FLOOR AND WALL
- SHEATHING AND 3 INCHES ON CENTER AT EDGES, 6 INCHES AT INTERMEDIATE SUPPORTS FOR ROOF SHEATHING.
- p. FASTENERS SPACED 4 INCHES ON CENTER AT EDGES, 8 INCHES AT INTERMEDIATE SUPPORTS. q. CEILING JOIST AND RAFTER CONSTRUCTION SHALL BE IN ACCORDANCE WITH CBC SECTION 2308.10.



**IRA REALTY CAPITAL** 1900 Main Street, Suite 375 Irvine, California 92614

PROJECT NAME


SHOPS at MAIN STREET -**Exterior Building** Improvements

511-581 North Main Street Corona, California 92880



**IDS GROUP** 

1 PETERS CANYON ROAD, SUITE 130 IRVINE, CA 92606 TEL: 949-387-8500, FAX: 949-387-0800

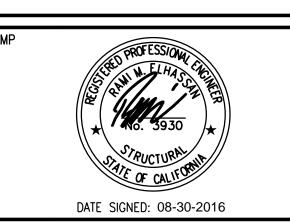

ISSUE			
REV.	DESCRIPTION	DATE	
	PLAN CHECK SUBMITTAL	05.31.16	
	PLAN CHECK RE-SUBMITTAL	07.06.16	
	PLAN CHECK RE-SUBMITTAL	08.31.16	

— í		
) L	PROJECT NO.	15X047.0
ו	PRINT DATE	8/30/201
AL	DRAWN BY	
_	CHECKED BY	JR, S

GENERAL NOTES (BLDGS 'B' & 'C')

SHEET NUMBER

